



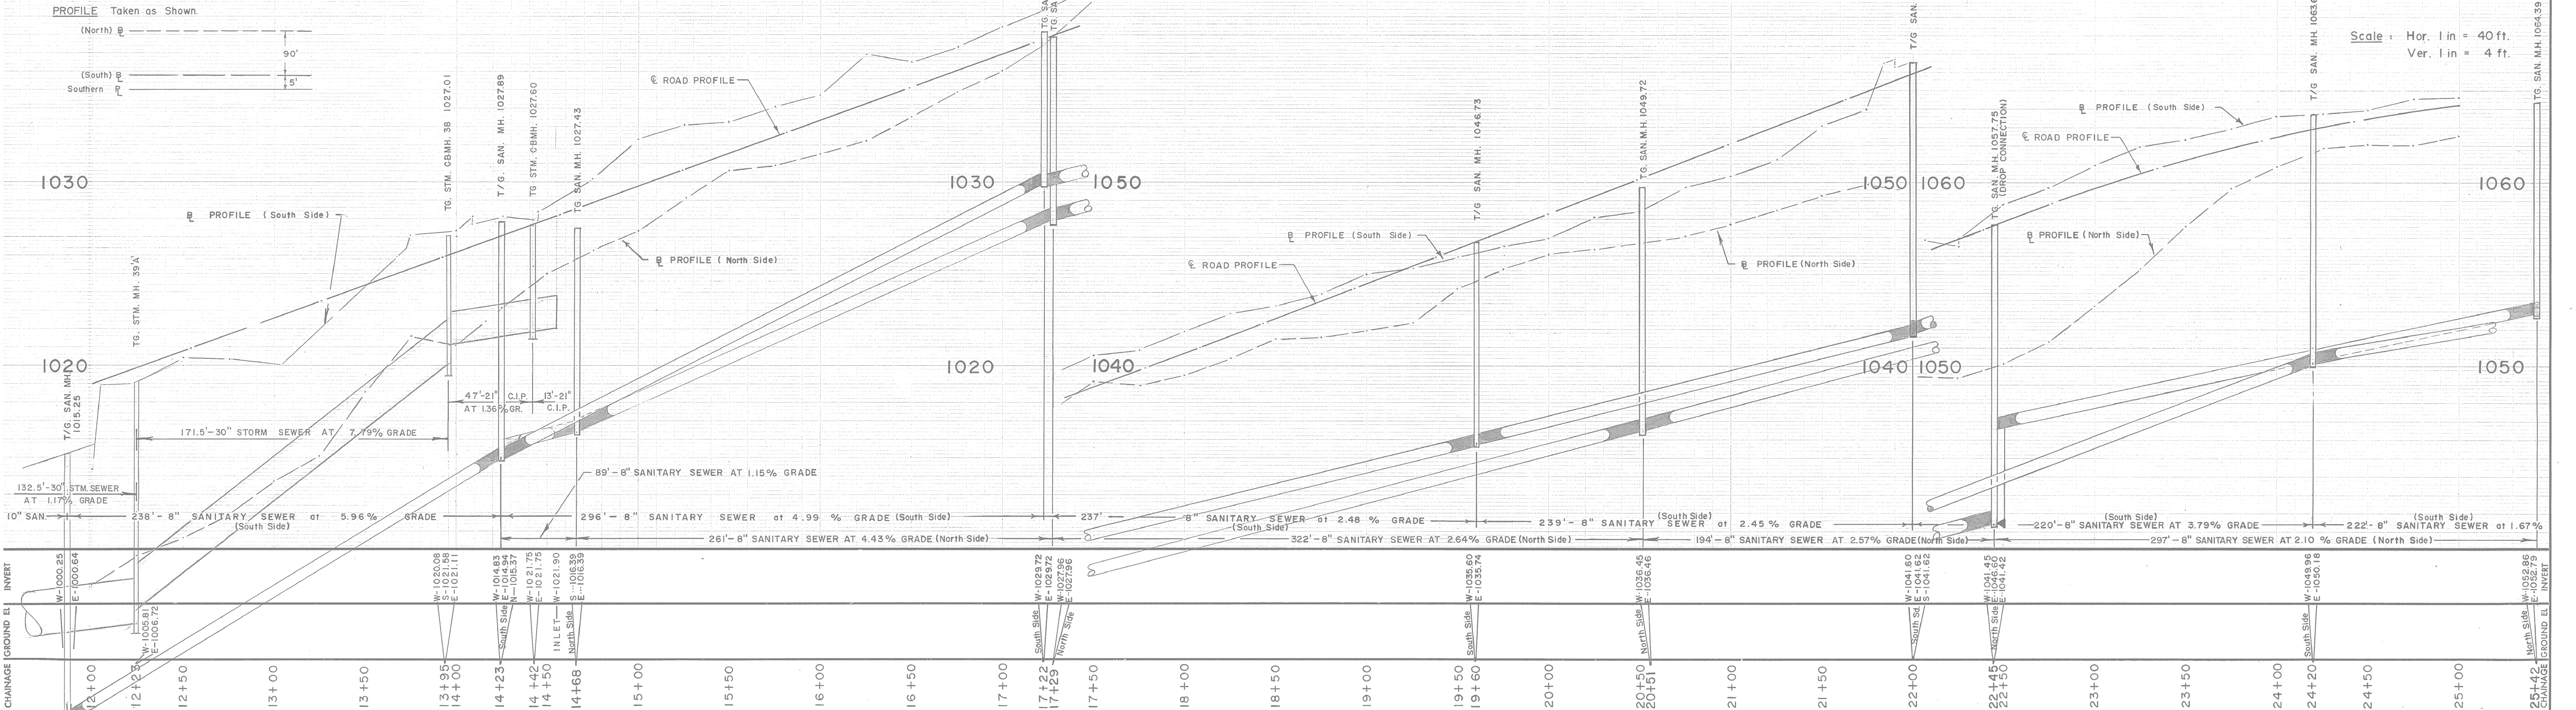

DISCLAIMER		8 AS CONST D. (Cont. 115-87) Pearce St. Bk 281		1. NEW DRAWING		APPROVED		AIRPORT ROAD		CITY OF NORTH BAY	
The information contained on this drawing may be based upon data provided by others and may not have been verified by either as-constructed drawings or an Ontario Land Surveyor. The City of North Bay cannot accept responsibility for any errors or omissions on any information shown herein. Field verification, land surveys or excavation (with City approvals) may be required to determine actual location of any and all utilities or property lines.		9 As-Built Pearce St.		2. AS CONST SAN. & WATERMAIN		JUNE, 1975		PEARCE STREET to YOUNG STREET		ENGINEERING DEPARTMENT	
		10. UG Hydro Service added		3. UG HYDRO SERVICE (HO.845) YOUNG ST. SERVICES		JUNE / 78		REG'D PLAN N° M-270, Lot 18 Con.B		SCALE: AS SHOWN	
				4. UG. BELL & SAGE CABLE		JULY/80		36R-5622		DATE: JUNE 1975	
				5. AS CONST. SAN. SEWER (North Side)		AUG. 83		36R-4284		DRAWN BY: J.M.	
				6. ROAD PROFILE ADDED AS SHOWN ON M.T.C. CONT. No. 65-219		MAR. '87		36R-4240		FIELD BOOK No. 242	
				7. ADDITION OF GAS LINE.		MAY '87		36R-4307		DRAWING No. A-257	
				No. REVISION		DATE		36R-4508		REV.	

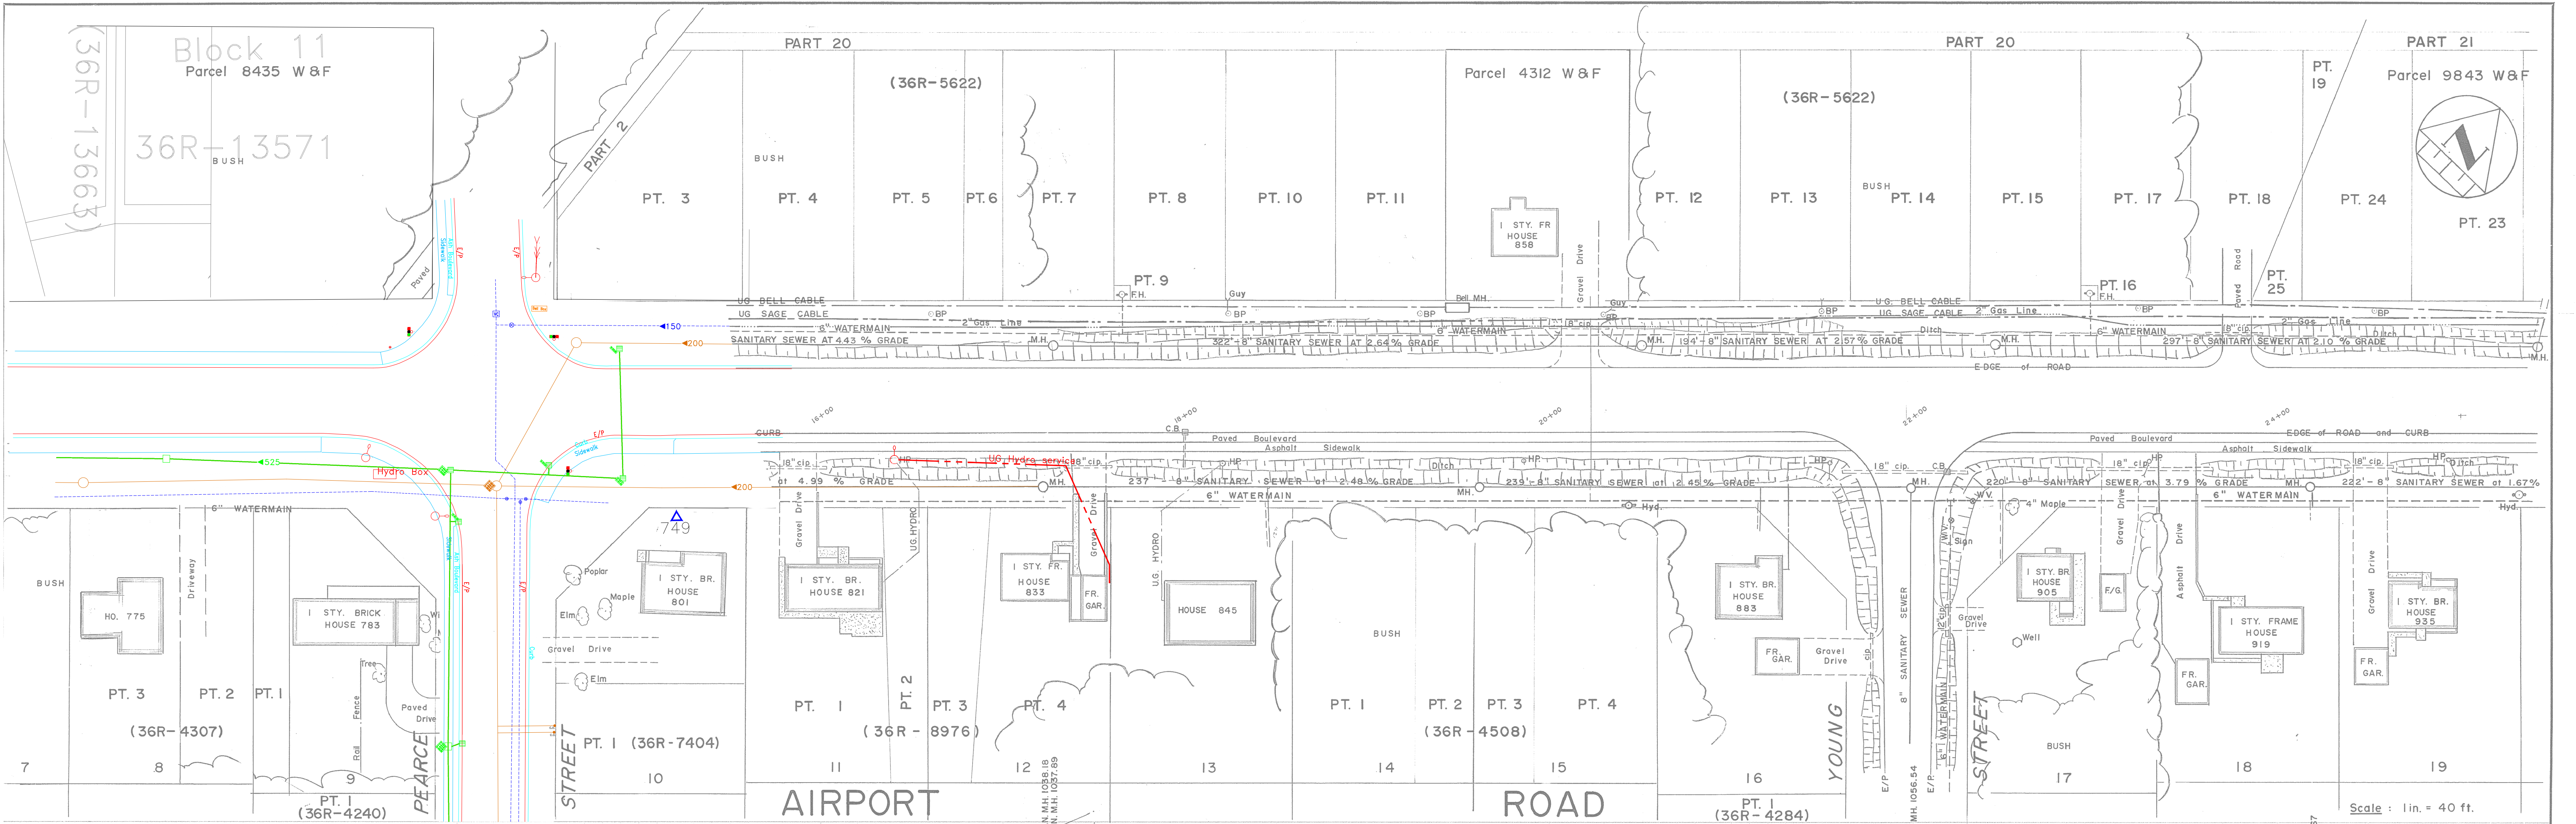