



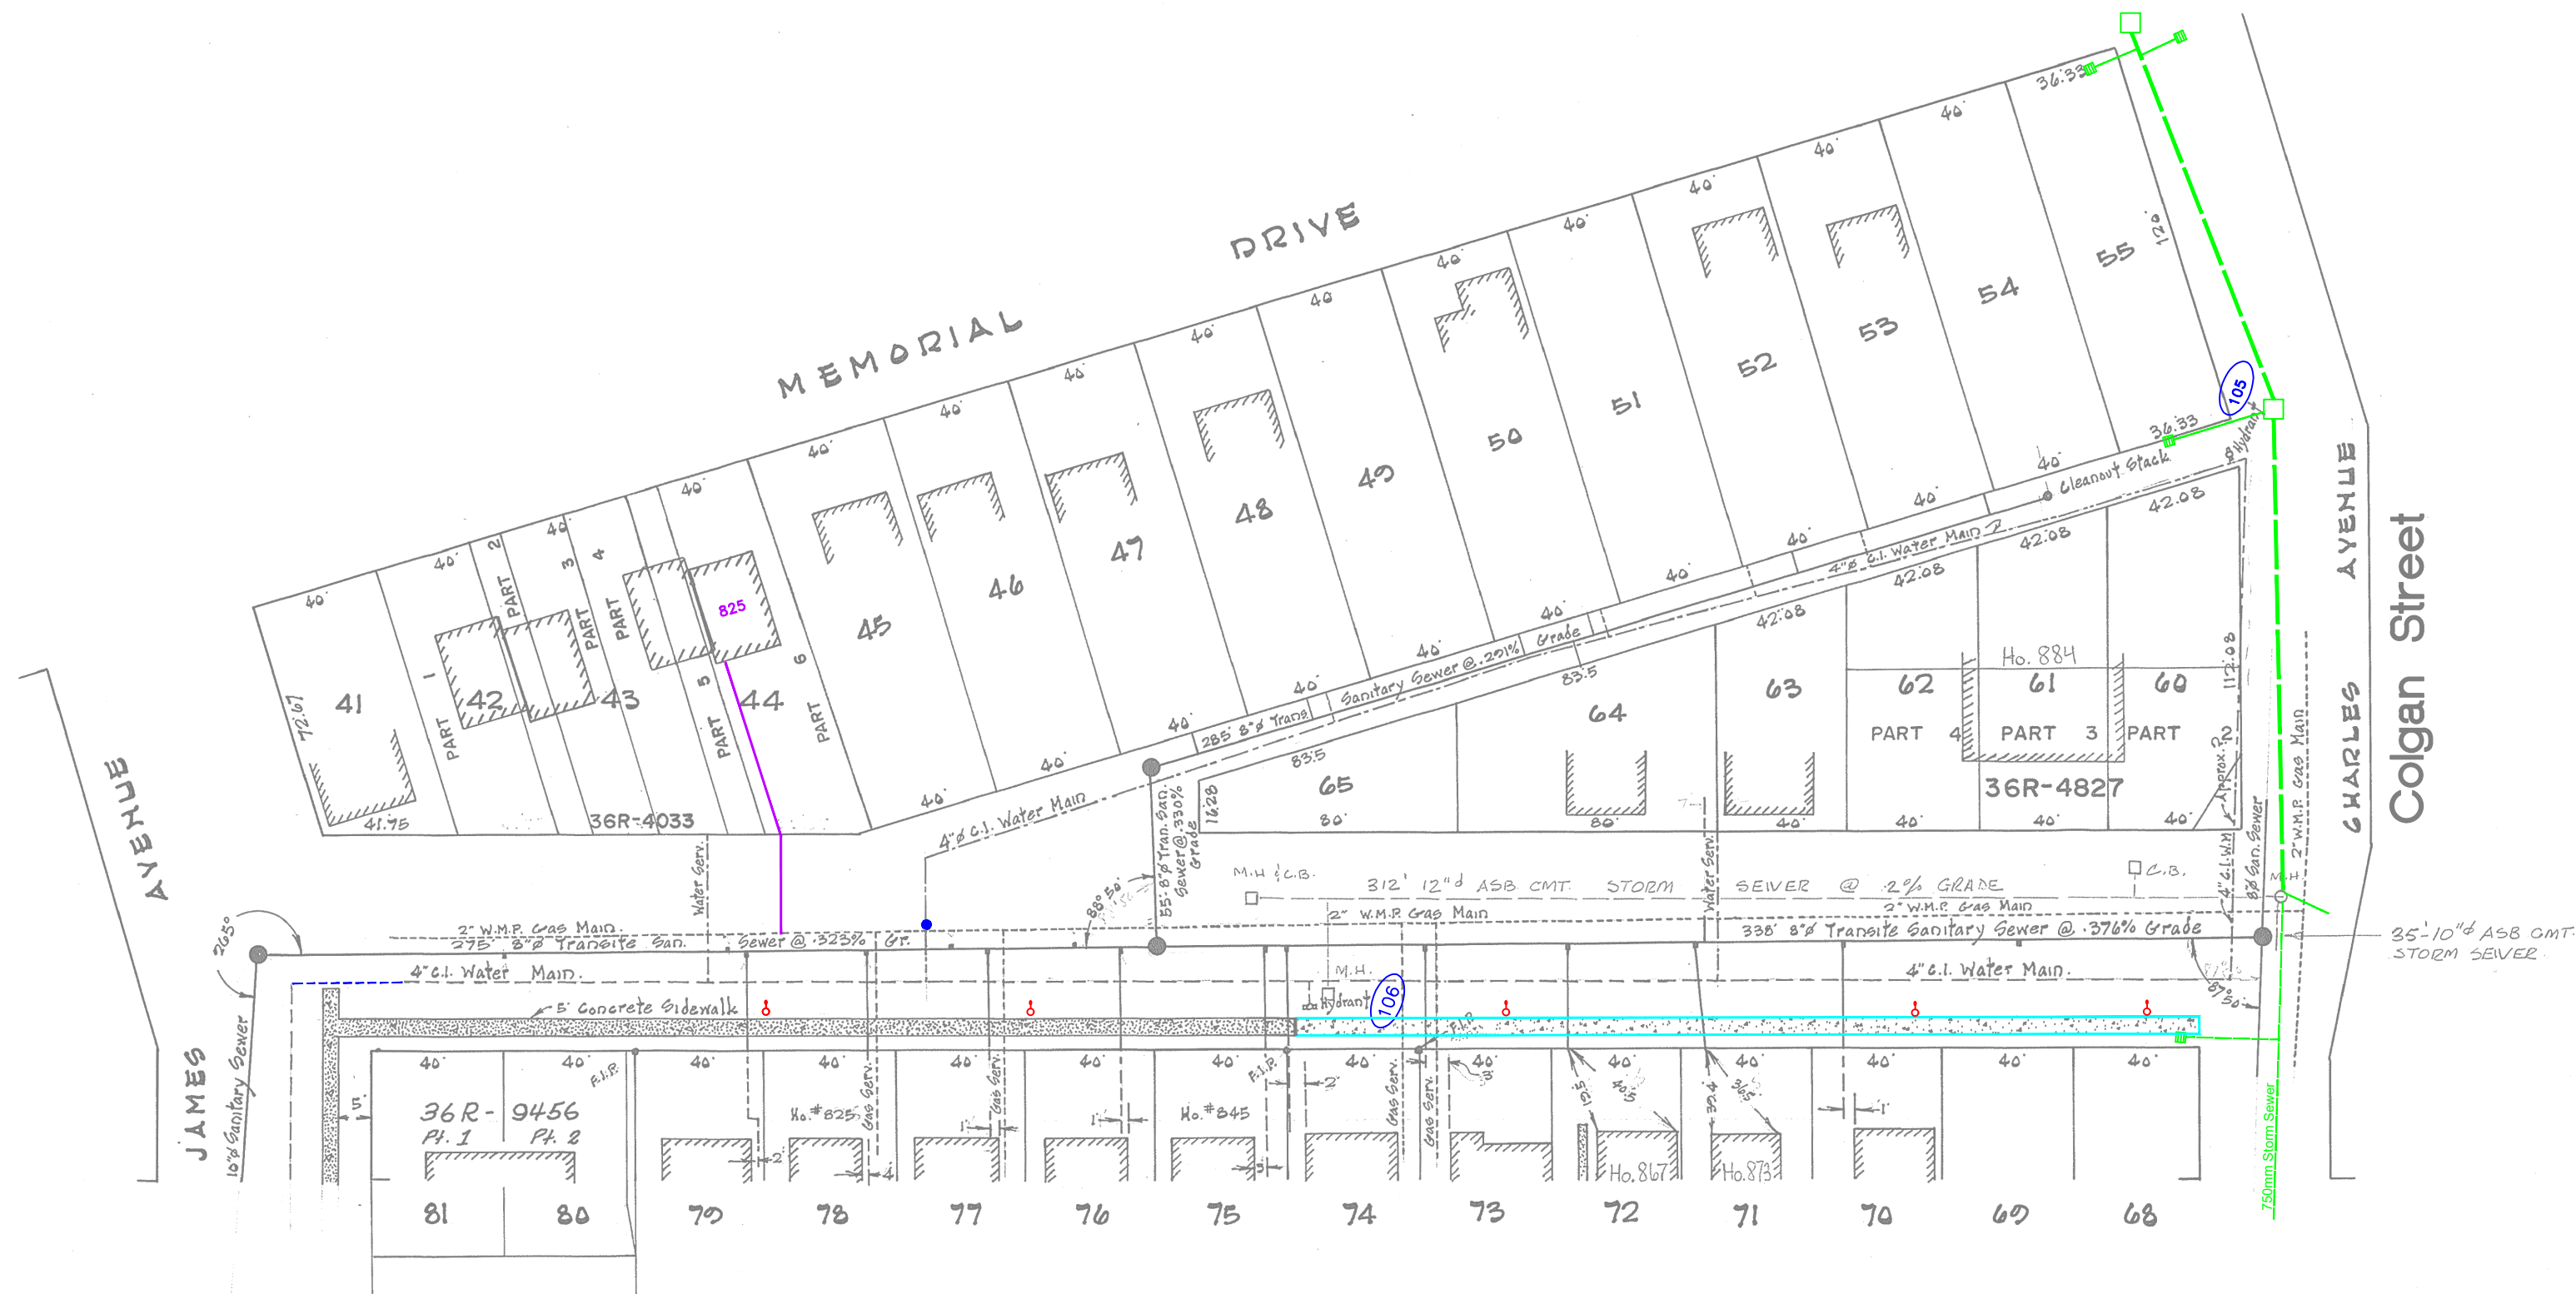

Scale - 1" = 40'

AMELIA STREET AND LANEWAY

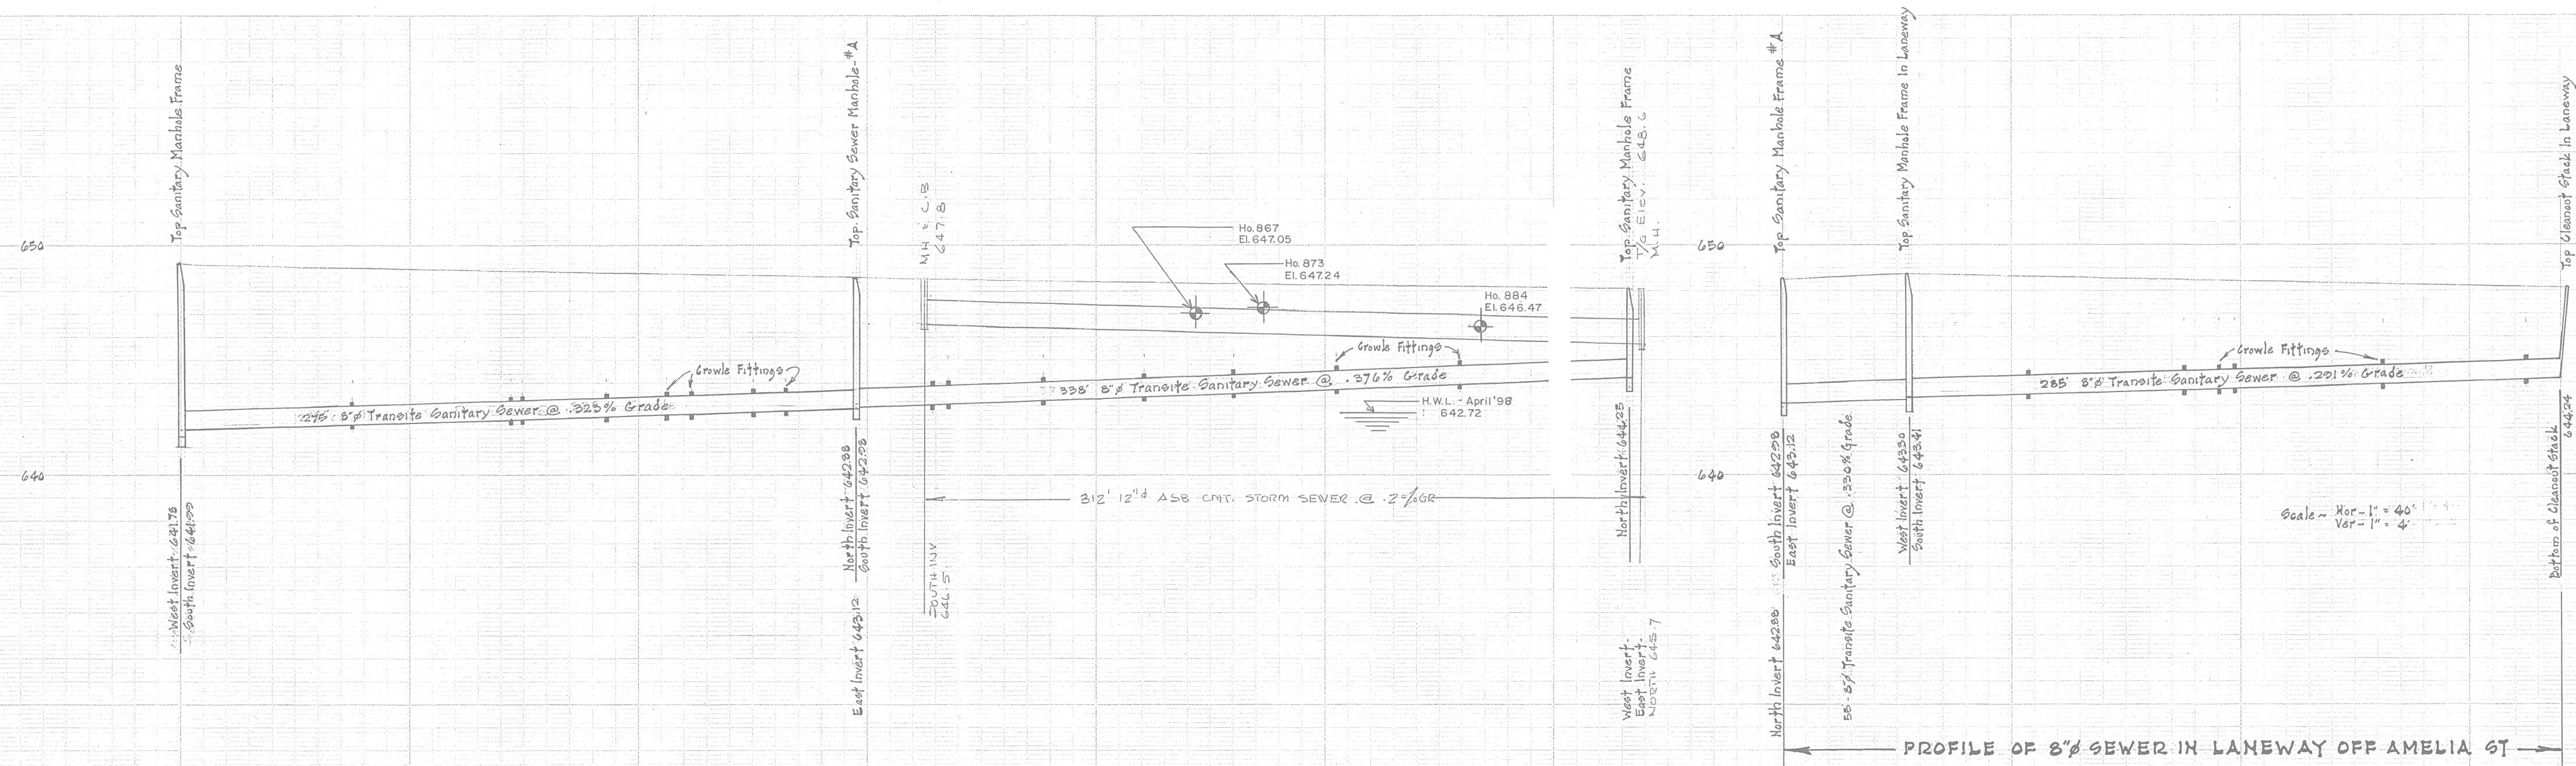

Scale - Hor - 1" = 40'
Ver - 1" = 4'



DISCLAIMER
The information contained on this drawing may be based upon data provided by others and may not have been verified by either as-constructed drawings or an Ontario Land Surveyor. The City of North Bay cannot accept responsibility for any errors or omissions on any information shown herein. Field verification, land surveys or excavation (with City approval) may be required to determine actual location of any and all utilities or property lines.

AS CONSTRUCTED APRIL 18th 1961

BENCH MARK				
DATE	REVISIONS	DWG. NO.	DWG. BY	
DEC. 1961	12" x 48" CMT. STORM SEWER AS CONSTRUCTED		PLS	
CORPORATION OF THE CITY OF NORTH BAY, ONTARIO				
PLAN AND PROFILE				
AMELIA STREET FROM JAMES STREET TO CHARLES ST. AND OF LANEWAY FROM AMELIA STREET TO CHARLES STREET				
DWG. BY B. Saunders	CHKD. BY J. D. 12/61	DATE	FIELD BOOK NO.	
SCALE AS SHOWN	APPROVED BY [Signature]	CITY ENGINEER	DWG. NO. A-26	

A-26