

LEGEND

PROPOSED

- WATERMAIN
- GATE VALVE
- HYDRANT SET
- AIR RELEASE CHAMBER
- VALVE CHAMBER



EXISTING

- SA SANITARY SEWER
- WM WATERMAIN, VALVE, & HYDRANT
- ST STORM SEWER
- G GAS LINE
- STEAM STEAM LINE
- T U.G. TELEPHONE CONDUIT
- H U.G. ELECTRICAL CONDUIT
- C.S.P. CULVERT
- MANHOLE, CATCH BASIN
- DECIDUOUS, CONIFEROUS TREE
- H.P.B.P. HYDRO, BELL, & GUY POLES
- ASPHALT SURFACE
- CONCRETE SURFACE
- DRAINAGE DITCH
- BELL TELEPHONE MARKER

DETAIL 'B'
NTS (BY OTHERS)

DETAIL 'A'
NTS (BY OTHERS)

DETAIL 'C'

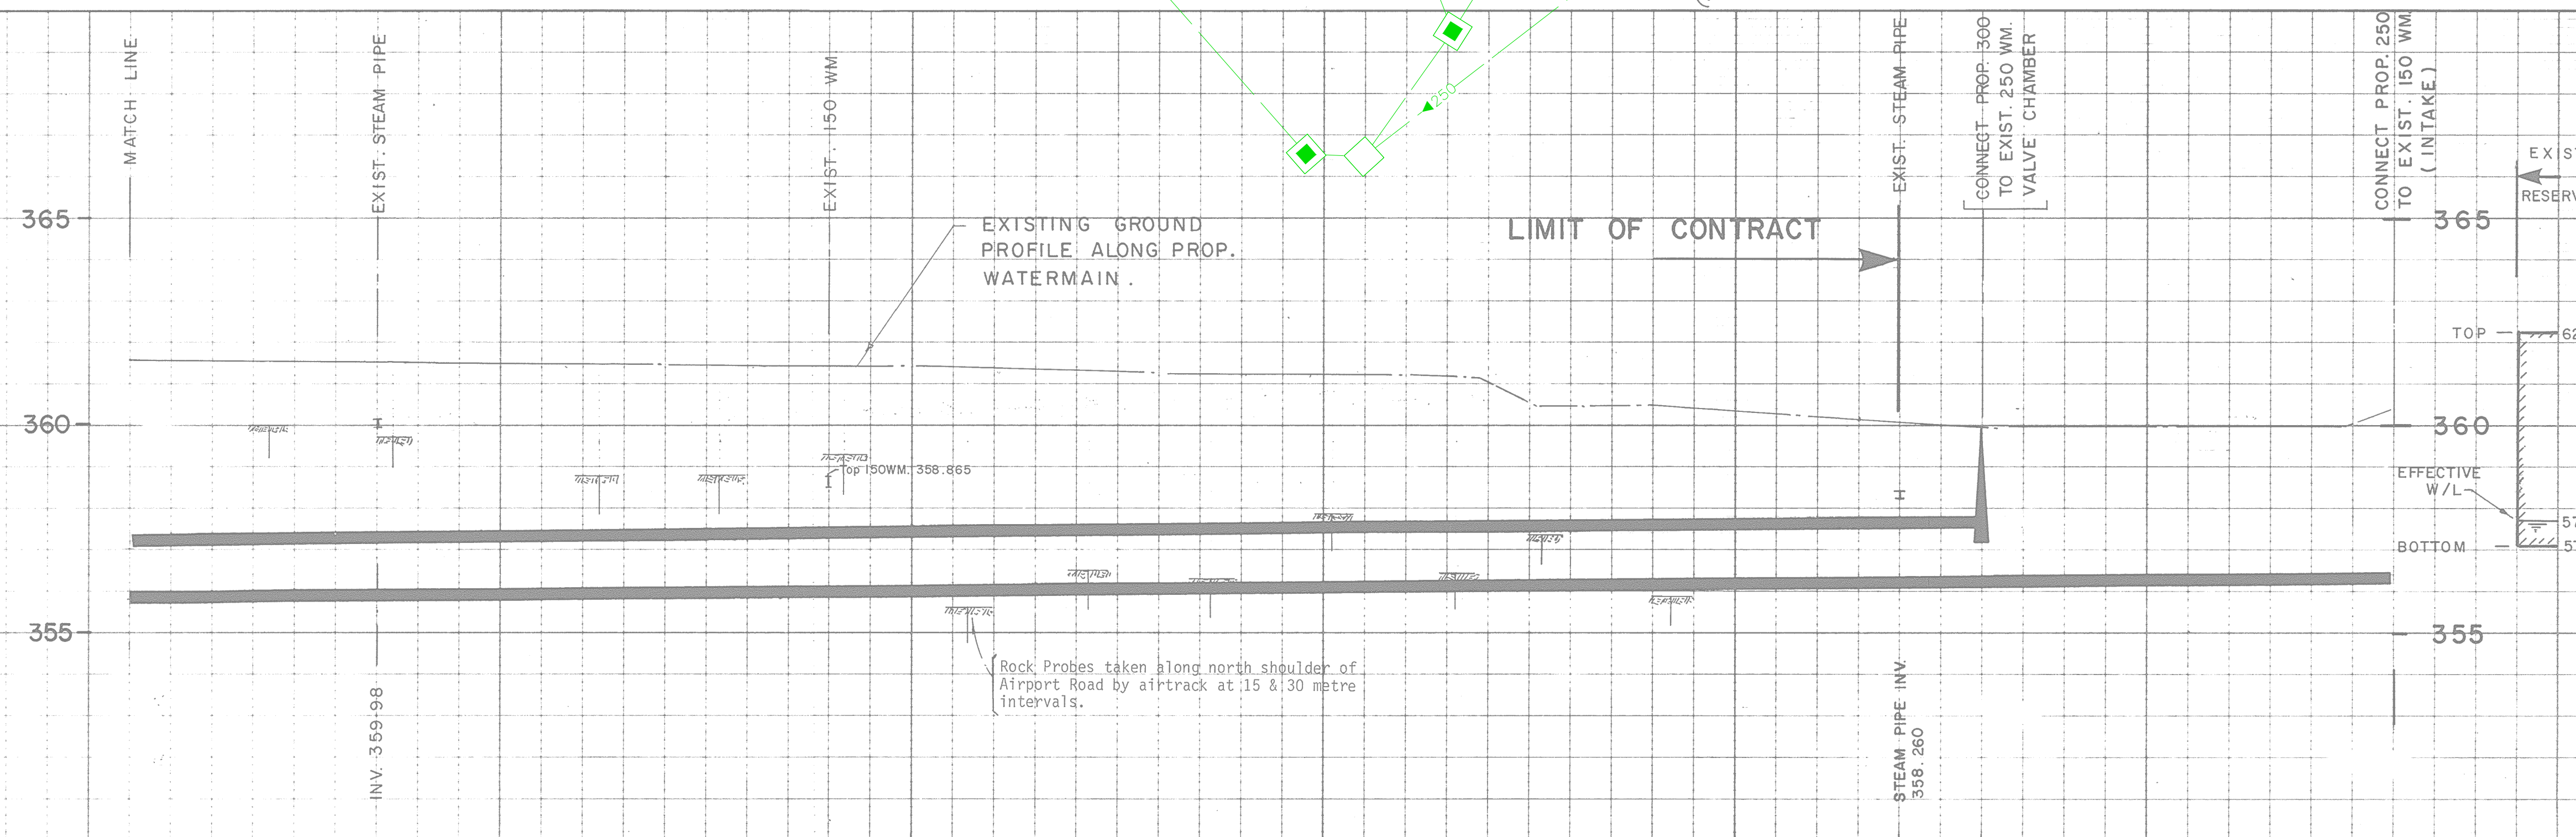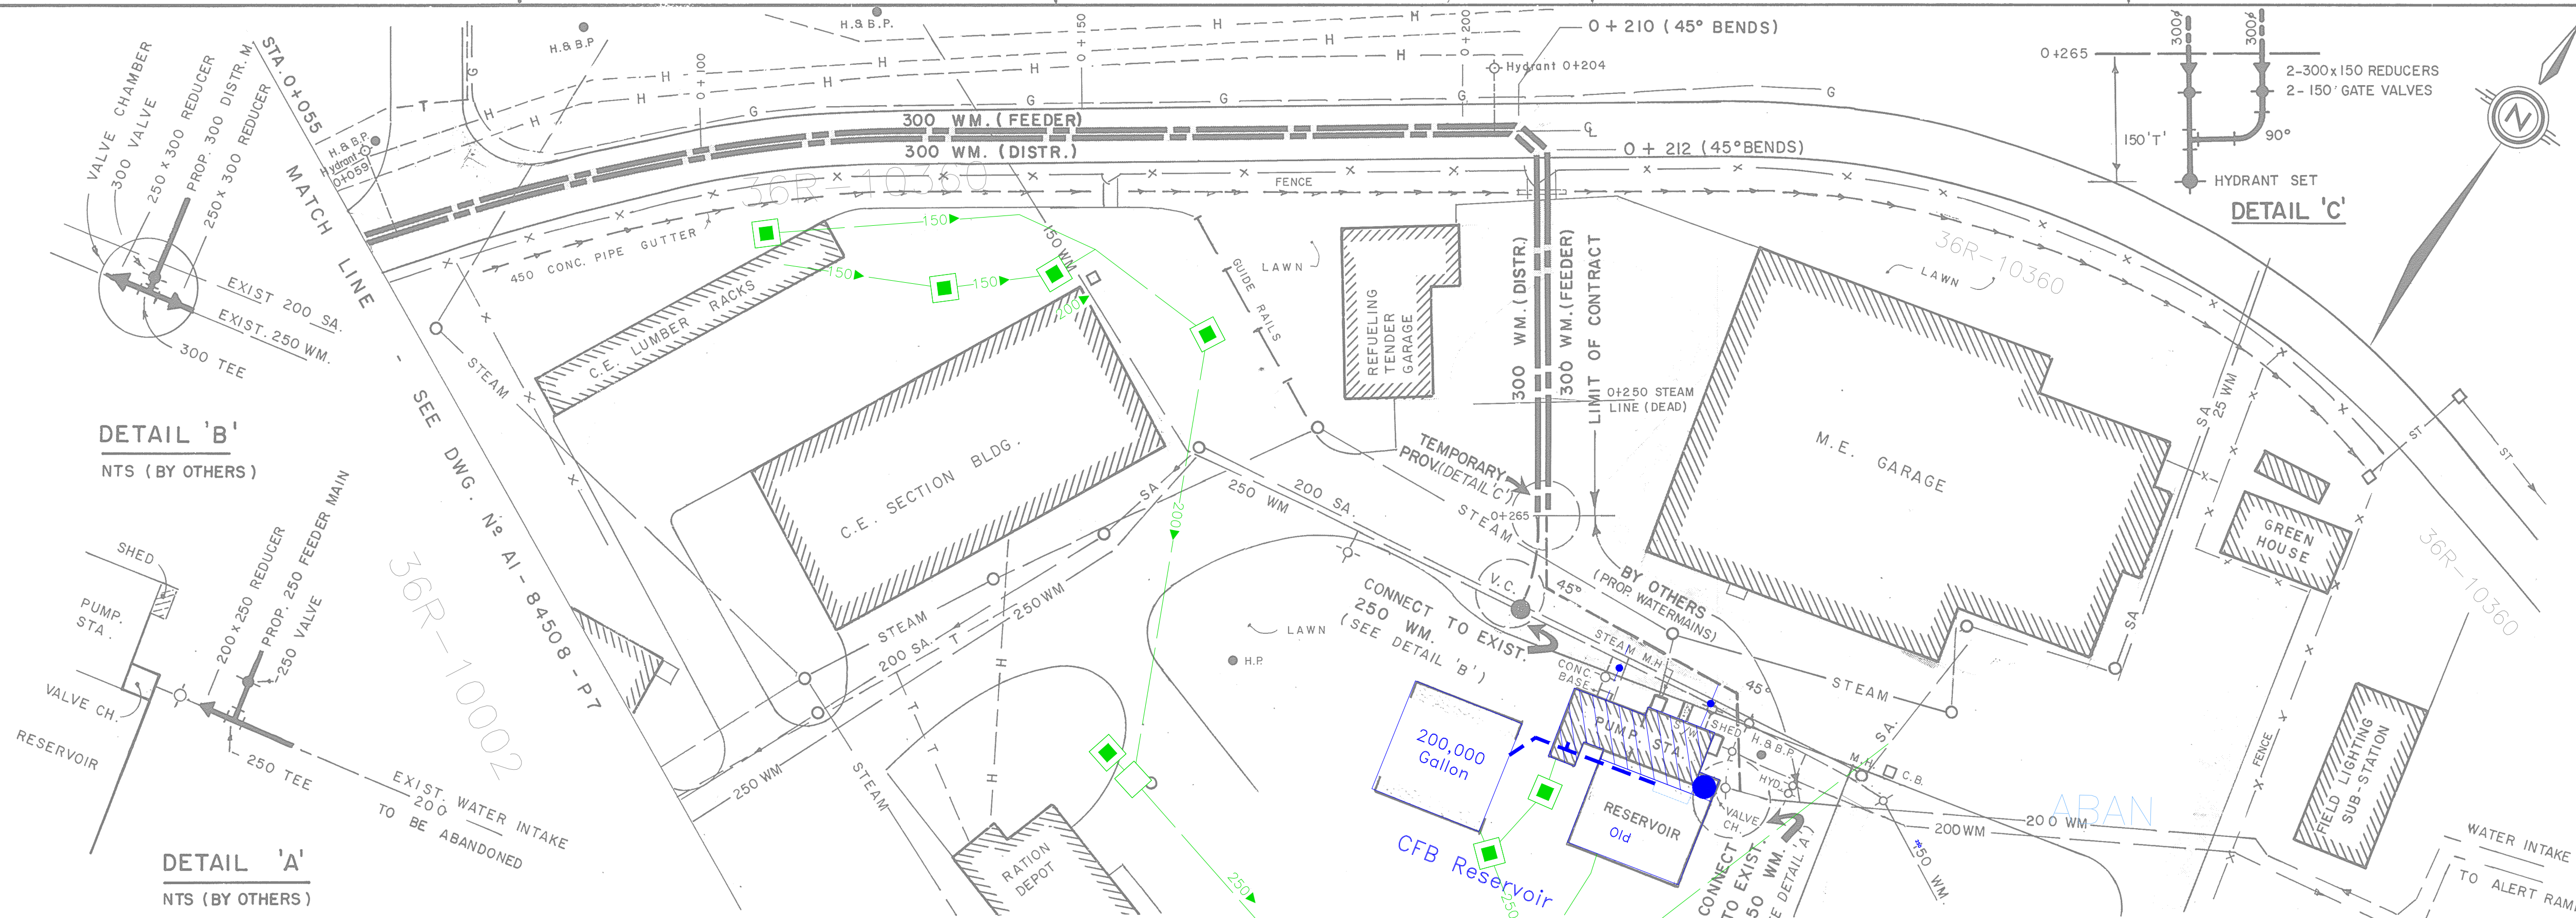

ELEV. & GRADE
FOR
300 mm DISTRIBUTION MAIN

215.0 @ 0.200 %

ELEV. & GRADE
FOR
300 mm FEEDER MAIN

215.0 @ 0.200 %

EXIST. WATERMAIN ELEVATION TO BE CONFIRMED IN THE FIELD PRIOR TO CONSTRUCTION. THE ENGINEER WILL ADJUST THE DESIGN IF THE EXIST. WATERMAIN PROVES TO BE LOWER THAN 357.600

Notes:

DISCLAIMER

The information contained on this drawing may be based upon data provided by others and may not have been verified by either as-constructed drawings or an Ontario Land Surveyor. The City of North Bay cannot accept responsibility for any errors or omissions on any information shown herein. Field verification, land surveys or excavation (with City approvals) may be required to determine actual location of any and all utilities or property lines.

Approved




No.	Zone	Revision	Date	Initial
2.		Registered Plans Added.	Aug 07	r.j.o.
1.	C.N.B.	AS CONST'D. WATERMAINS Cont. 124-84 BK. 279	NOV. 85.	R. B.



CITY OF NORTH BAY

C.F.B. NORTH BAY
FEEDER TRUNK WATERMAIN

0 + 055 (WM.) TO PUMPING STA.

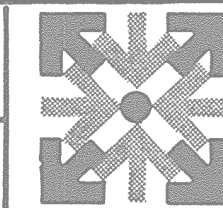

Proctor & Redfern Limited

Consulting Engineers

Toronto

NORTH BAY

Scale HOR. 1:500
VERT. 1:100

Date: JULY, 1984

Drawn By
Ckd. By

Field Book
14163, 14164, 14165

Drawing No.

A1-84508-P8

Rev. 0

A-266