



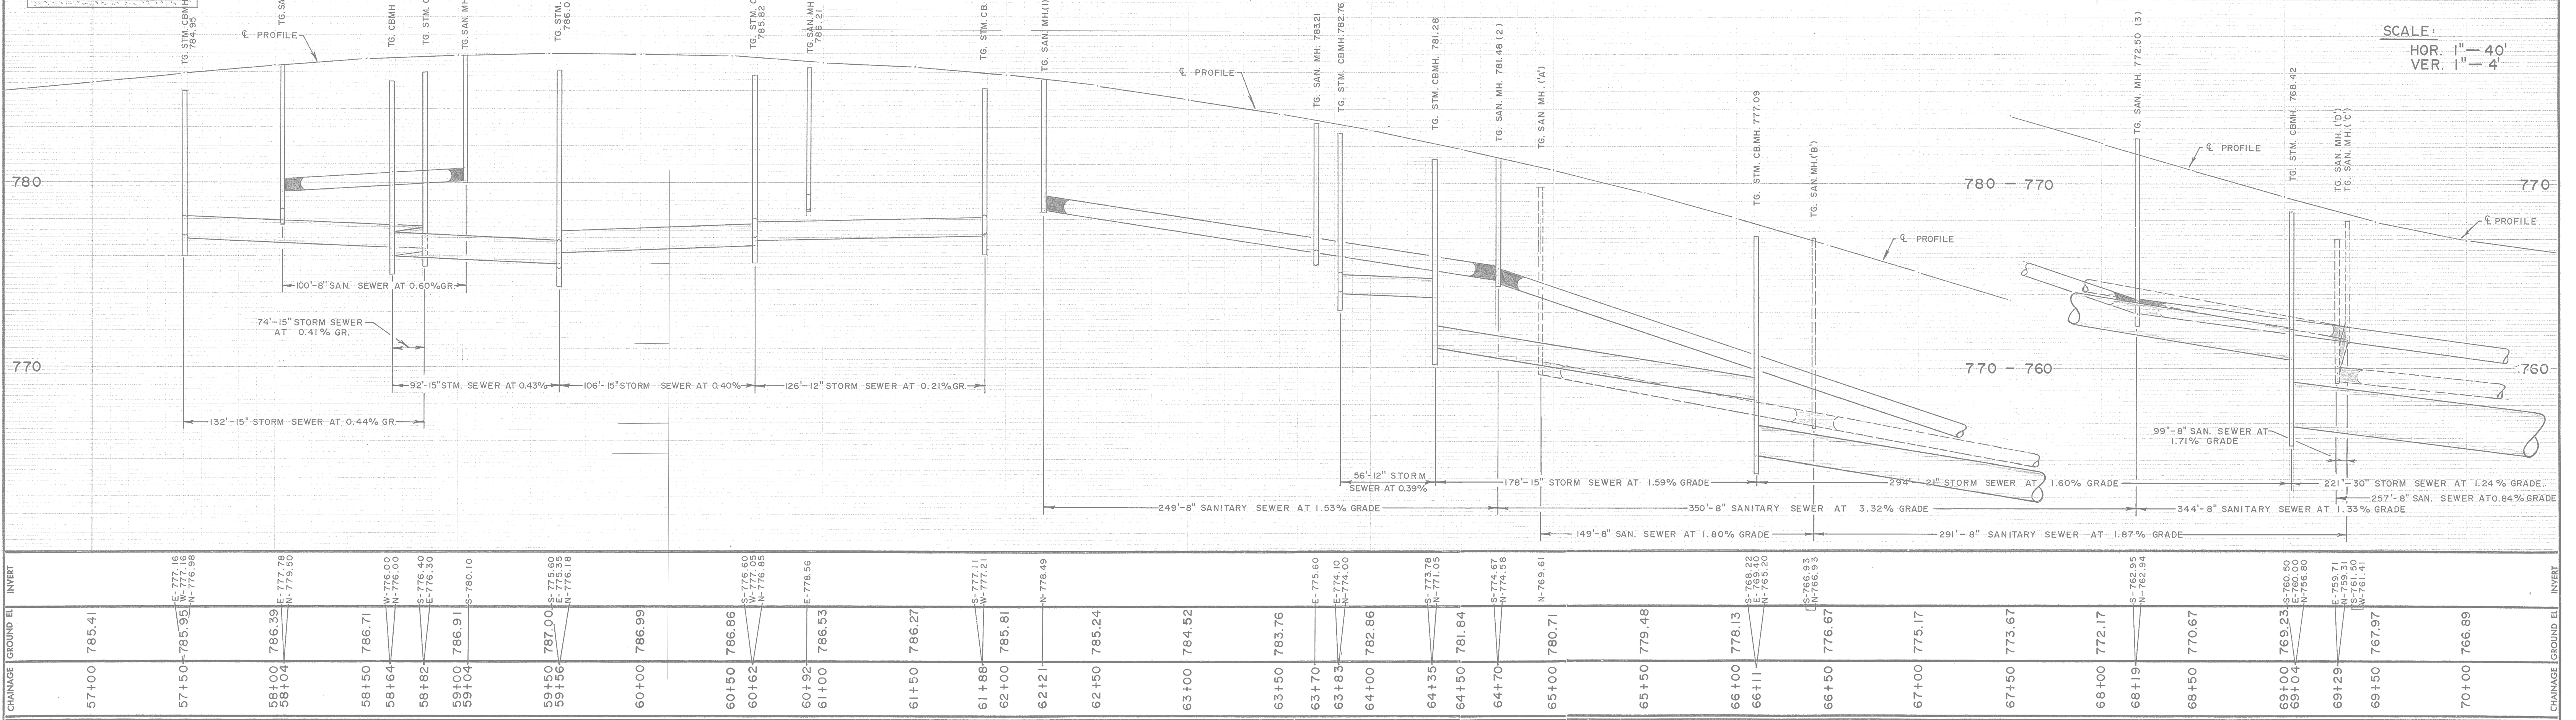

NOTES:		1. NEW DWS. TRACED FROM M.T.C. TOPO		MAY 79		R.F.B.		APPROVED		ALGONQUIN AVENUE OAKWOOD AVE. TO SHIRREFF AVENUE		CITY OF NORTH BAY ENGINEERING DEPARTMENT	
2. Registered Plans Added.		Aug 07		r.j.o.						SCALE: AS SHOWN		DATE: MAY 79	
No.		REVISION		DATE		INITIAL				DRAWN BY: Rick B.		FIELD BOOK No.	
										CK'D. BY:		DRAWING No.	
												A-81	
												REV.	

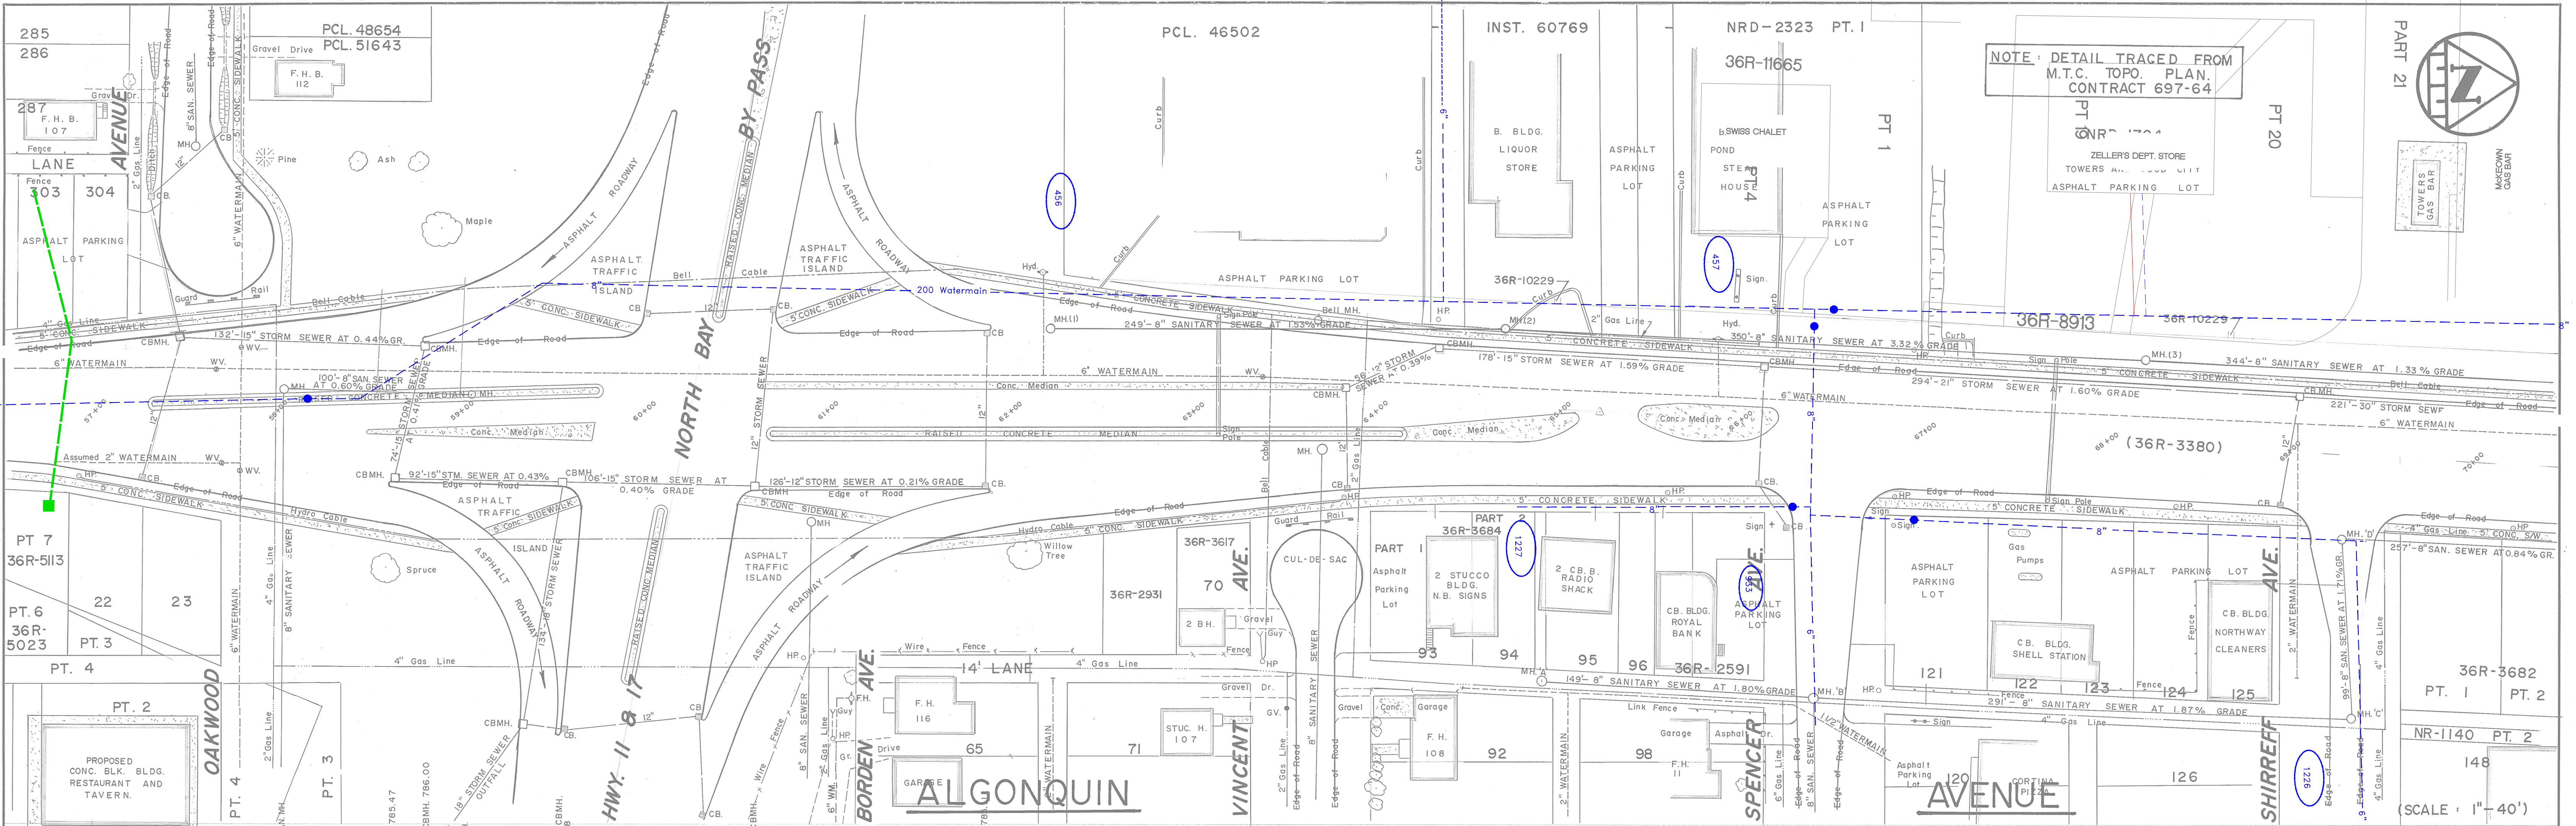