



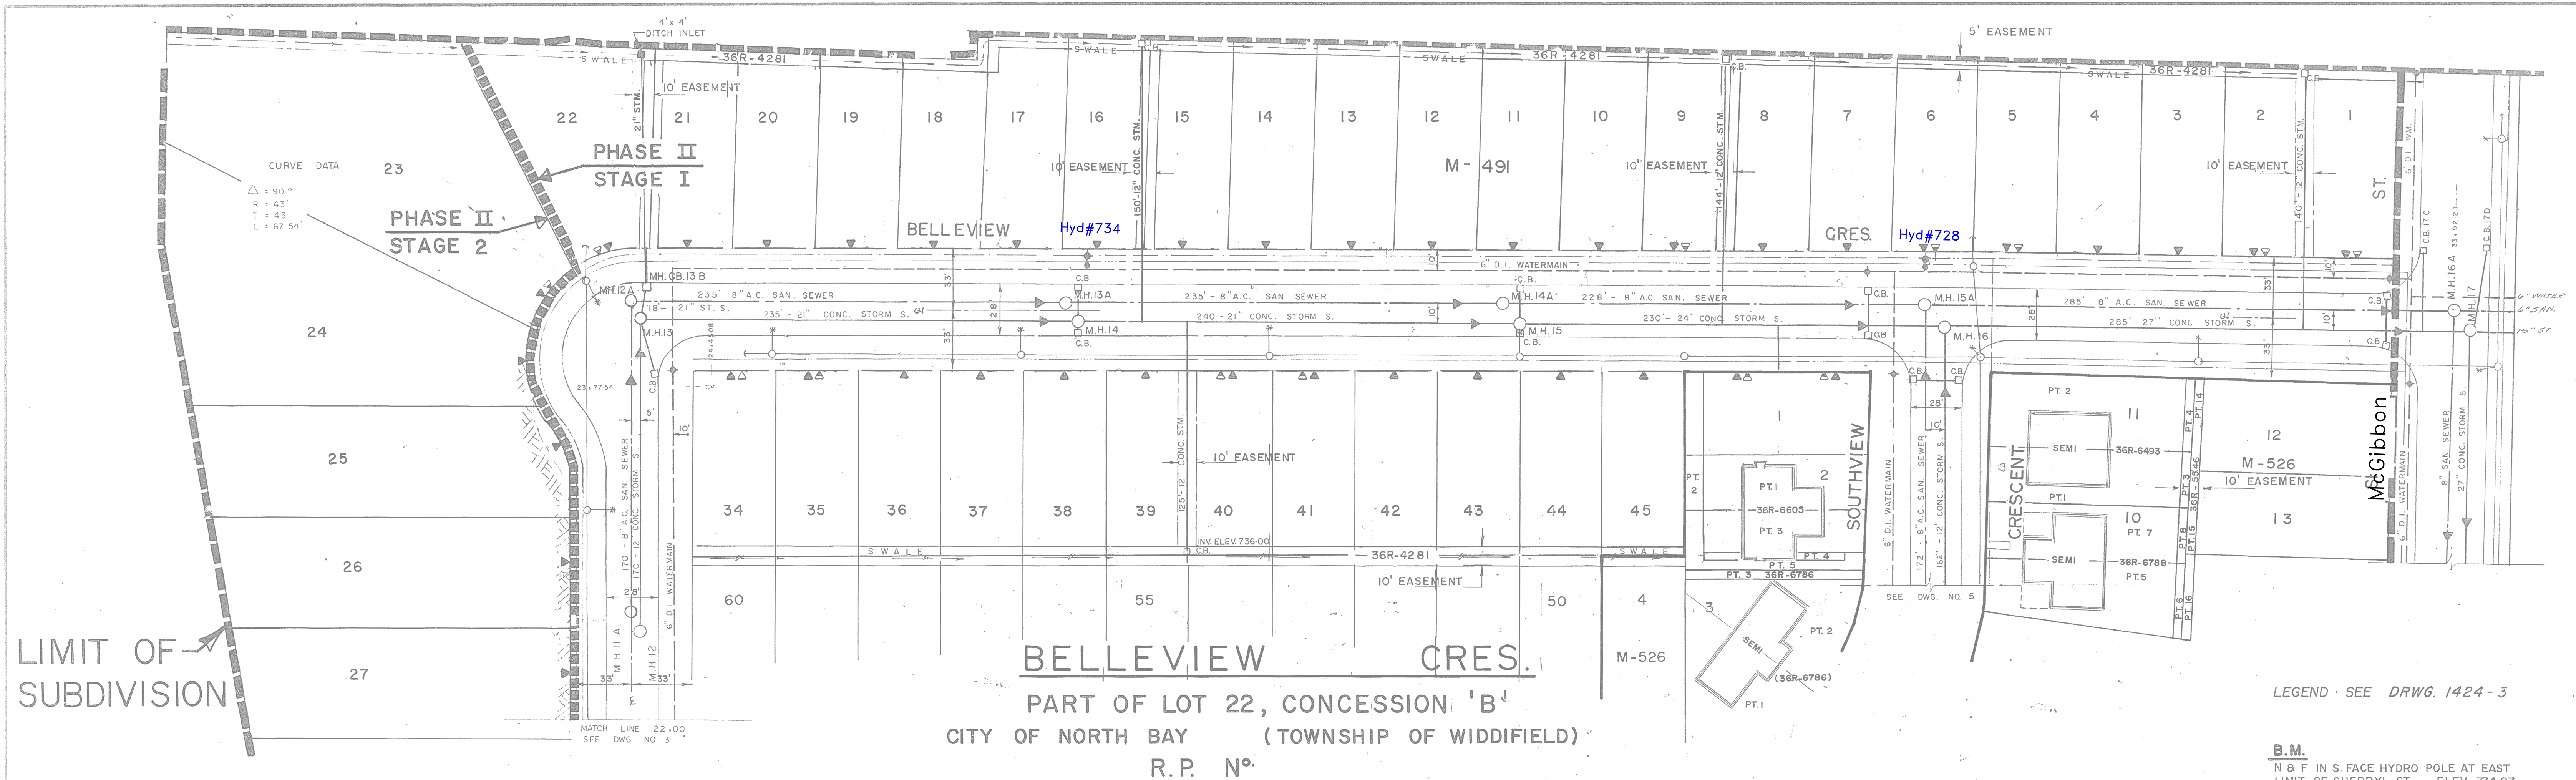

LEGEND - SEE DRWG. 1424-3

B.M.
N 8° F IN S FACE HYDRO POLE AT EAST
LIMIT OF SHERRYL ST. ELEV. 734.97

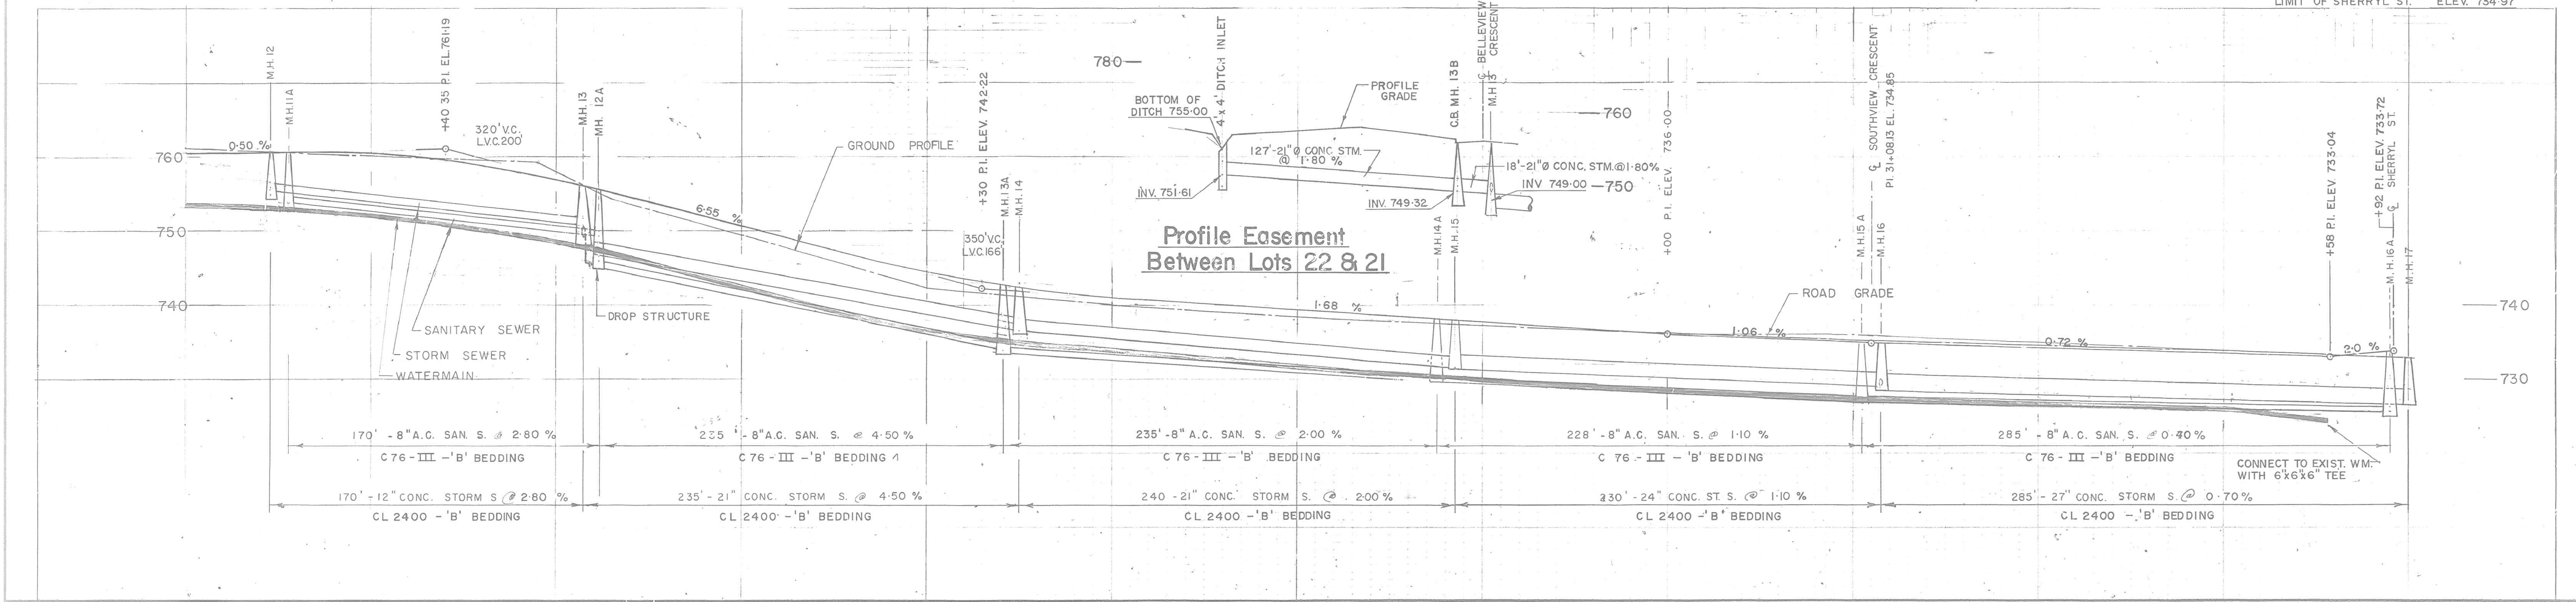

Chainage	Invert
22+00	760.49
-22+30	-755.54 -753.76 760.72
-23+00	760.36
-24+00	-750.78 -749.00 -747.00 -749.00 -744.54 756.99
-25+00	754.01 750.74
-26+00	747.46 744.60
-27+00	-733.96 -736.42 742.46 741.06
-28+00	740.20 739.36
-29+00	-738.52 -729.88 -731.62 -731.37 737.68
-30+00	736.84 736.00
-31+00	-735.47 -734.94 -726.75 -728.64 -728.59
-32+00	734.54 734.18
-33+00	733.82 733.46
-34+00	-733.72 -726.51 -726.59
-34+24	733.10

Notes:

DISCLAIMER

The information contained on this drawing may be based upon data provided by others and may not have been verified by either as-constructed drawings or an Ontario Land Surveyor. The City of North Bay cannot accept responsibility for any errors or omissions on any information shown herein. Field verification, land surveys or excavation (with City approvals) may be required to determine actual location of any and all utilities or property lines.

THE POSITION OF POLE LINES, CONDUITS, WATERMANS, SEWERS AND OTHER UNDERGROUND AND OVERGROUND UTILITIES AND STRUCTURES IS NOT NECESSARILY SHOWN ON THE CONTRACT DRAWINGS, AND, WHERE SHOWN, THE ACCURACY OF THE POSITION OF SUCH UTILITIES AND STRUCTURES IS NOT GUARANTEED. BEFORE STARTING WORK, THE CONTRACTOR SHALL INFORM HIMSELF OF THE EXACT LOCATION OF ALL SUCH UTILITIES AND STRUCTURES, AND SHALL ASSUME ALL LIABILITY FOR DAMAGE TO THEM.

Approved

NORTH BAY

Just North Enough to be PERFECT

CITY of NORTH BAY

BELLEVUE PARK SUBDIVISION

BELLEVUE CRESCENT

(FROM STA 22+30 TO STA 33+90)

Northland Engineering Ltd.

CONSULTING ENGINEERS AND PLANNERS

NORTH BAY SUBURBY

Scale Hor 1"=40'
Vert 1"=10'

Drawn By P.F.
Ckd. By

Field Book

Drawing No.

141 B-1052

Rev.