
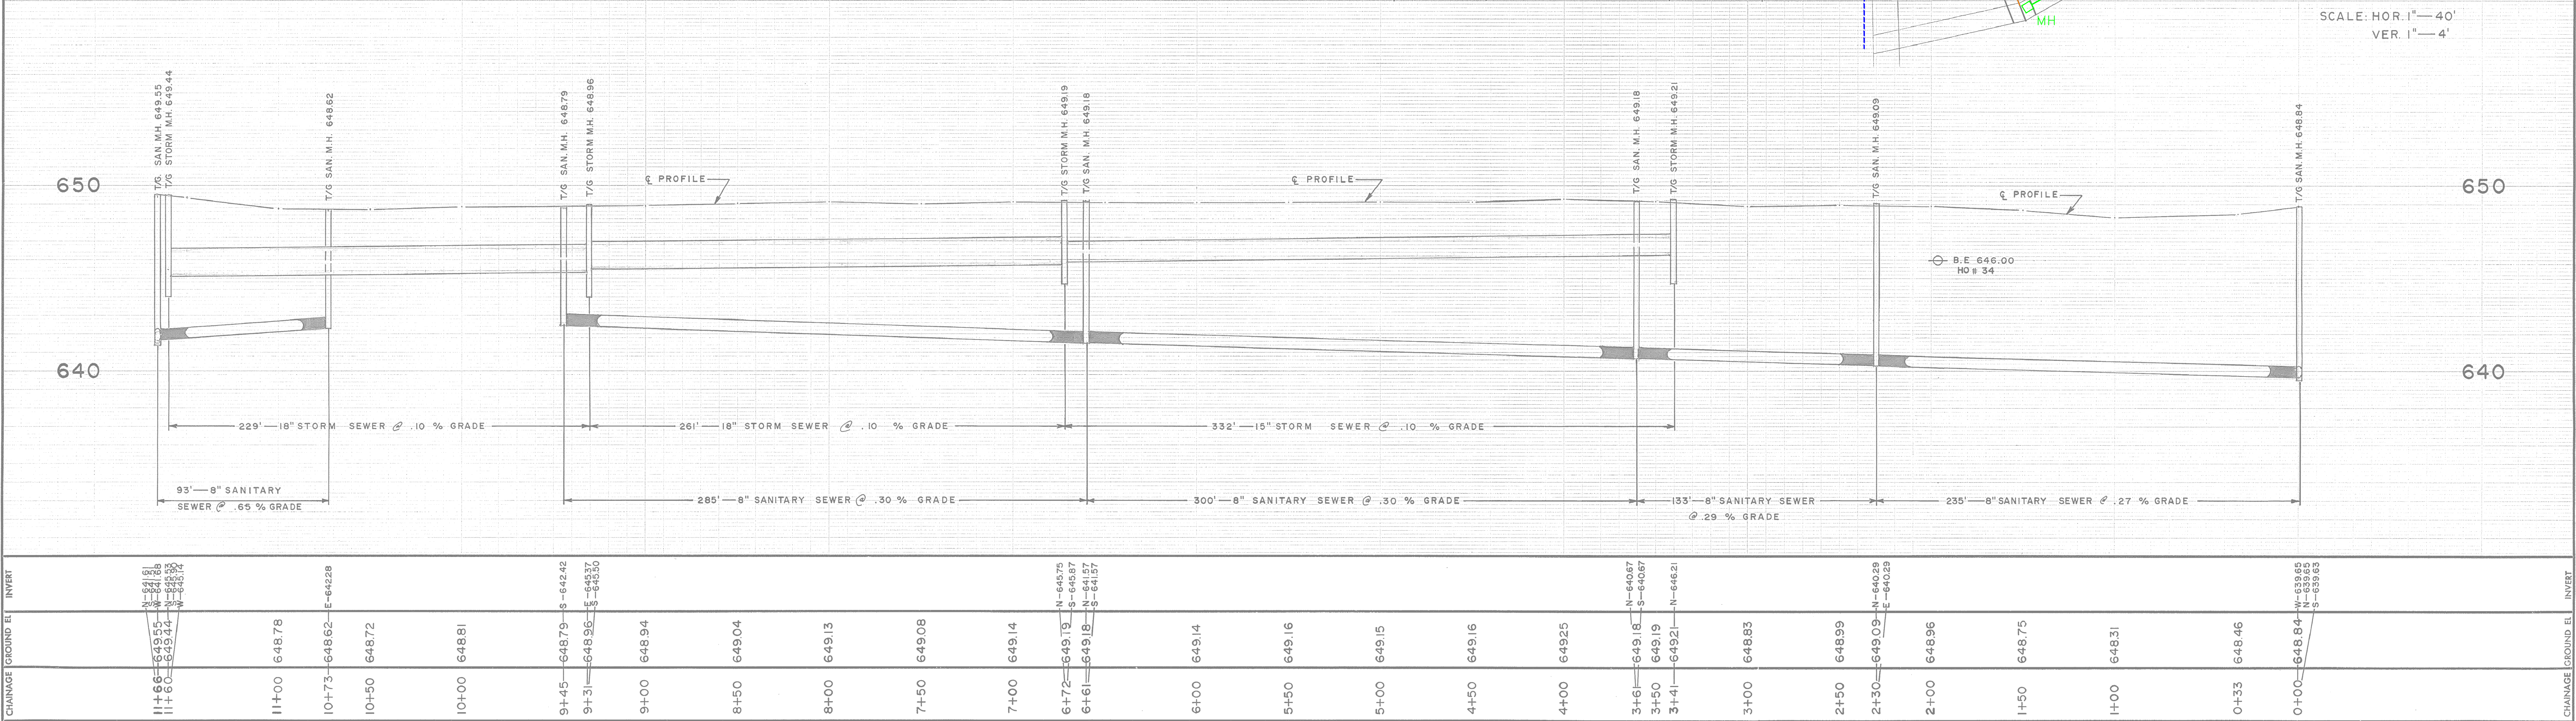


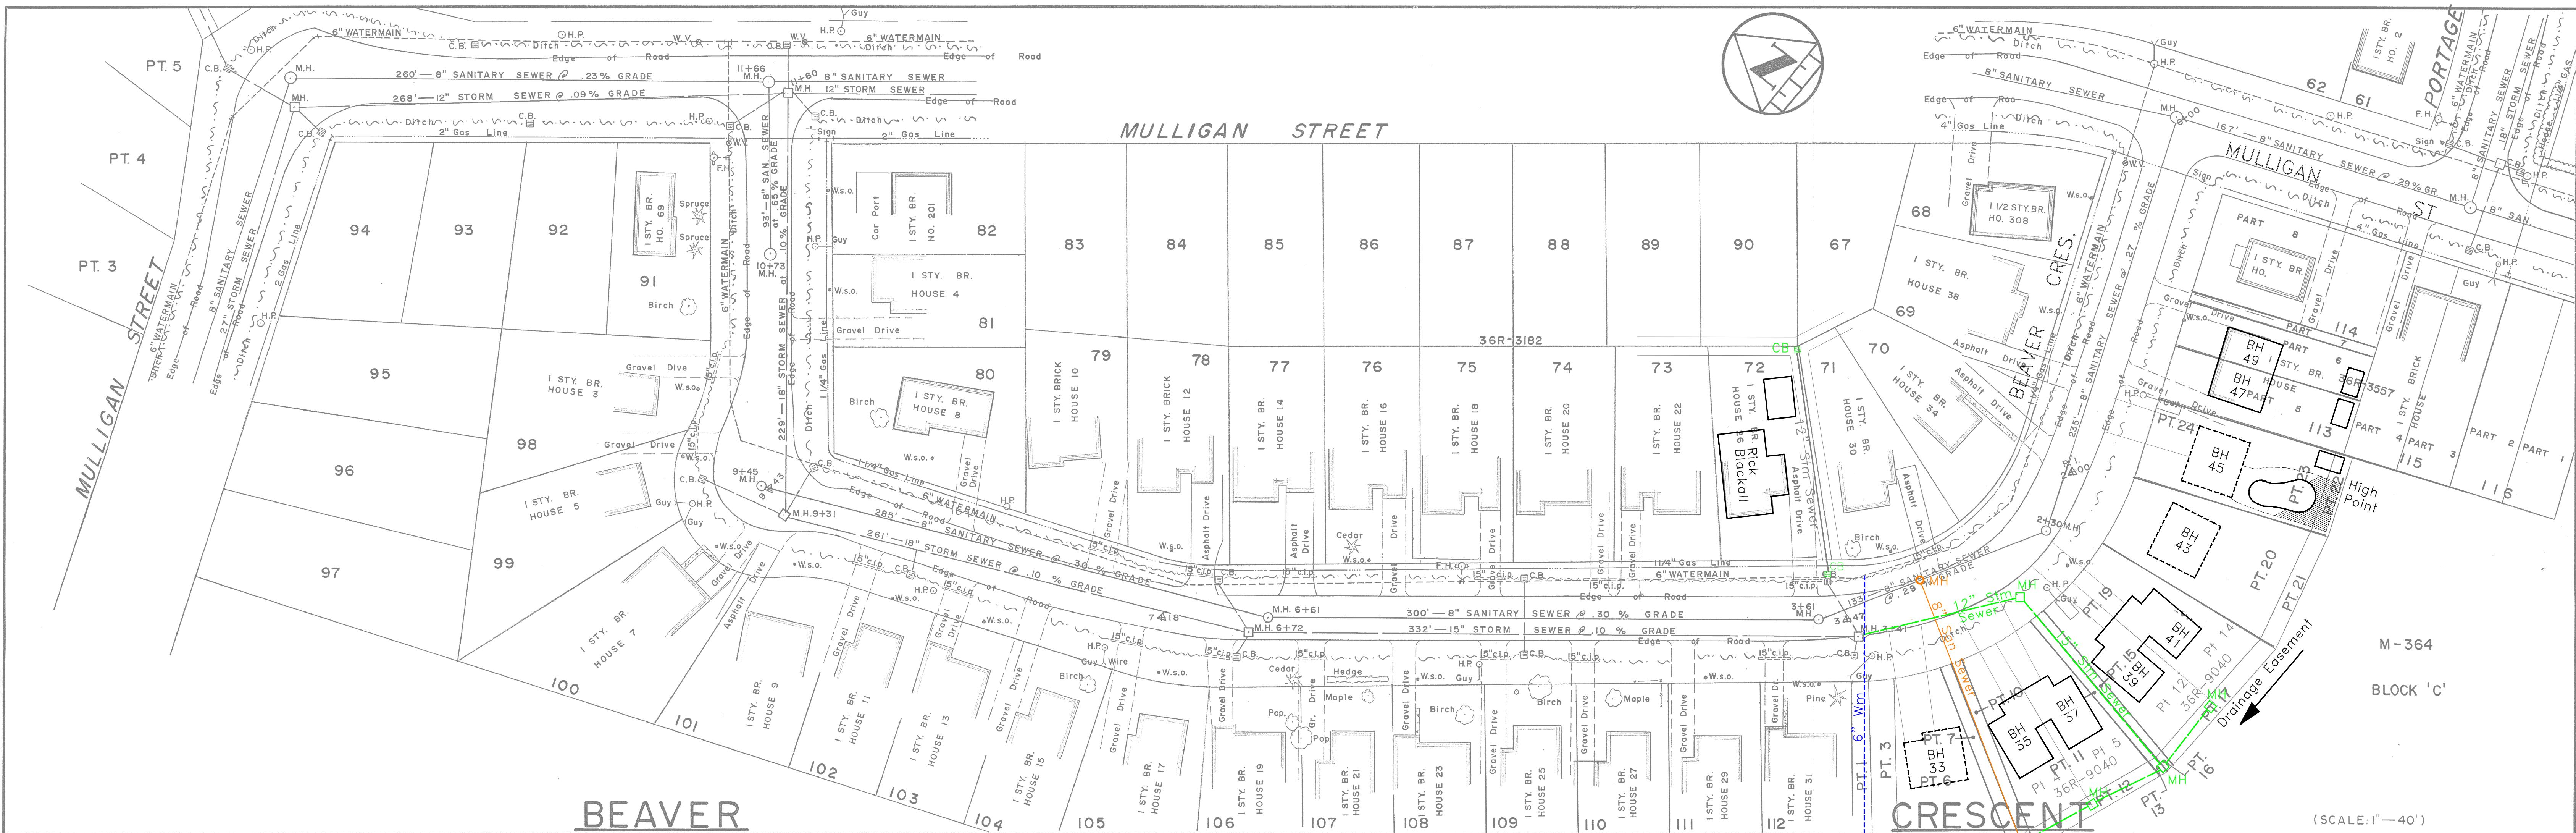

NOTES:

DISCLAIMER

1. NEW DRAWING.

2. ADD PLAN 36R-6814

3. Registered Plans Added.

MAY / 76

MAY 86

2006

A.P.

J.S.

r.f.b.

APPROVED

BEAVER CRESCENT

MULLIGAN ST. TO MULLIGAN ST.

REG'D PLAN N^o. M-364.

CITY OF NORTH BAY

ENGINEERING DEPARTMENT

SCALE: AS SHOWN.

DATE: MAY / 76

DRAWN BY: A.P.

CKD. BY:

FIELD BOOK No.

242

DRAWING No.

B-1076

REV.

DWG: 140

11-0-005 PLAJEWART 10