
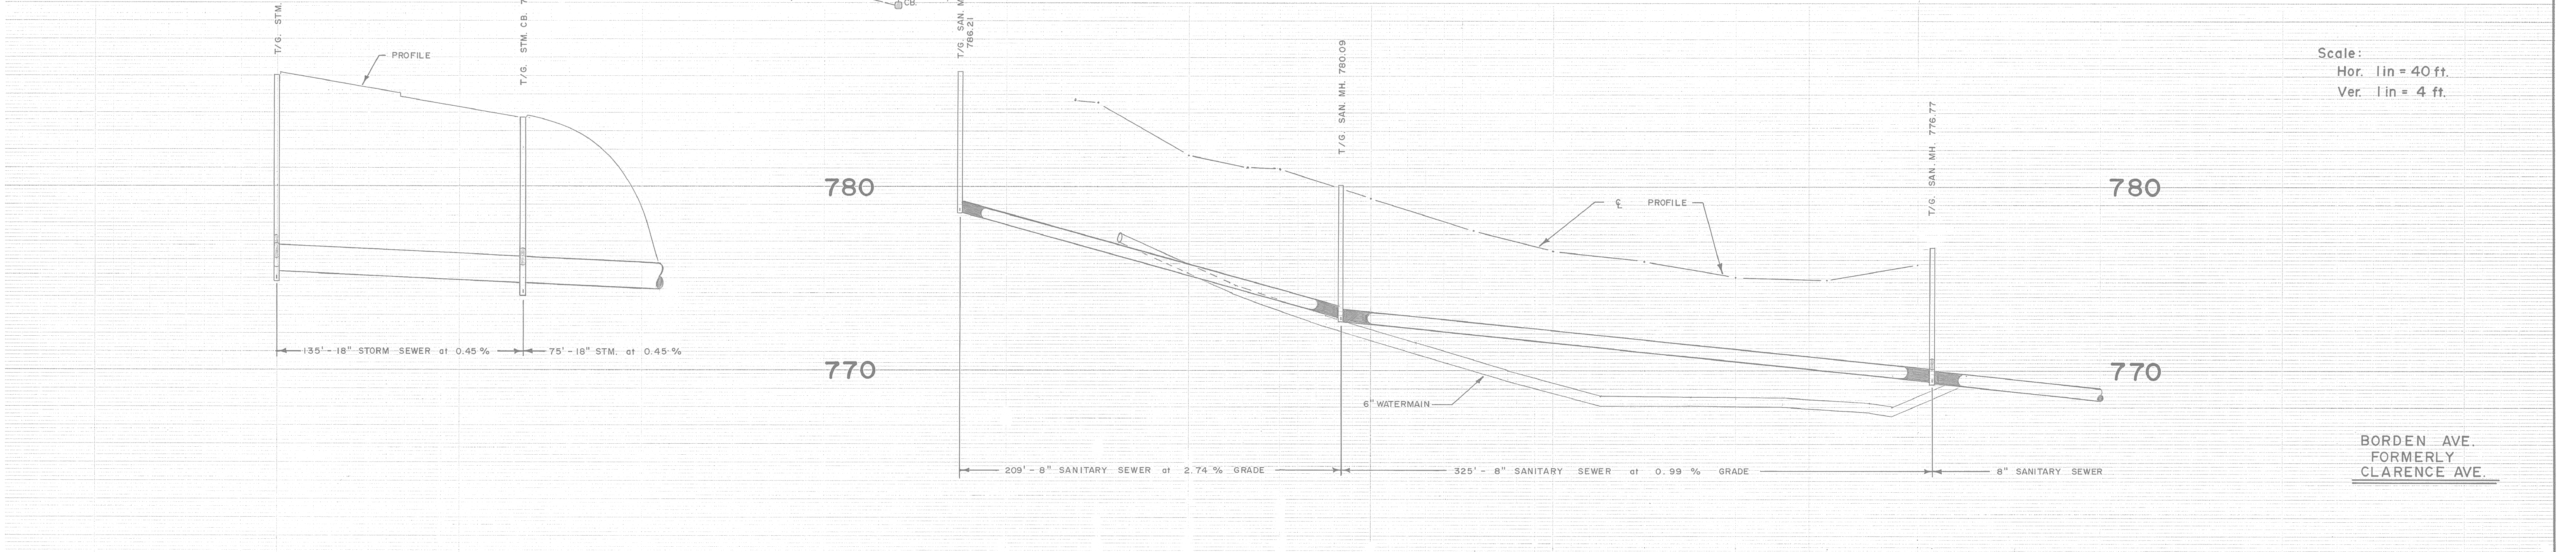


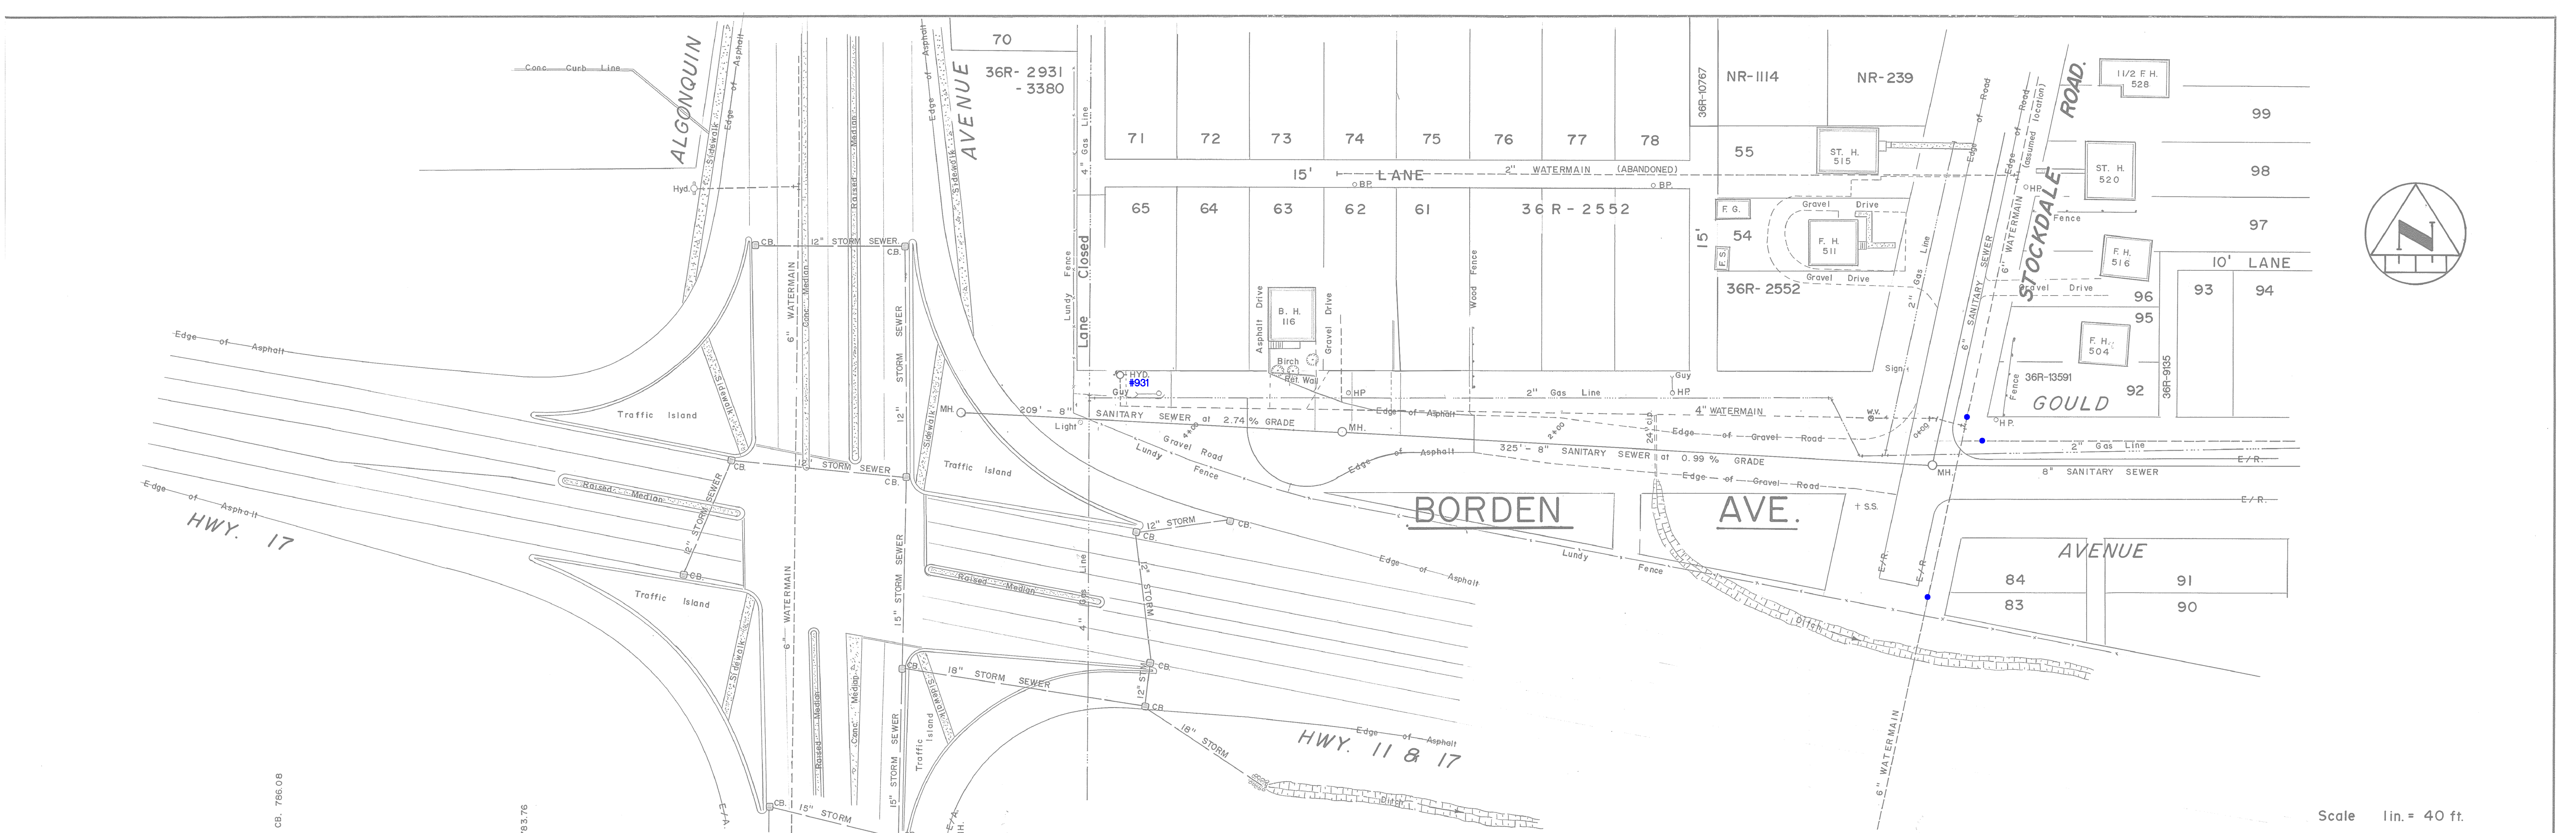

CHAINAGE		GROUND EL	INVERT
N-775.18 E-775.35 S-775.60			
N-775.74 E-774.75			
W-774.40			
E-778.56			
5 + 26			
5 + 00			
4 + 63	784.69		
4 + 50	784.53		
4 + 00	781.64		
3 + 69	781.00		
3 + 50	780.95		
3 + 17	772.63 E-772.64		
3 + 00	779.34		
2 + 44	777.59		
2 + 00	776.46		
1 + 50	775.69		
1 + 00	775.04		
0 + 50	774.89		
0 + 00	775.77 W-768.42 N-770.07 E-768.30		
0 + 08			
CHAINAGE		GROUND EL	INVERT

NOTES:

DISCLAIMER

The information contained on this drawing may be based upon data provided by others and may not have been verified by either as-constructed drawings or an Ontario Land Surveyor. The City of North Bay cannot accept responsibility for any errors or omissions on any information shown herein. Field verification, land surveys or excavation (with City approvals) may be required to determine actual location of any and all utilities or property lines.

1.	REVISED WATERMAINS.	JAN. 80	A.P.
2.	AS CONST'D 6" WATERMAIN FROM INSPECTOR'S DIARY	MAR. 82	T.M.
3.	Registered Plans Added.	May '07	rjo
No.	REVISION	DATE	INITIAL

BORDEN AVENUE	
STOCKDALE ROAD TO ALGONQUIN AVE	

CITY OF NORTH BAY

ENGINEERING DEPARTMENT

SCALE: AS SHOWN		DATE: APRIL 1979	
DRAWN BY: gjo	FIELD BOOK No. 252	DRAWING No. B-1126	REV.
CK'D. BY:			

ST-3-005 RAJESHART 01