


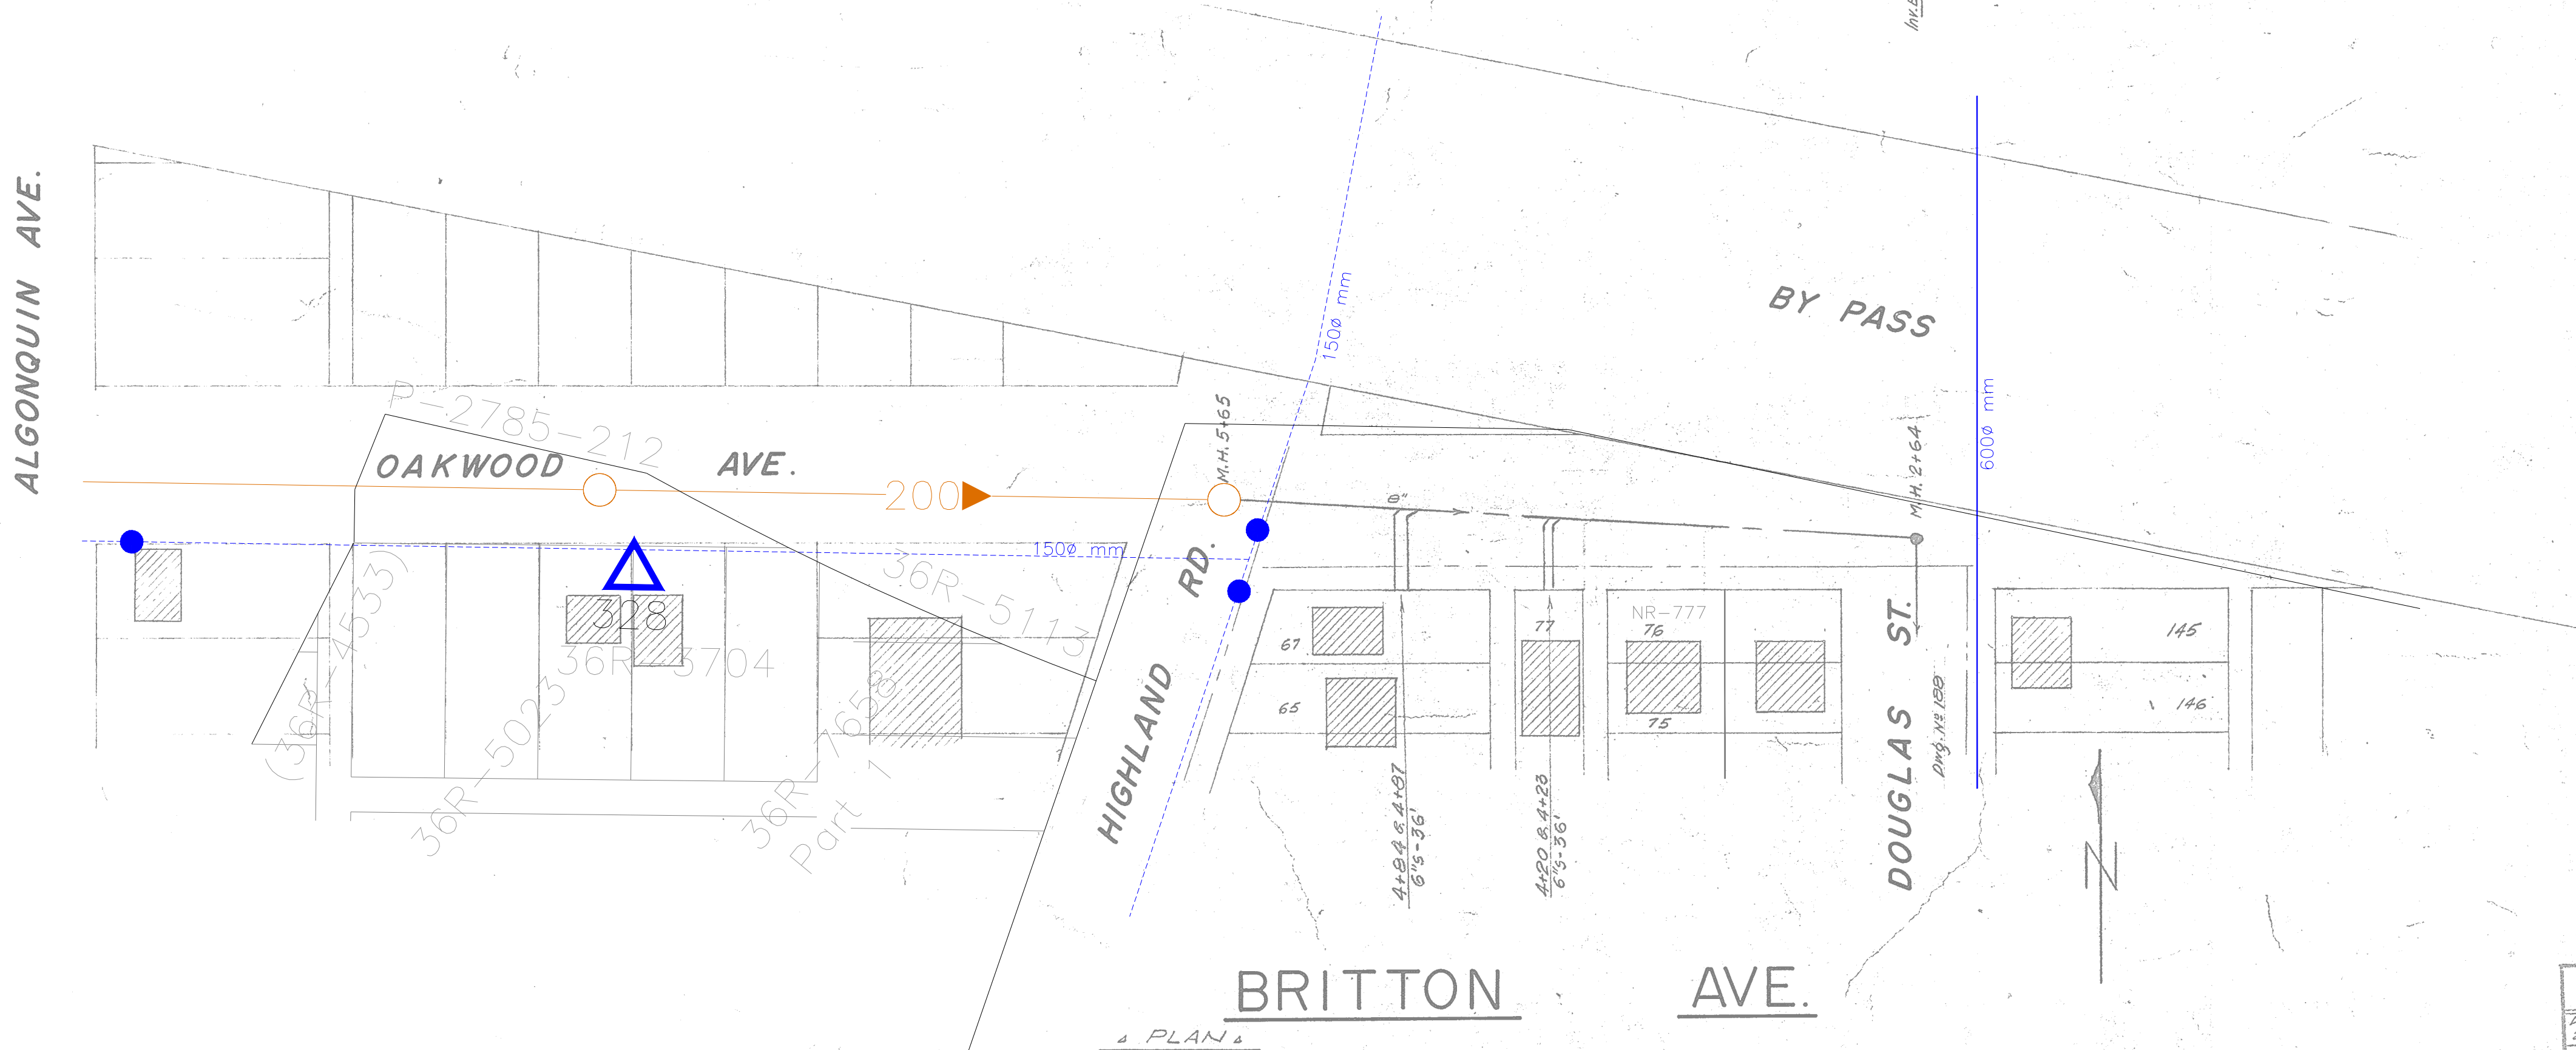

The information contained on this drawing may be based upon data provided by others and may not have been verified by either as-constructed drawings or an Ontario Land Surveyor. The City of North Bay cannot accept responsibility for any errors or omissions on any information shown herein. Field verification, land surveys or excavation (with City approvals) may be required to determine actual location of any and all utilities or property lines.

B-1151

LEGEND & NOTE: See DWG N° 156

[illegible]

TWP of WIDDIFIELD	
Mr. A. Carmichael Clerk NORTH BAY	Graham Reid & Associates Ltd. Consulting Engineers Toronto, Ontario
BRITTON AVE.	
HIGHLAND RD. TO DOUGLAS ST.	
No. 192	As Shown
Date: April 25, 58	Scale: AS SHOWN SIGNED: [Signature] TAMM

