
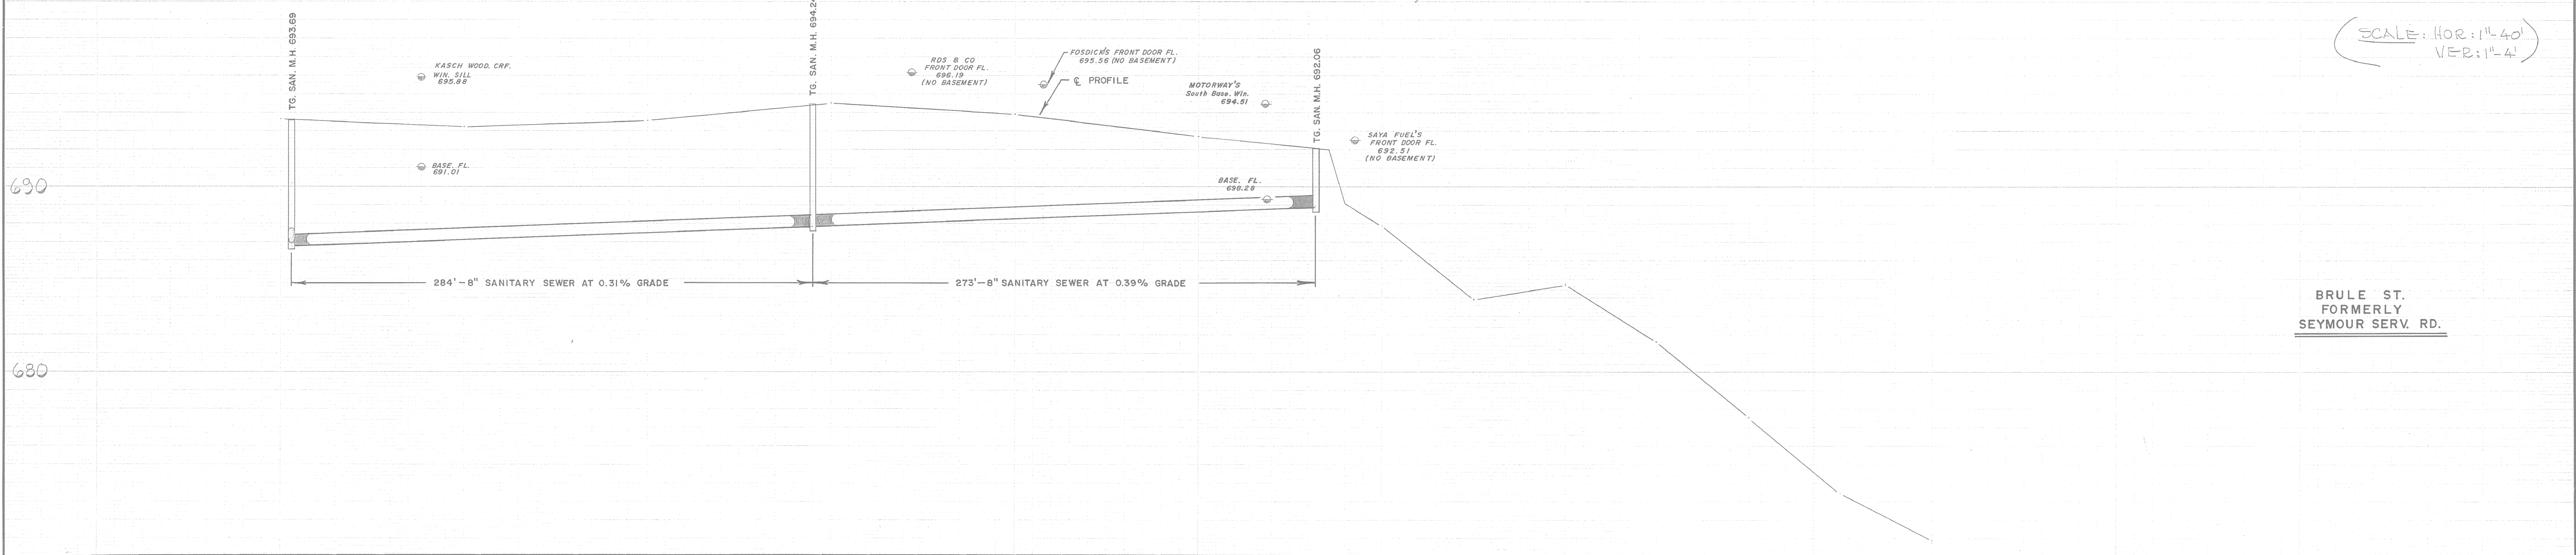


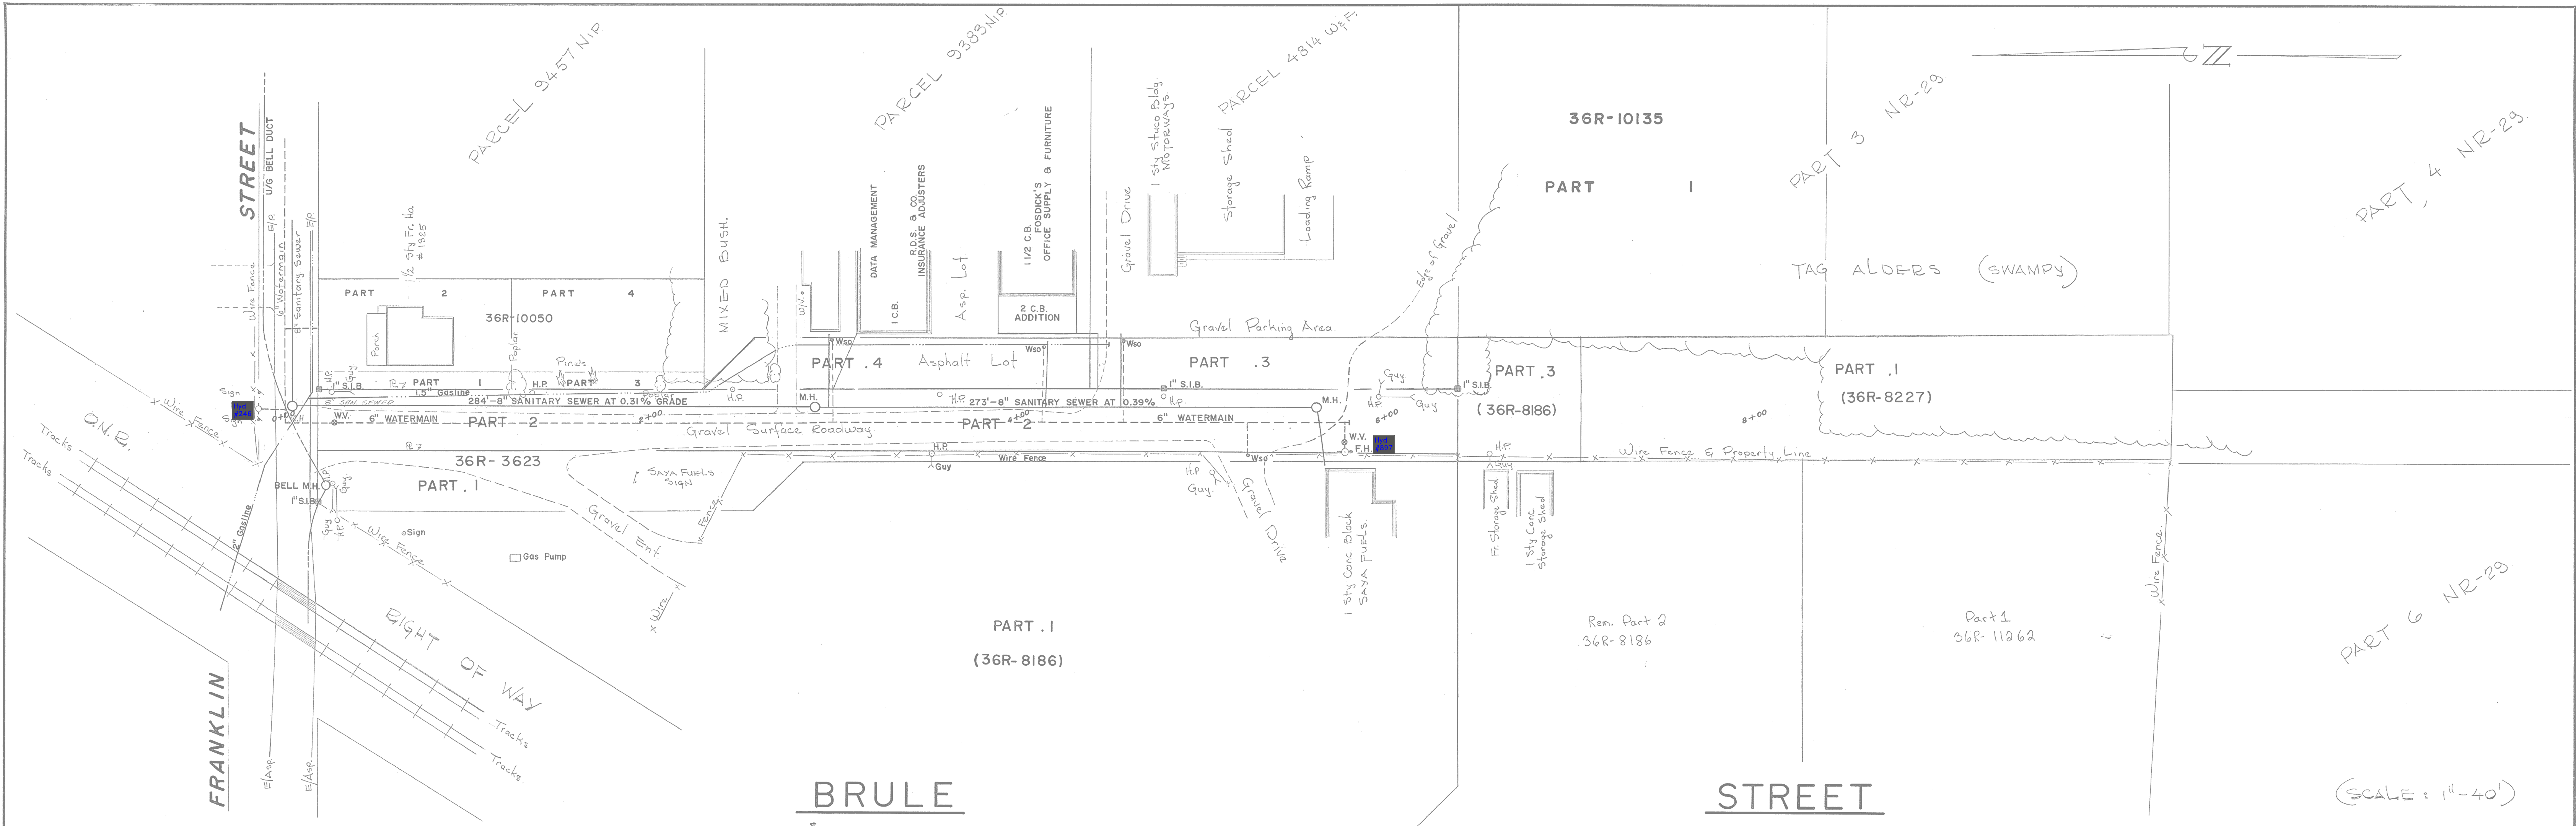

CHANCE	GROUND EL	INVERT
0+00	693.65	E-686.77 S-686.92
0+06		
1+00	693.21	
2+00	693.58	
2+90		N-687.81 S-687.66
3+00	694.49	
4+00	693.91	
5+00	692.66	
5+57		N-688.92 SW-688.94
5+63	691.44	
6+00	687.86	
6+50	683.91	
7+00	684.69	
7+50	681.61	
8+00	677.54	
8+50	673.44	
9+00	670.83	
10+00		
11+00		
CHANCE	GROUND EL	INVERT

NOTES:

DISCLAIMER
The information contained on this drawing may be based upon data provided by others and may not have been verified by either as-constructed drawings or an Ontario Land Surveyor. The City of North Bay cannot accept responsibility for any errors or omissions on any information shown herein. Field verification, land surveys or excavation (with City approvals) may be required to determine actual location of any and all utilities or property lines.

1	REVISIONS TO PROPERTY LINES	SEPT 76	J.D.M.
2	REVISE & PROFILE FRANKLIN - END	JUNE 83	J.S.
3	BASEMENT FLOOR & FLOOR ELEV	JUNE 83	R.B.
4	AS CONST. SAN., W.M. CONT. 115-84 BK. 276	OCT. 85	J.S.
No.	REVISION	DATE	INITIAL

APPROVED

**NORTH BAY**
ONTARIO-CANADA
Just North Enough to be PERFECT

BRULE STREET	
FRANKLIN STREET TO END OF ROAD	
REGISTERED PLAN: NR-28, 36R-3623	

CITY OF NORTH BAY	
ENGINEERING DEPARTMENT	
SCALE: AS SHOWN	DATE: APRIL 73.
DRAWN BY: KSB	FIELD BOOK No.
CK'D. BY:	#227
	DRAWING No.
	B-1176
	REV.