

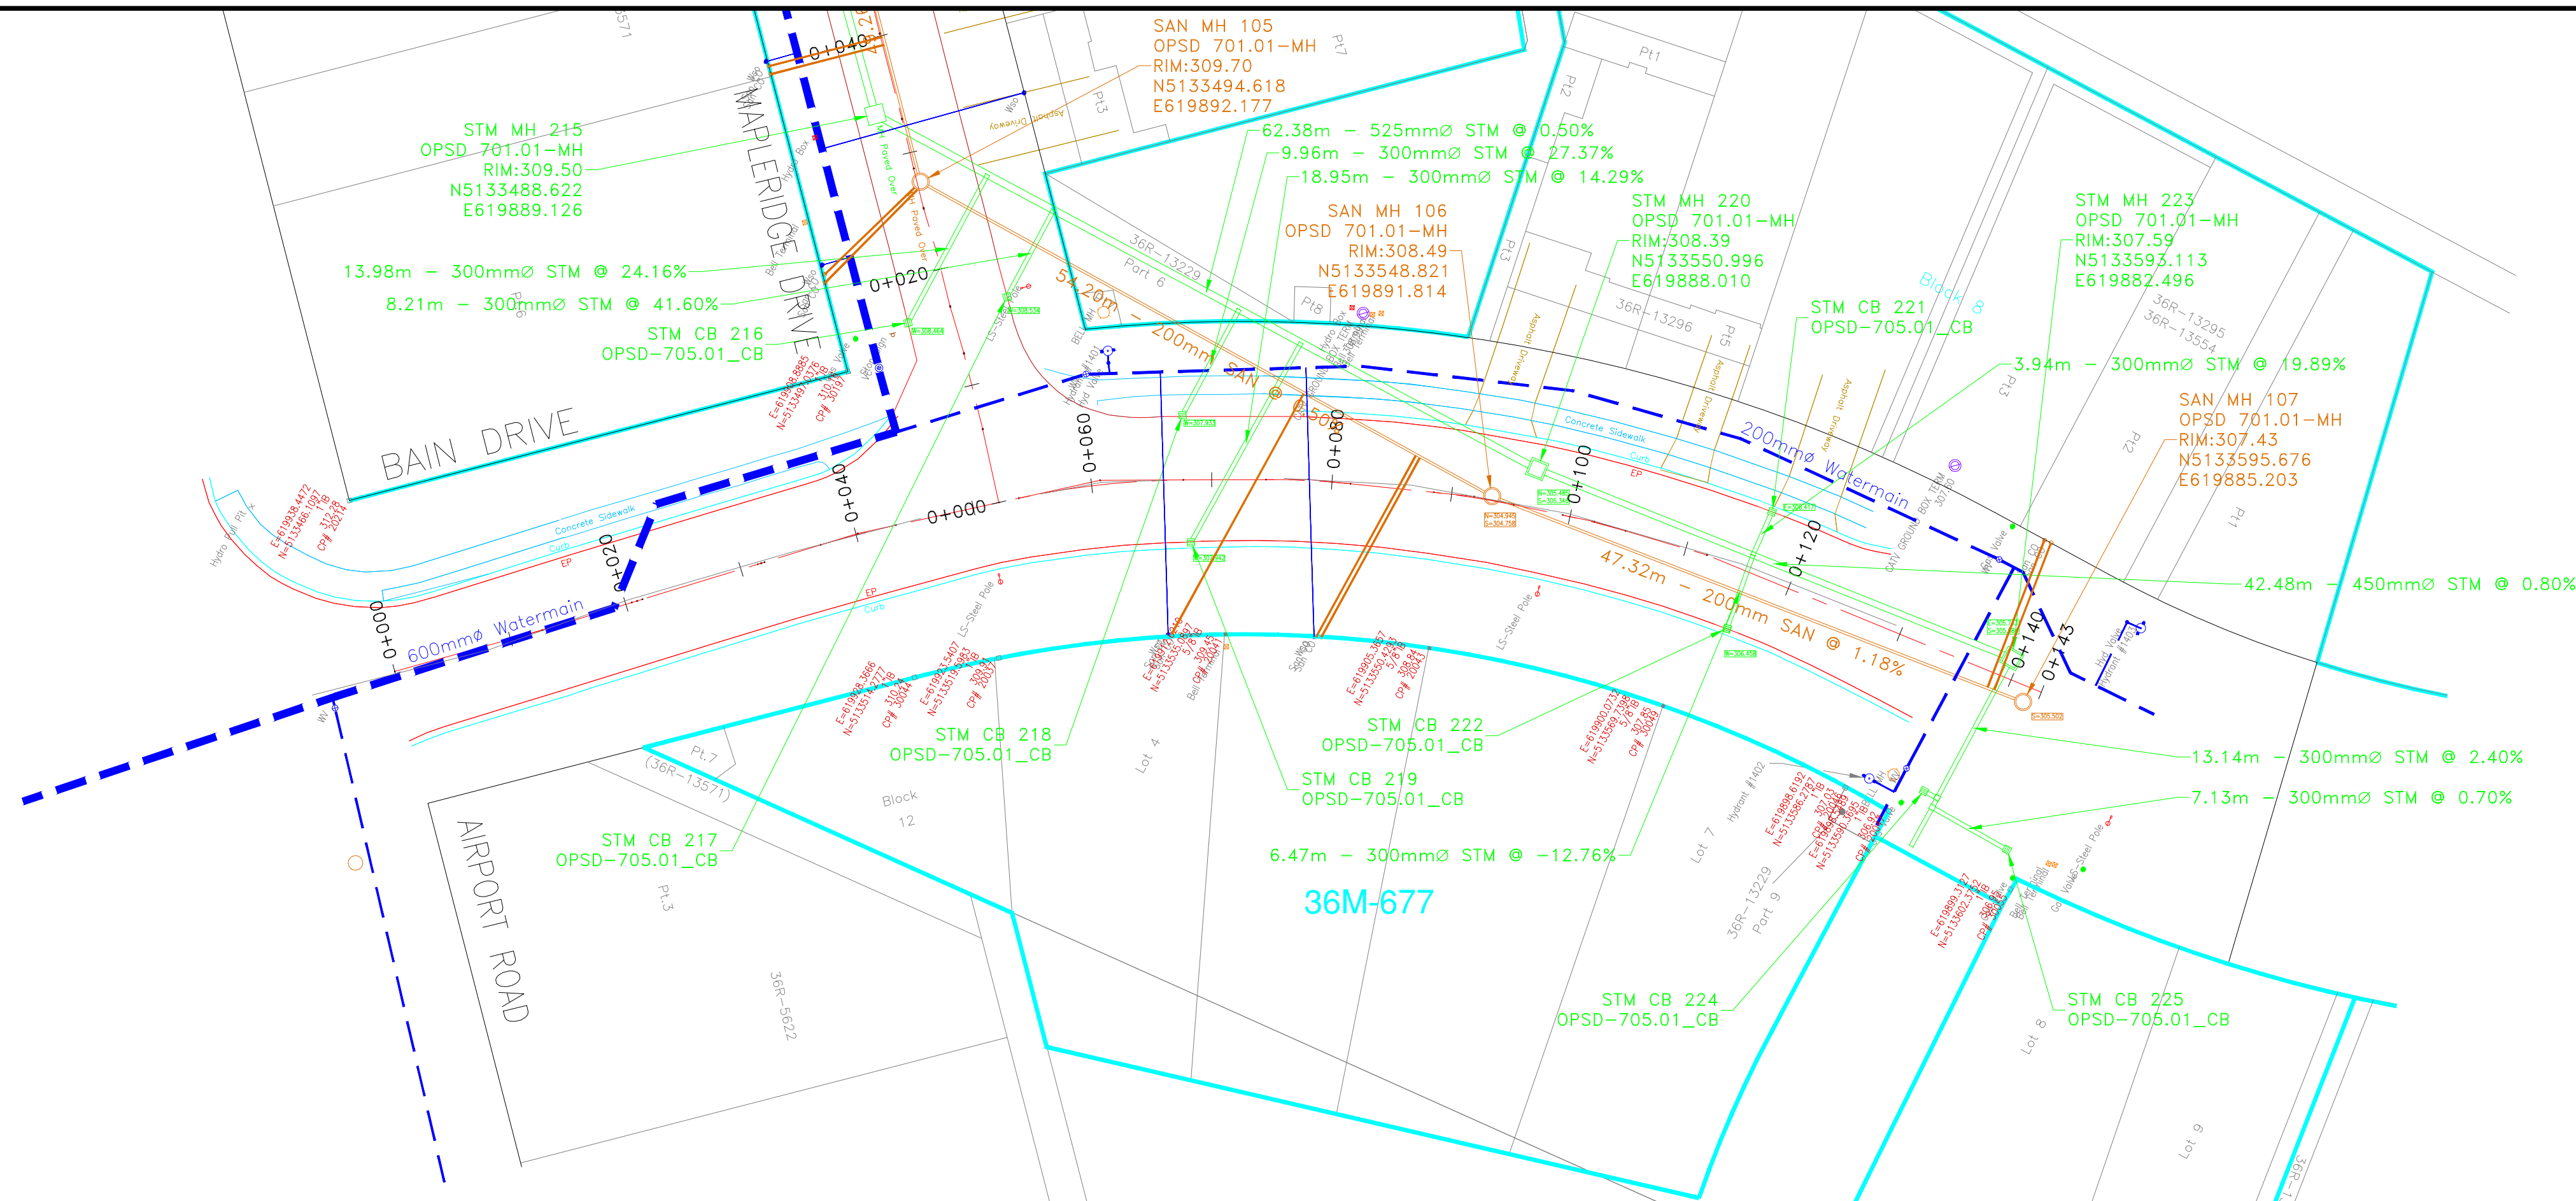
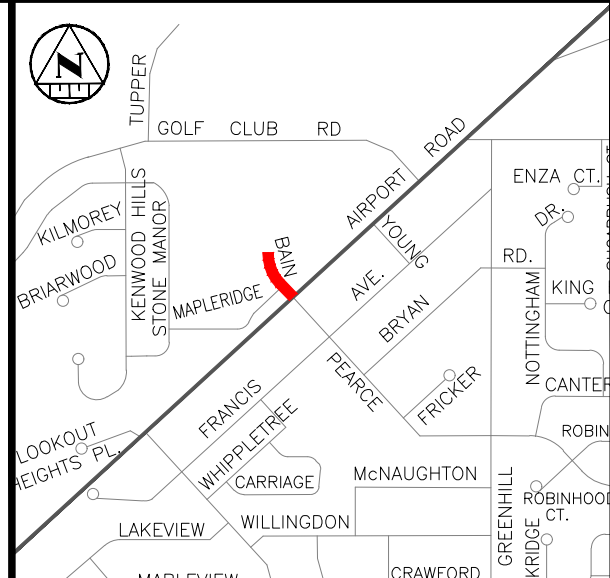


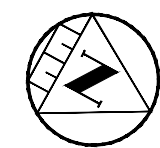

Bain Drive PROFILE

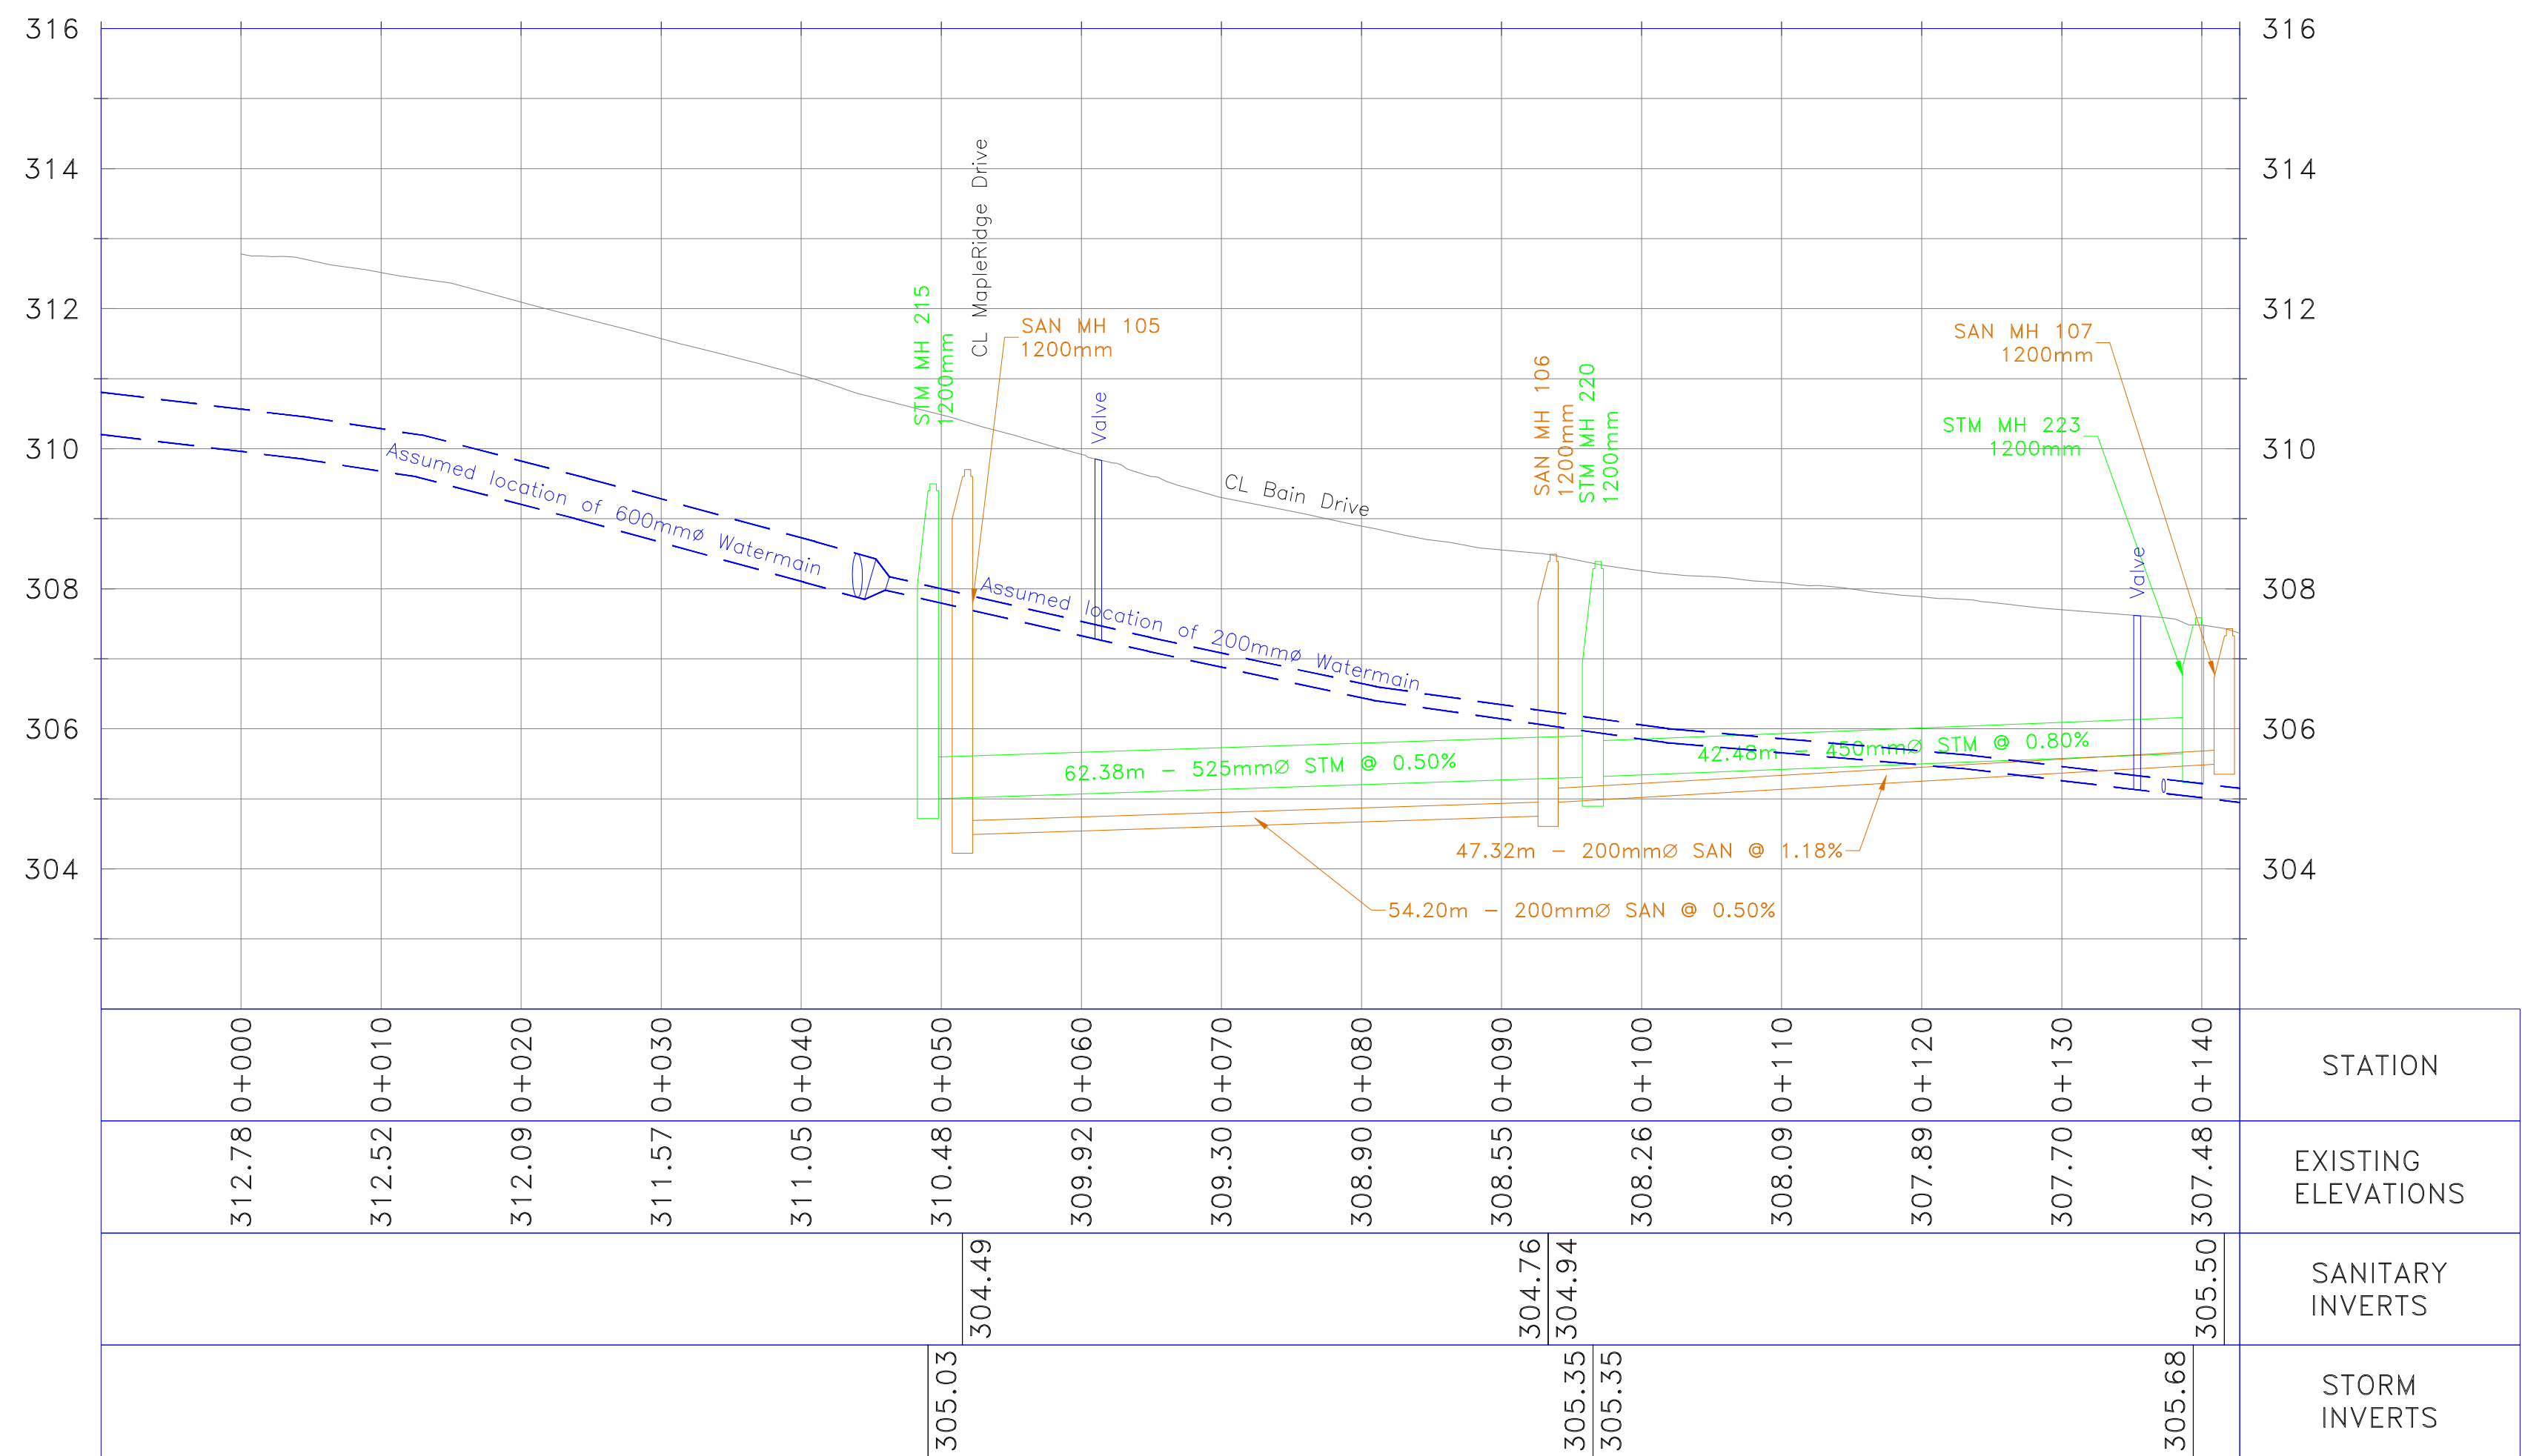

KEY PLAN

LEGEND

- STORMWATER PIPE
- SANITARY PIPE
- WATERMAIN & VALVES
- LOT / CONCESSION LINES
- M-Plan Lines
- FIELD MEASURED INVERT
- CATCH BASIN
- STORM MANHOLE
- SANITARY MANHOLE
- EDGE OF PAVEMENT
- CURB
- HYDRO POLL/LIGHT

REVISIONS

no.	date	by	description
1	Dec 12/14	GWC	As-Built

Disclaimer

The information contained on this drawing may be based upon data provided by others and may not have been verified by either as-constructed drawings or an Ontario Land Surveyor. The City of North Bay cannot accept responsibility for any errors or omissions on any information shown herein. Field verification, land surveys or excavation (with City approvals) may be required to determine actual location of any and all utilities or property lines.



BAIN DRIVE
PLAN & PROFILE

As-Built

BAIN DR.
from AIRPORT
to END

designer G.W.C.	drawn by: G.W.C.
checked by: D.P.N.	approved by: A.J.L.
scale H: 1:400 V: 1:80	
date 12/12/2014	drawing number B-1281