


BAYWOOD

STREET

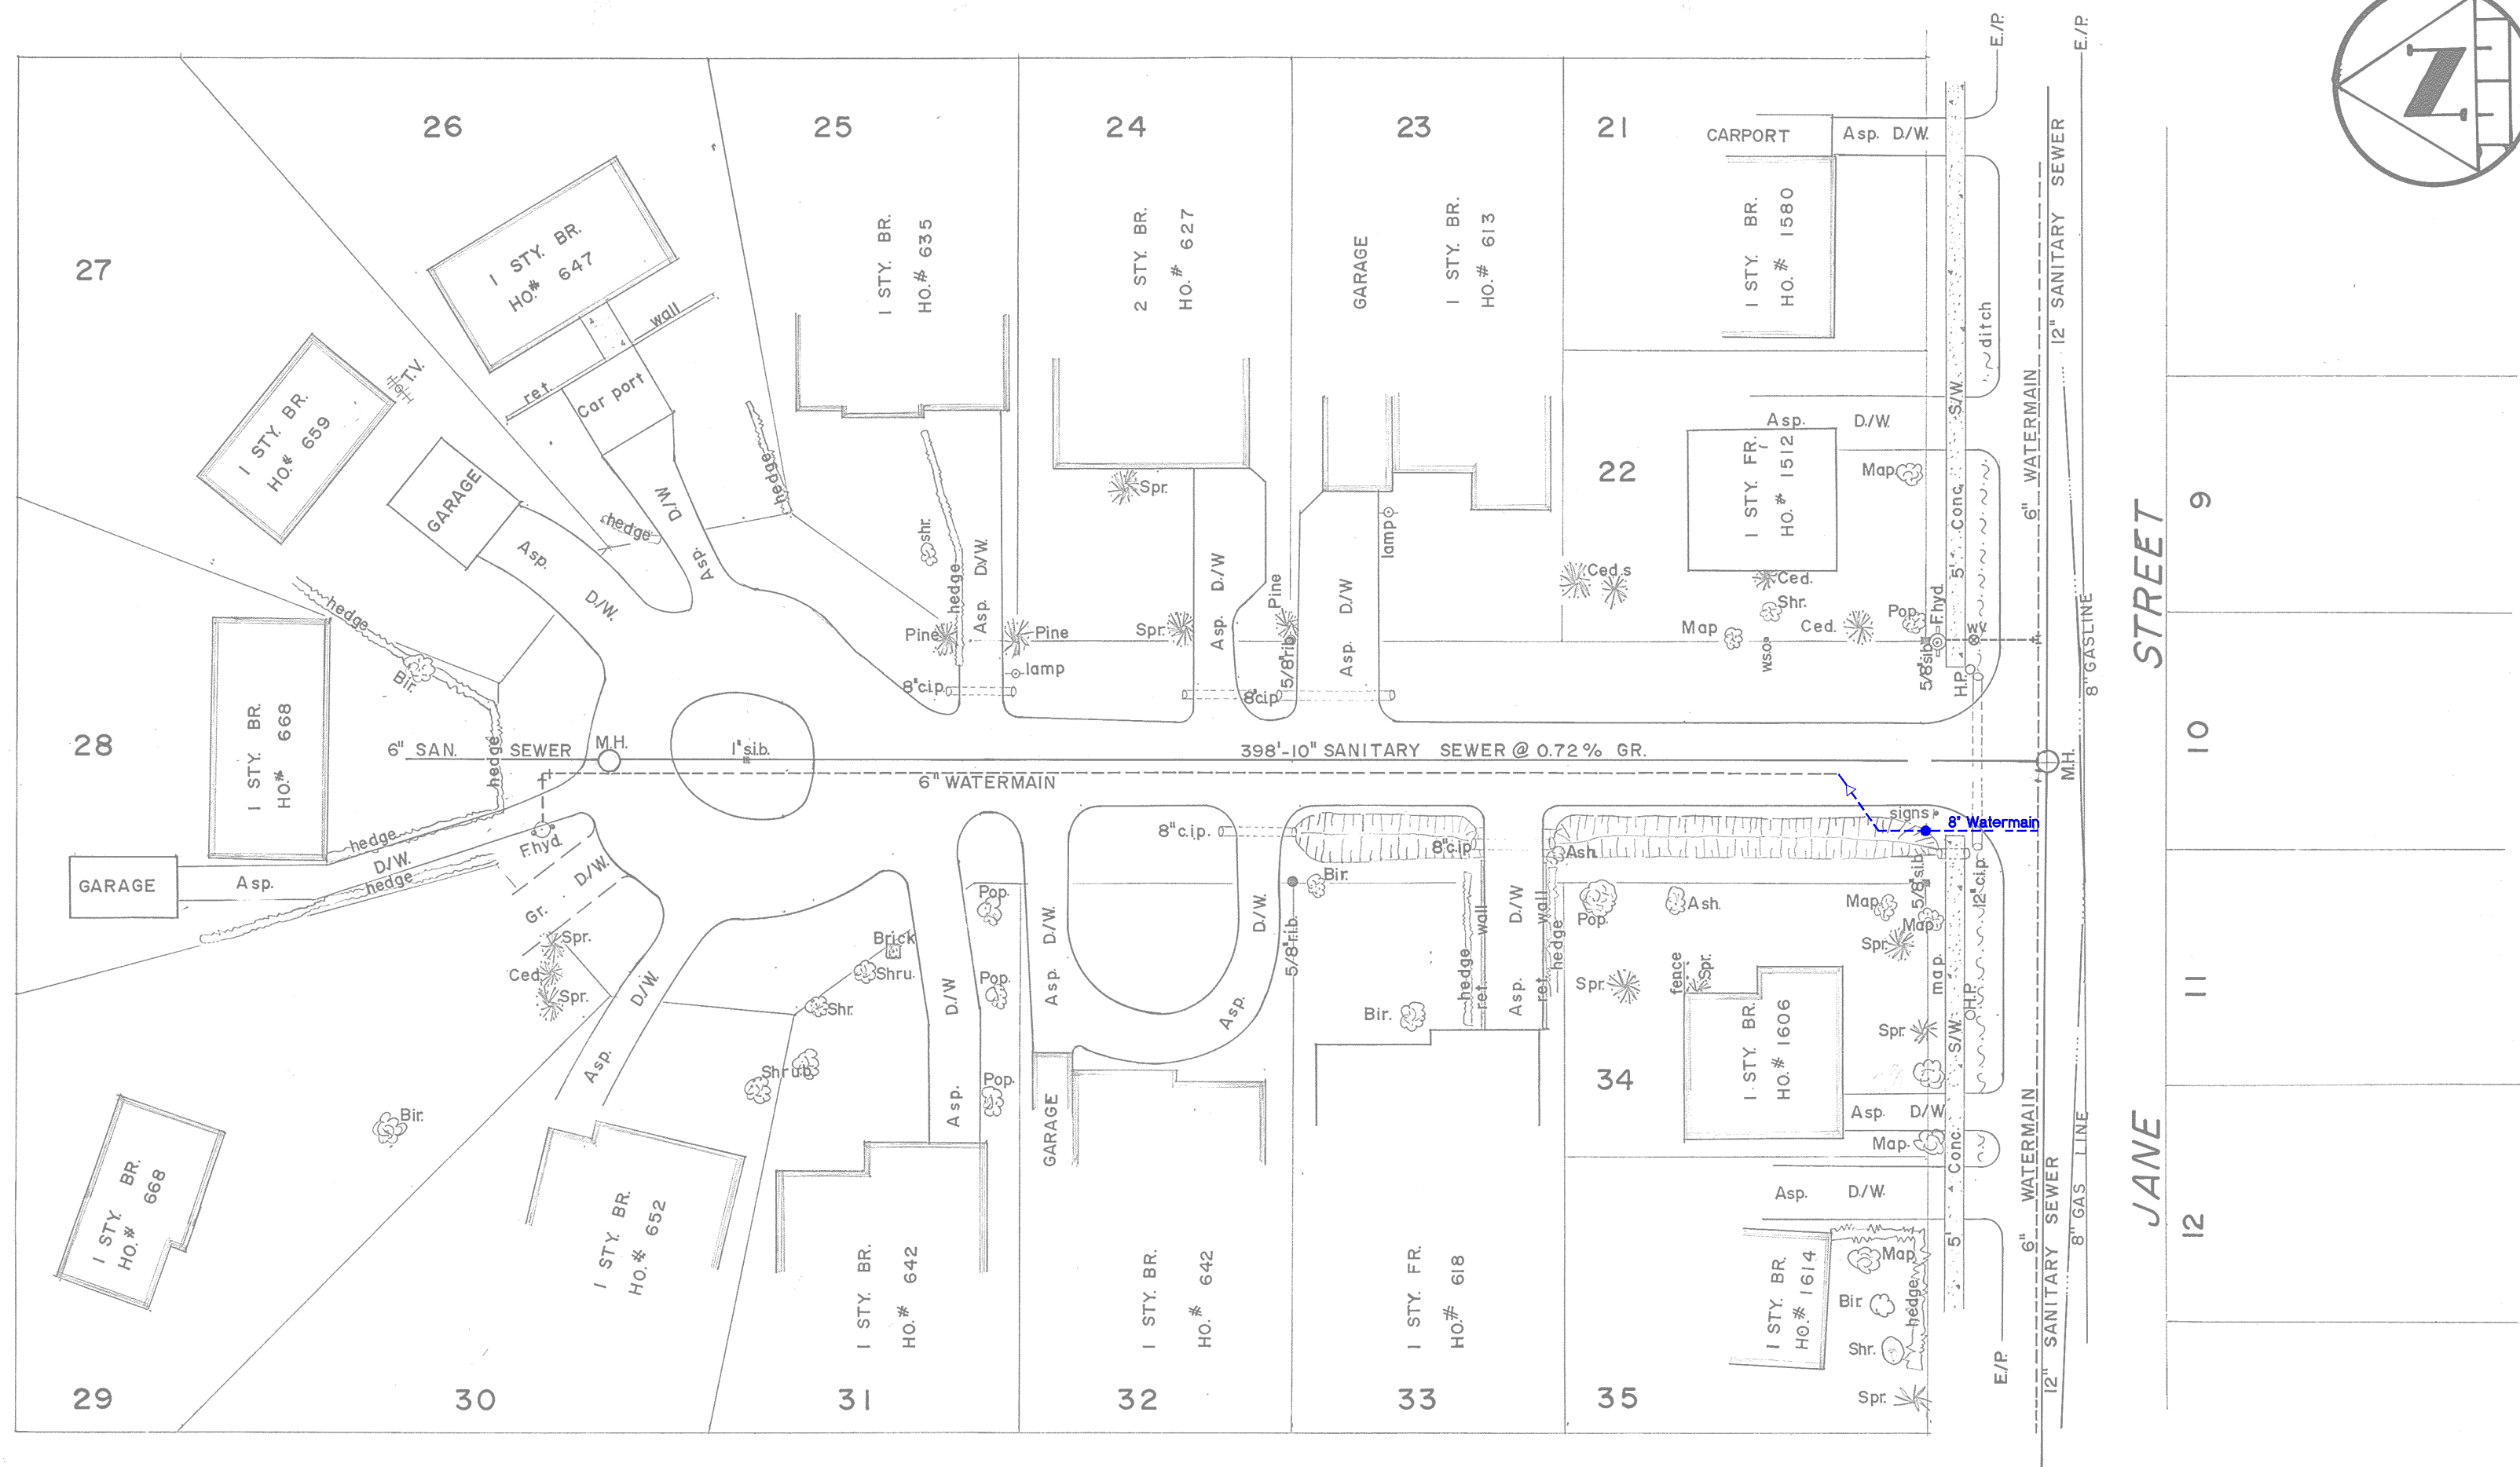


SCALE: 1 in. = 40 ft

710

700

710

700

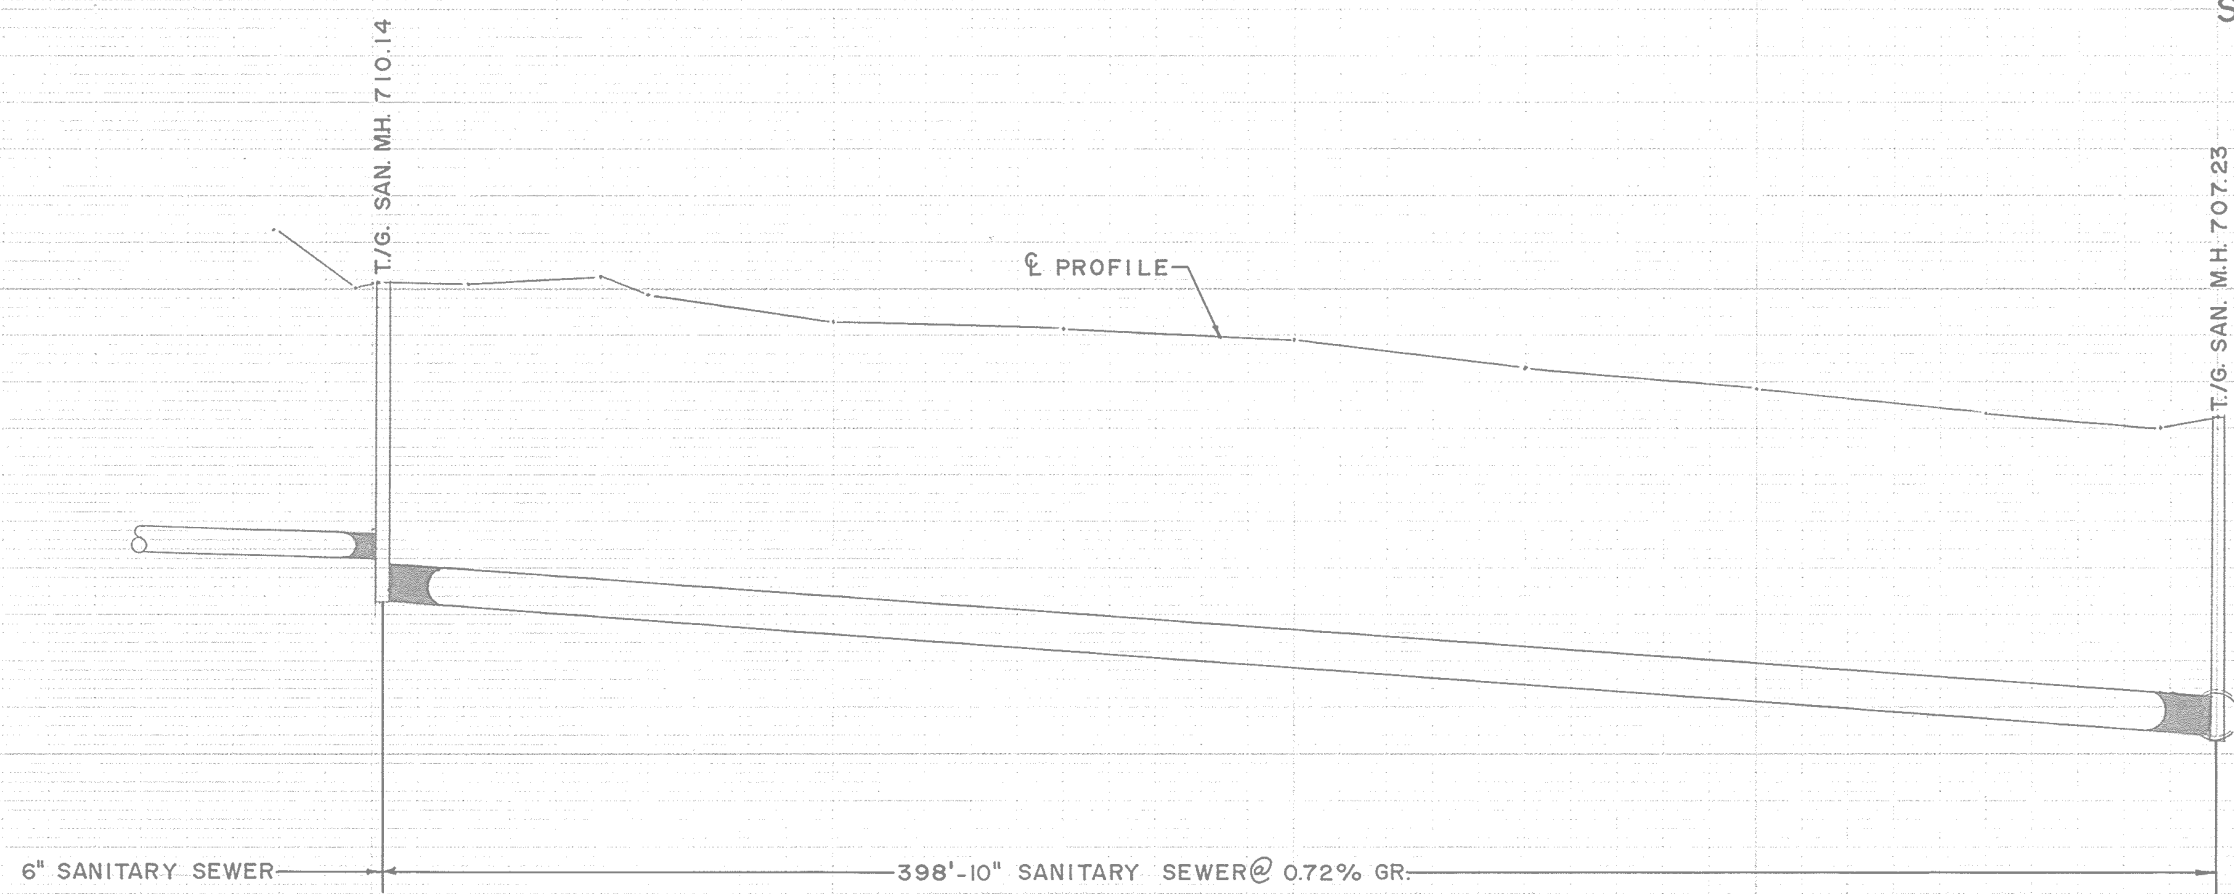

SCALE: hor. 1 in. = 40 ft
ver. 1 in. = 4 ft

DWG. 10'-	NOTES: DISCLAIMER The information contained on this drawing may be based upon data provided by others and may not have been verified by either as-constructed drawings or an Ontario Land Surveyor. The City of North Bay cannot accept responsibility for any errors or omissions on any information shown herein. Field verification, land surveys or excavation (with City approvals) may be required to determine actual location of any and all utilities or property lines.		1'-	NEW DRAWING	15/10/73	G.W.R.	APPROVED	BAYWOOD STREET		CITY OF NORTH BAY	
			2-	Watermain change • Jane St.	Feb. '08	r.j.o.		JANE STREET TO END		ENGINEERING DEPARTMENT	
								REG.D. PLAN N ^o 114		SCALE: AS SHOWN DATE: OCT. 1973	
								116			
								DRAWN BY: G.W.R.	FIELD BOOK No.	DRAWING No.	REV.
				No.	REVISION	DATE	INITIAL	CK'D. BY:	228	B-251	