



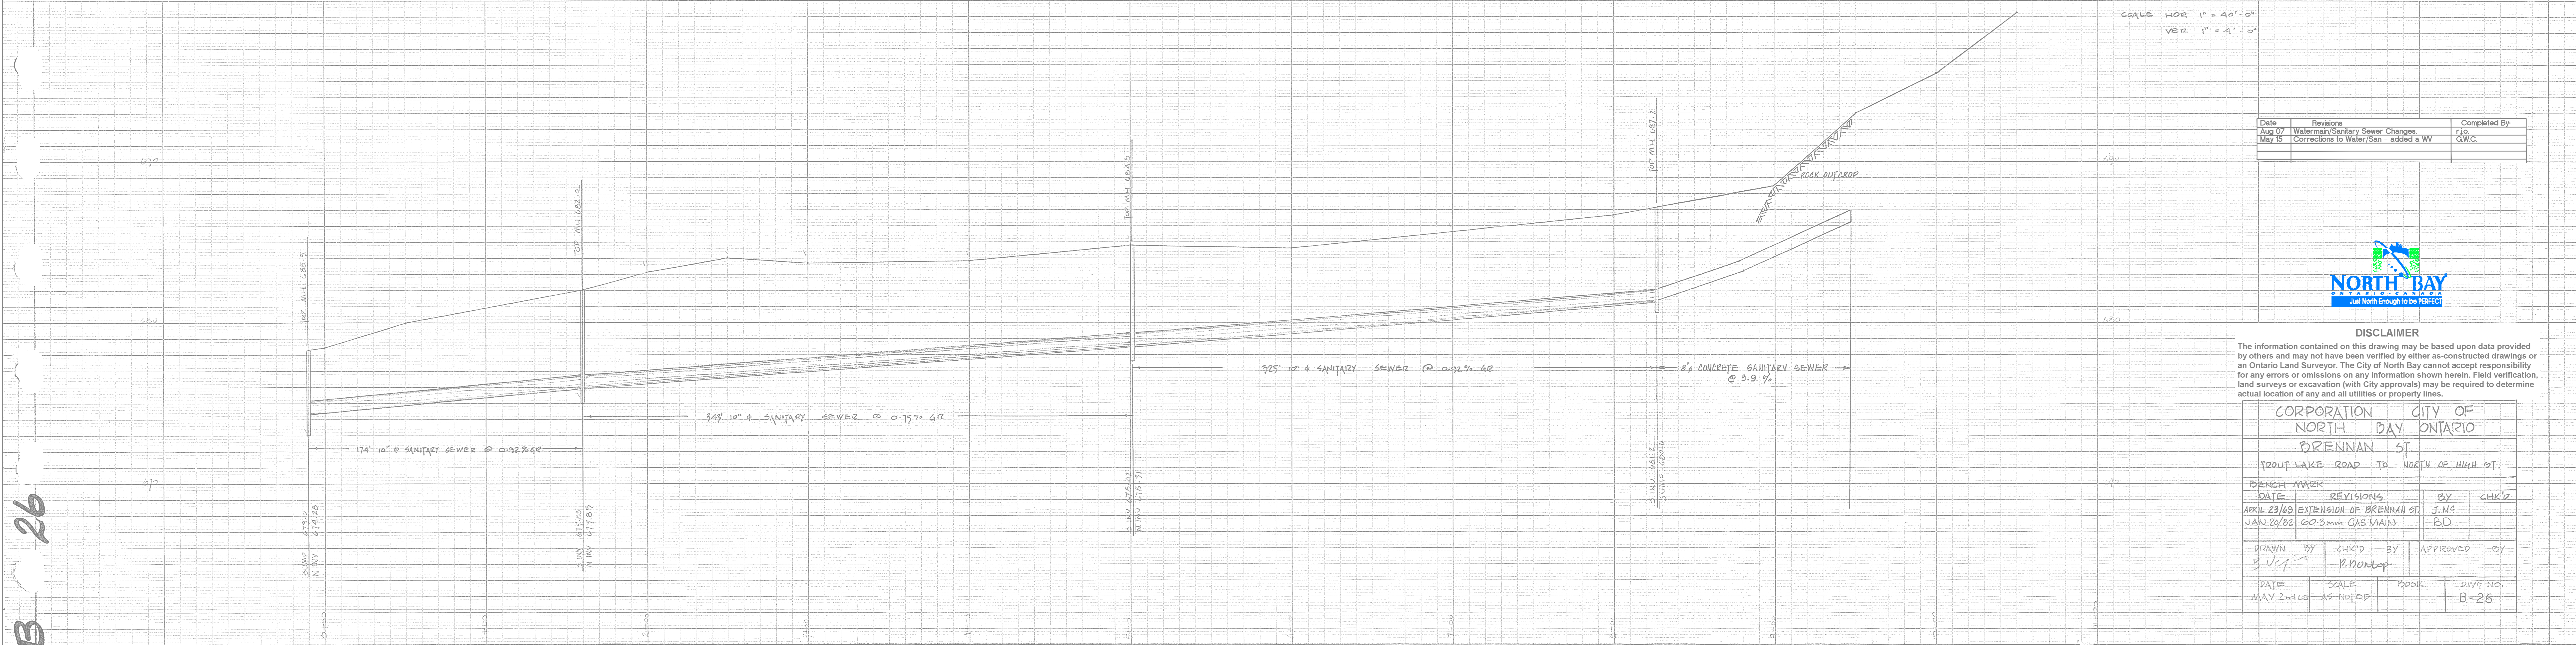

Date	Revision	Completed By
APR 23/09	Extension of Brennan St	JMS
MAY 15	Correction to Watermain - added a WV	LEW

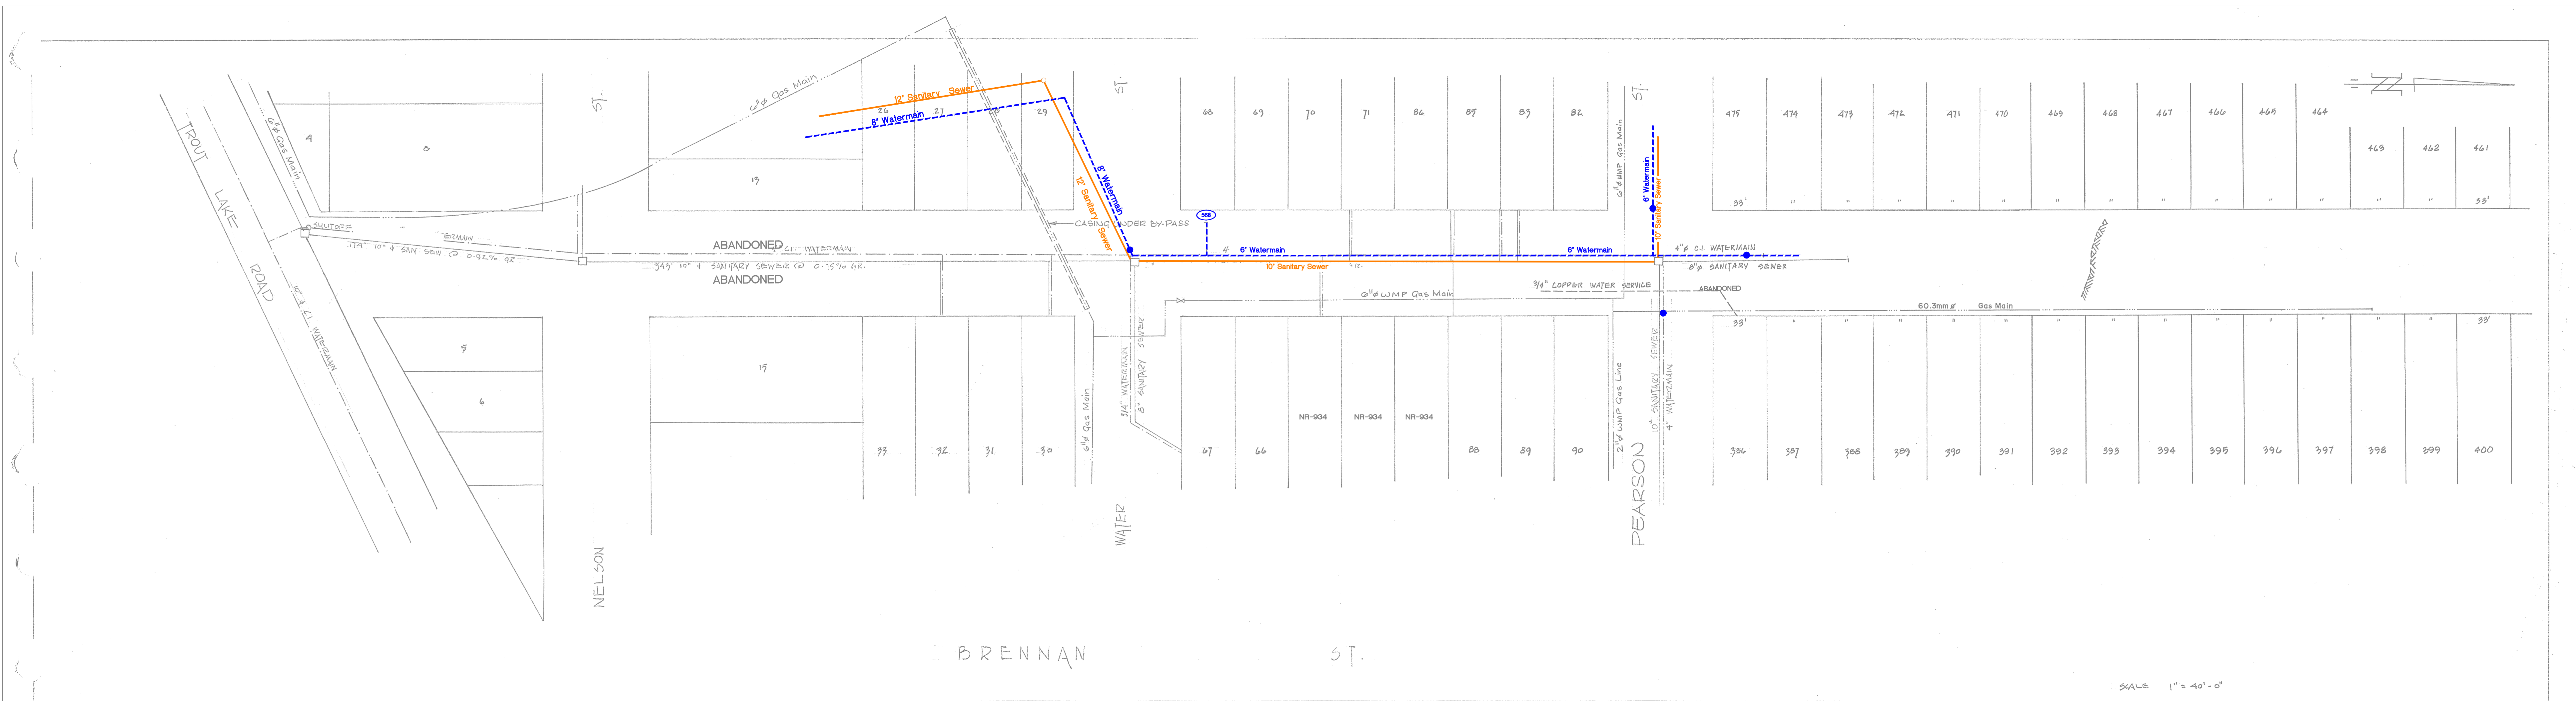

DISCLAIMER

The information contained on this drawing may be based upon data provided by others and may not have been verified by either as-constructed drawings or an Ontario Land Surveyor. The City of North Bay cannot accept responsibility for any errors or omissions on any information shown herein. Field verification, land surveys or excavation (with City approvals) may be required to determine actual location of any and all utilities or property lines.

CORPORATION CITY OF NORTH BAY ONTARIO			
BRENNAN ST			
FOOT LAKE ROAD TO NORTH OF NINA ST.			
DESIGN - WATER	DATE	REVISIONS	BY
APRIL 23/09	EXTENSION OF BRENNAN ST	JMS	CHK'D
JAN 08/02	600mm GAS MAIN	B.D.	
DRAWN BY	CHK'D BY	BY	APPROVED BY
J. LEWIS	J. BODOLPH		
DATE	SCALE	PROJECT	PROJECT NO.
MAY 2008	AS NOTED		B-26