

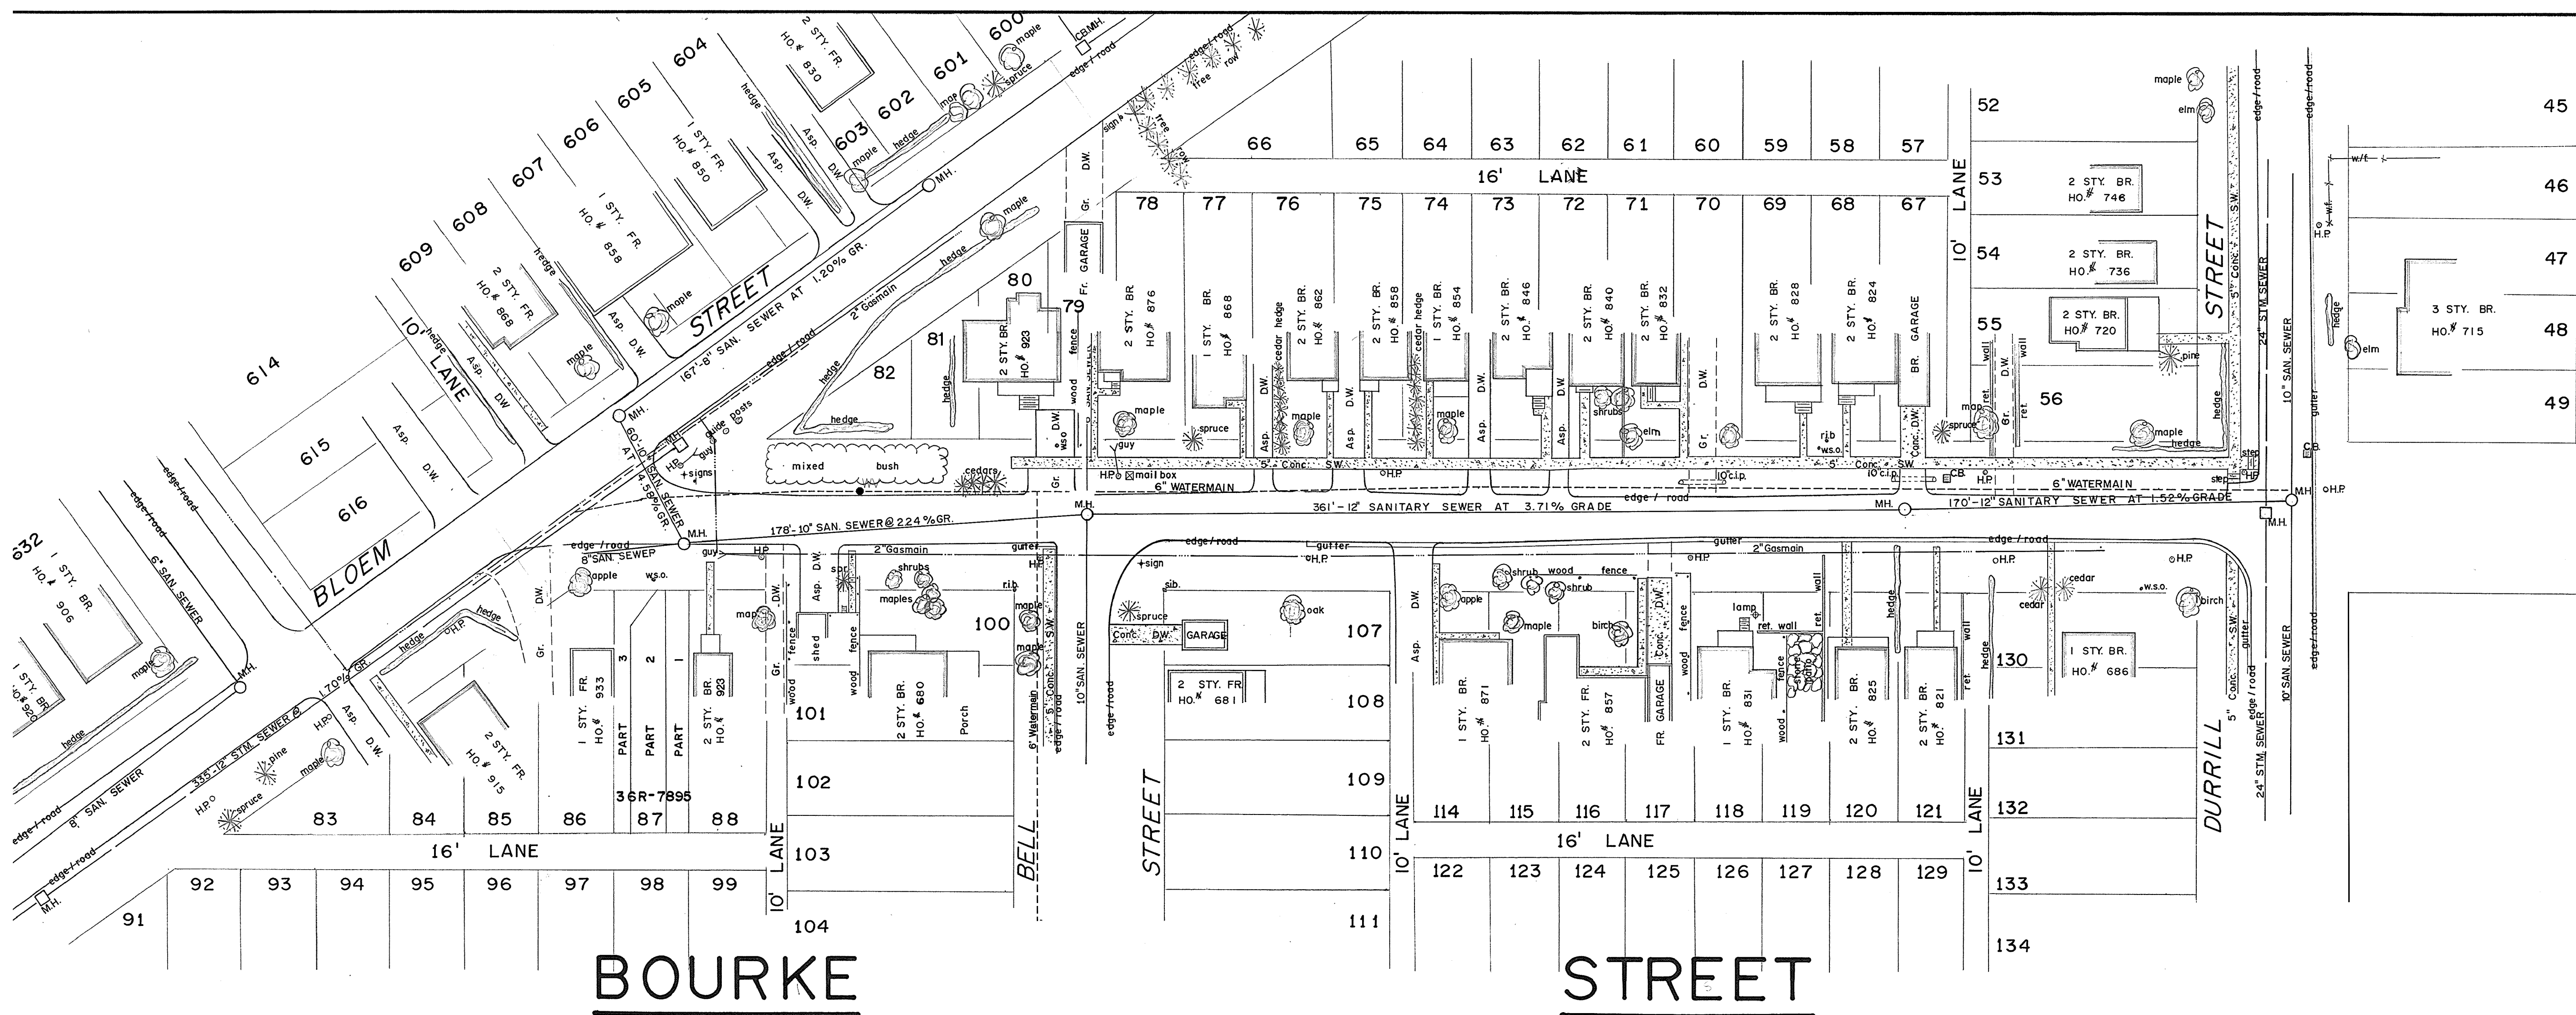


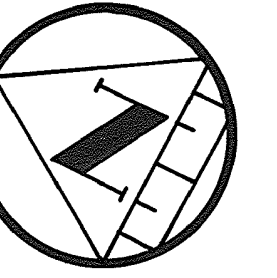

SCALE: 1 in. = 40 ft.

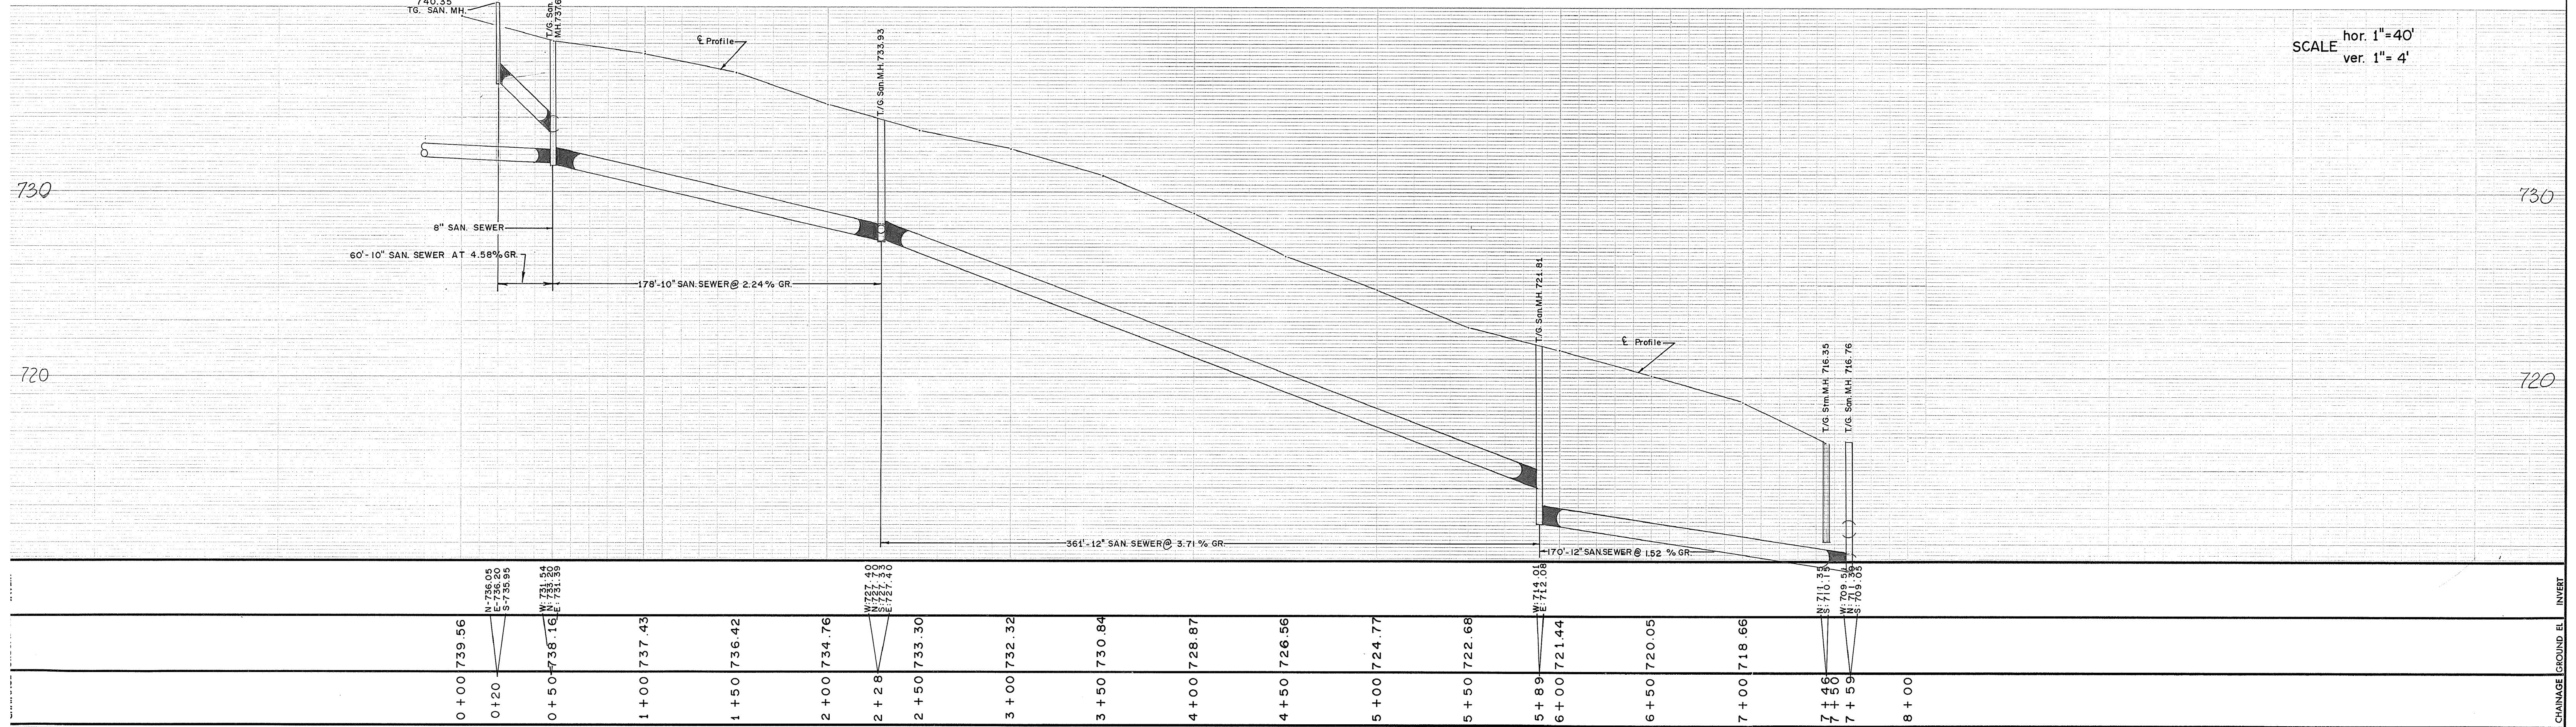

SCALE hor. 1" = 40'
ver. 1" = 4'

DWG: 10'	NOTES: DISCLAIMER The information contained on this drawing may be based upon data provided by others and may not have been verified by either as-constructed drawings or an Ontario Land Surveyor. The City of North Bay cannot accept responsibility for any errors or omissions on any information shown herein. Field verification, land surveys or excavation (with City approvals) may be required to determine actual location of any and all utilities or property lines.	1.	REVISED SAN SEWER TO CORRECT LOCATION	AUG.81	Rick B.	APPROVED	BOURKE STREET		CITY OF NORTH BAY		
		2.	6" Watermain Added, 10" Sanitary Corrected	Aug 07	r.j.o.		BLOEM STREET TO DURRILL ST.		ENGINEERING DEPARTMENT		
		3.	Civic address change # 923 and 880	Aug 08	r.j.o.		REG,D. PLANS N ^o 78		SCALE: AS SHOWN	DATE: SEPTEMBER 1974	
		4.	Updated WV as per P/W	Mar'11	G.W.C.		21		DRAWN BY: G.W.R.	FIELD BOOK No. 236	B-351
							77				
		No.	REVISION	DATE	INITIAL						