



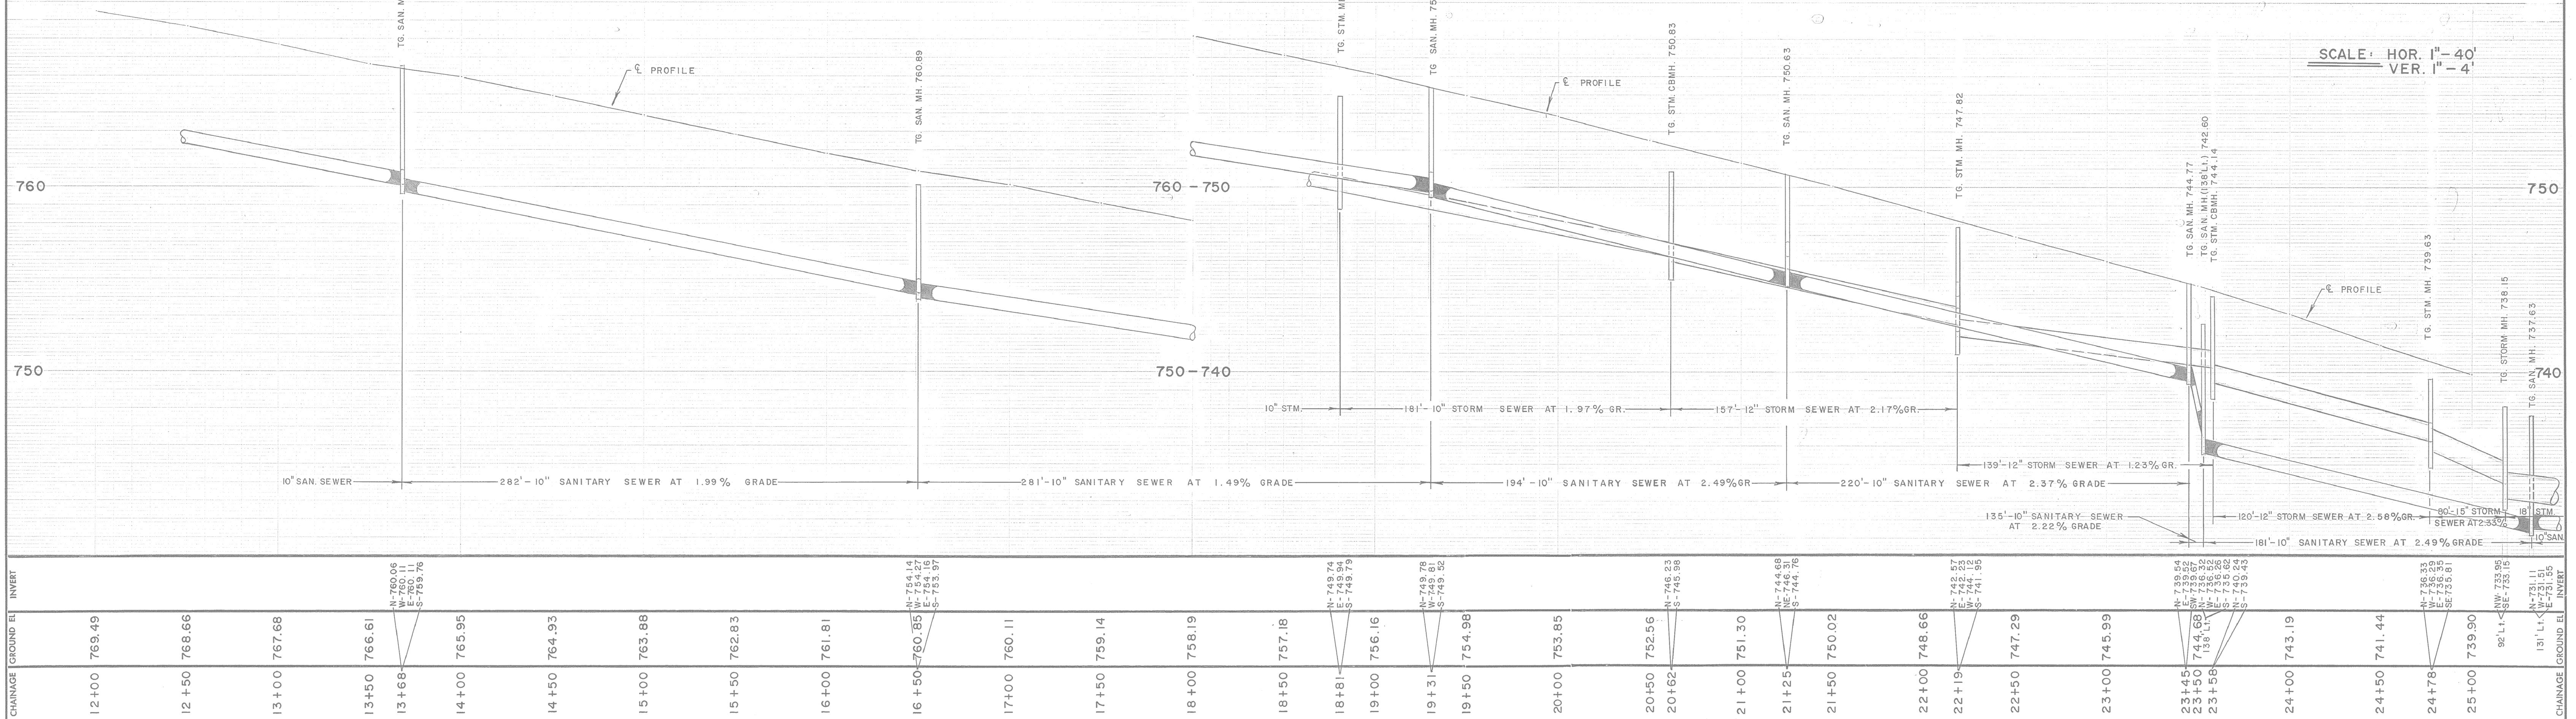

DWG No.	NOTES:	6" & 4" Wm. Norwood. to Reynolds (See H² Ser. File) JAN. 82. Rick B.				APPROVED	BEATTIE STREET		CITY OF NORTH BAY		
	DISCLAIMER The information contained on this drawing may be based upon data provided by others and may not have been verified by either as-constructed drawings or an Ontario Land Surveyor. The City of North Bay cannot accept responsibility for any errors or omissions on any information shown herein. Field verification, land surveys or excavation (with City approvals) may be required to determine actual location of any and all utilities or property lines.	AS CONST'D. STORM. Bk to Lavery 1969 JAN. 82 Rick B.	REVISED JAN. 82 Rick B.	36R-12758 Added Sept 09 G.W.C.	Updated water as per P/W Aug '13 G.W.C.		NORWOOD AVENUE TO BLOEM STREET		ENGINEERING DEPARTMENT		
							REQ'D PLAN'S : 77, 78, 80,				
		No.		REVISION		DATE		INITIAL		REV.	

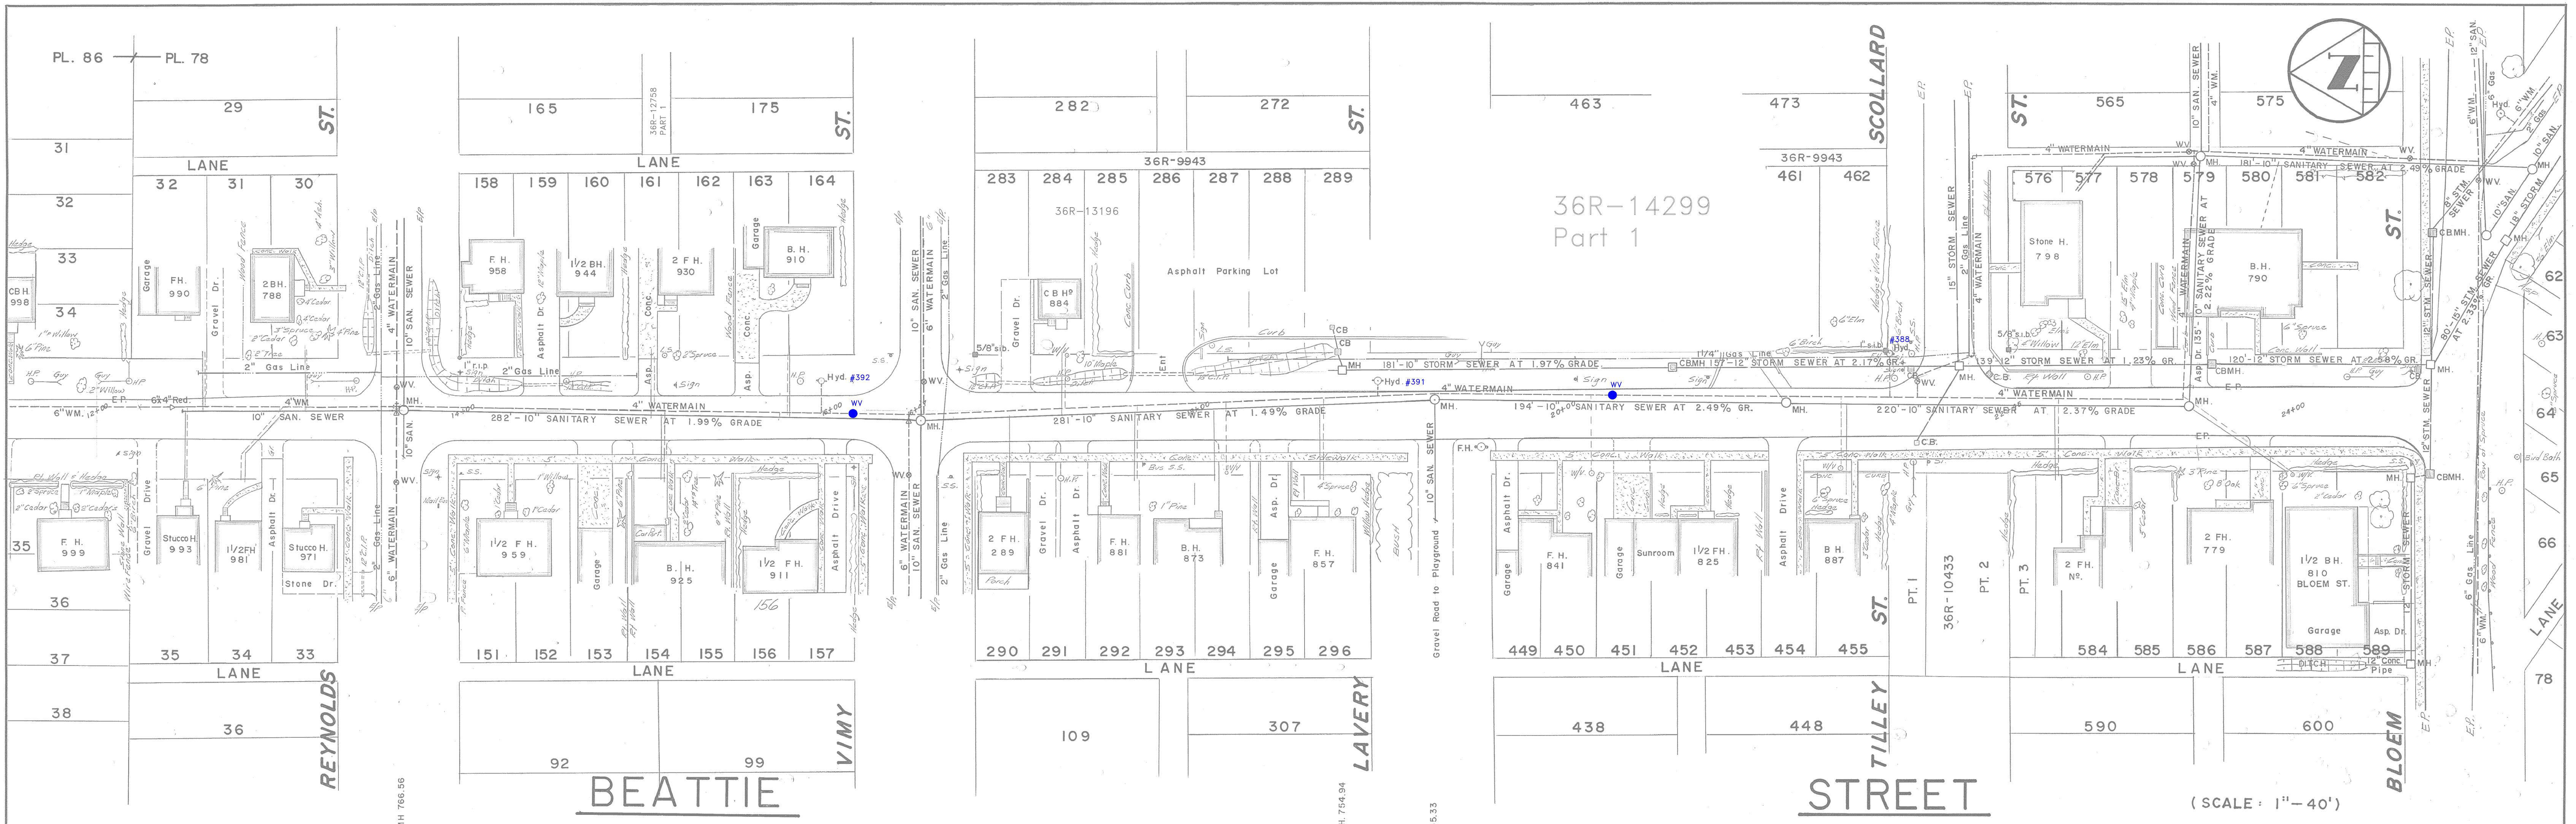