



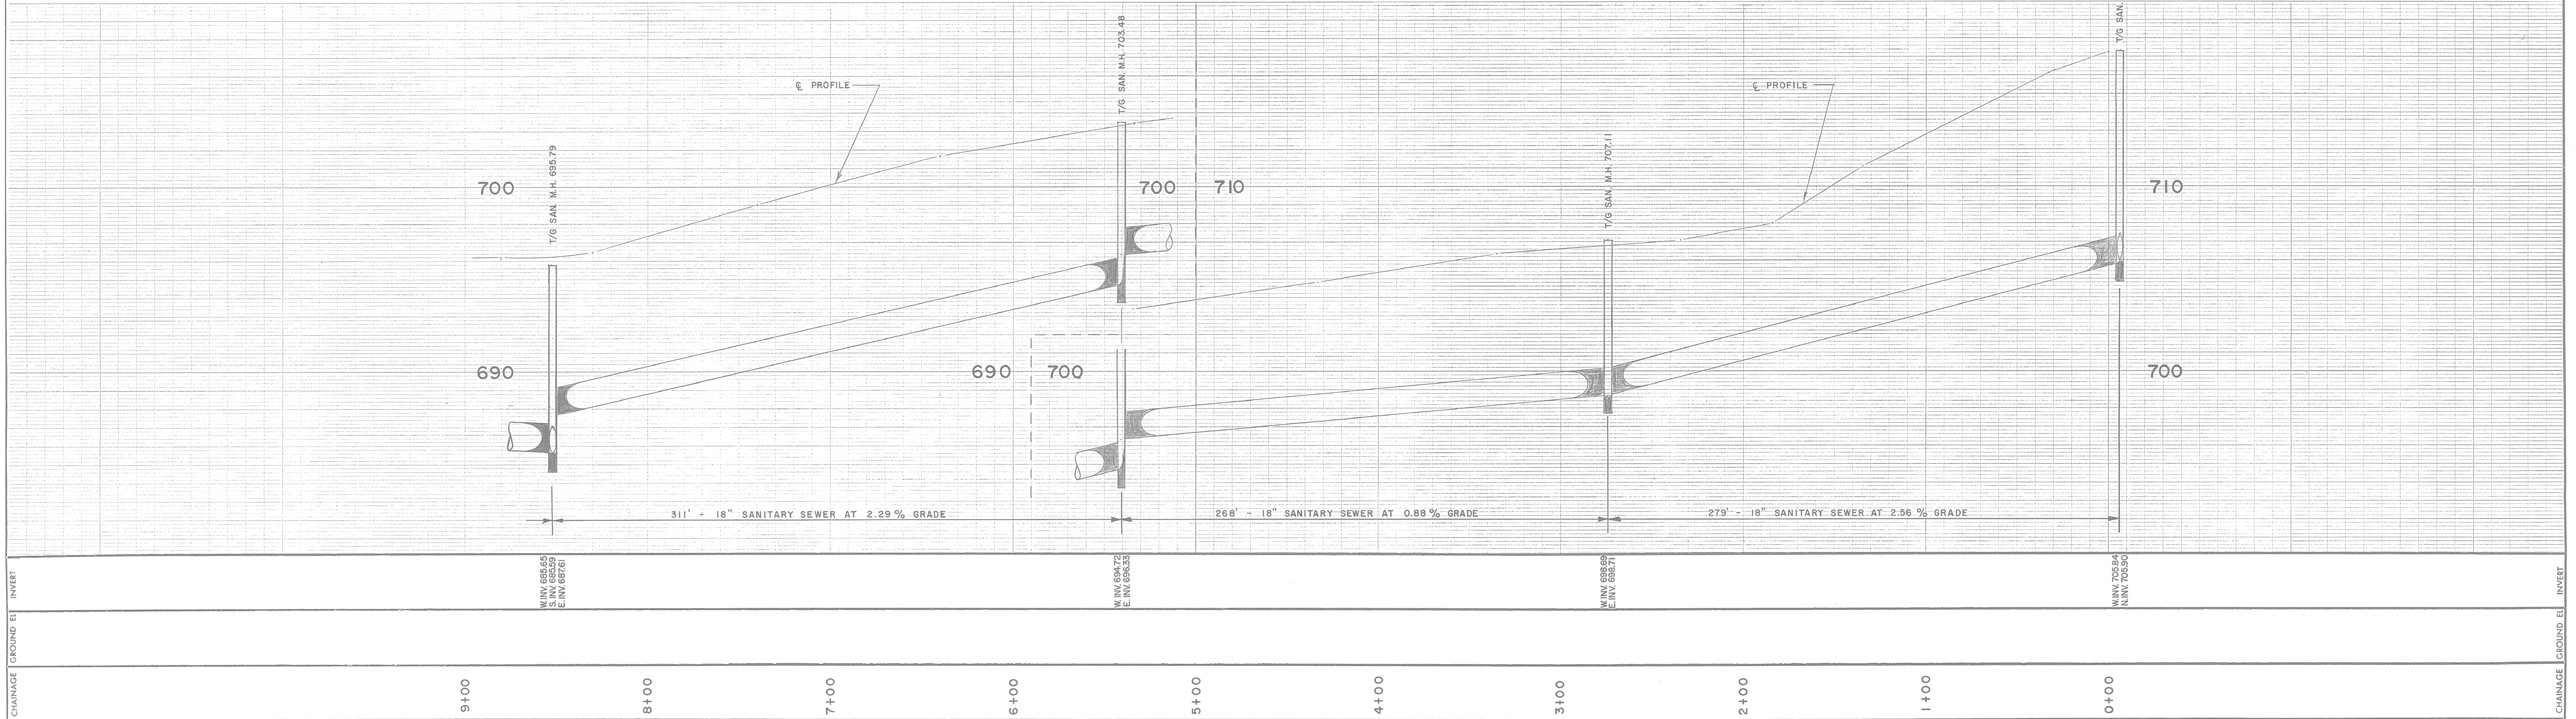

NOTES:

DISCLAIMER

The information contained on this drawing may be based upon data provided by others and may not have been verified by either as-constructed drawings or an Ontario Land Surveyor. The City of North Bay cannot accept responsibility for any errors or omissions on any information shown herein. Field verification, land surveys or excavation (with City approvals) may be required to determine actual location of any and all utilities or property lines.

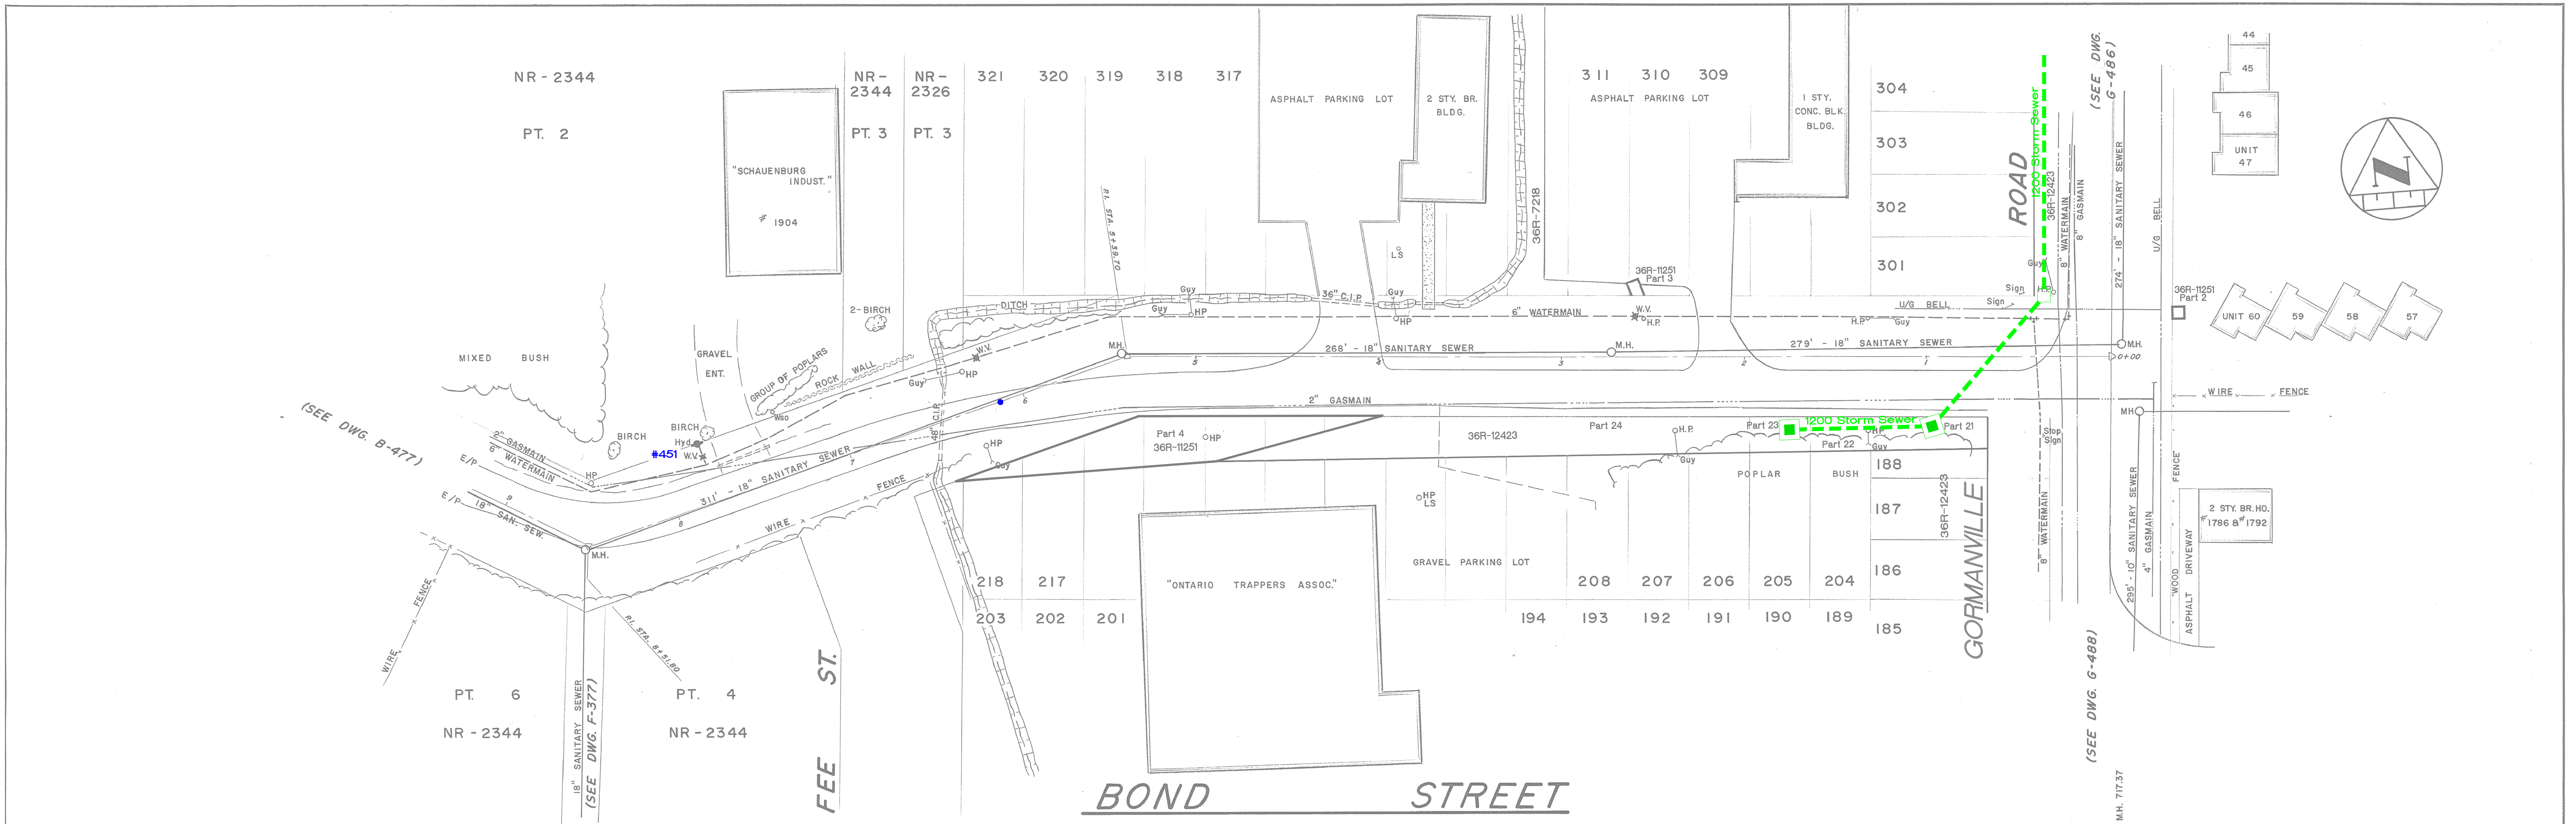

No.	REVISION	DATE	INITIAL
2.	Registered Plans added.	May 07	r.j.o.
1	NEW DRAWING FROM ORIG. NOTES '74-'88	Oct., 1988	P.L.C.

APPROVED

BOND STREET

GORMANVILLE ROAD TO STATION 9+00

REGISTERED PLAN N° M, 167, NR-2326, NR-2344, NR-2600

CITY OF NORTH BAY

ENGINEERING DEPARTMENT

SCALE: 1" = 40' HOR.
1" = 4' VERT.

DATE: Oct. 1988

DRAWN BY:
C.D. BY:

FIELD BOOK No.
178, 204, 211, 216
234, 262, 264, 265

DRAWING No.
B - 476

REV.