
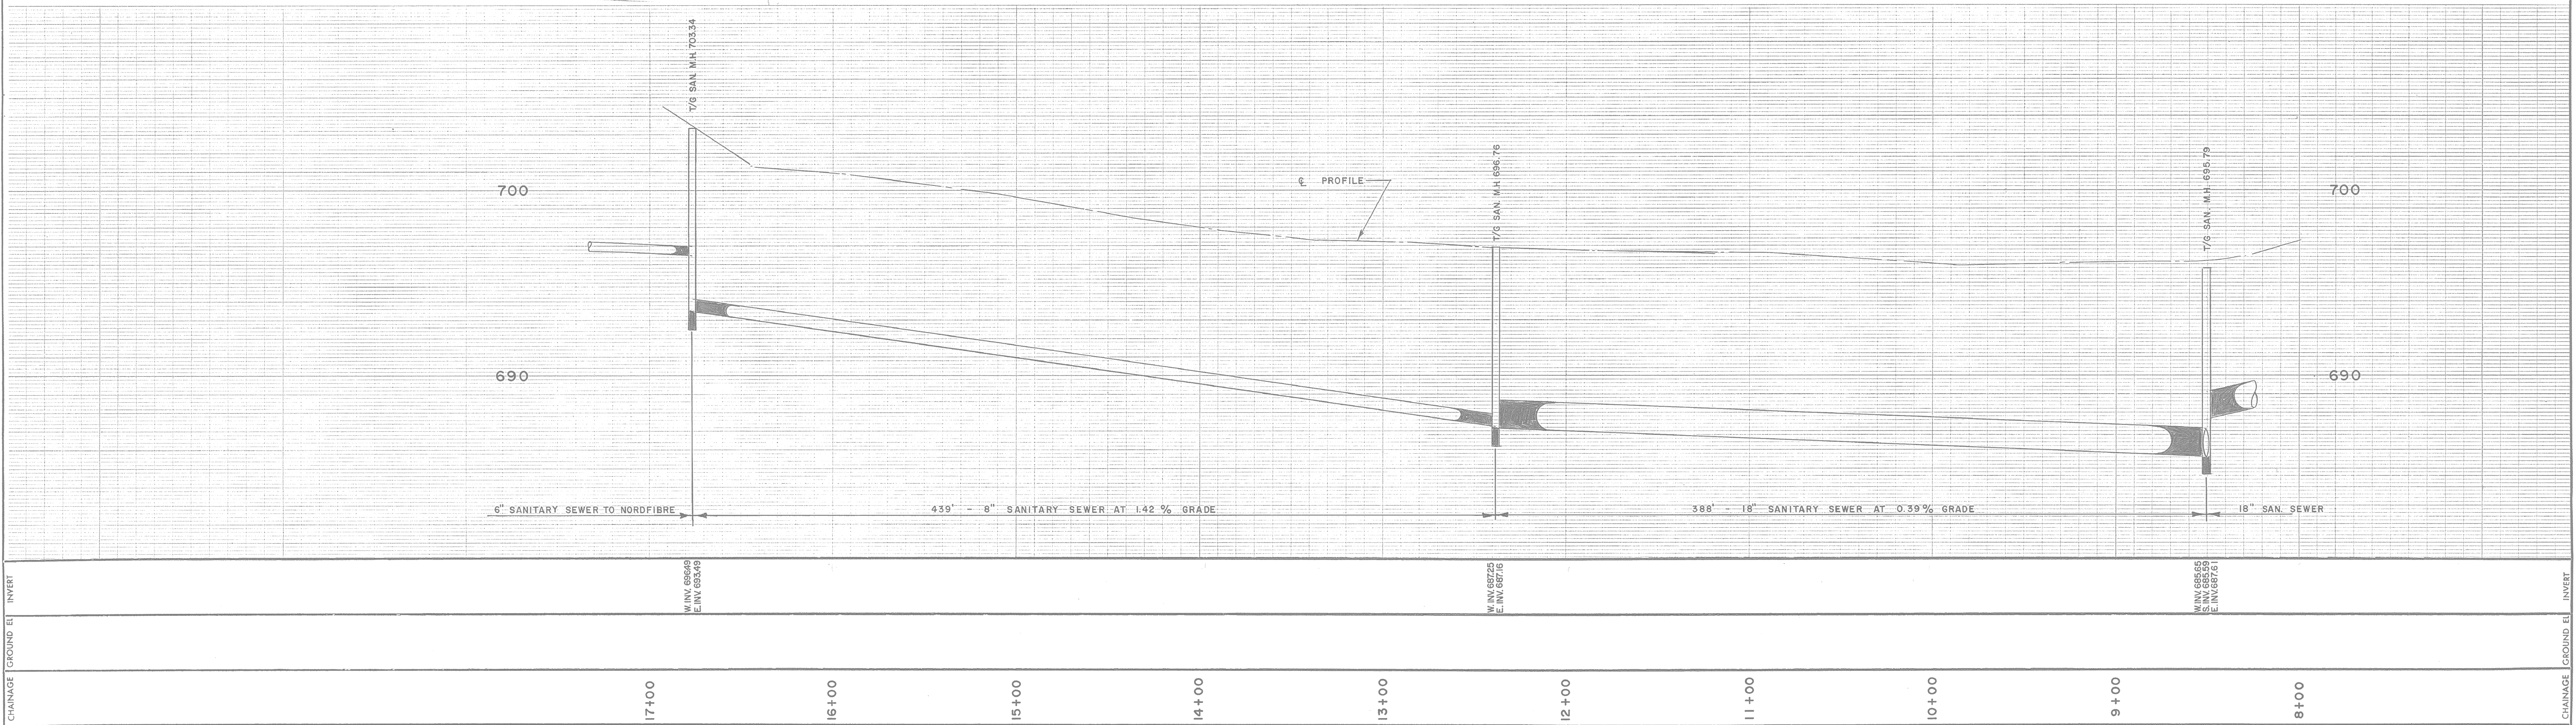


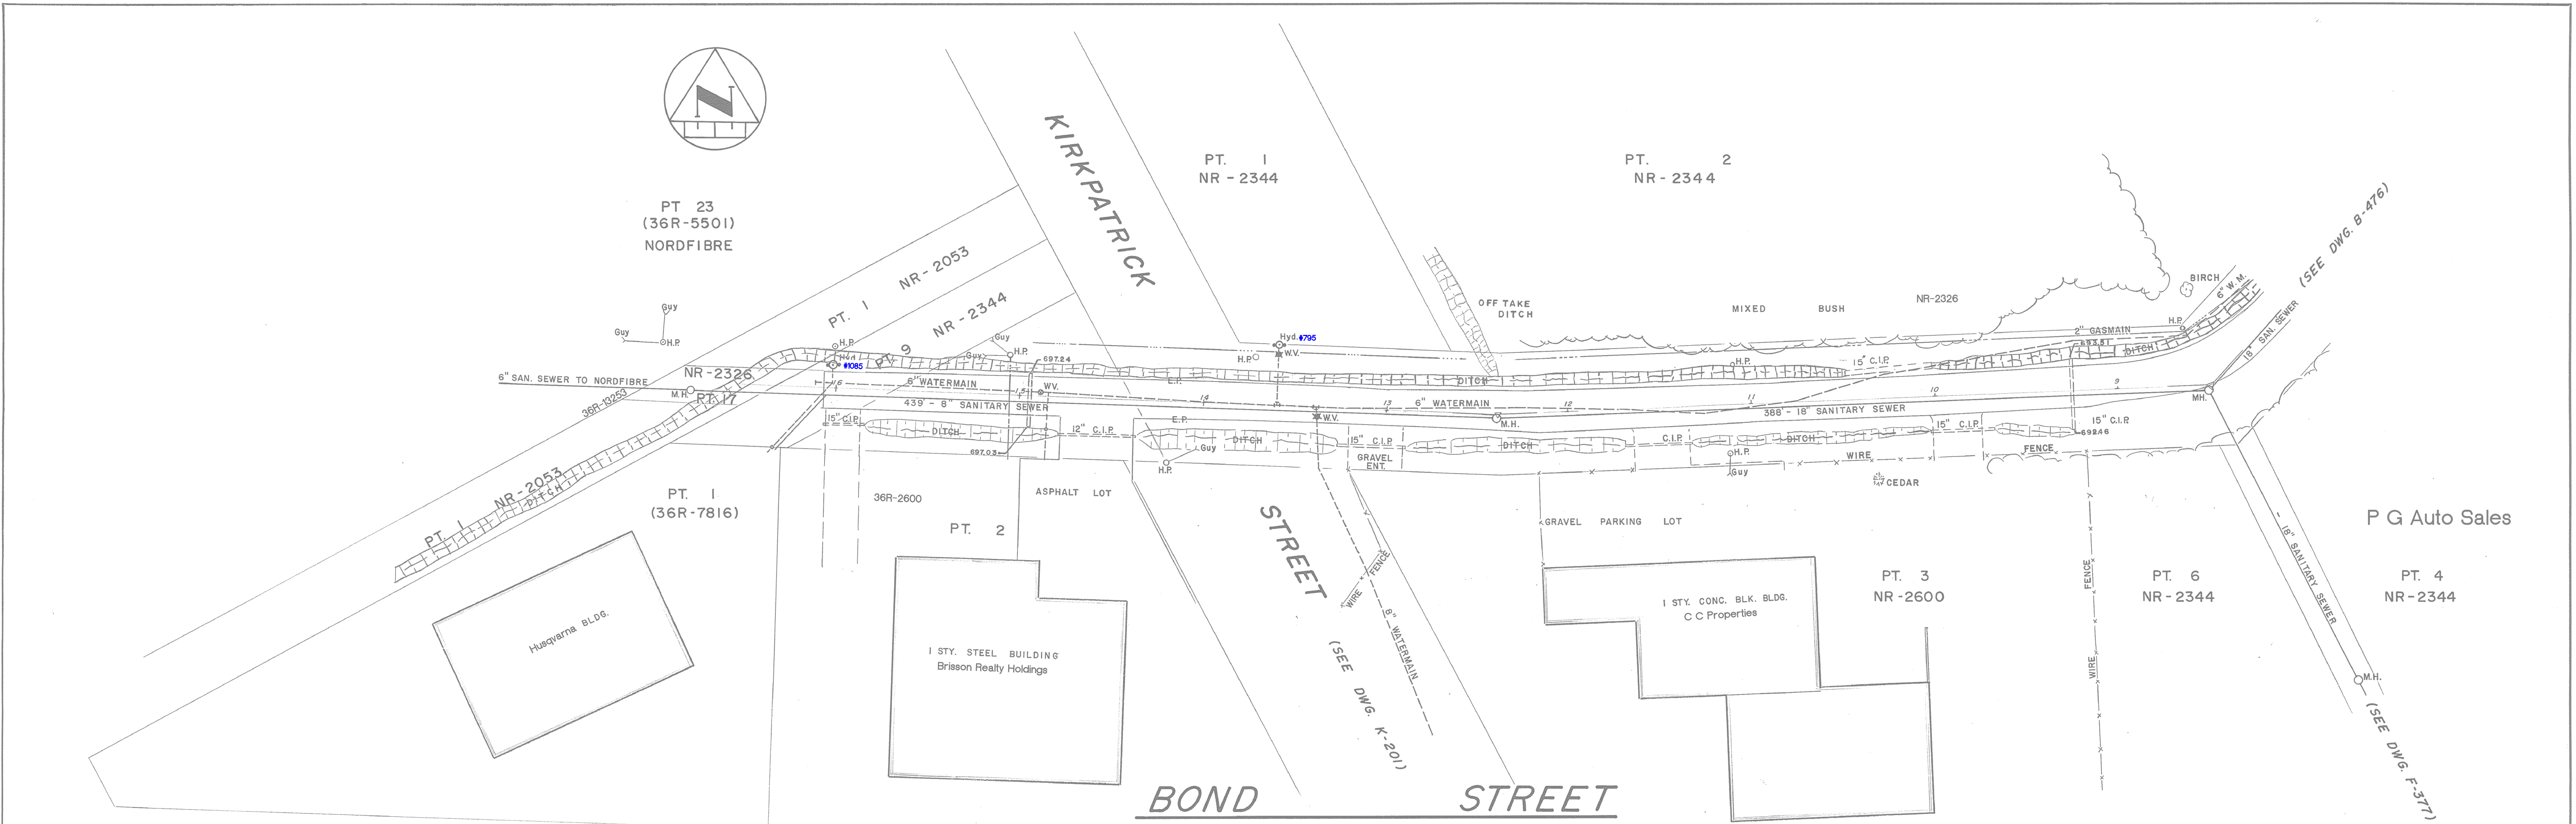

NOTES: DISCLAIMER The information contained on this drawing may be based upon data provided by others and may not have been verified by either as-constructed drawings or an Ontario Land Surveyor. The City of North Bay cannot accept responsibility for any errors or omissions on any information shown herein. Field verification, land surveys or excavation (with City approvals) may be required to determine actual location of any and all utilities or property lines.		APPROVED		BOND STREET STATION 9+00 TO STATION 16+80 REGISTERED PLAN N° M-167, NR-2326, NR-2344, NR-2600		CITY OF NORTH BAY ENGINEERING DEPARTMENT	
		3 DITCH PROFILE JUNE 89		JUNE 89 RTHAYER		SCALE: 1" = 40' HOR. 1" = 4' VERT.	
		2. AS CONST'D. WATERMAIN 1988.		NOV. 88 Rick B.		DATE: Oct. 1988	
		1 NEW DRAWING FROM ORIG. NOTES '74-'88		Oct, 1988 P.L.C.		DRAWN BY: FIELD BOOK No. 178, 204, 211, 216 CKD. BY: 234, 262, 264, 283	
No. REVISION		DATE INITIAL		DRAWING No. B-477		REV.	