
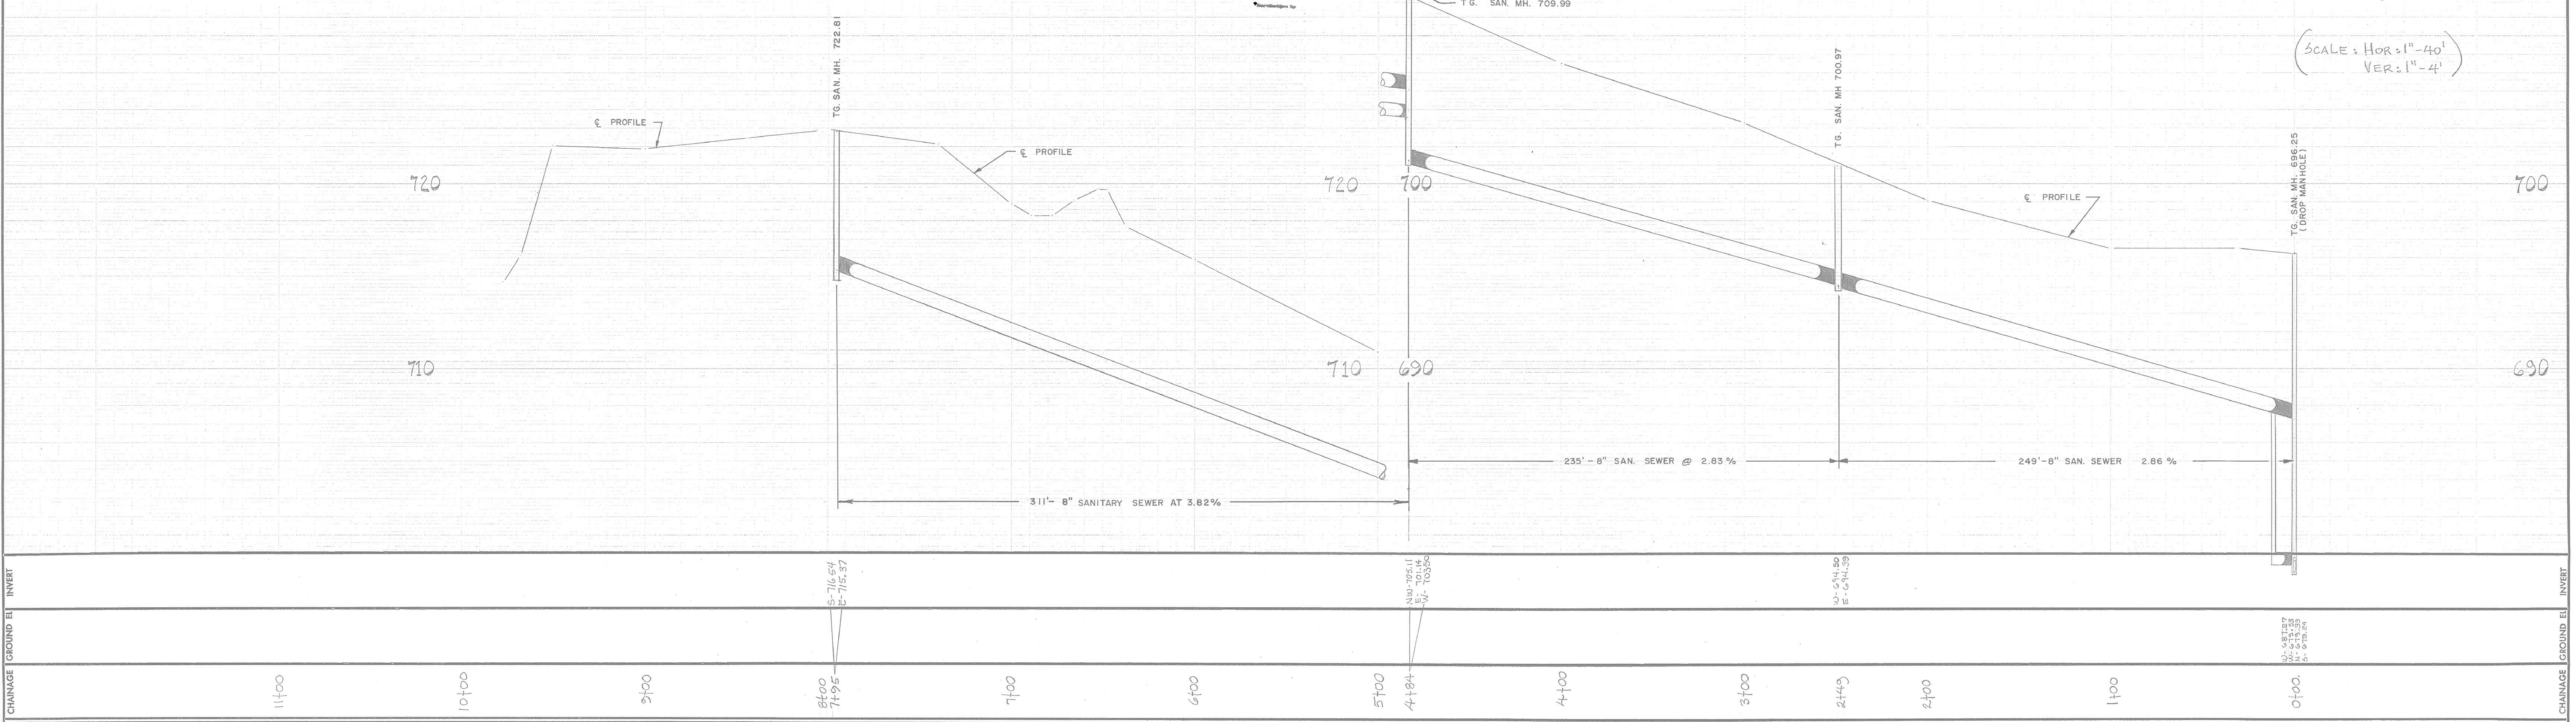


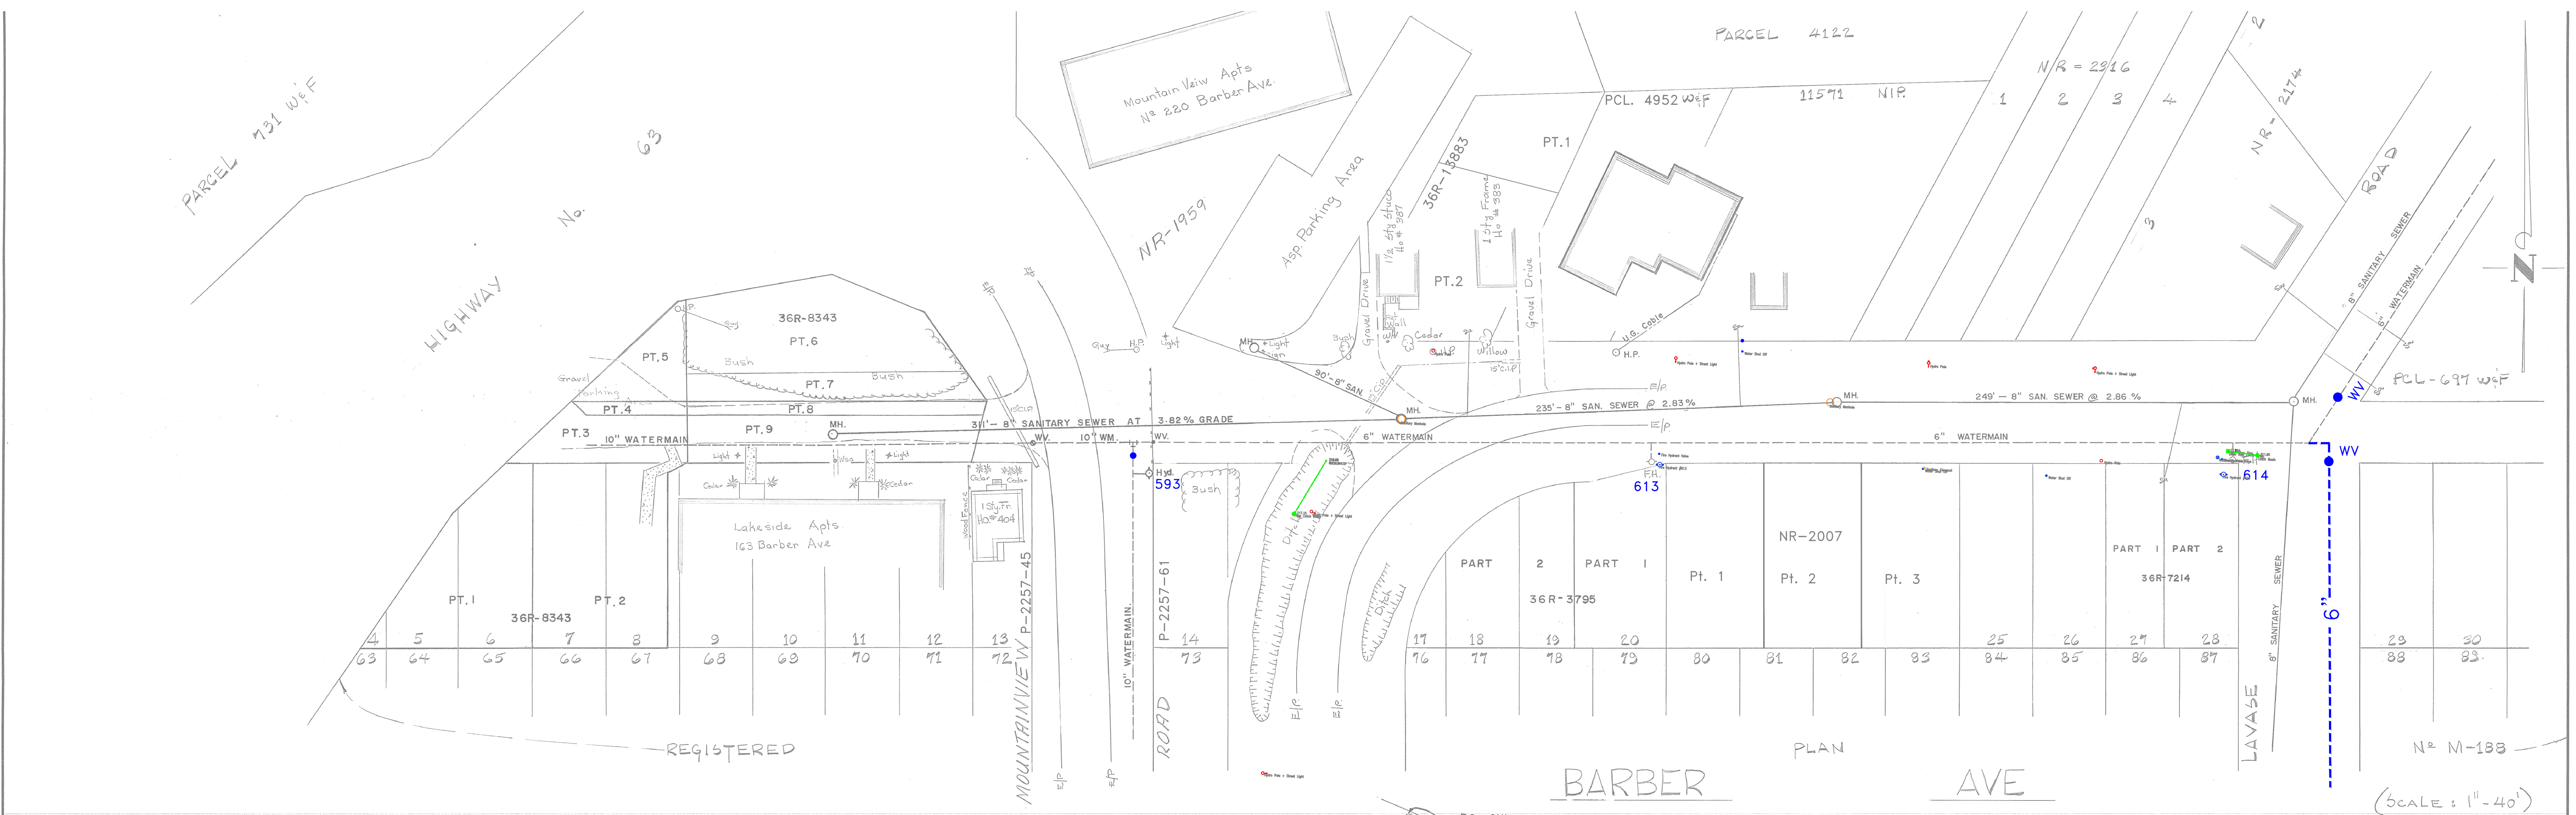

DWG: 140	NOTES:	1. New Drawing (SEPT 13/07) Nov/12 RJS 2. Water And Sanitary Sewer June/13 GJR 3. Connection to San. Sewer (BK 173 pg. 90) Mar./15 J.L.M. 4. Watermain/valves added. Aug 07 r.j.o. No. REVISION DATE INITIAL				APPROVED	BARBER AVENUE LAVASE ROAD TO HIGHWAY N° 63 REG'D PLAN N° = M-188 Hwy PLAN N° = P-2257-45		CITY OF NORTH BAY ENGINEERING DEPARTMENT	
	DISCLAIMER The information contained on this drawing may be based upon data provided by others and may not have been verified by either as-constructed drawings or an Ontario Land Surveyor. The City of North Bay cannot accept responsibility for any errors or omissions on any information shown herein. Field verification, land surveys or excavation (with City approval) may be required to determine actual location of any and all utilities or property lines.				SCALE: As shown DATE: Nov/12					
			DRAWN BY: RJS FIELD BOOK No. DRAWING No. REV.							
			CK'D. BY: # 225 B-576							

140ADWIP Drawing08-176.dwg, DWG to PDF p13

140-0111-11