

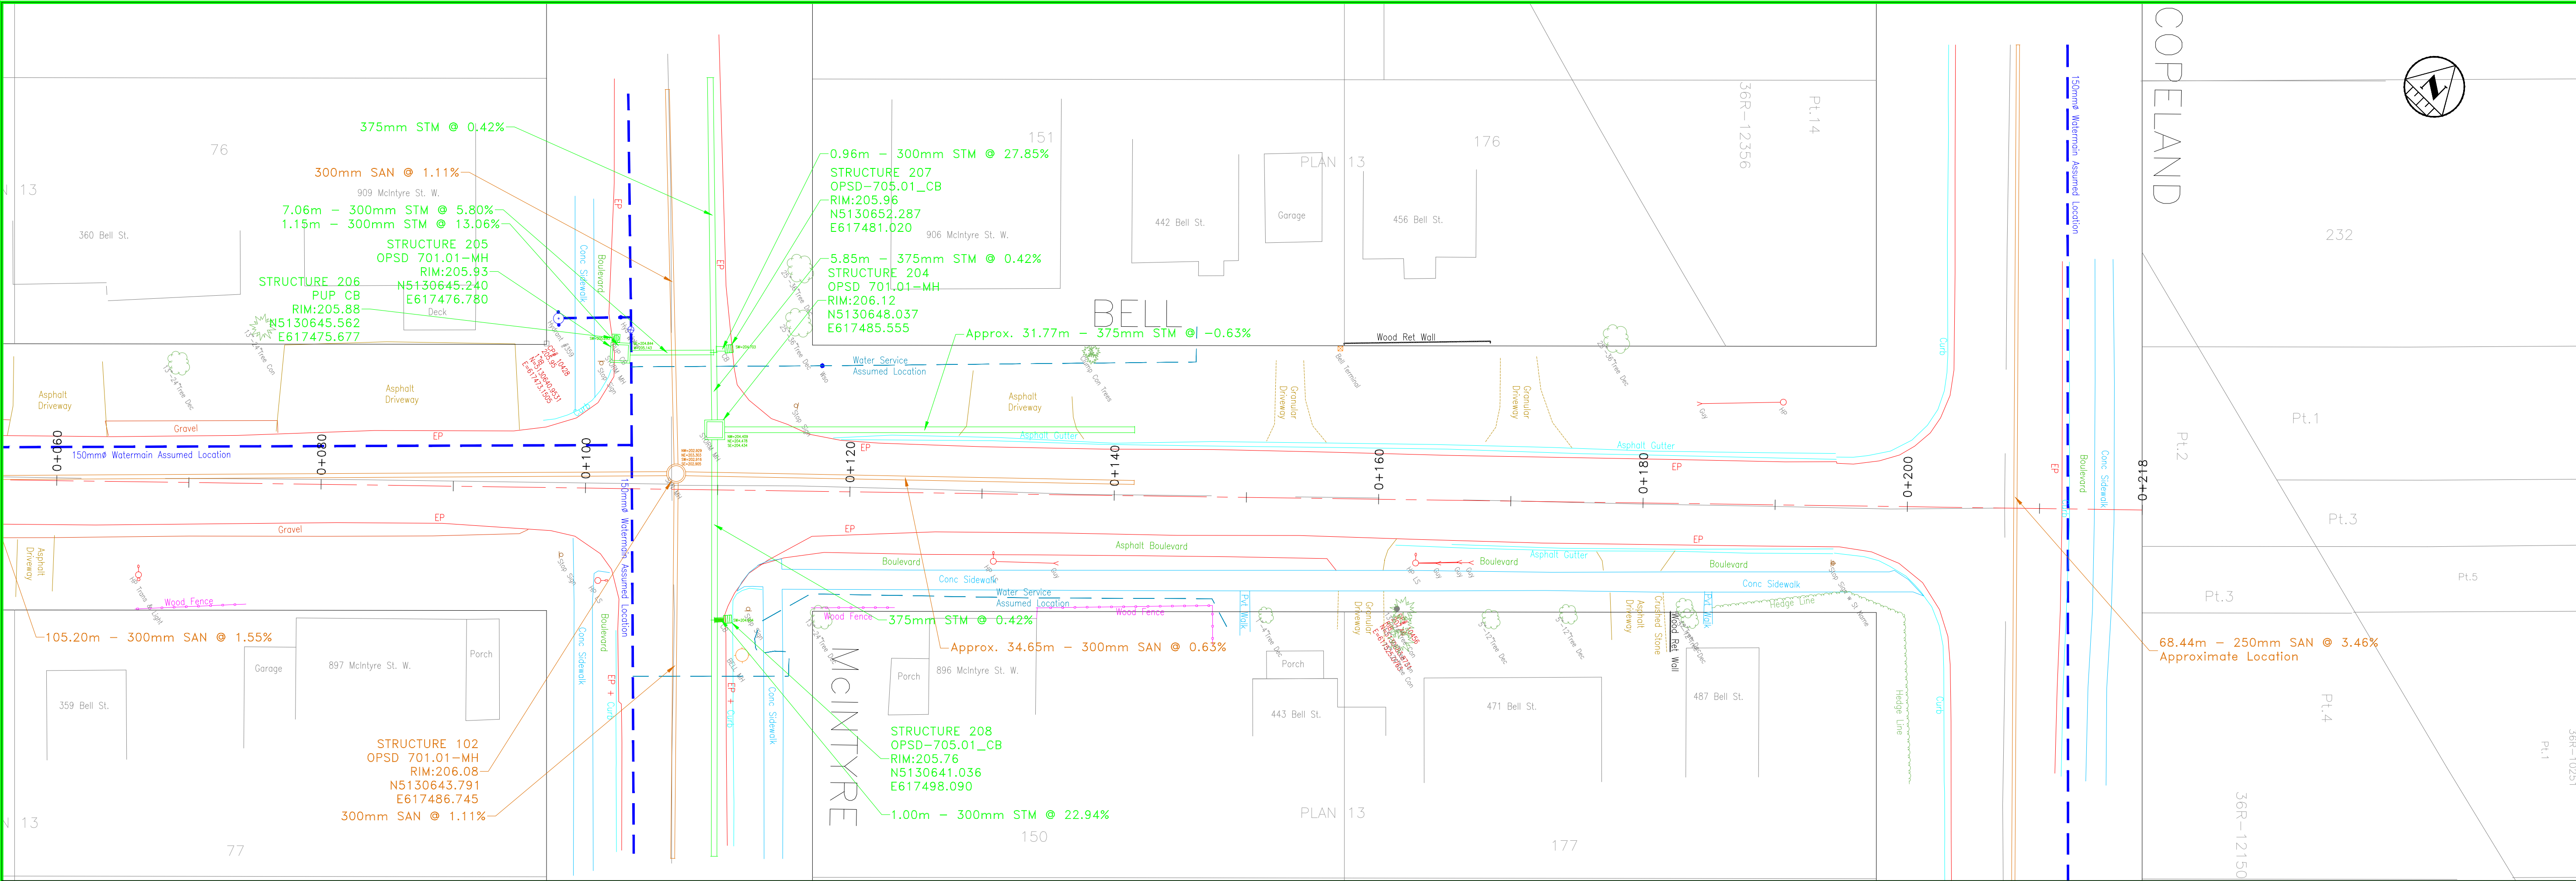


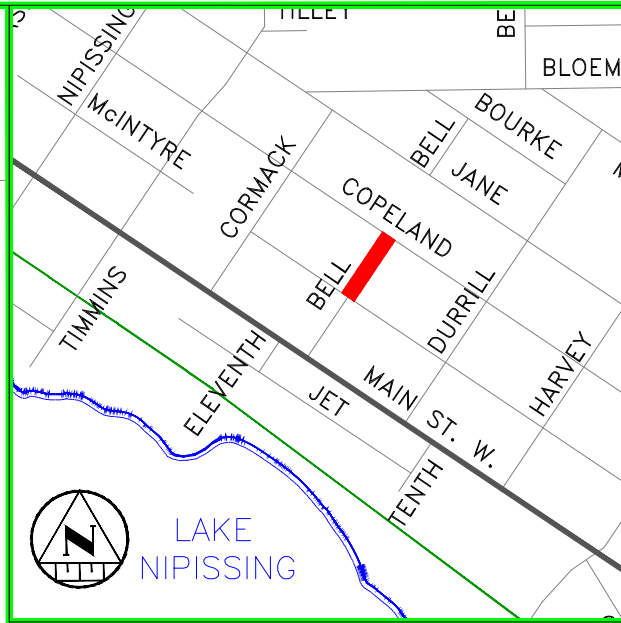

Bell Street CL PROFILE

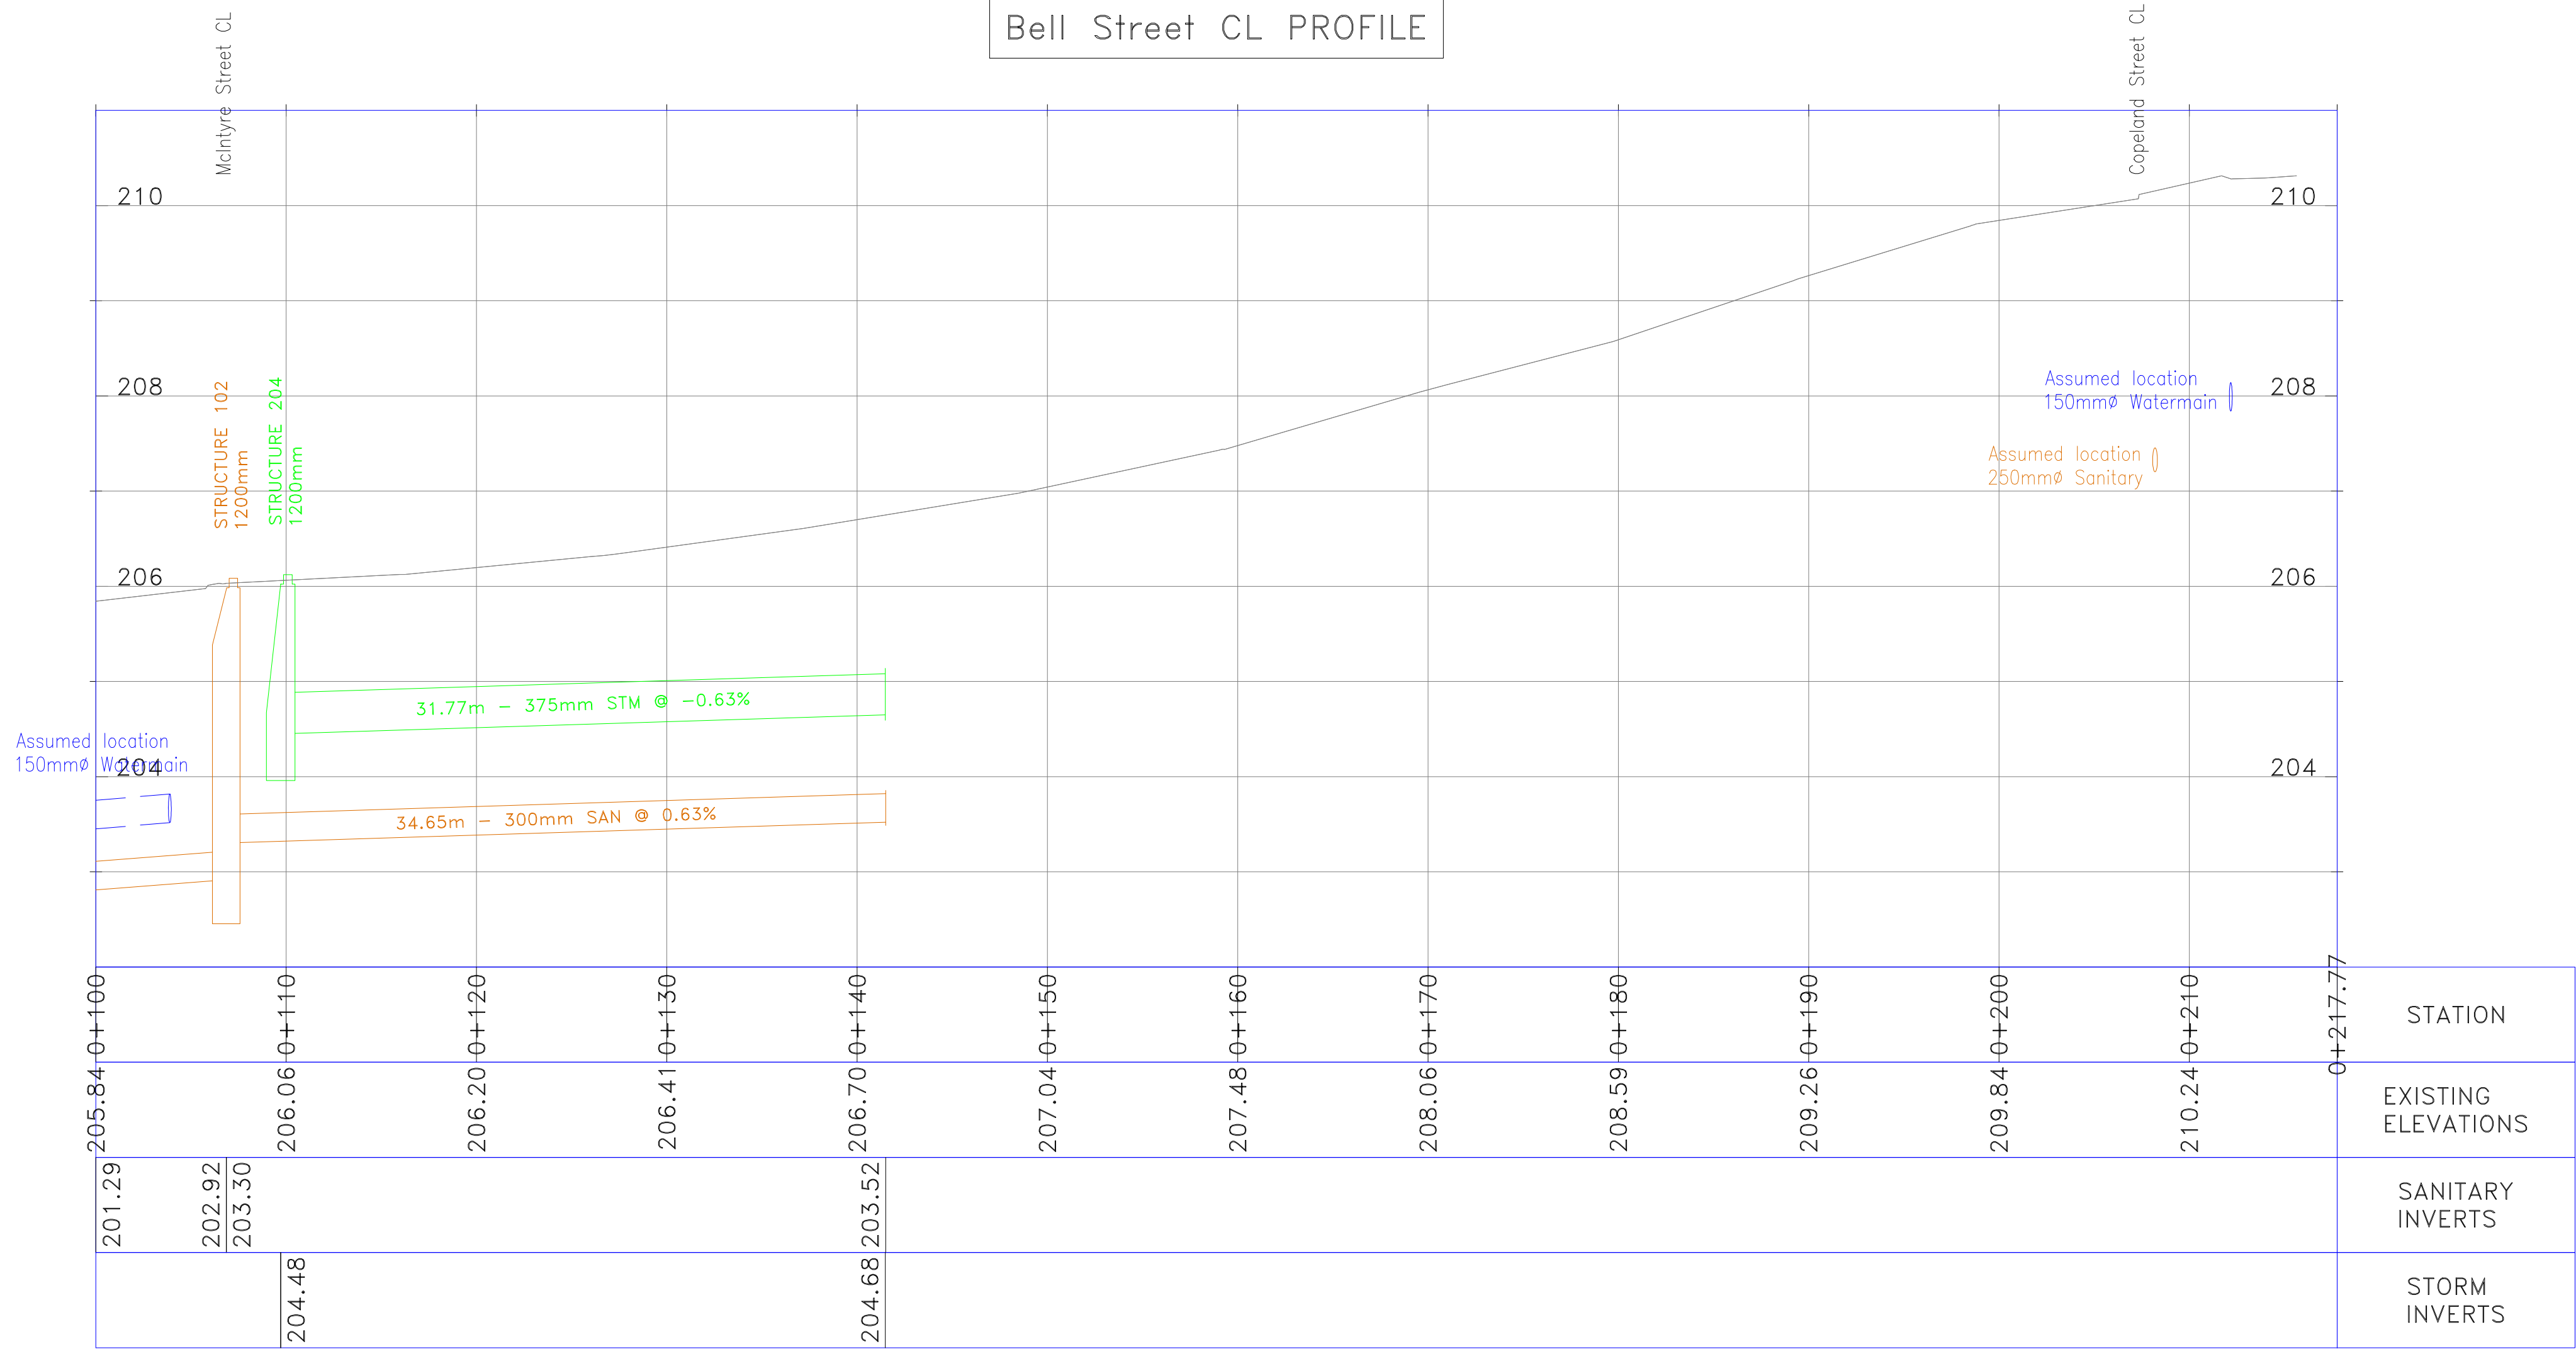

KEY PLAN
LEGEND

REVISIONS			
no.	date	by	description
1.	5 August 2015		As-Built

Disclaimer
The information contained on this drawing may be based upon data provided by others and may not have been verified by either as-constructed drawings or an Ontario Land Surveyor. The City of North Bay cannot accept responsibility for any errors or omissions on any information shown herein. Field verification, land surveys or excavation (with City approvals) may be required to determine actual location of any and all utilities or property lines.



**From McIntyre St.
To Copeland St.**

AS-BUILT

BELL STREET

STA. 0+100 to 0+218	
designer	drawn by: G.W.C.
checked by:	approved by:
scale H:1:250 V:1:50	date 8/05/2015
	drawing number B-779