



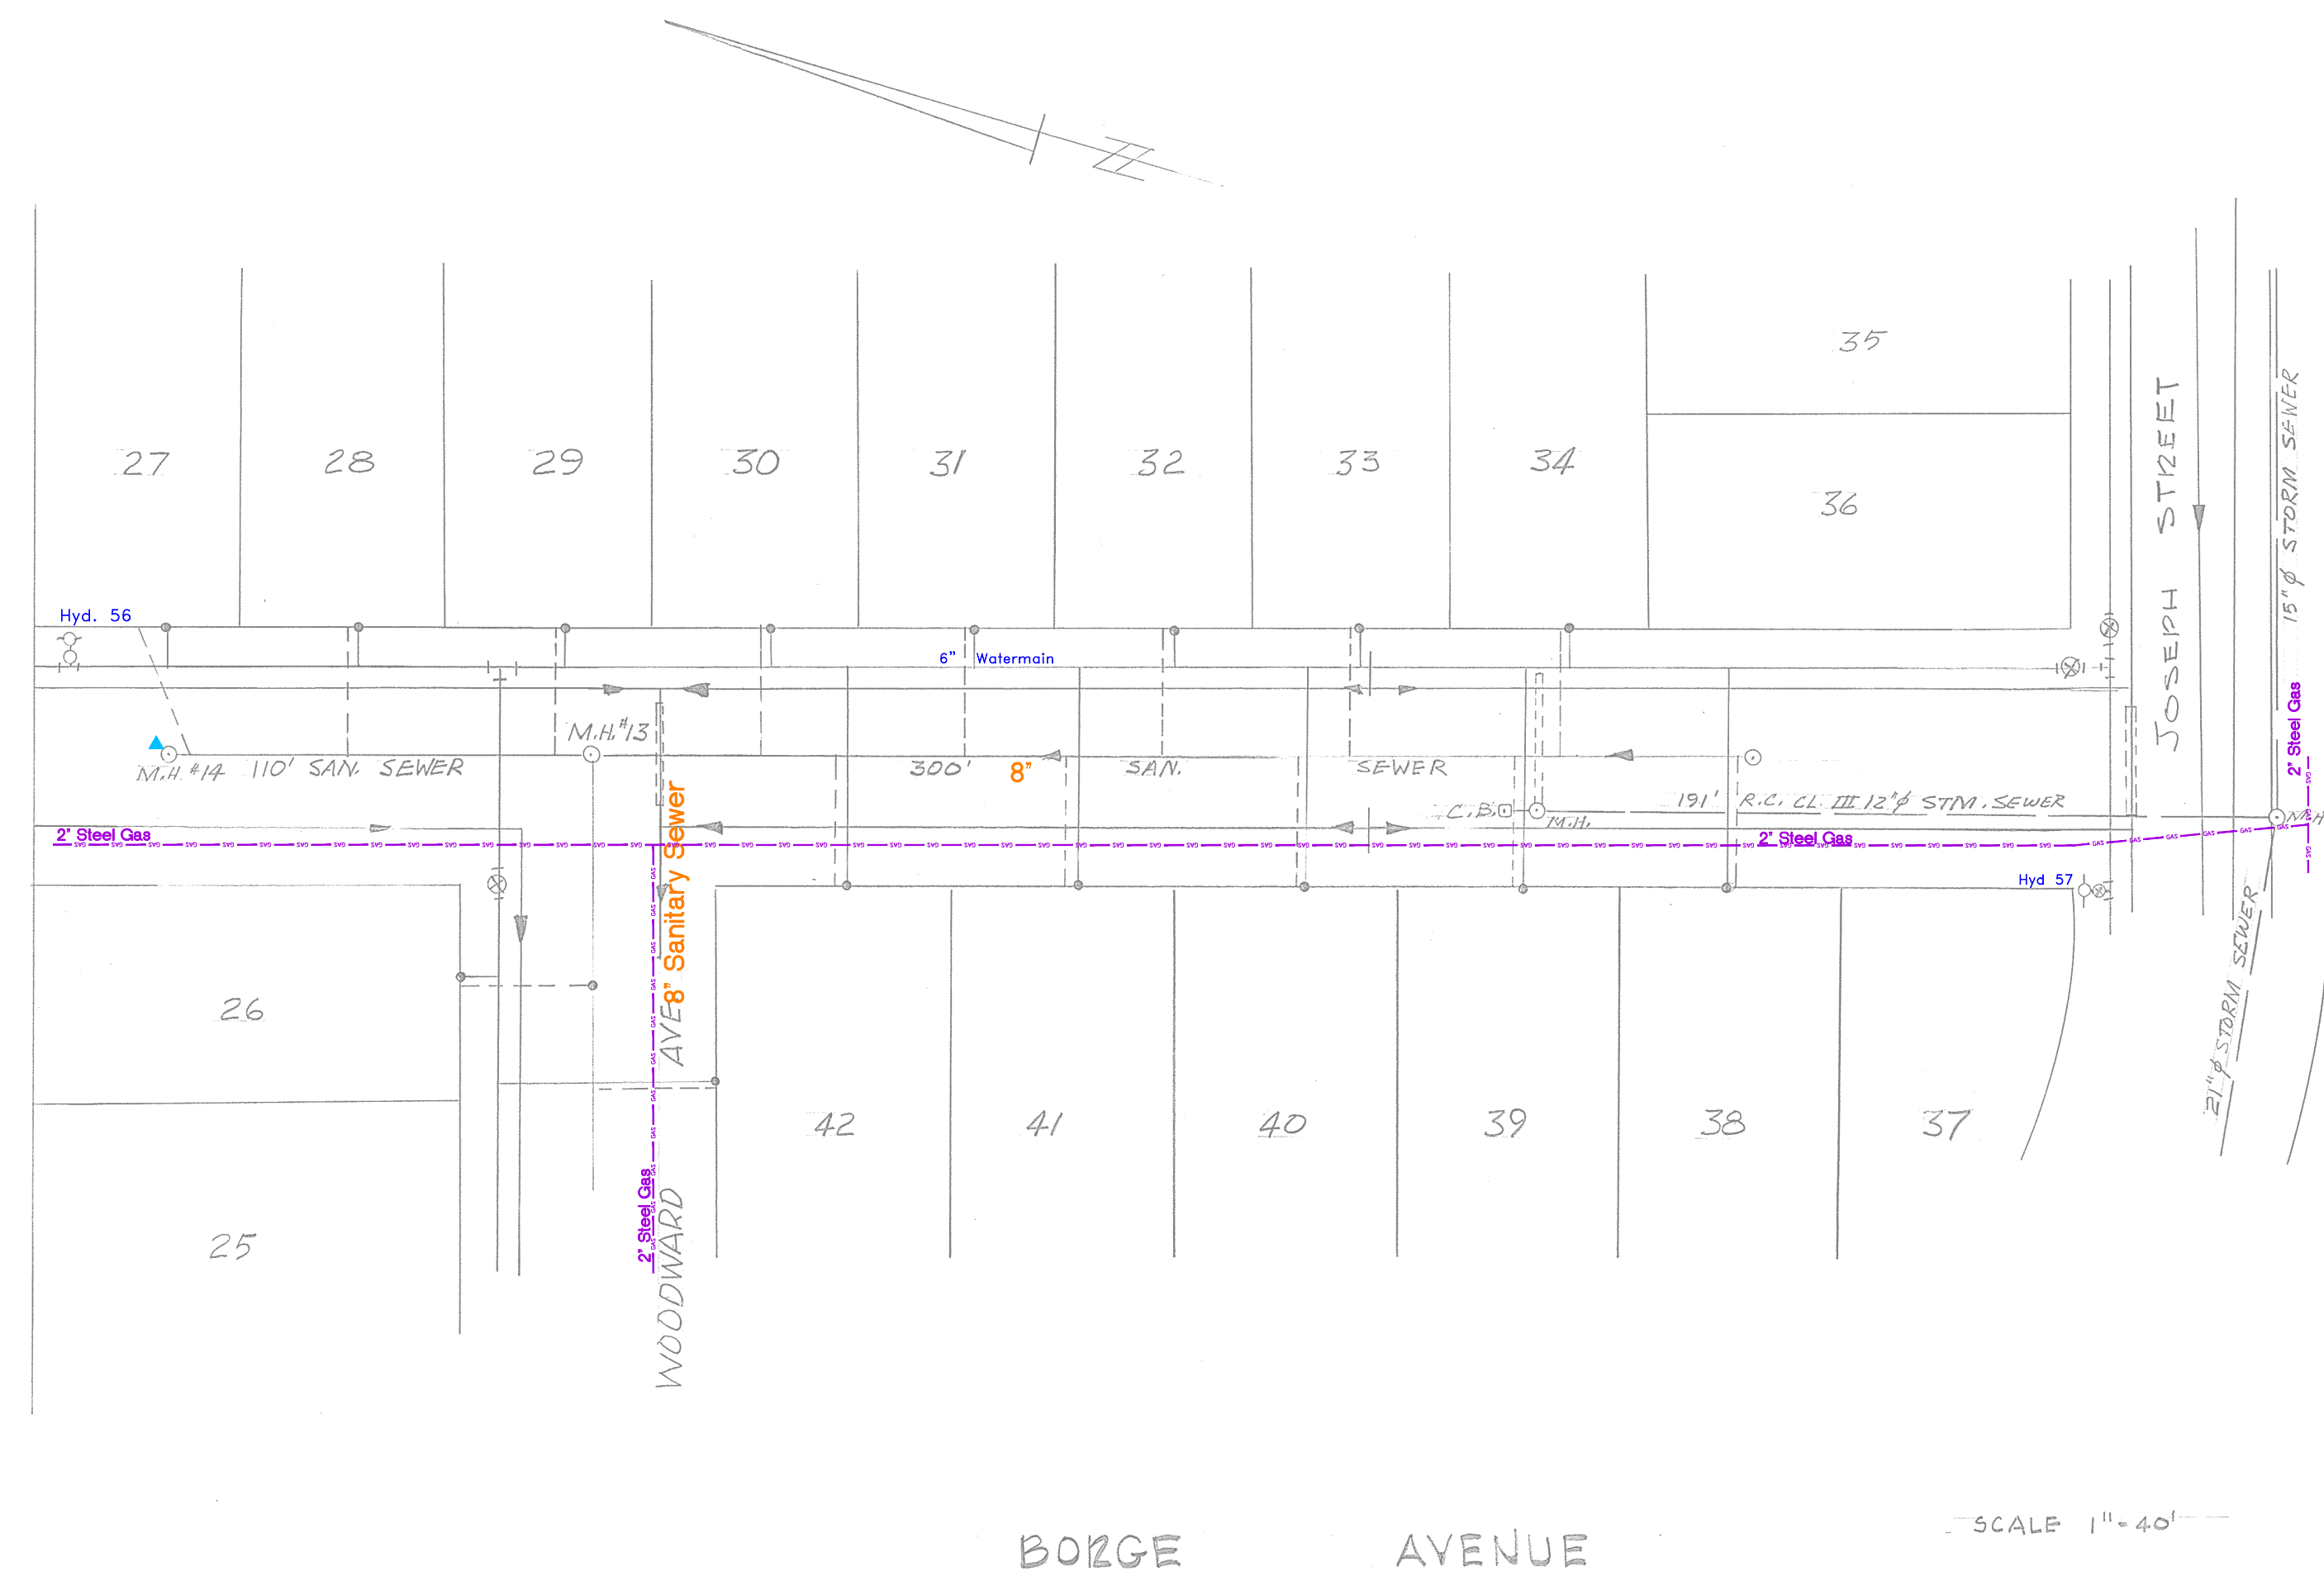

SCALE 1" = 40'

SCALE HOR 1" = 40'
VER 1" = 4'

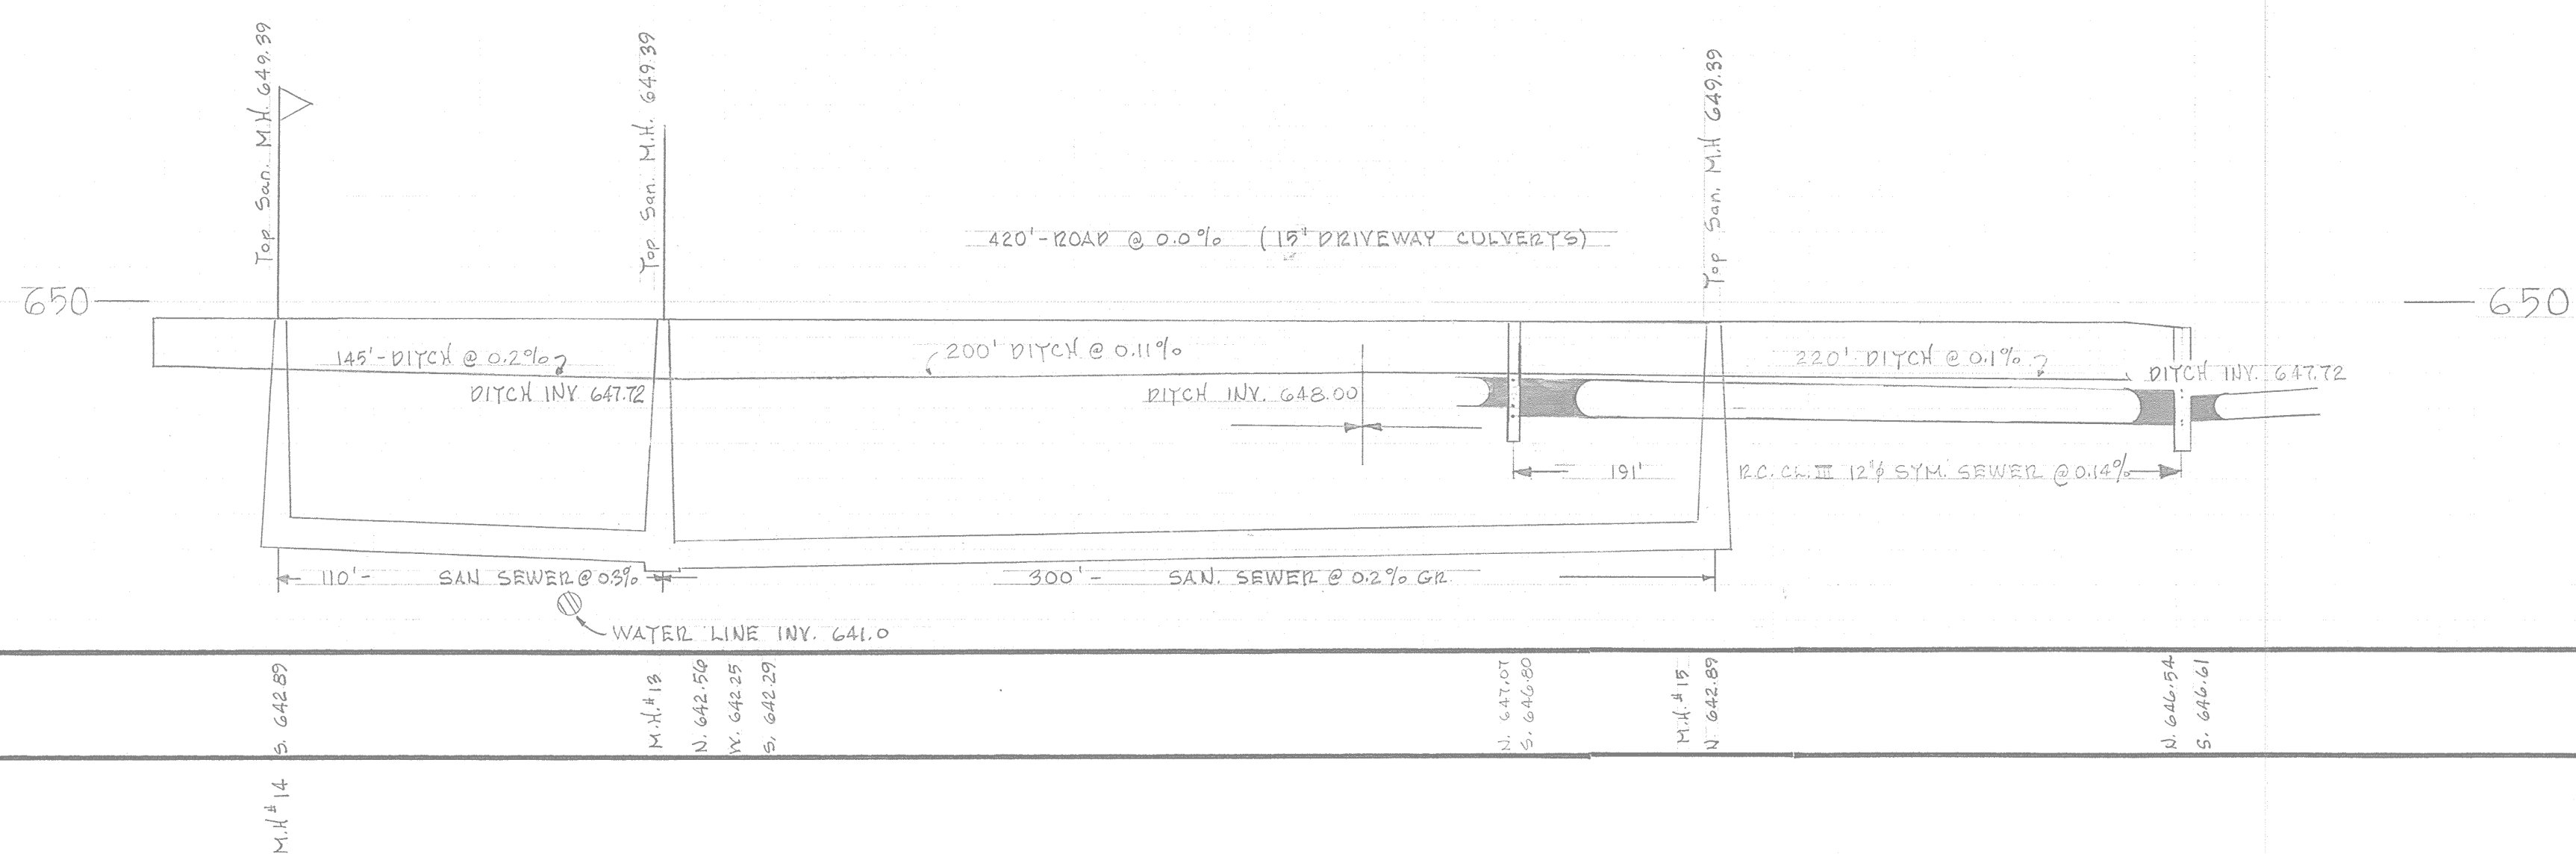

DMC: 10'

NOTES:

DISCLAIMER

The information contained on this drawing may be based upon data provided by others and may not have been verified by either as-constructed drawings or an Ontario Land Surveyor. The City of North Bay cannot accept responsibility for any errors or omissions on any information shown herein. Field verification, land surveys or excavation (with City approvals) may be required to determine actual location of any and all utilities or property lines.



1970	AS CONST. STORM SEWER	JD		
1.	Steel Gas Main added	April 2018	r.j.o.	
No.	REVISION	DATE	INITIAL	

APPROVED

BORGE AVENUE

JOSEPH STREET TO WOODWARD AVENUE
JUSTIEN SUBDIVISION

CITY OF NORTH BAY
ENGINEERING DEPARTMENT

SCALE: AS SHOWN ABOVE DATE: JULY/20

DRAWN BY: J.D.	FIELD BOOK No.	DRAWING No.	REV.
CK'D. BY:	200	B-901	