

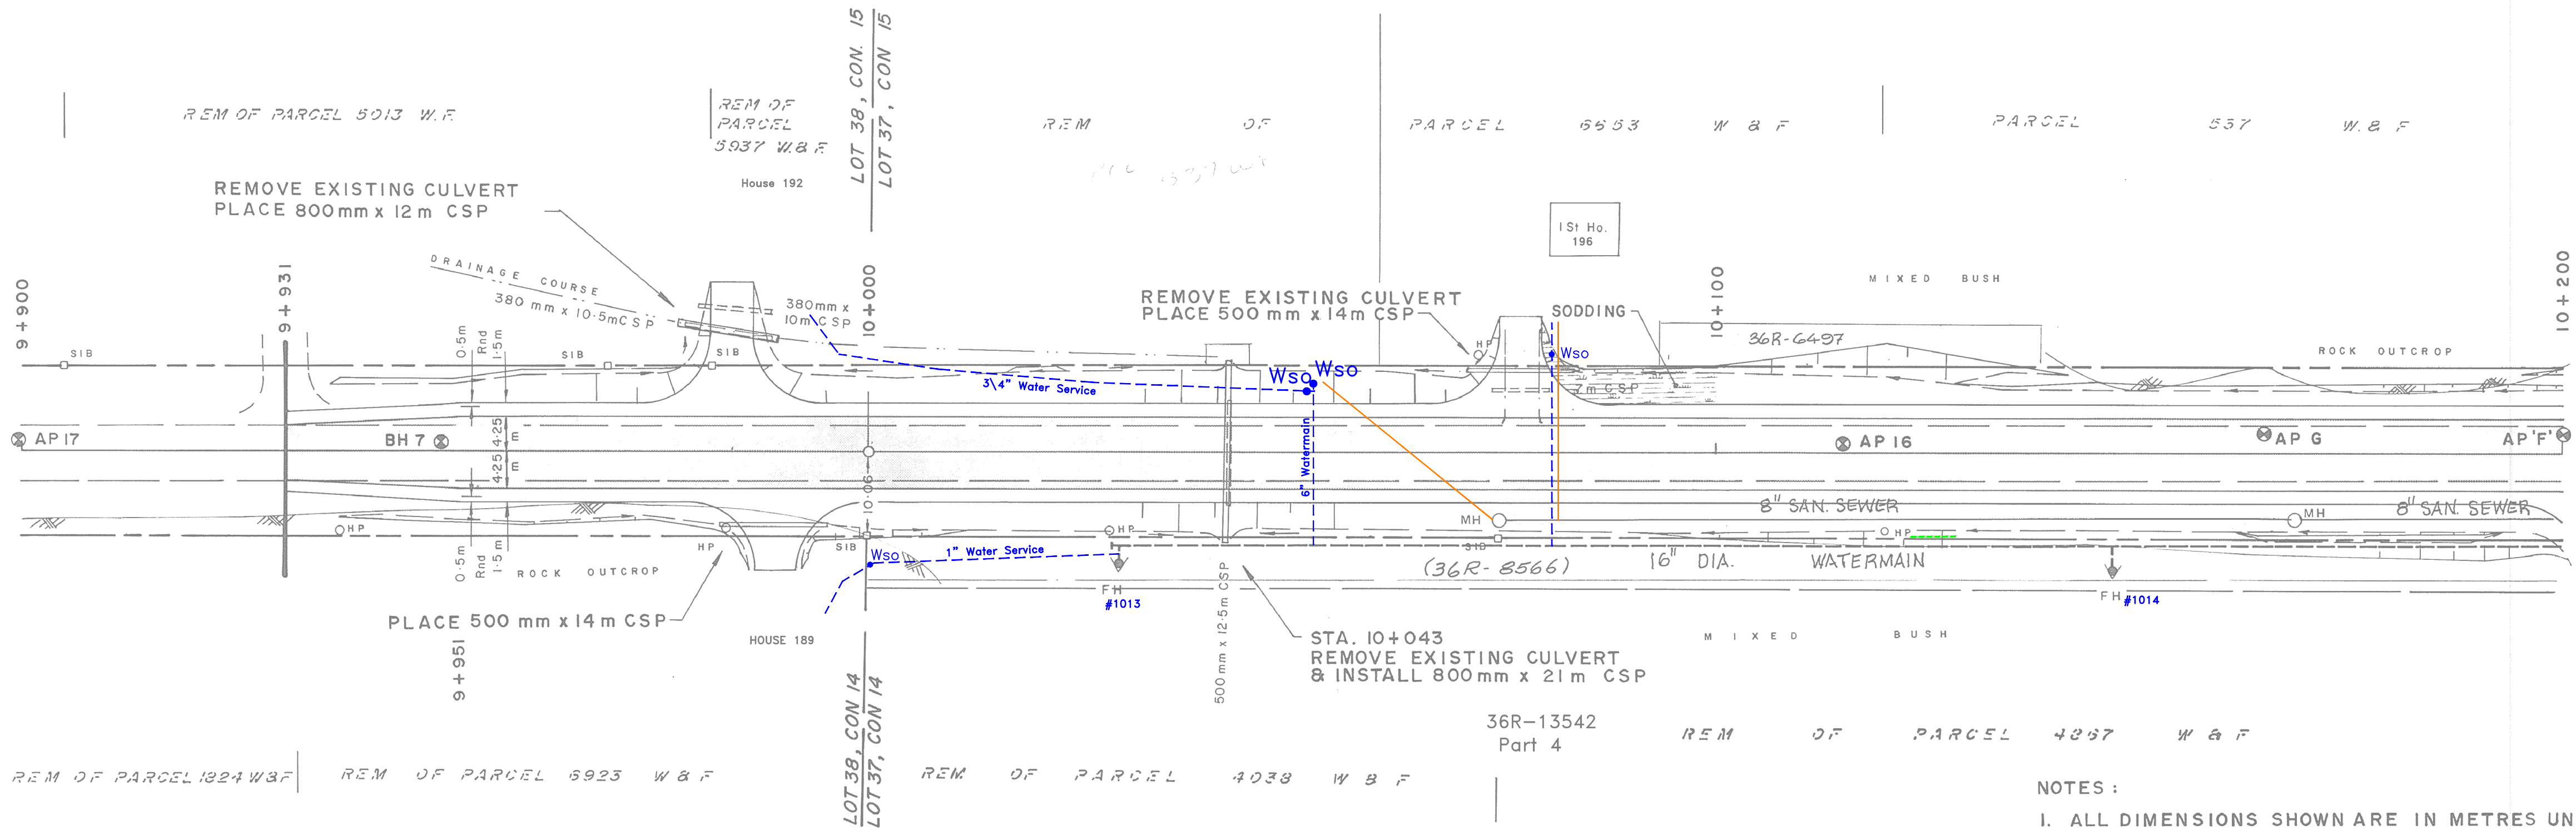


DISCLAIMER
The information contained on this drawing may be based upon data provided by others and may not have been verified by either as-constructed drawings or an Ontario Land Surveyor. The City of North Bay cannot accept responsibility for any errors or omissions on any information shown herein. Field verification, land surveys or excavation (with City approvals) may be required to determine actual location of any and all utilities or property lines.

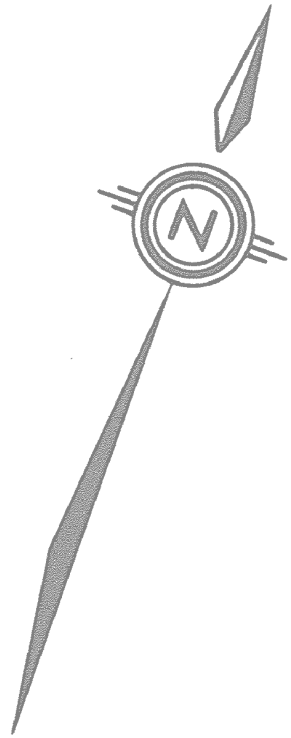

- NOTES:
- ALL DIMENSIONS SHOWN ARE IN METRES UNLESS OTHERWISE NOTED.
 - DEPTH OF GRANULAR 'A' THROUGHOUT PROJECT - 150 mm
 - DEPTH OF GRANULAR 'C' IN EARTH CUTS & FILLS - 450 mm
- IN ROCK CUTS & FILLS - 150 mm
 - HOT MIX HL-4 MAIN ROAD - SURFACE COURSE - 40 mm
- UPPER BINDER COURSE - 50 mm
- LOWER BINDER COURSE - 50 mm
SIDE ROADS - SURFACE COURSE - 40 mm
- BINDER COURSE - 40 mm
COMMERCIAL ENTS - SURFACE COURSE - 40 mm

- LOCATION OF BURIED UTILITIES SHOWN ARE APPROXIMATE AND MUST BE VERIFIED BY THE CONTRACTOR
- NEW HOT MIX PAVING SHOWN THUS: [Pattern]
- SODDING SHOWN THUS: [Pattern]

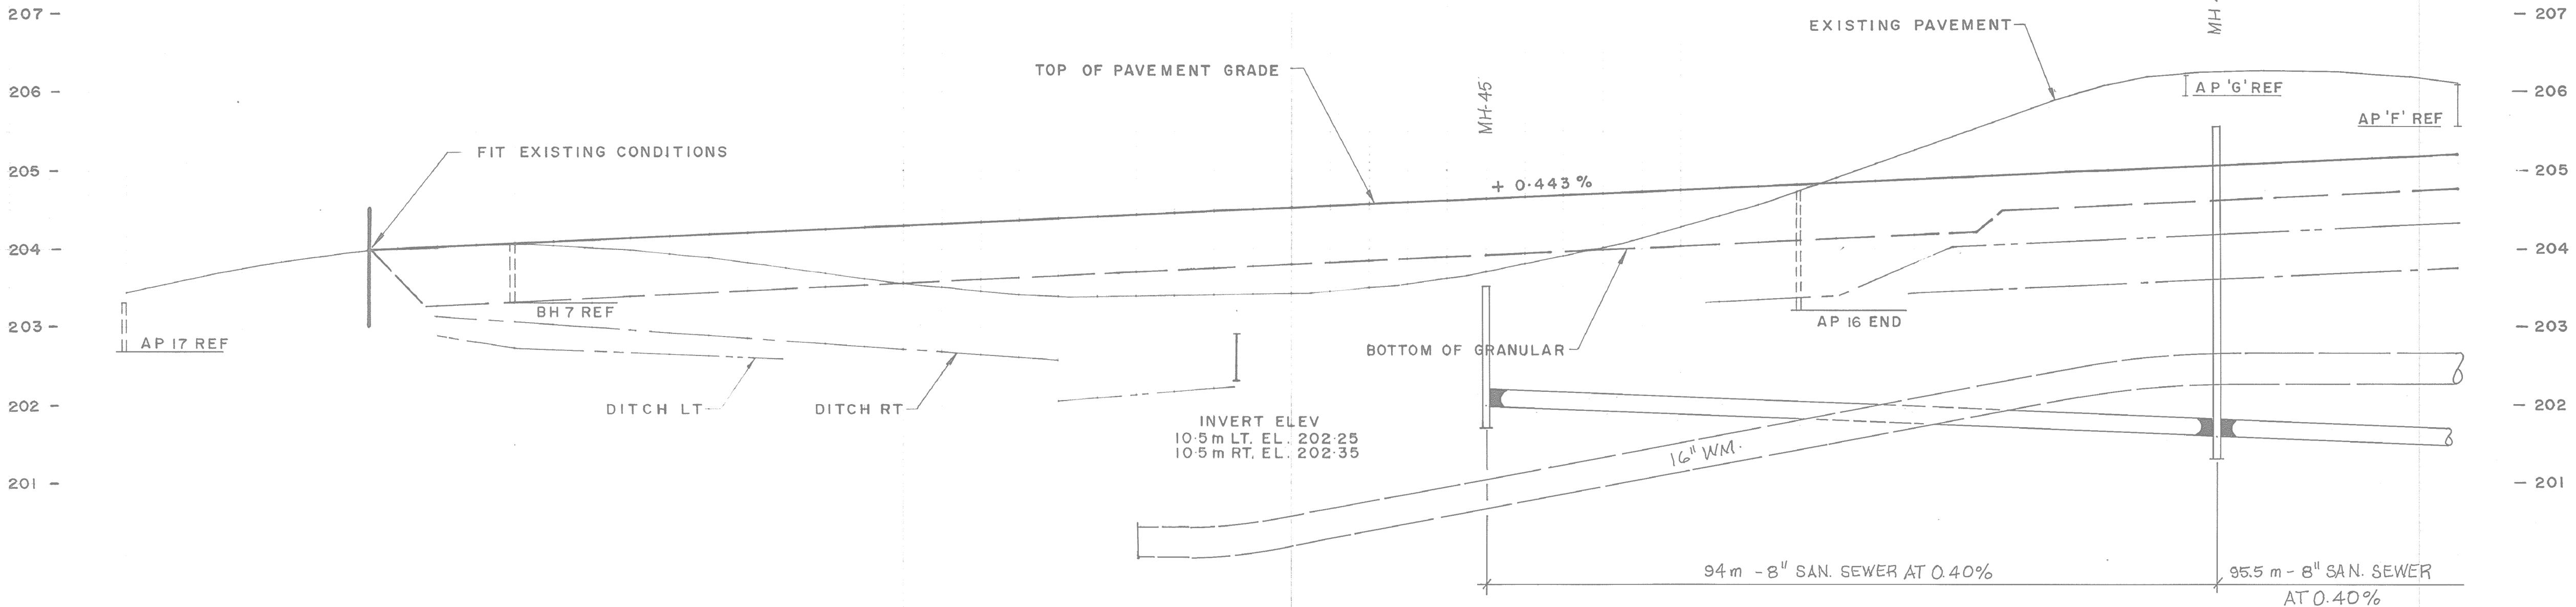

CHAINAGE	9+900	9+931	9+940	9+950	9+984	10+000	10+020	10+043	10+050	10+100	10+120	10+135	10+150	10+200	CHAINAGE
TOP OF PAVEMENT		FIT	204.074		204.296	204.517	204.739	204.960	205.182	205.182	205.182	205.182	205.182	205.182	TOP OF PAVEMENT
DITCH LT		202.90	202.75		202.60	202.08	202.25	203.30	203.40	204.05	204.10	204.33	204.33	204.33	DITCH LT
DITCH RT		203.15	203.08		202.73			203.30		203.52		203.75	203.75	203.75	DITCH RT

REVISIONS		
DATE	DETAILS	BY
Feb 08	SAN. SEWER & WATER FROM CONTR. (MAR 08)	P.B.
Feb 08	Water and Sewer services to Ho 192	W.C.
Dec 13	Added 36R-13542	G.W.C.

RECOMMENDED BY
CITY OF NORTH BAY
DEPARTMENT OF REGIONAL ECONOMIC EXPANSION
AND
MINISTRY OF NORTHERN AFFAIRS

BIRCH'S ROAD
RECONSTRUCTION & WATERMAIN

BIRCH'S ROAD
STA. 9+900 TO STA. 10+200

NORTHLAND ENGINEERING LTD.
Consulting Engineers and Planners

NORTH BAY SUDBURY THUNDER BAY
DRAWN BY: [Signature] DATE: APRIL, 1983
CHECKED BY: [Signature] FIELD BOOK: [Signature]
SCALE: HORIZ 1: 500 CONTRACT N°
VERT. 1: 50

OFFICE PROJECT N° DRAWING N°
NORTH BAY 2368 B-928