

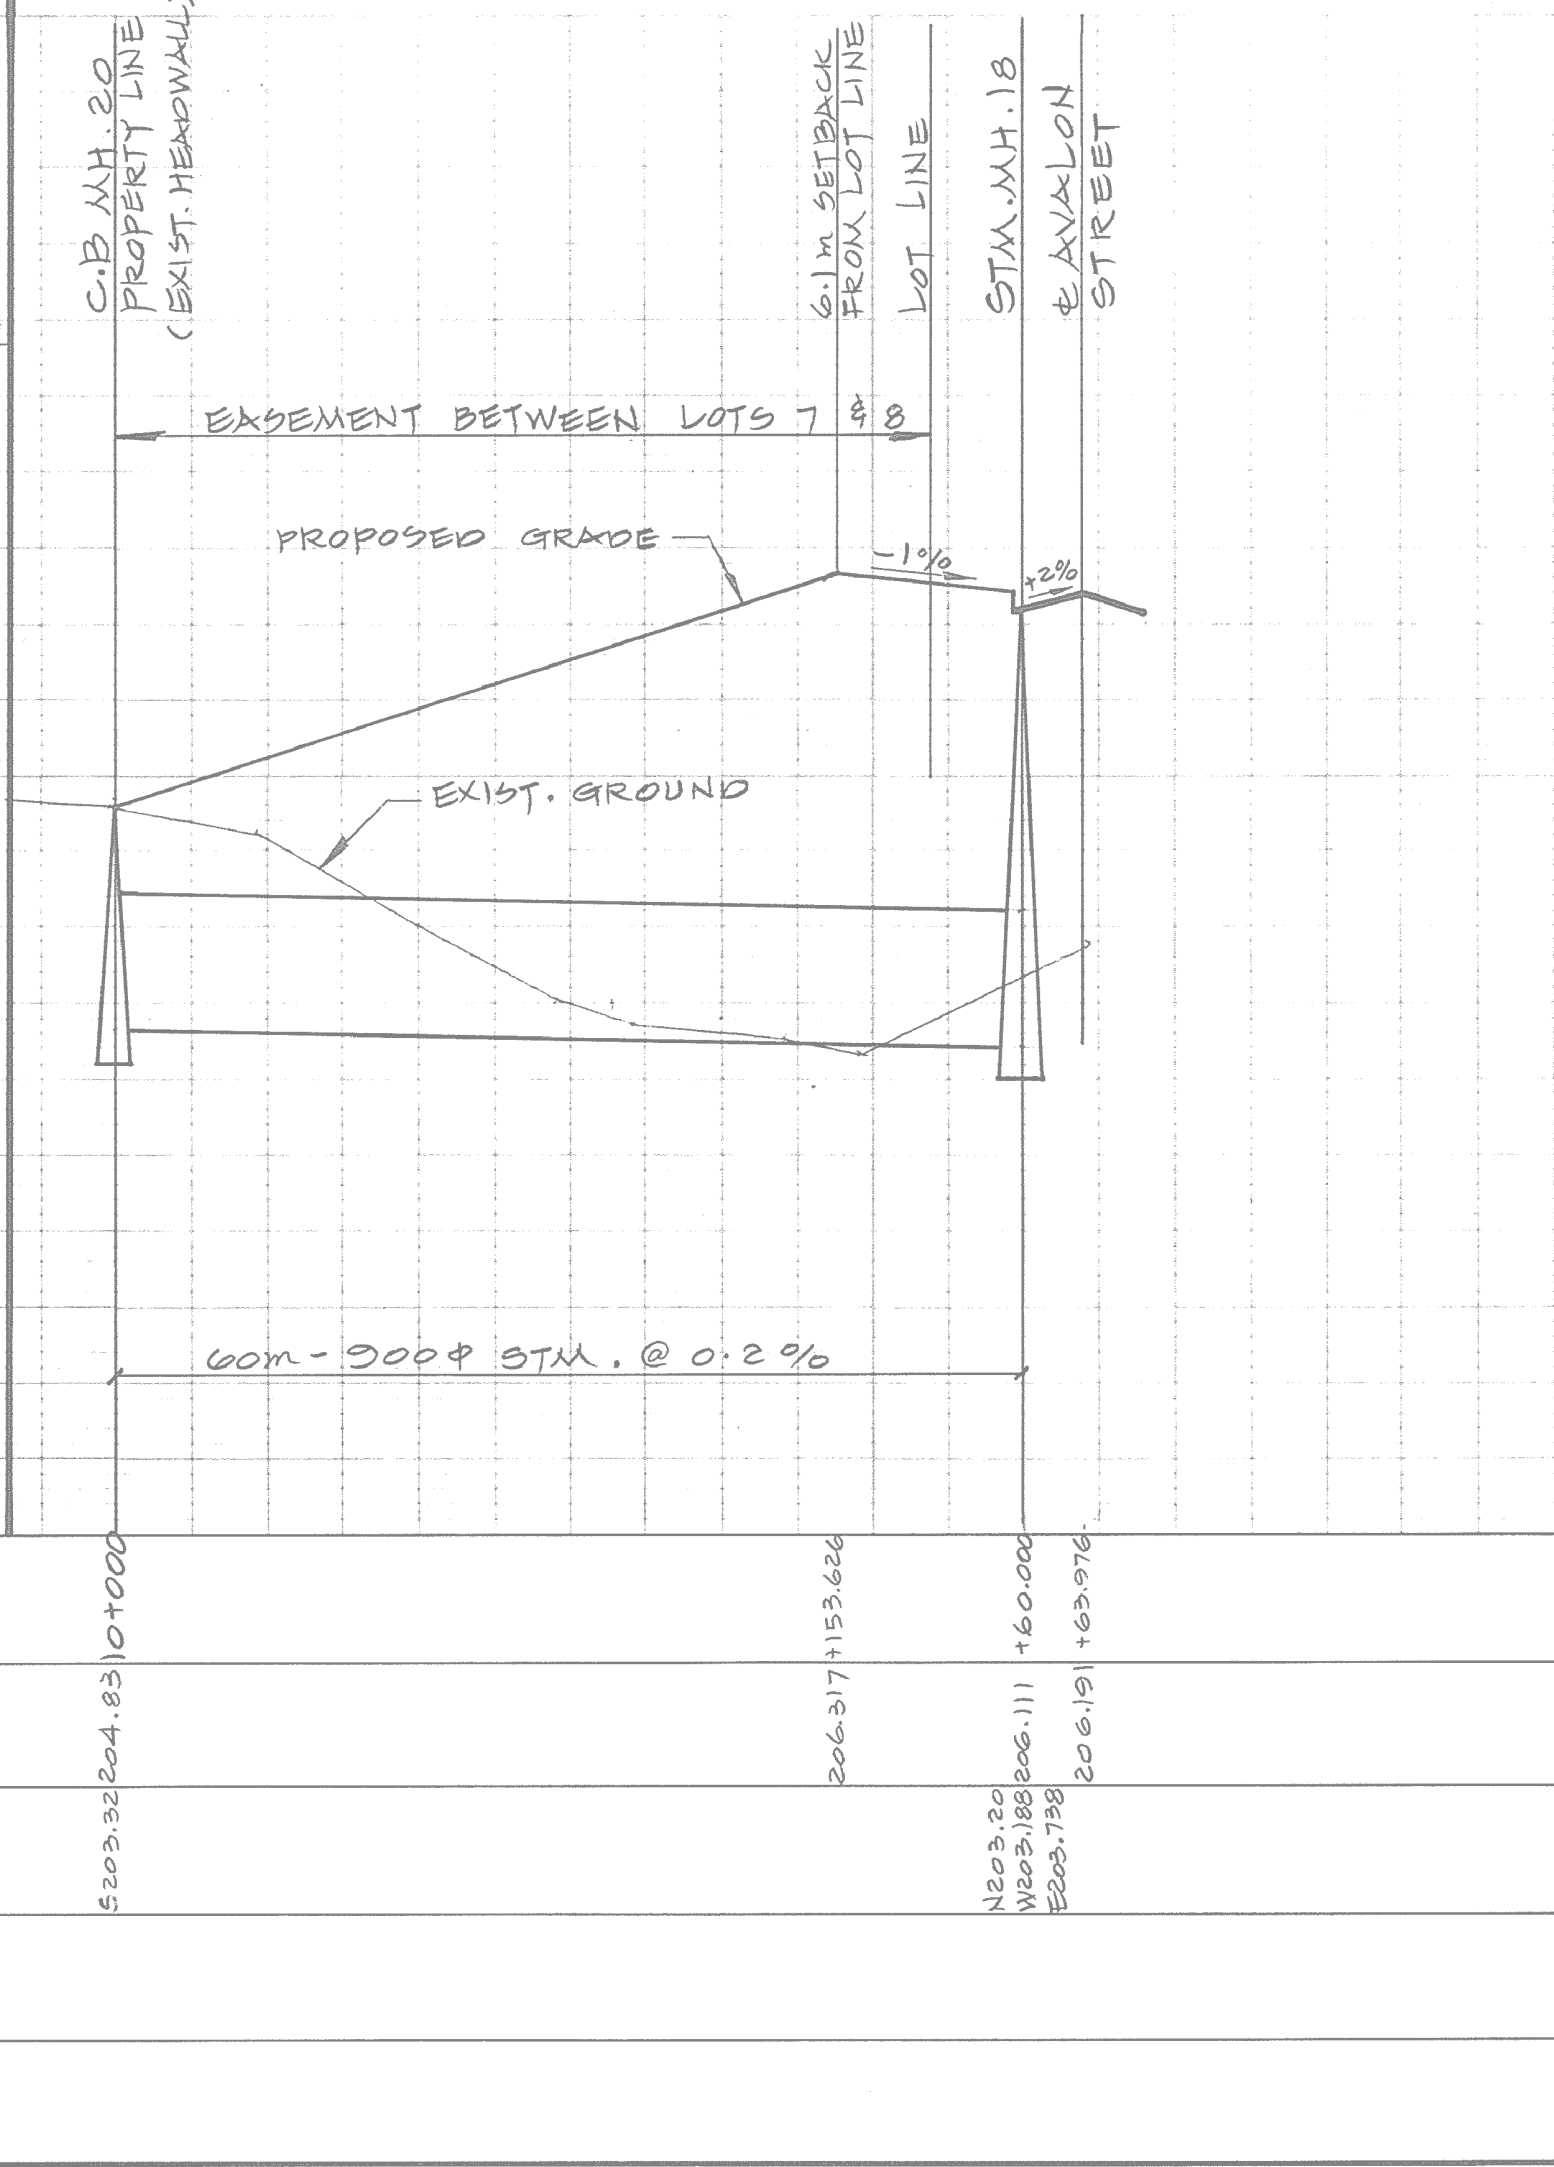
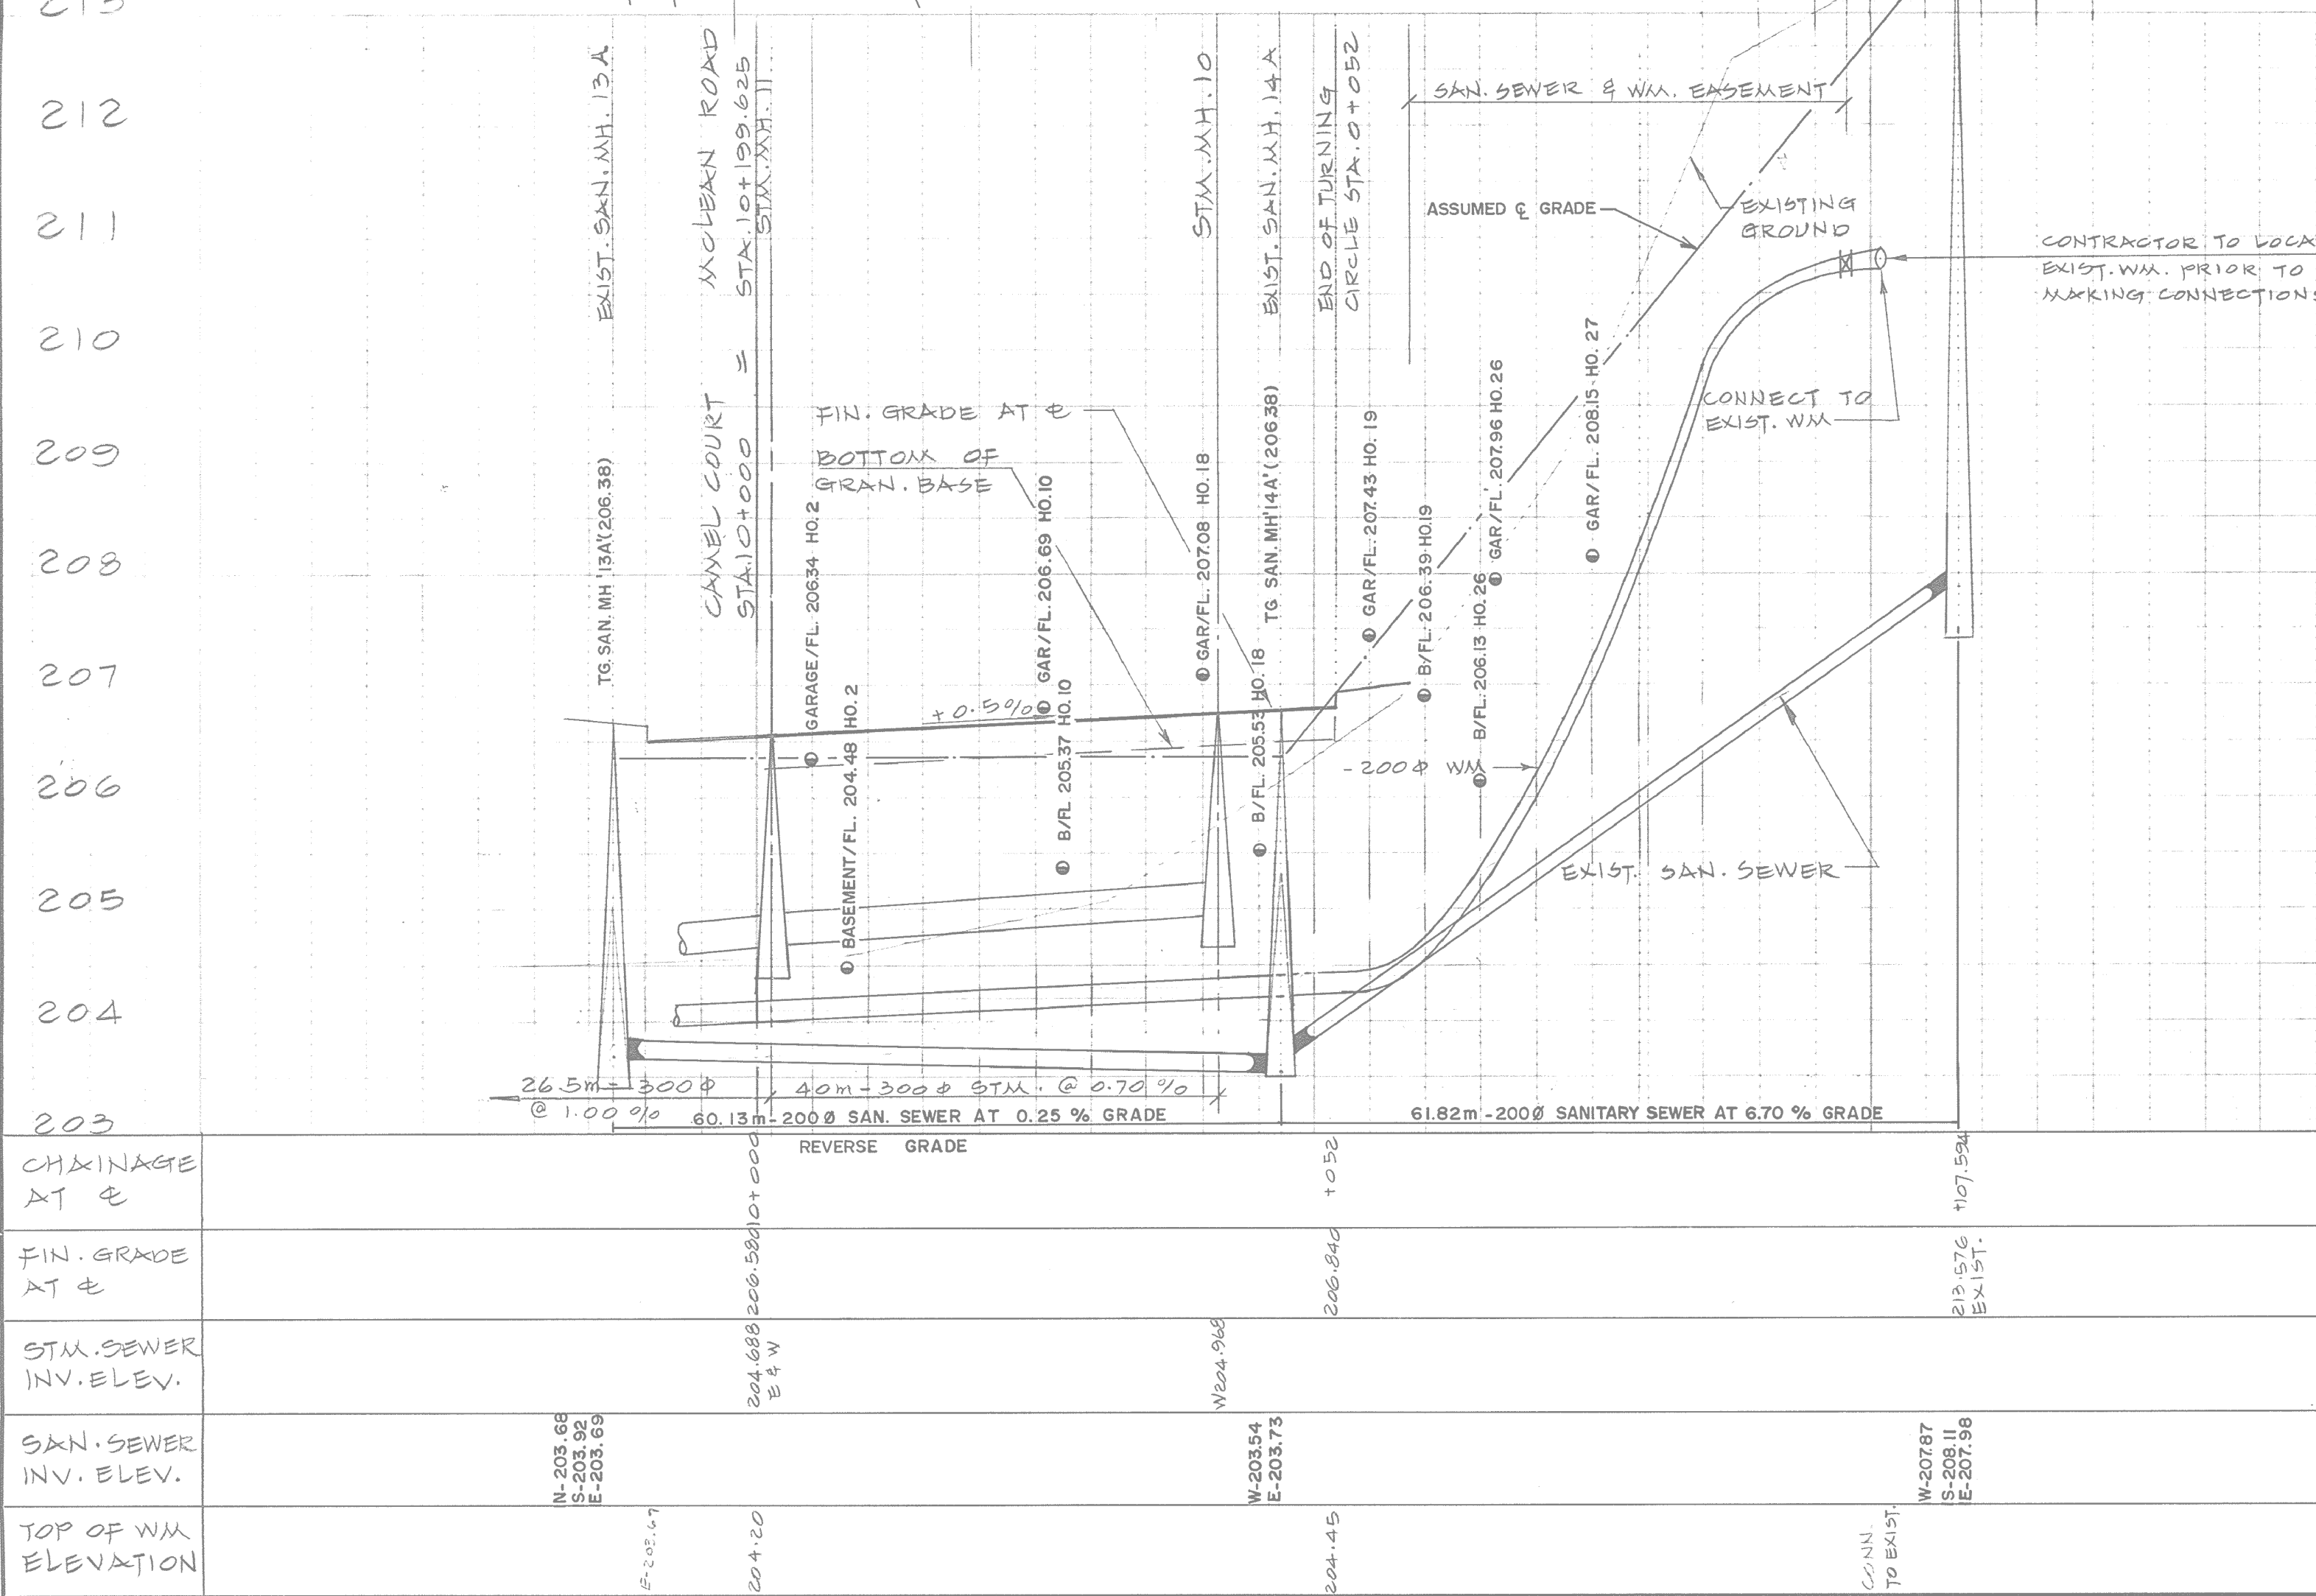


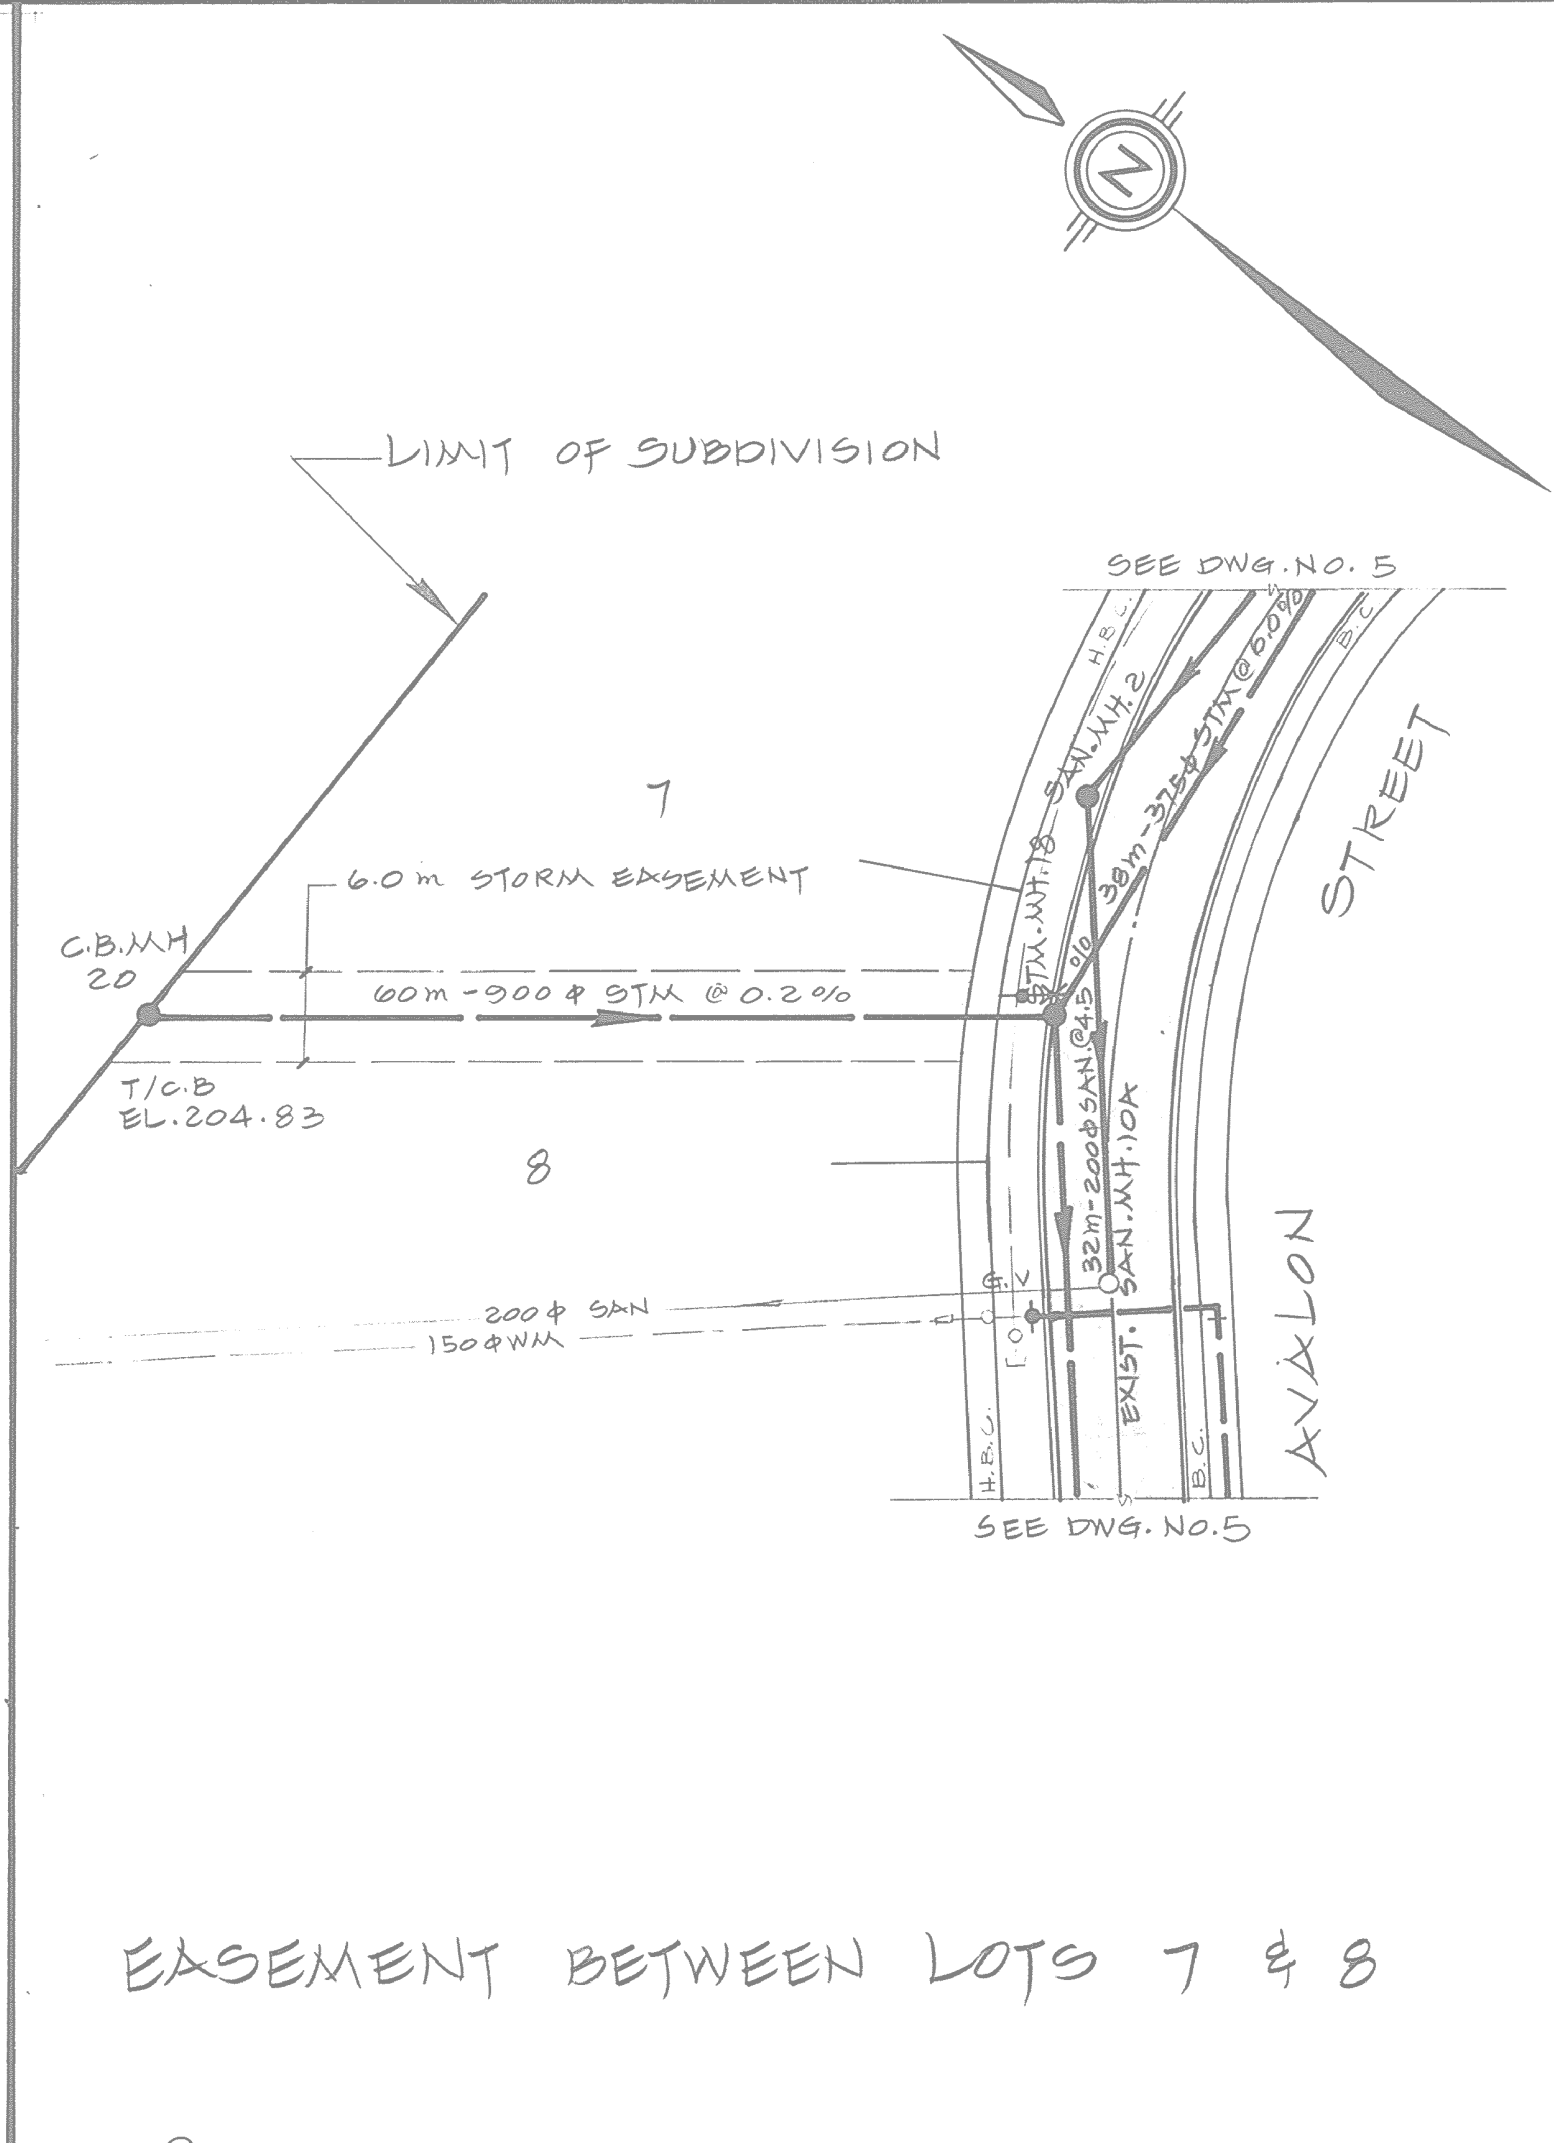

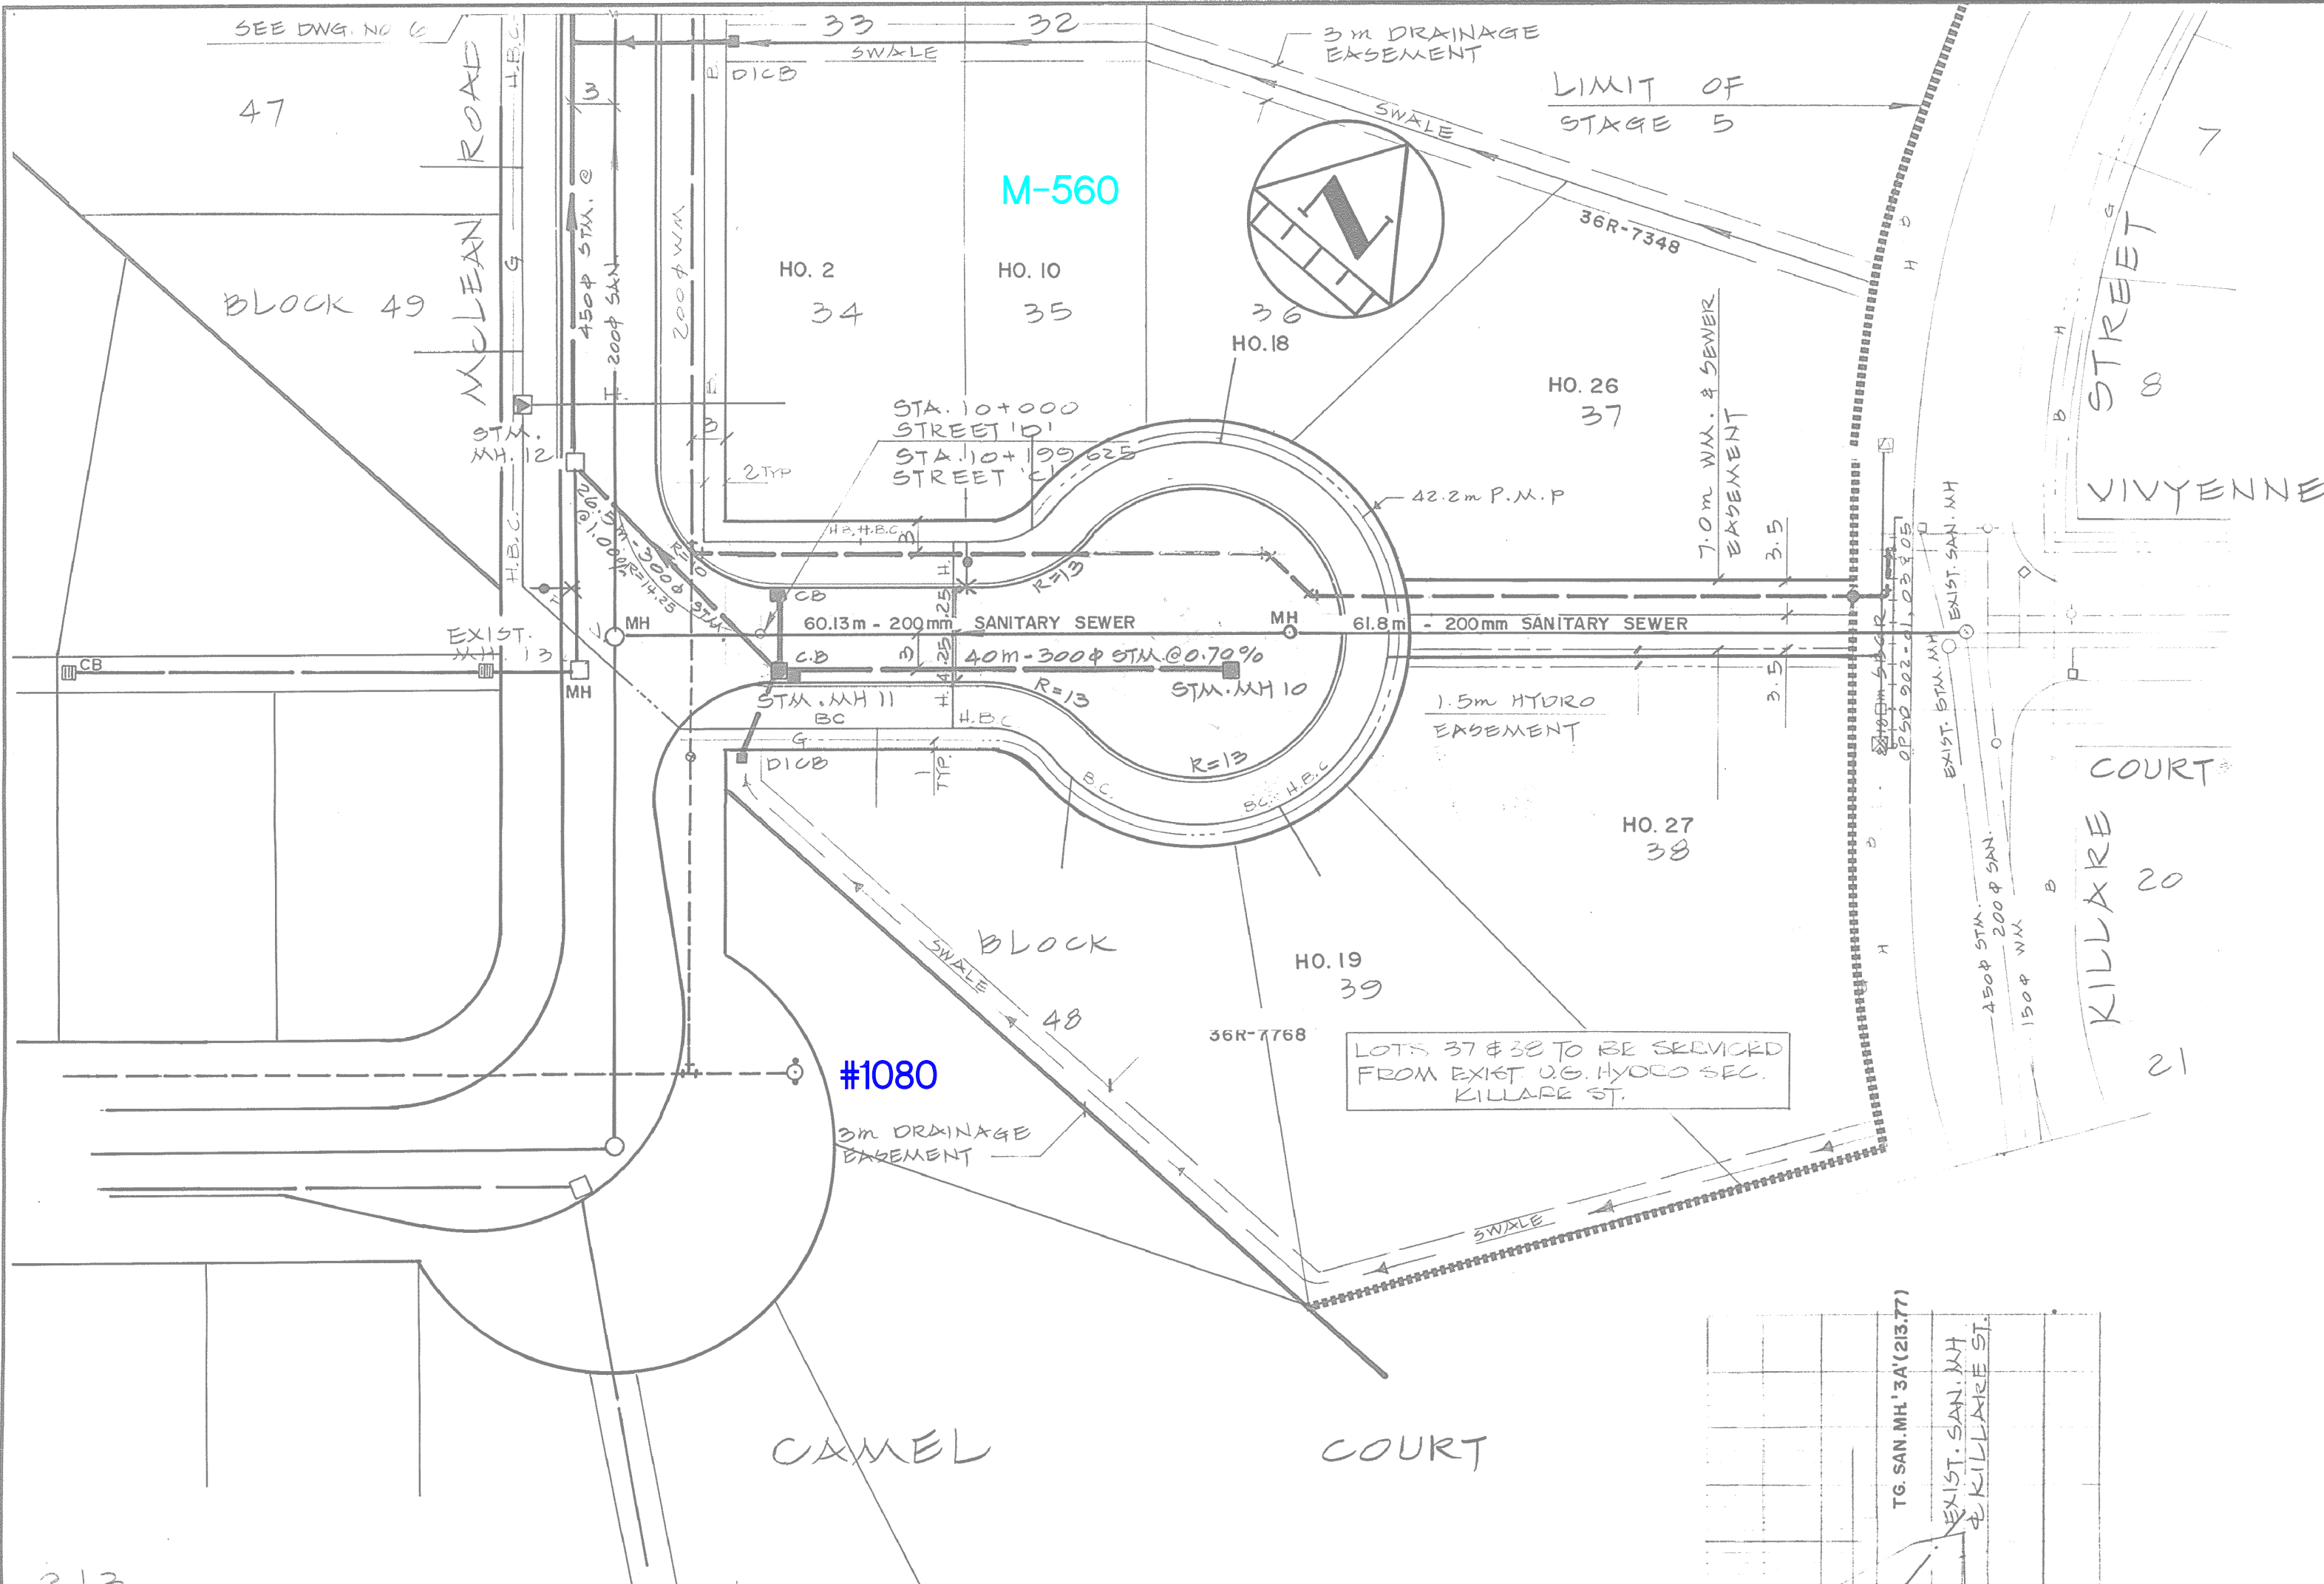

DISCLAIMER

The information contained on this drawing may be based upon data provided by others and may not have been verified by either as-constructed drawings or an Ontario Land Surveyor. The City of North Bay cannot accept responsibility for any errors or omissions on any information shown herein. Field verification, land surveys or excavation (with City approvals) may be required to determine actual location of any and all utilities or property lines.

GAS PLANT APPROVED		CATV PLANT APPROVED	
<i>D. H. H.</i>	8/14/38	<i>B. L. H.</i>	8/14/38
leg. Utilities (Ontario) Ltd.	Date	McLean - Hunter Cable T.V. Ltd.	Date
HYDRO PLANT APPROVED		BELL PLANT APPROVED	
North Bay Hydro		Bell Canada Ltd.	
Date		Date	
REVISIONS			
DATE	DETAILS	BY	
NOV 93	REVISED SANITARY PROFILE	RT	
NOV 93	PLOTTED BASEMENT, GARAGE ELEVATIONS BK. 288	RT	
Aug 07	Registered Plans Added	rjo.	
RECOMMENDED BY			
APPROVED BY			
GAP CONSTRUCTION CO. LTD.			
PELLINORE PARK SUBDIVISION STAGE 5			
PLAN AND PROFILE CAMEL COURT STA. 10+000 TO STA. 10+050 EASEMENT BETWEEN LOTS 7 & 8			
NORTHLAND ENGINEERING LTD.			
Consulting Engineers and Planners			
NORTH BAY		SUBSURY	
THUNDER BAY			
DRAWN BY: S.C.P.		DATE: AUGUST, 1986	
CHECKED BY: M.B.B.		FIELD BOOK:	
SCALE: HORIZ. 1:500 VERT. 1:50		CONTRACT NO:	
OFFICE: NORTH BAY		PROJECT NO: 1389	
		DRAWING NO: C-1026	