


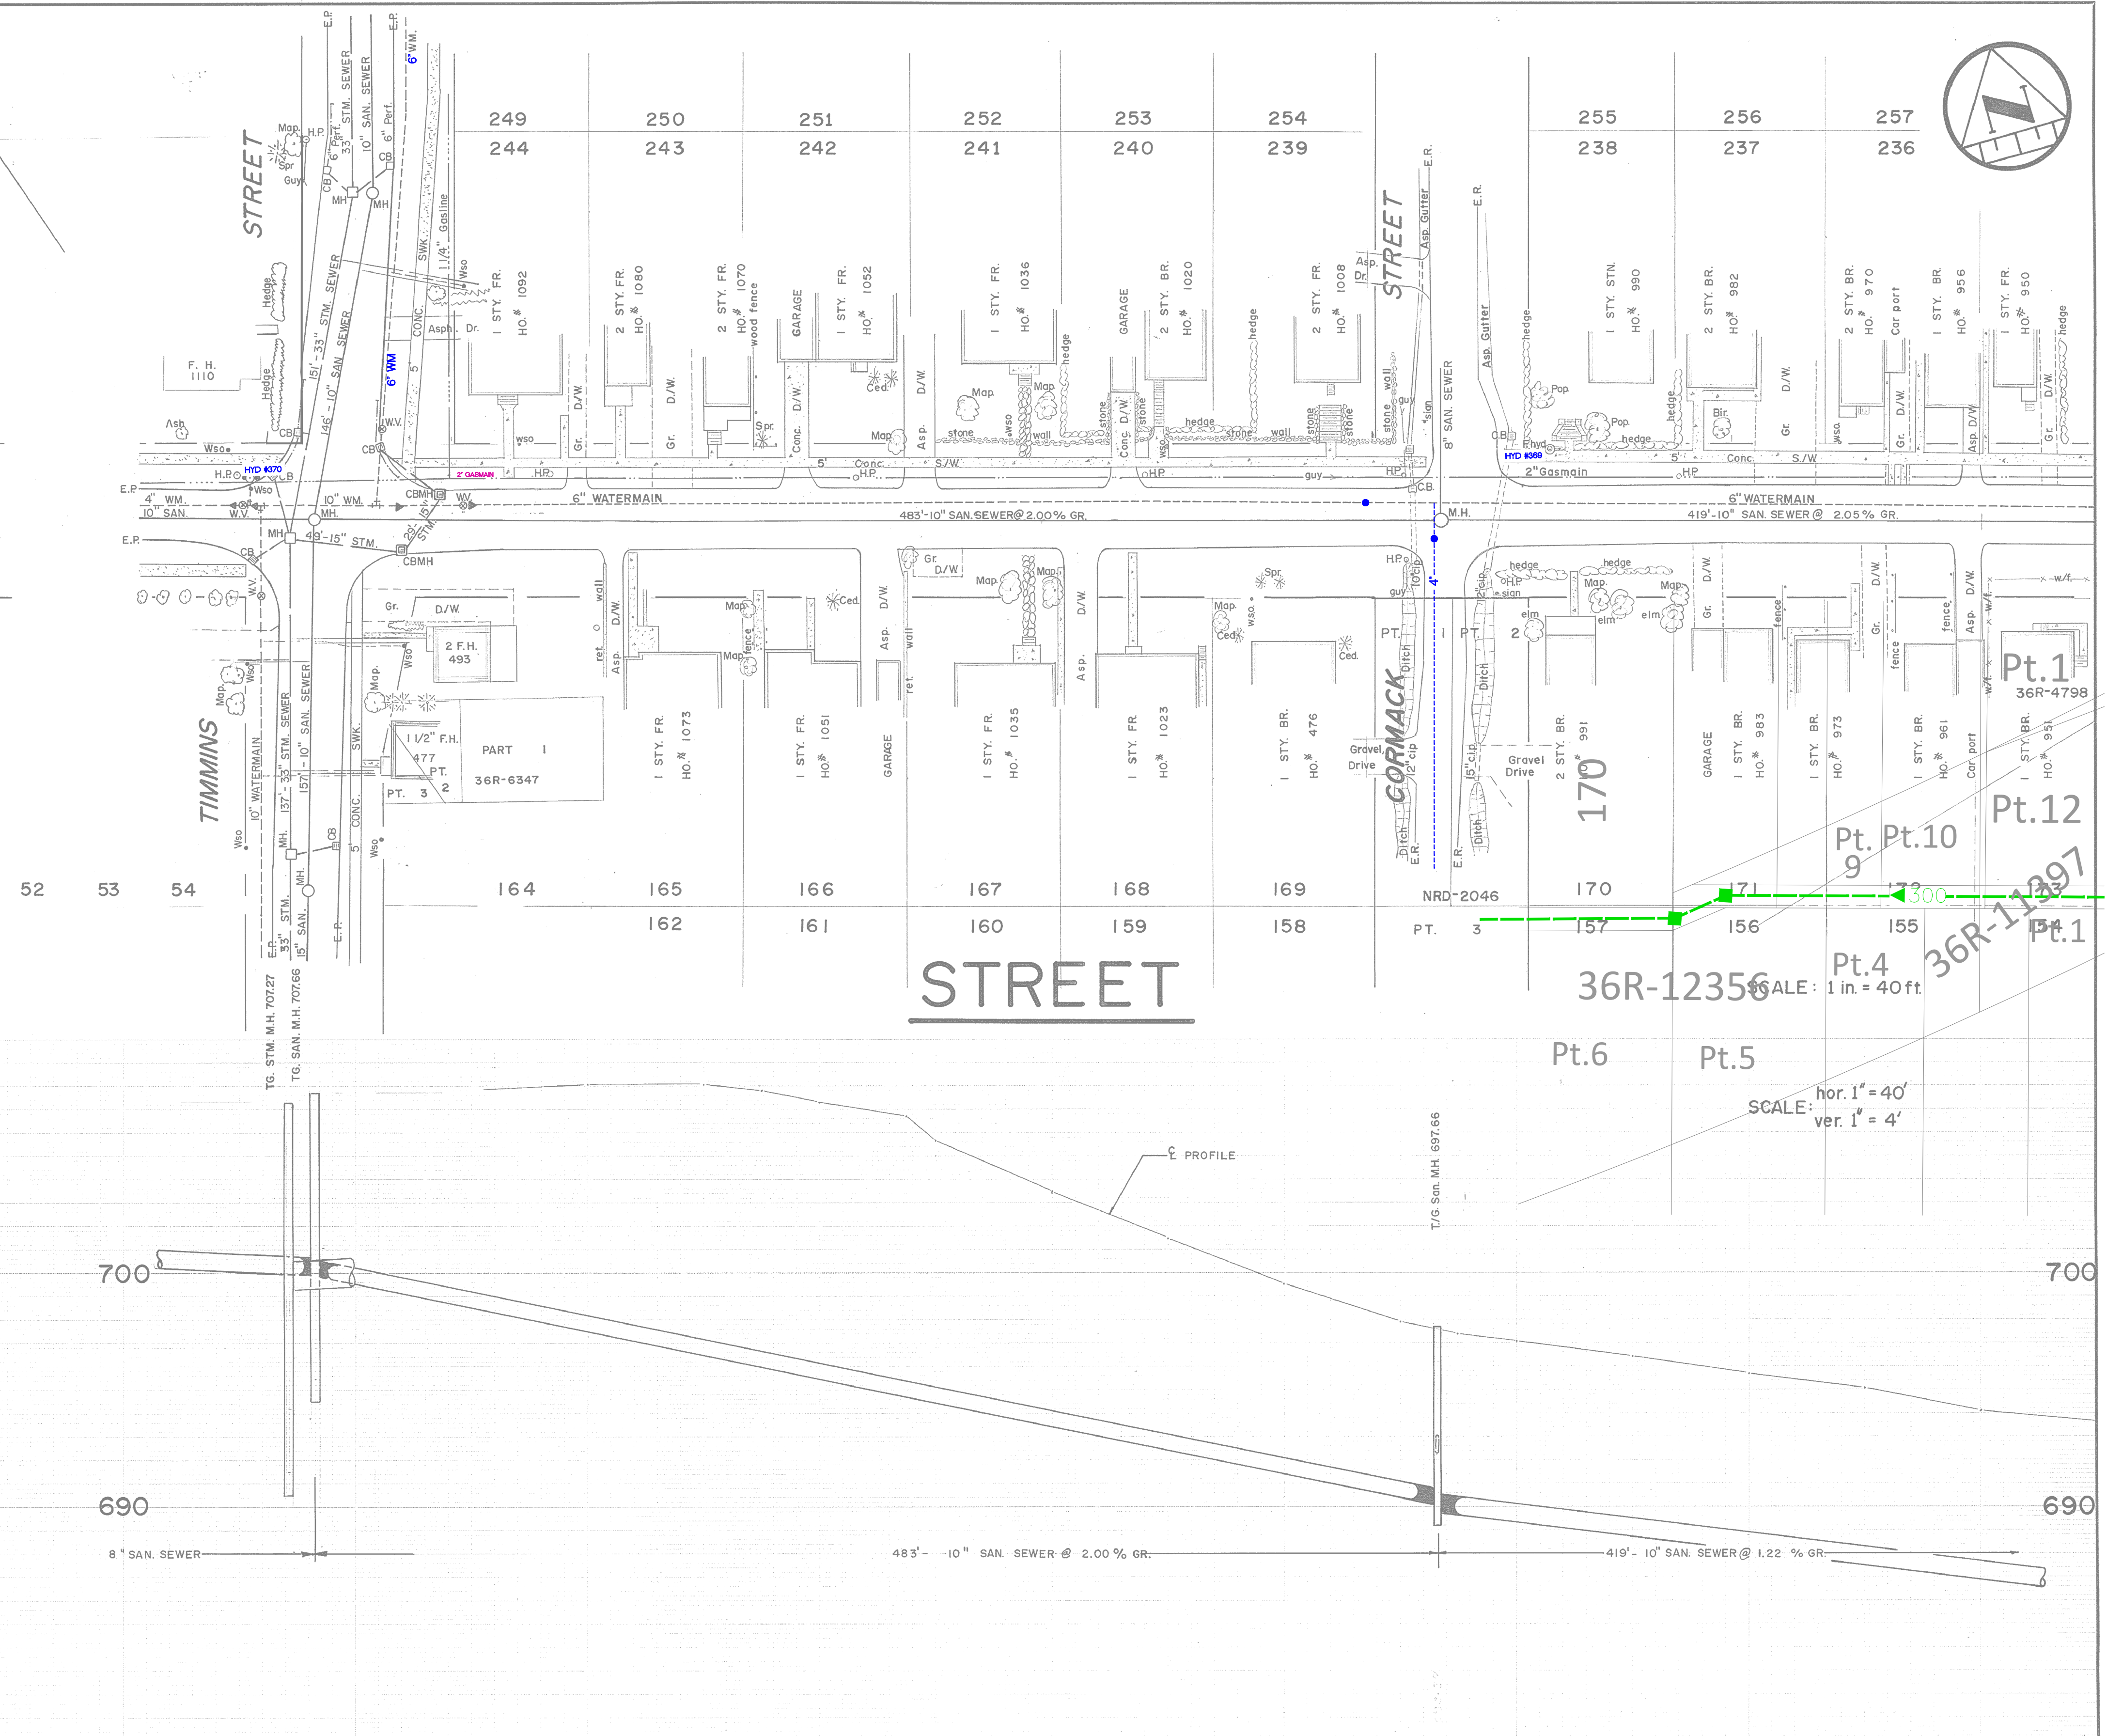

COPELAND

STREET

SCALE: hor. 1" = 40'
ver. 1" = 4'

DMC: 10-	NOTES: DISCLAIMER The information contained on this drawing may be based upon data provided by others and may not have been verified by either as-constructed drawings or an Ontario Land Surveyor. The City of North Bay cannot accept responsibility for any errors or omissions on any information shown herein. Field verification, land surveys or excavation (with City approvals) may be required to determine actual location of any and all utilities or property lines.		NEW DRAWING			29/1/74	APPROVED 	COPELAND STREET		CITY OF NORTH BAY ENGINEERING DEPARTMENT	
			2. REVISE CORMACK ST. INTERSECTION			AUG. 83		J.S.	STATION 3+00 to TIMMINS ST.		
			3. REVISE TIMMINS ST. CONTRACT 101-84(BK. 273)			MAR. 86	J.S.	REG.D. PLAN N ^o . 13 & 89		SCALE: AS SHOWN DATE: JAN. 1974	
										DRAWN BY:  C.K'D. BY:	
										FIELD BOOK No. 219	
										C-103	