


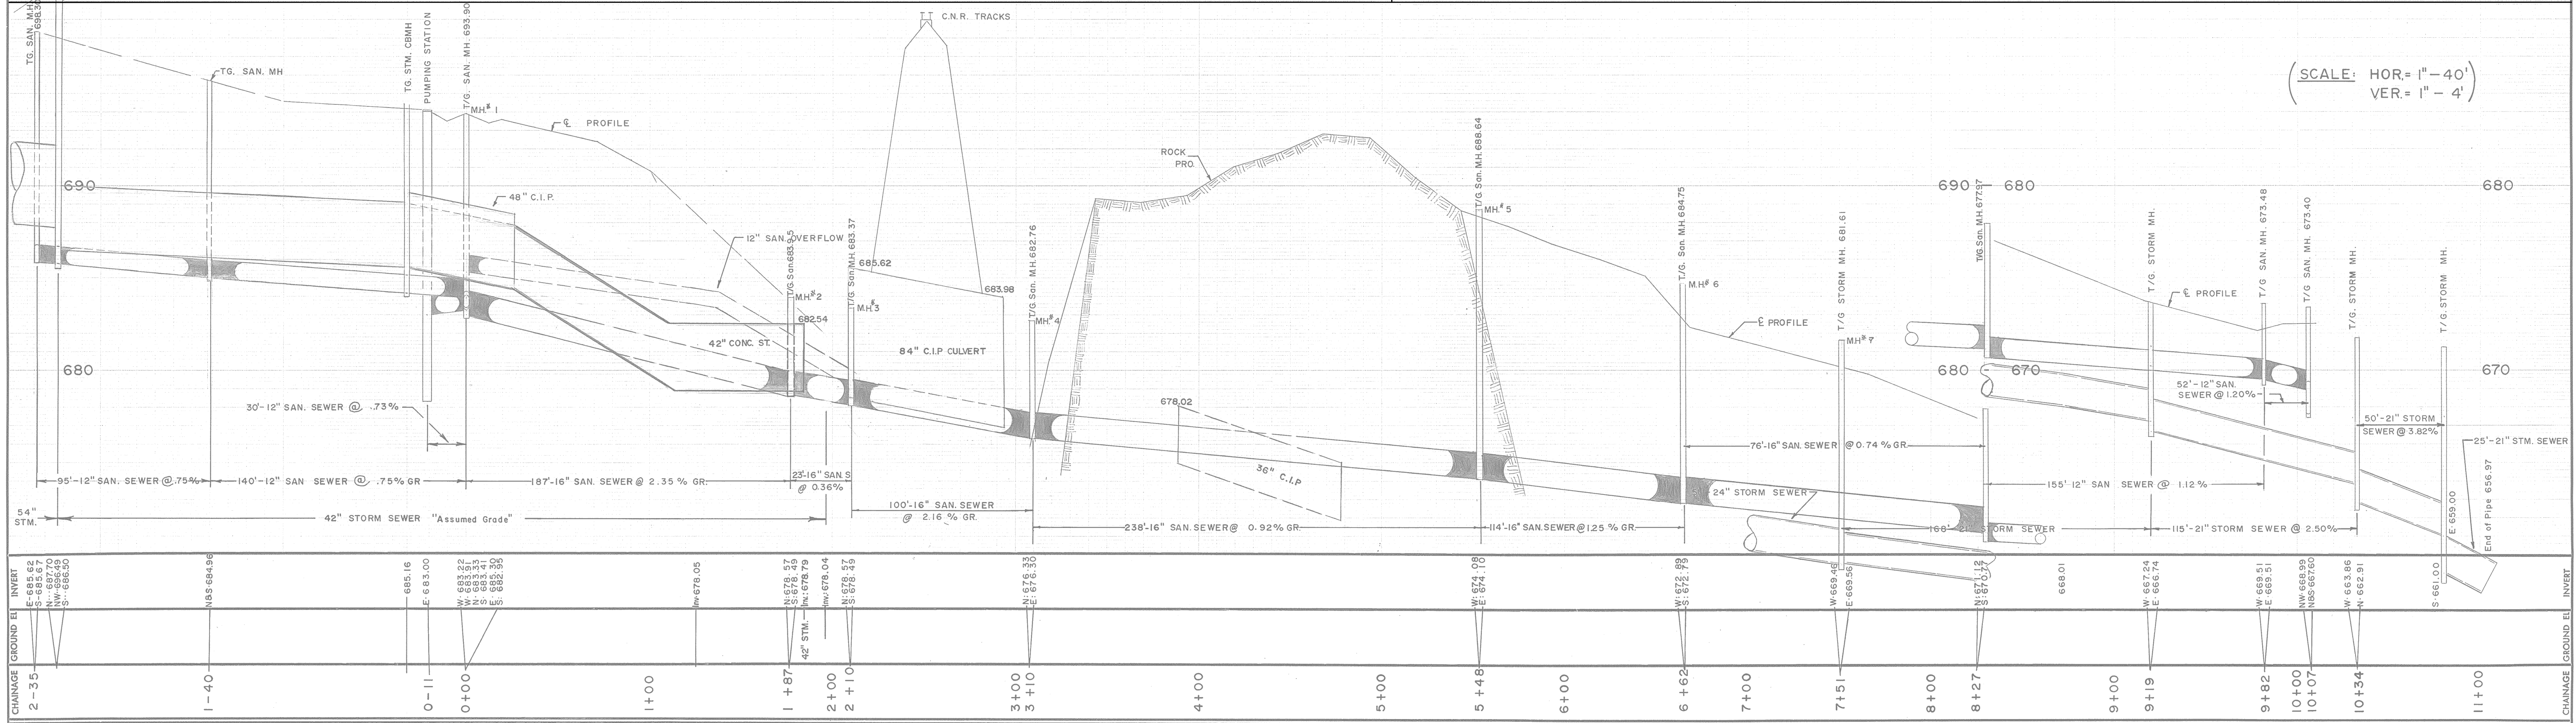

DWC: 140	NOTES:					APPROVED		COPELAND STREET		CITY OF NORTH BAY			
	DISCLAIMER The information contained on this drawing may be based upon data provided by others and may not have been verified by either as-constructed drawings or an Ontario Land Surveyor. The City of North Bay cannot accept responsibility for any errors or omissions on any information shown herein. Field verification, land surveys or excavation (with City approvals) may be required to determine actual location of any and all utilities or property lines. 	NEW DRAWING				SEPT. 73	R98	EASEMENT - COPELAND ST. to HARRIET ST.		ENGINEERING DEPARTMENT			
		16" SANITARY SEWER AS CONS.				22/2/74	GJR	REG'D. PLAN N ^o . - 53, 116, 36R-2775.					
		REVISE SEWER COPELAND - JANE				APR. 76	R.F.B.						
		REVISE STM. SEWER JANE to COPELAND				MAY 85	J.S.						
		EXTEND 42" STM. SEWER & REVISE GRADE				MAR. 88	Rick B.			SCALE: As Shown			
		REVISED DETAIL & PROFILE - 42", 84", 36" STM.				JAN. 96	R.T.			DATE: SEPT. 73			
		Updated Legal and some Infrastructure				MAY 2025	QWC.			DRAWN BY: R98			
		No.				REVISION		DATE		INITIAL		FIELD BOOK N ^o .	
												C - 106	

