
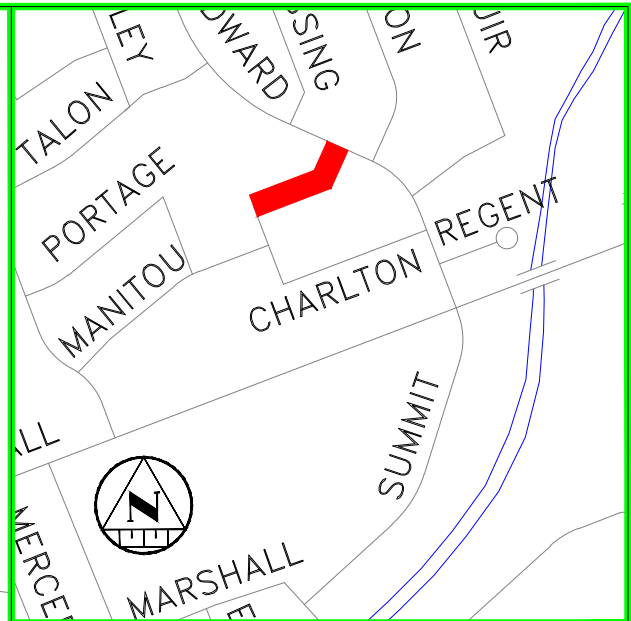


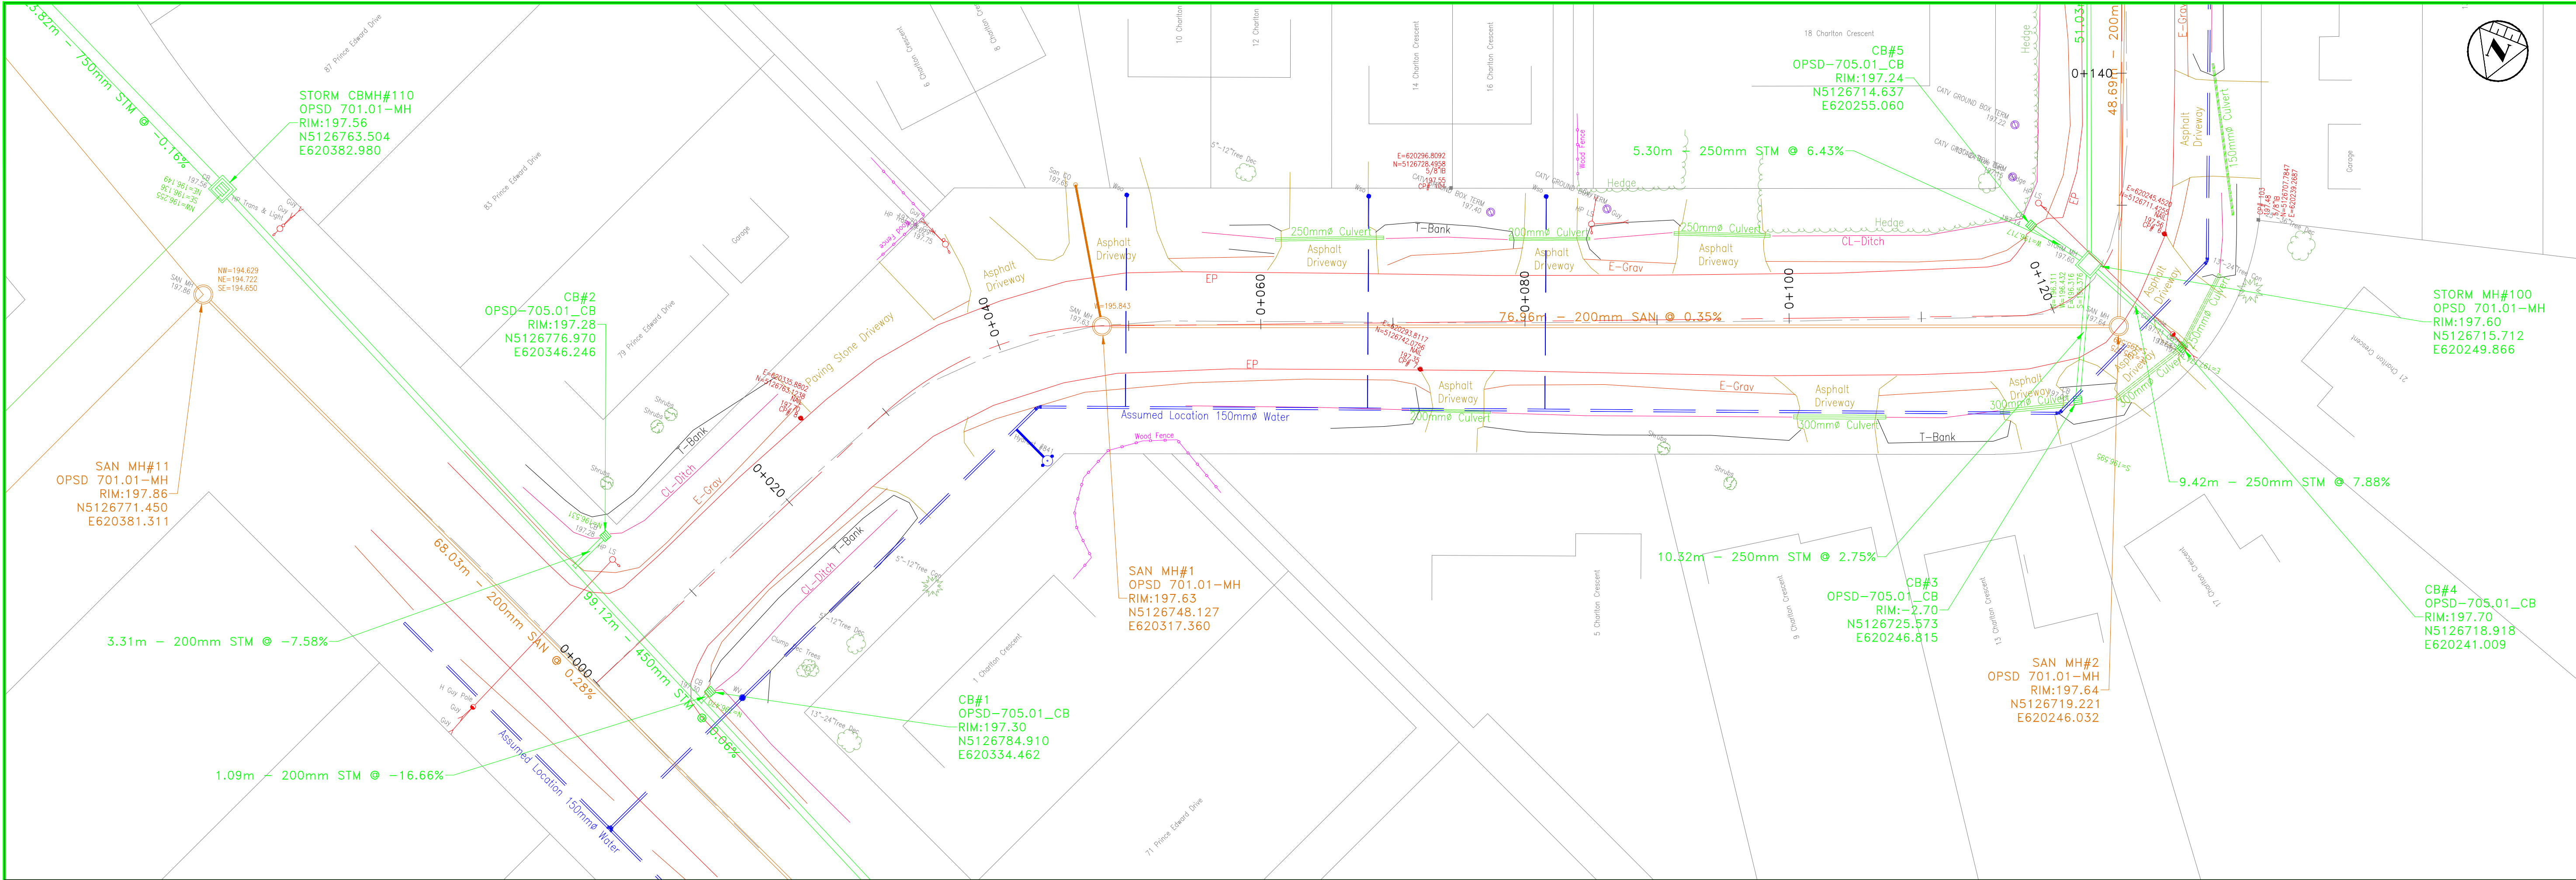

KEY PLAN

LEGEND

REVISIONS

no.	date	by	description
1.	3 Nov 2015		As-Built

Disclaimer

The information contained on this drawing may be based upon data provided by others and may not have been verified by either as-constructed drawings or an Ontario Land Surveyor. The City of North Bay cannot accept responsibility for any errors or omissions on any information shown herein. Field verification, land surveys or excavation (with City approvals) may be required to determine actual location of any and all utilities or property lines.

REQUIRED P.ENG
STAMP



From Prince Edward Dr.
(North) to First Bend

AS-BUILT

CHARLTON_CRES.

STA. 0+000 to 0+120

designer drawn by:
G.W.C.

checked by: approved by:

scale
H. 1:250
V. 1:50

date drawing number
11/3/2015 C-277

Charlton Cres. CL PROFILE

