


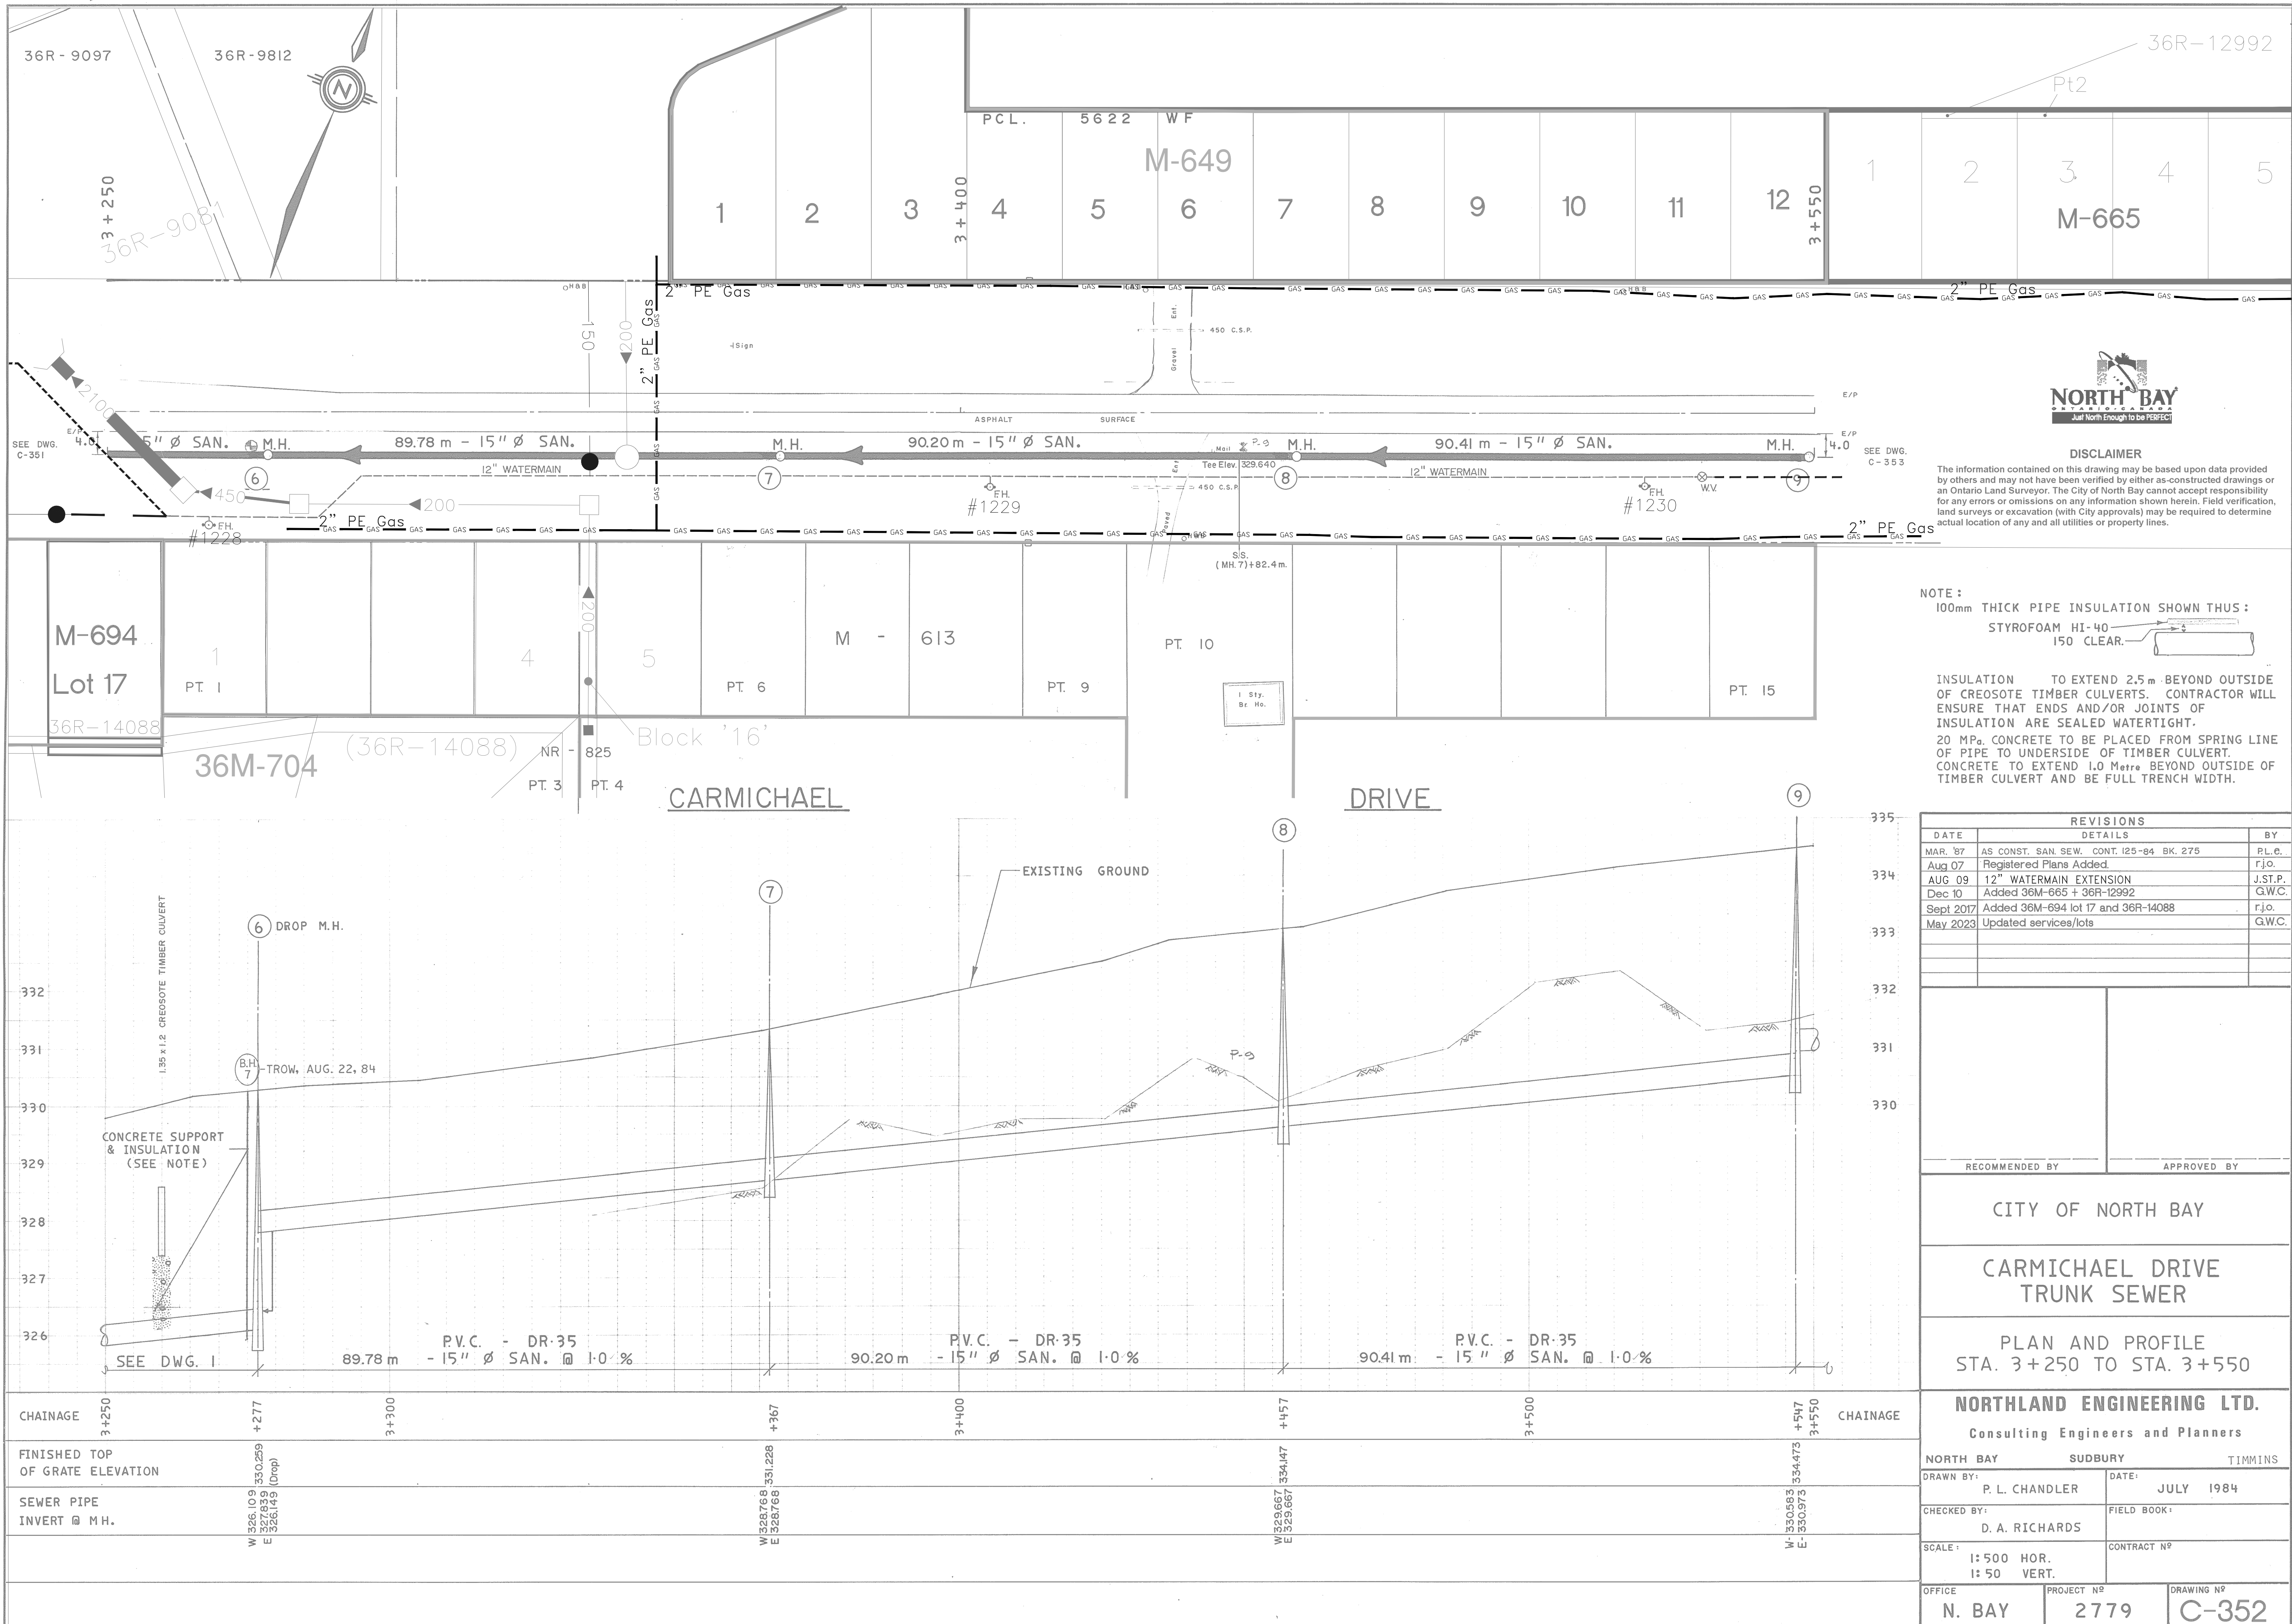

DISCLAIMER
The information contained on this drawing may be based upon data provided by others and may not have been verified by either as-constructed drawings or an Ontario Land Surveyor. The City of North Bay cannot accept responsibility for any errors or omissions on any information shown herein. Field verification, land surveys or excavation (with City approvals) may be required to determine actual location of any and all utilities or property lines.

NOTE :
100mm THICK PIPE INSULATION SHOWN THUS :
STYROFOAM HI-40
150 CLEAR.

INSULATION TO EXTEND 2.5 m BEYOND OUTSIDE OF CREOSOTE TIMBER CULVERTS. CONTRACTOR WILL ENSURE THAT ENDS AND/OR JOINTS OF INSULATION ARE SEALED WATERTIGHT.
20 MPa CONCRETE TO BE PLACED FROM SPRING LINE OF PIPE TO UNDERSIDE OF TIMBER CULVERT.
CONCRETE TO EXTEND 1.0 Metre BEYOND OUTSIDE OF TIMBER CULVERT AND BE FULL TRENCH WIDTH.

REVISIONS		
DATE	DETAILS	BY
MAR. '87	AS CONST. SAN. SEW. CONT. 125-84 BK. 275	P.L.C.
Aug 07	Registered Plans Added.	r.j.o.
AUG 09	12" WATERMAIN EXTENSION	J.ST.P.
Dec 10	Added 36M-665 + 36R-12992	G.W.C.
Sept 2017	Added 36M-694 lot 17 and 36R-14088	r.j.o.
May 2023	Updated services/lots	G.W.C.

RECOMMENDED BY	APPROVED BY

CITY OF NORTH BAY

CARMICHAEL DRIVE
TRUNK SEWER

PLAN AND PROFILE
STA. 3+250 TO STA. 3+550

NORTHLAND ENGINEERING LTD.		
Consulting Engineers and Planners		
NORTH BAY	SUDBURY	TIMMINS
DRAWN BY: P. L. CHANDLER	DATE: JULY 1984	
CHECKED BY: D. A. RICHARDS	FIELD BOOK:	
SCALE: 1:500 HOR. 1:50 VERT.	CONTRACT N°	
OFFICE N. BAY	PROJECT N° 2779	DRAWING N° C-352