





B.M. ELEV. 343.67
NAIL IN BIRCH TREE S.W. CORNER
LITLEDOWN LANE AND AIRPORT ROAD.

LEGEND

- 337.50 PROPOSED FINISHED GROUND ELEVATION AT BUILDING
- 337.89 PROPOSED FINISHED GROUND ELEVATION AT LOT CORNER
- 335.10 ORIGINAL GROUND ELEVATION
- DIRECTION OF SURFACE DRAINAGE
- BELL TELEPHONE PEDESTAL
- SERVICE CONNECTION (WATER & SEWER)
- EXIST. POLE TO BE REMOVED
- PROPOSED 35' WOOD POLE
- PROPOSED ANCHOR
- PROPOSED 200 WATT H.P.S.
- BURIED BELL CABLE
- GAS LINE

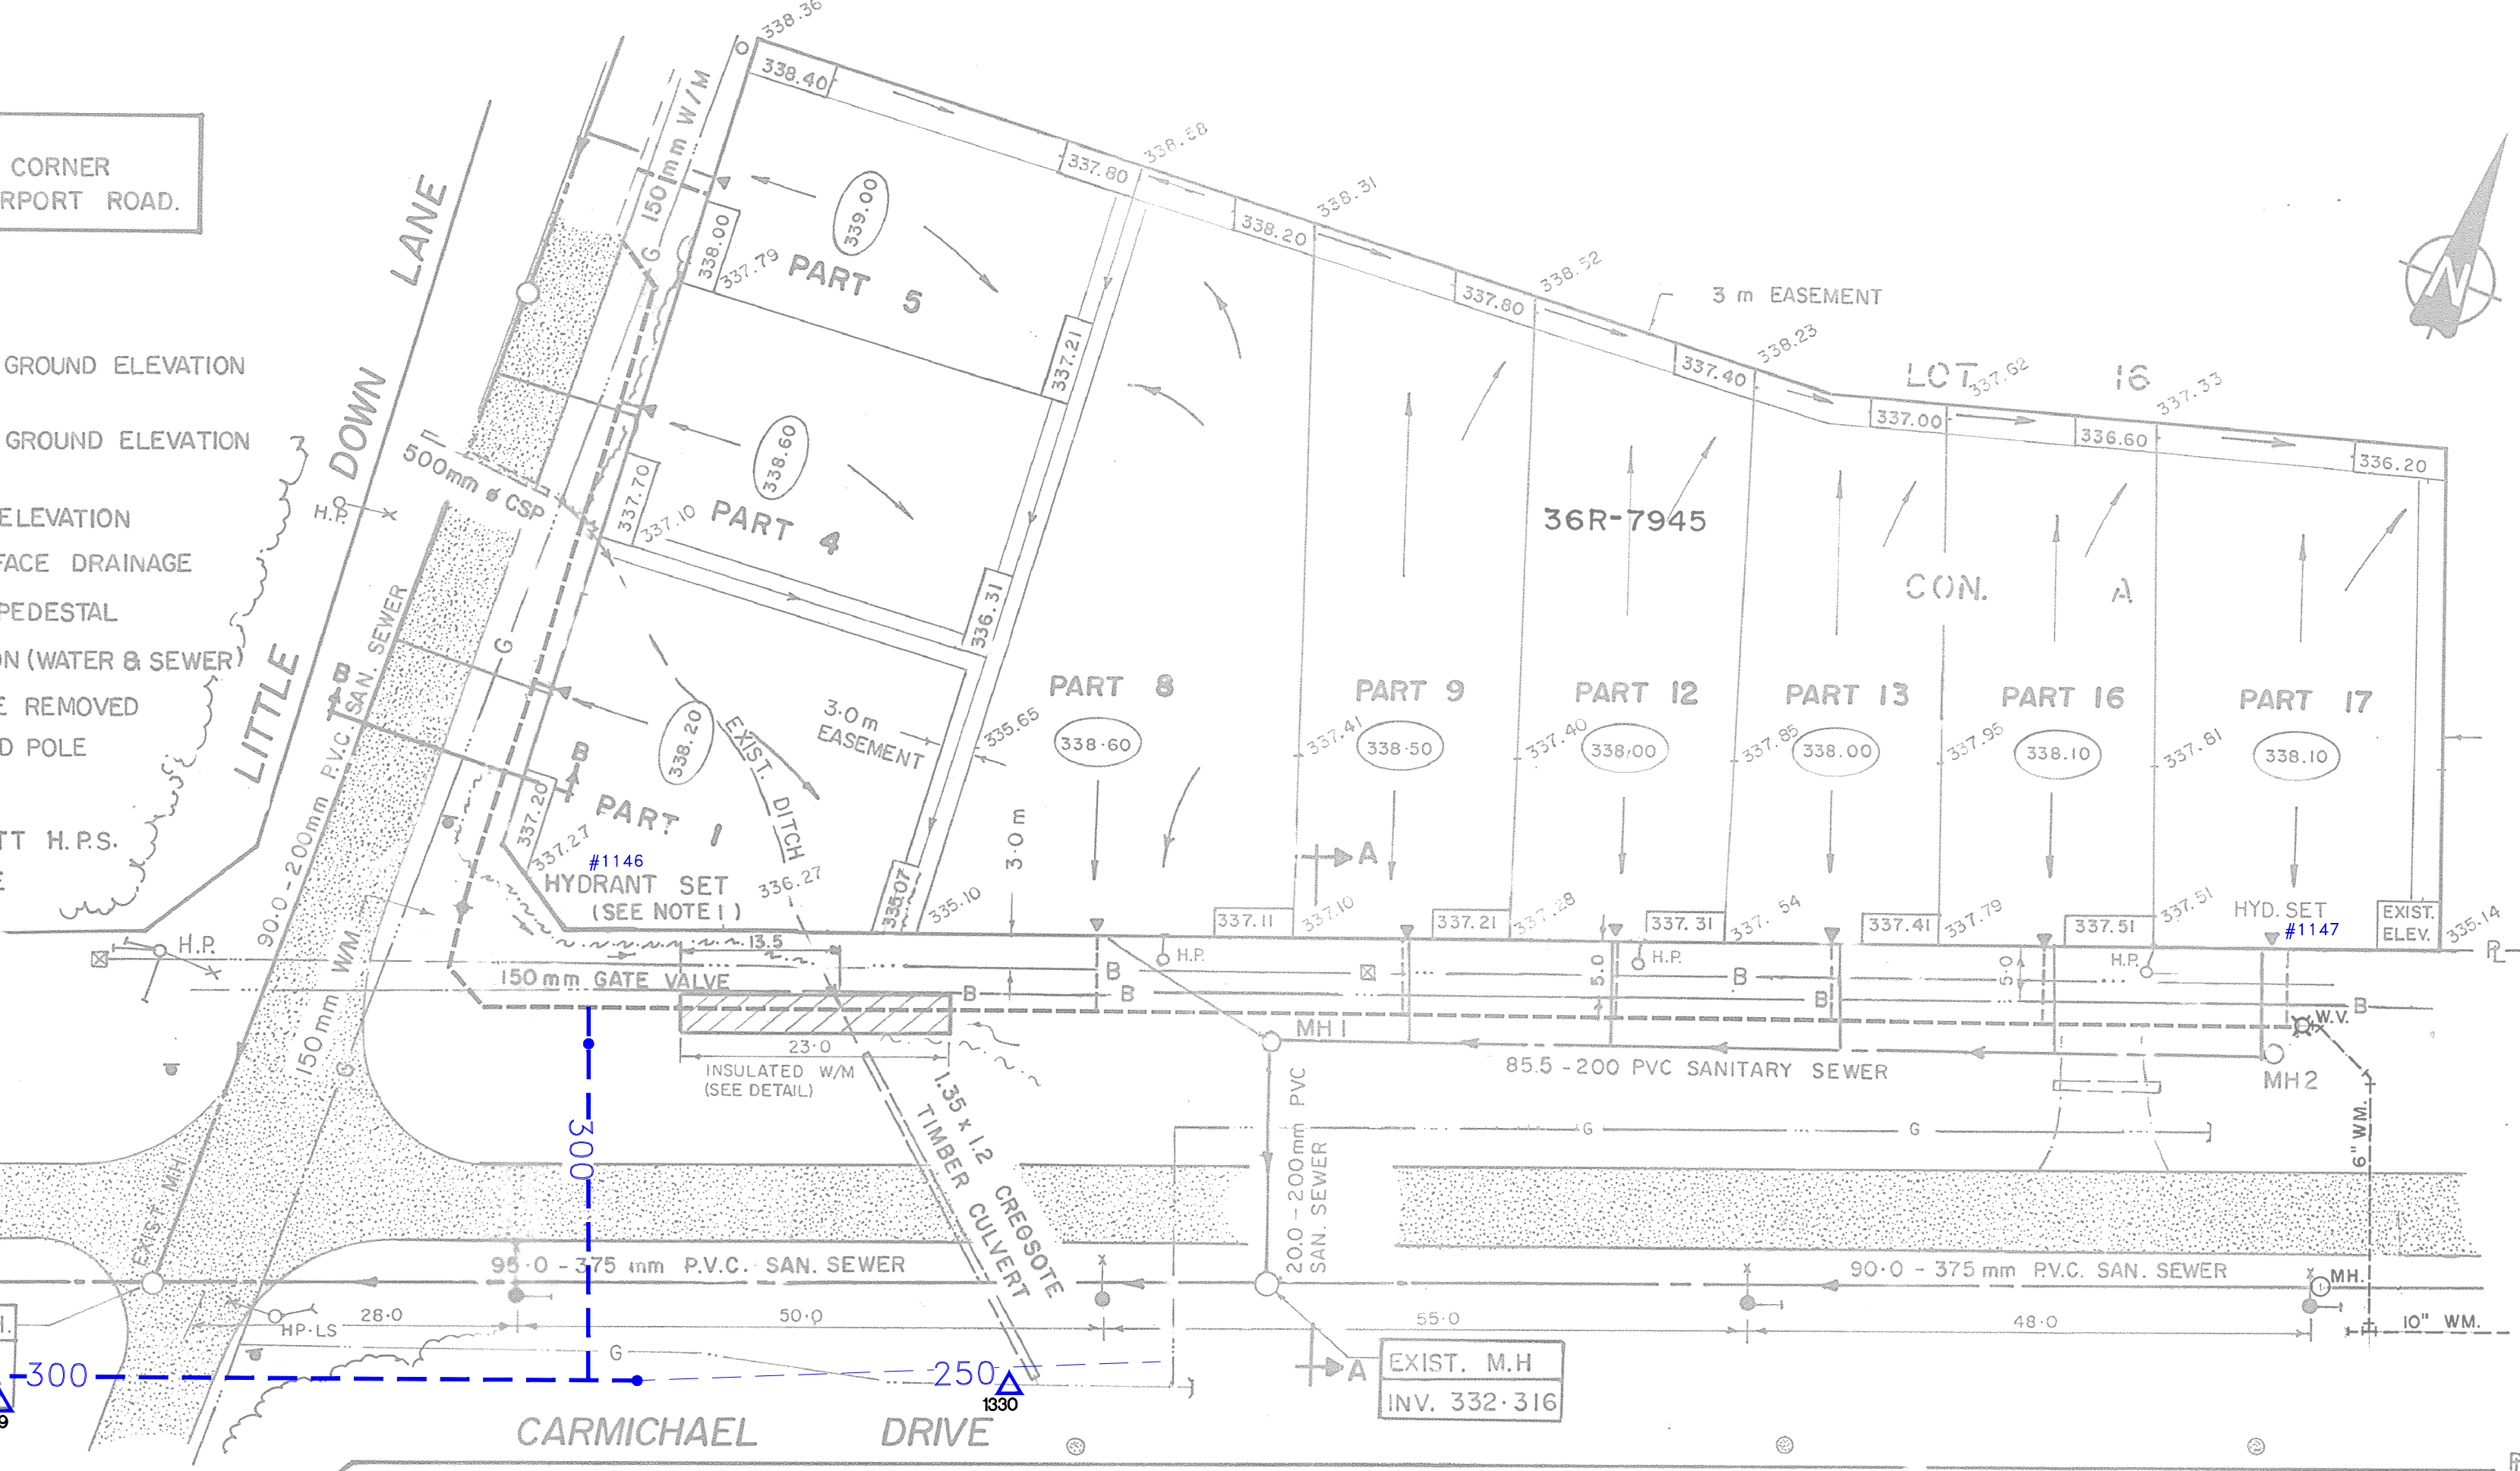

NOTES:
1. INSTALLATION OF HYDRANTS TO BE DEFERRED AS PER CONDITION 1 OF M.O.E. CERTIFICATE N° 7-1922-88-906. SECONDARY VALVE AND HYDRANT TEE TO BE INSTALLED AS PART OF THIS CONTRACT.

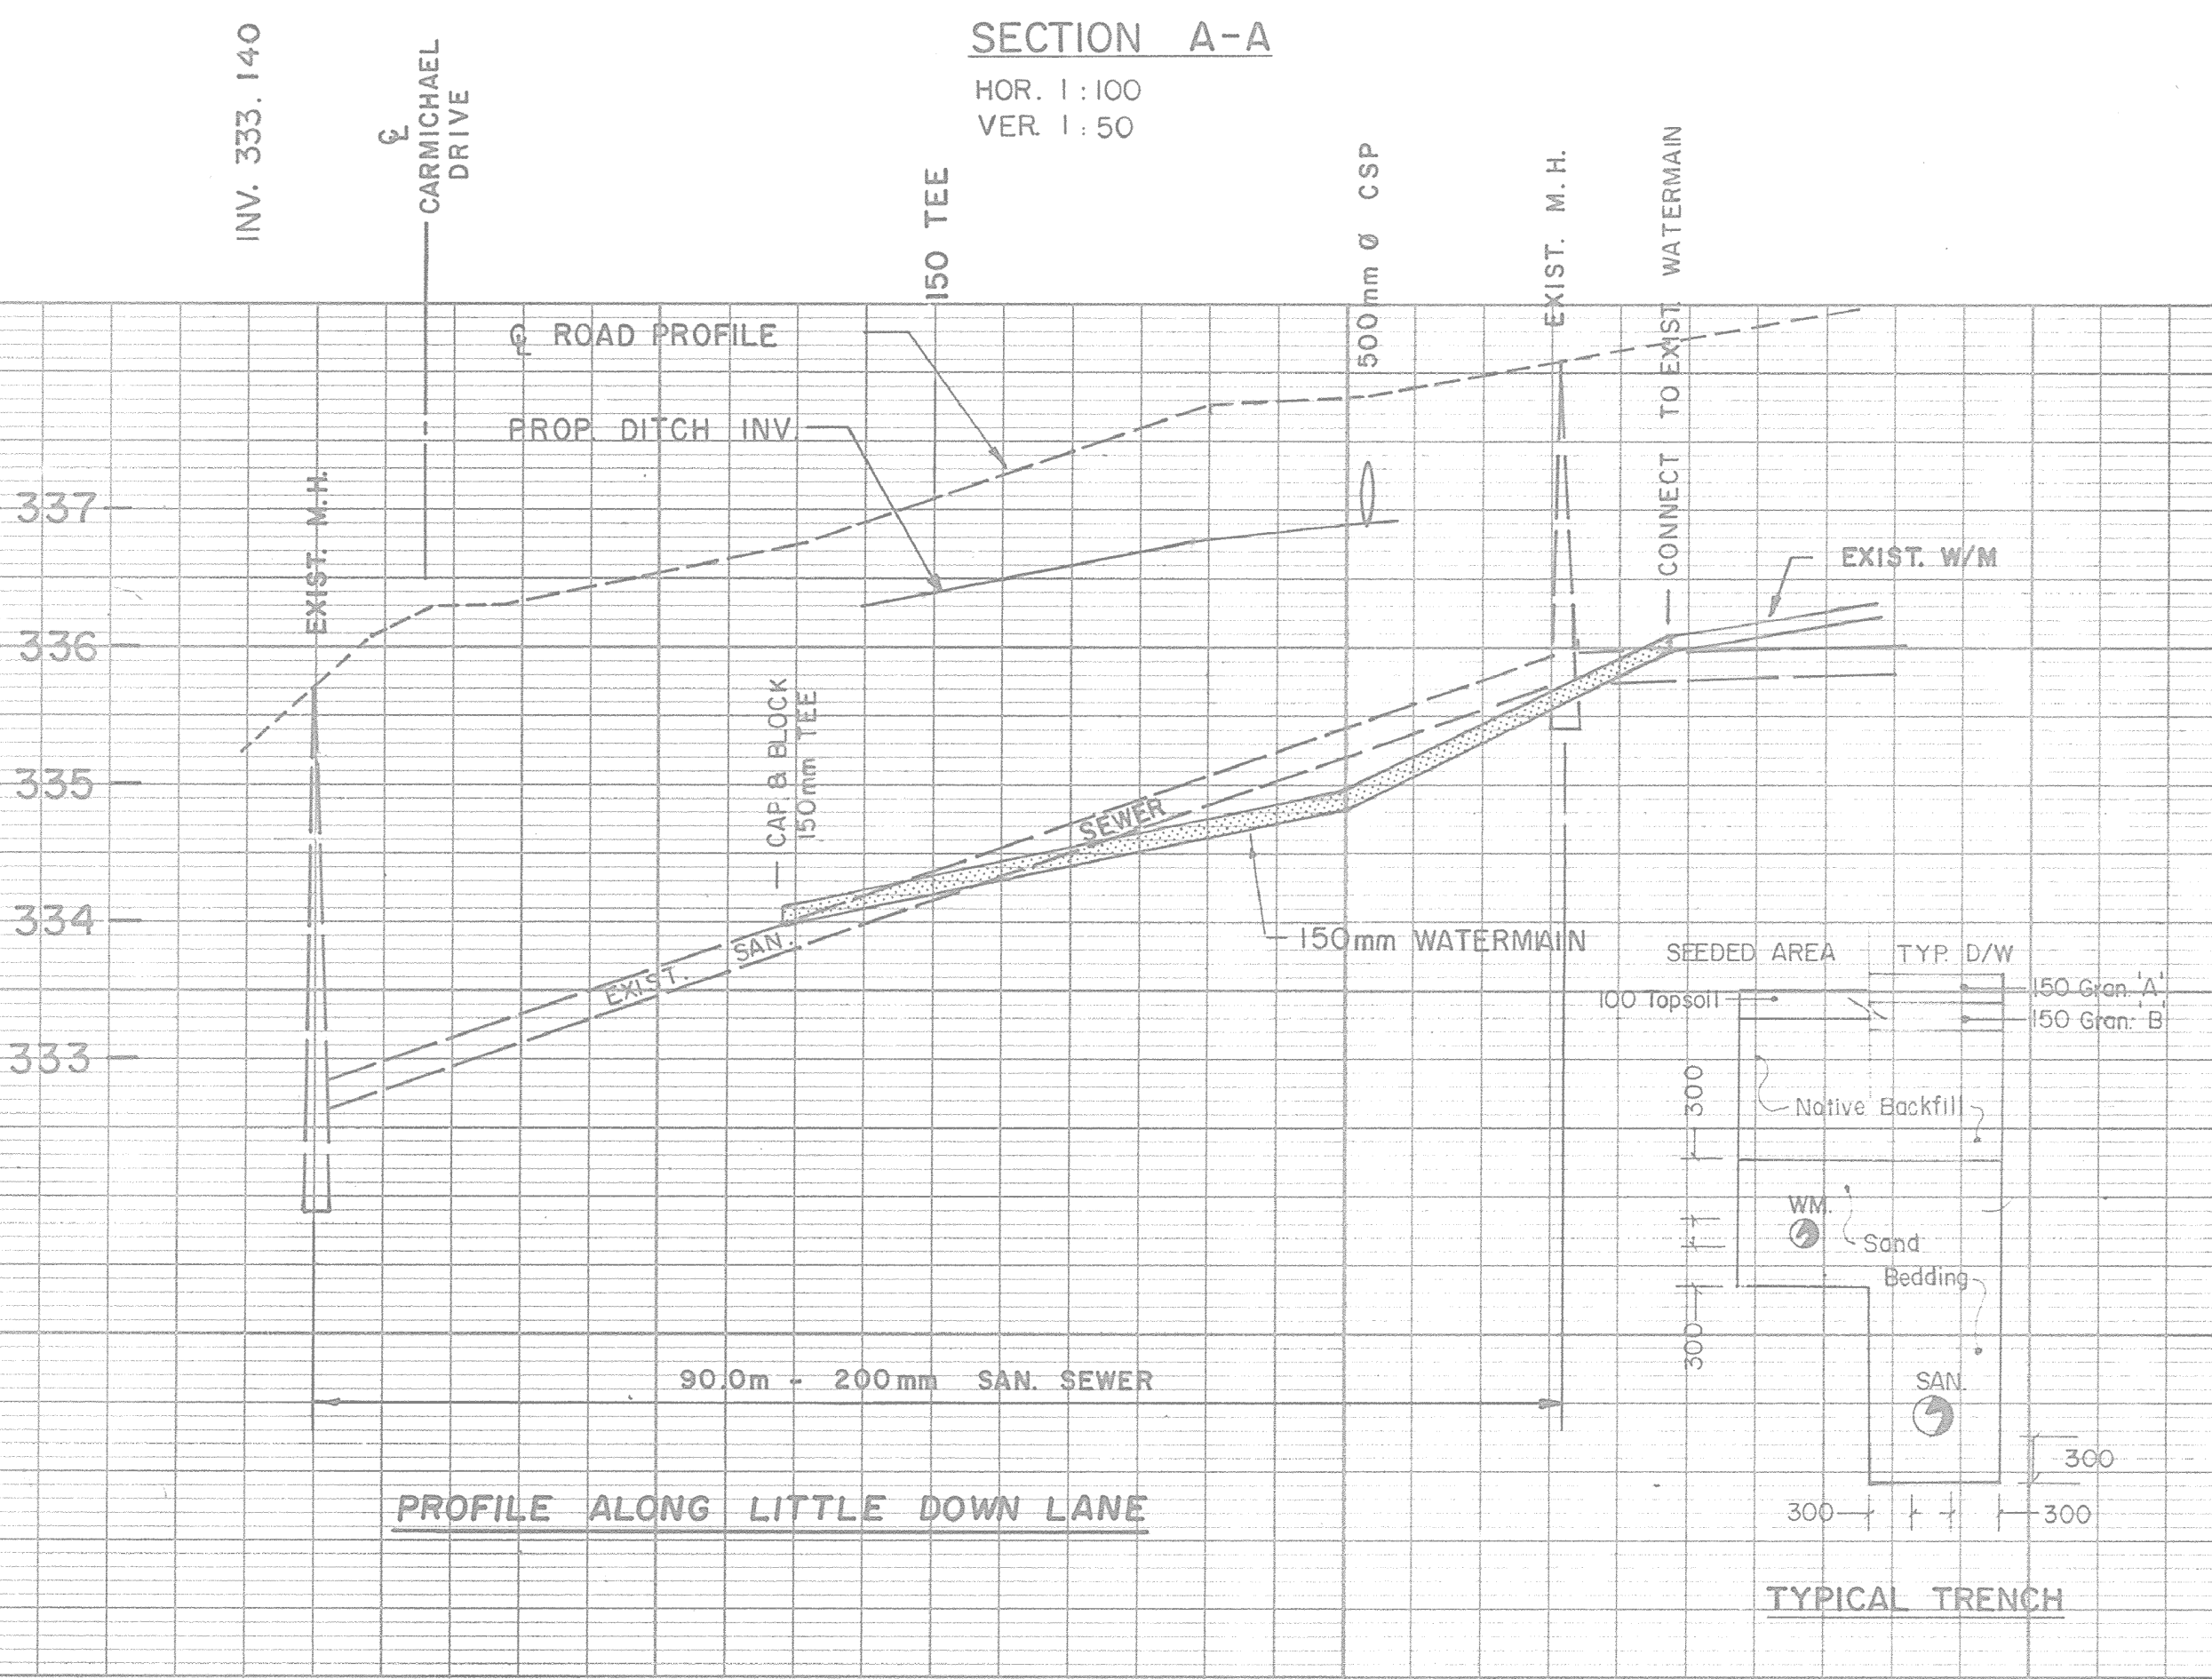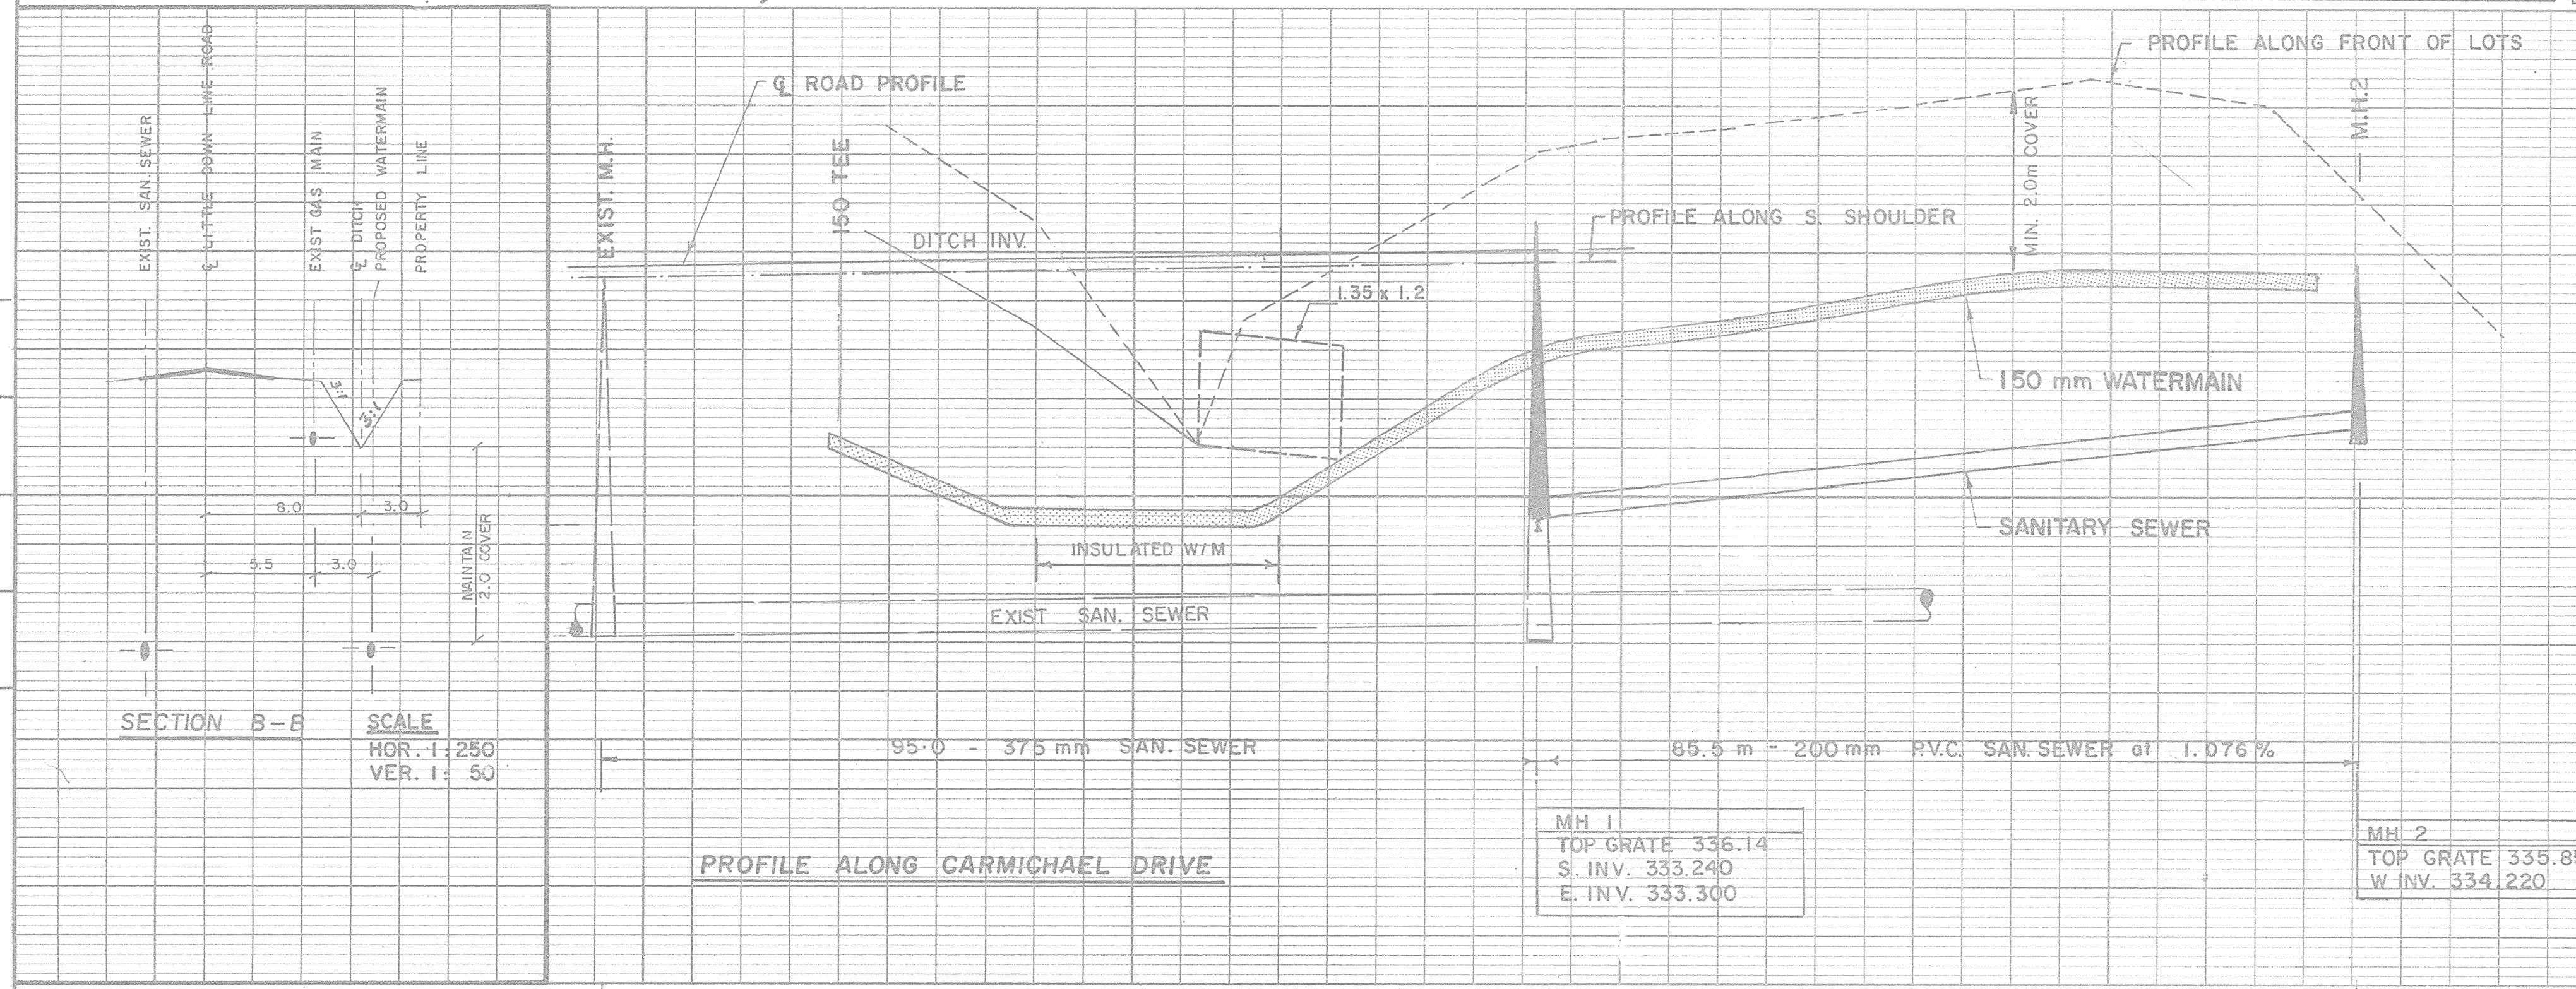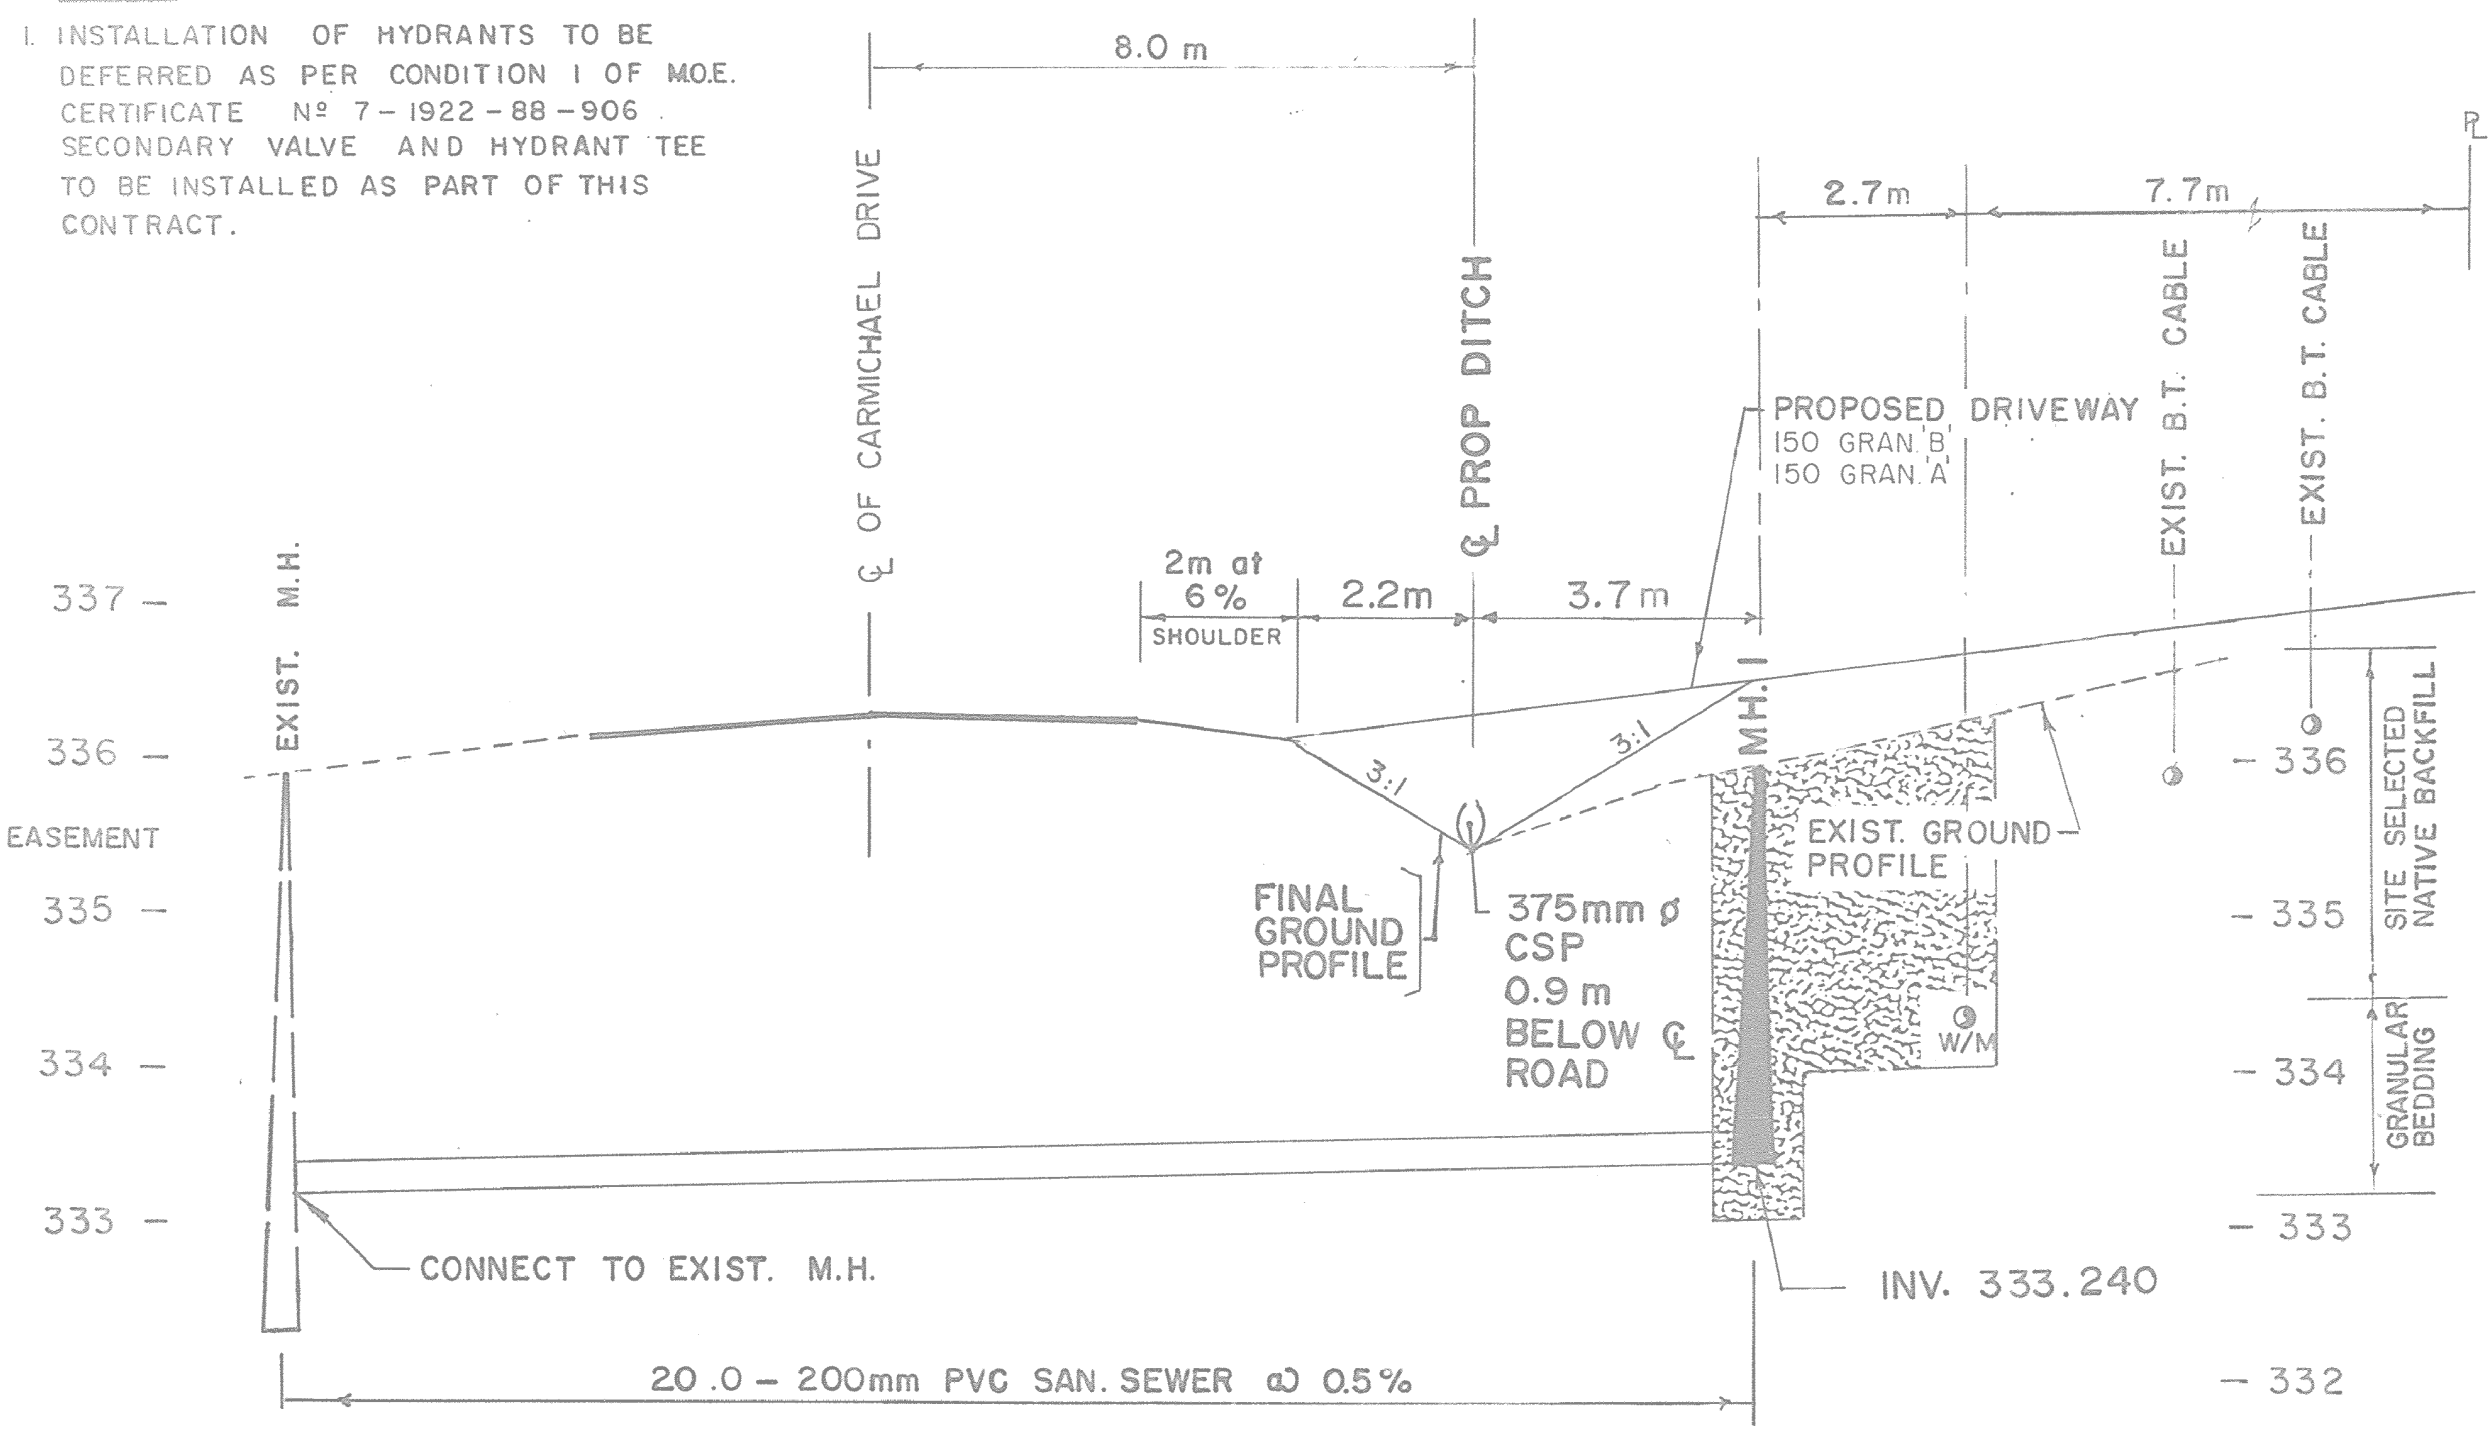

Ground

Invert

Chainage

Notes:

DISCLAIMER

The information contained on this drawing may be based upon data provided by others and may not have been verified by either as-constructed drawings or an Ontario Land Surveyor. The City of North Bay cannot accept responsibility for any errors or omissions on any information shown herein. Field verification, land surveys or excavation (with City approvals) may be required to determine actual location of any and all utilities or property lines.

No.	Revision	Date	Initial
5.	AS CONSTRUCTED	JULY '91	DRB
4.	REVISED SAN. SEWER ALIGNMENT	MAY '90	D.R.B.
3.	REVISE WATER DEPTH ON LITTLE DOWN LANE & DIVERT DITCH ALONG EAST SIDE OF LITTLE DOWN LANE	FEB. 90	J.D.R.
2.	ADDED NOTE REGARDING FIRE HYD.	FEB. '90	RMB
1.	REVISED LOT NUMBERS	JAN. 89	D.R.B.

Approved

8/1/9

2008/28

HYDRO PLANT APPROVED

NORTH BAY HYDRO

DATE 88-11-07

GAS PLANT APPROVED

INTER CITY GAS (I.C.G.)

BELL PLANT APPROVED

BELL TELEPHONE CO.

CITY OF NORTH BAY

JACK NORMAN SUBDIVISION

Proctor & Redfern Limited

Consulting Engineers & Architect

Toronto

North Bay

Scale

HOR. 1:500

VER. 1:50

Drawn by D.R.B.

Ckd. by D.J.F.

Date JUNE, 1988

Dwg. No. C-354 'A'

Rev. 5