



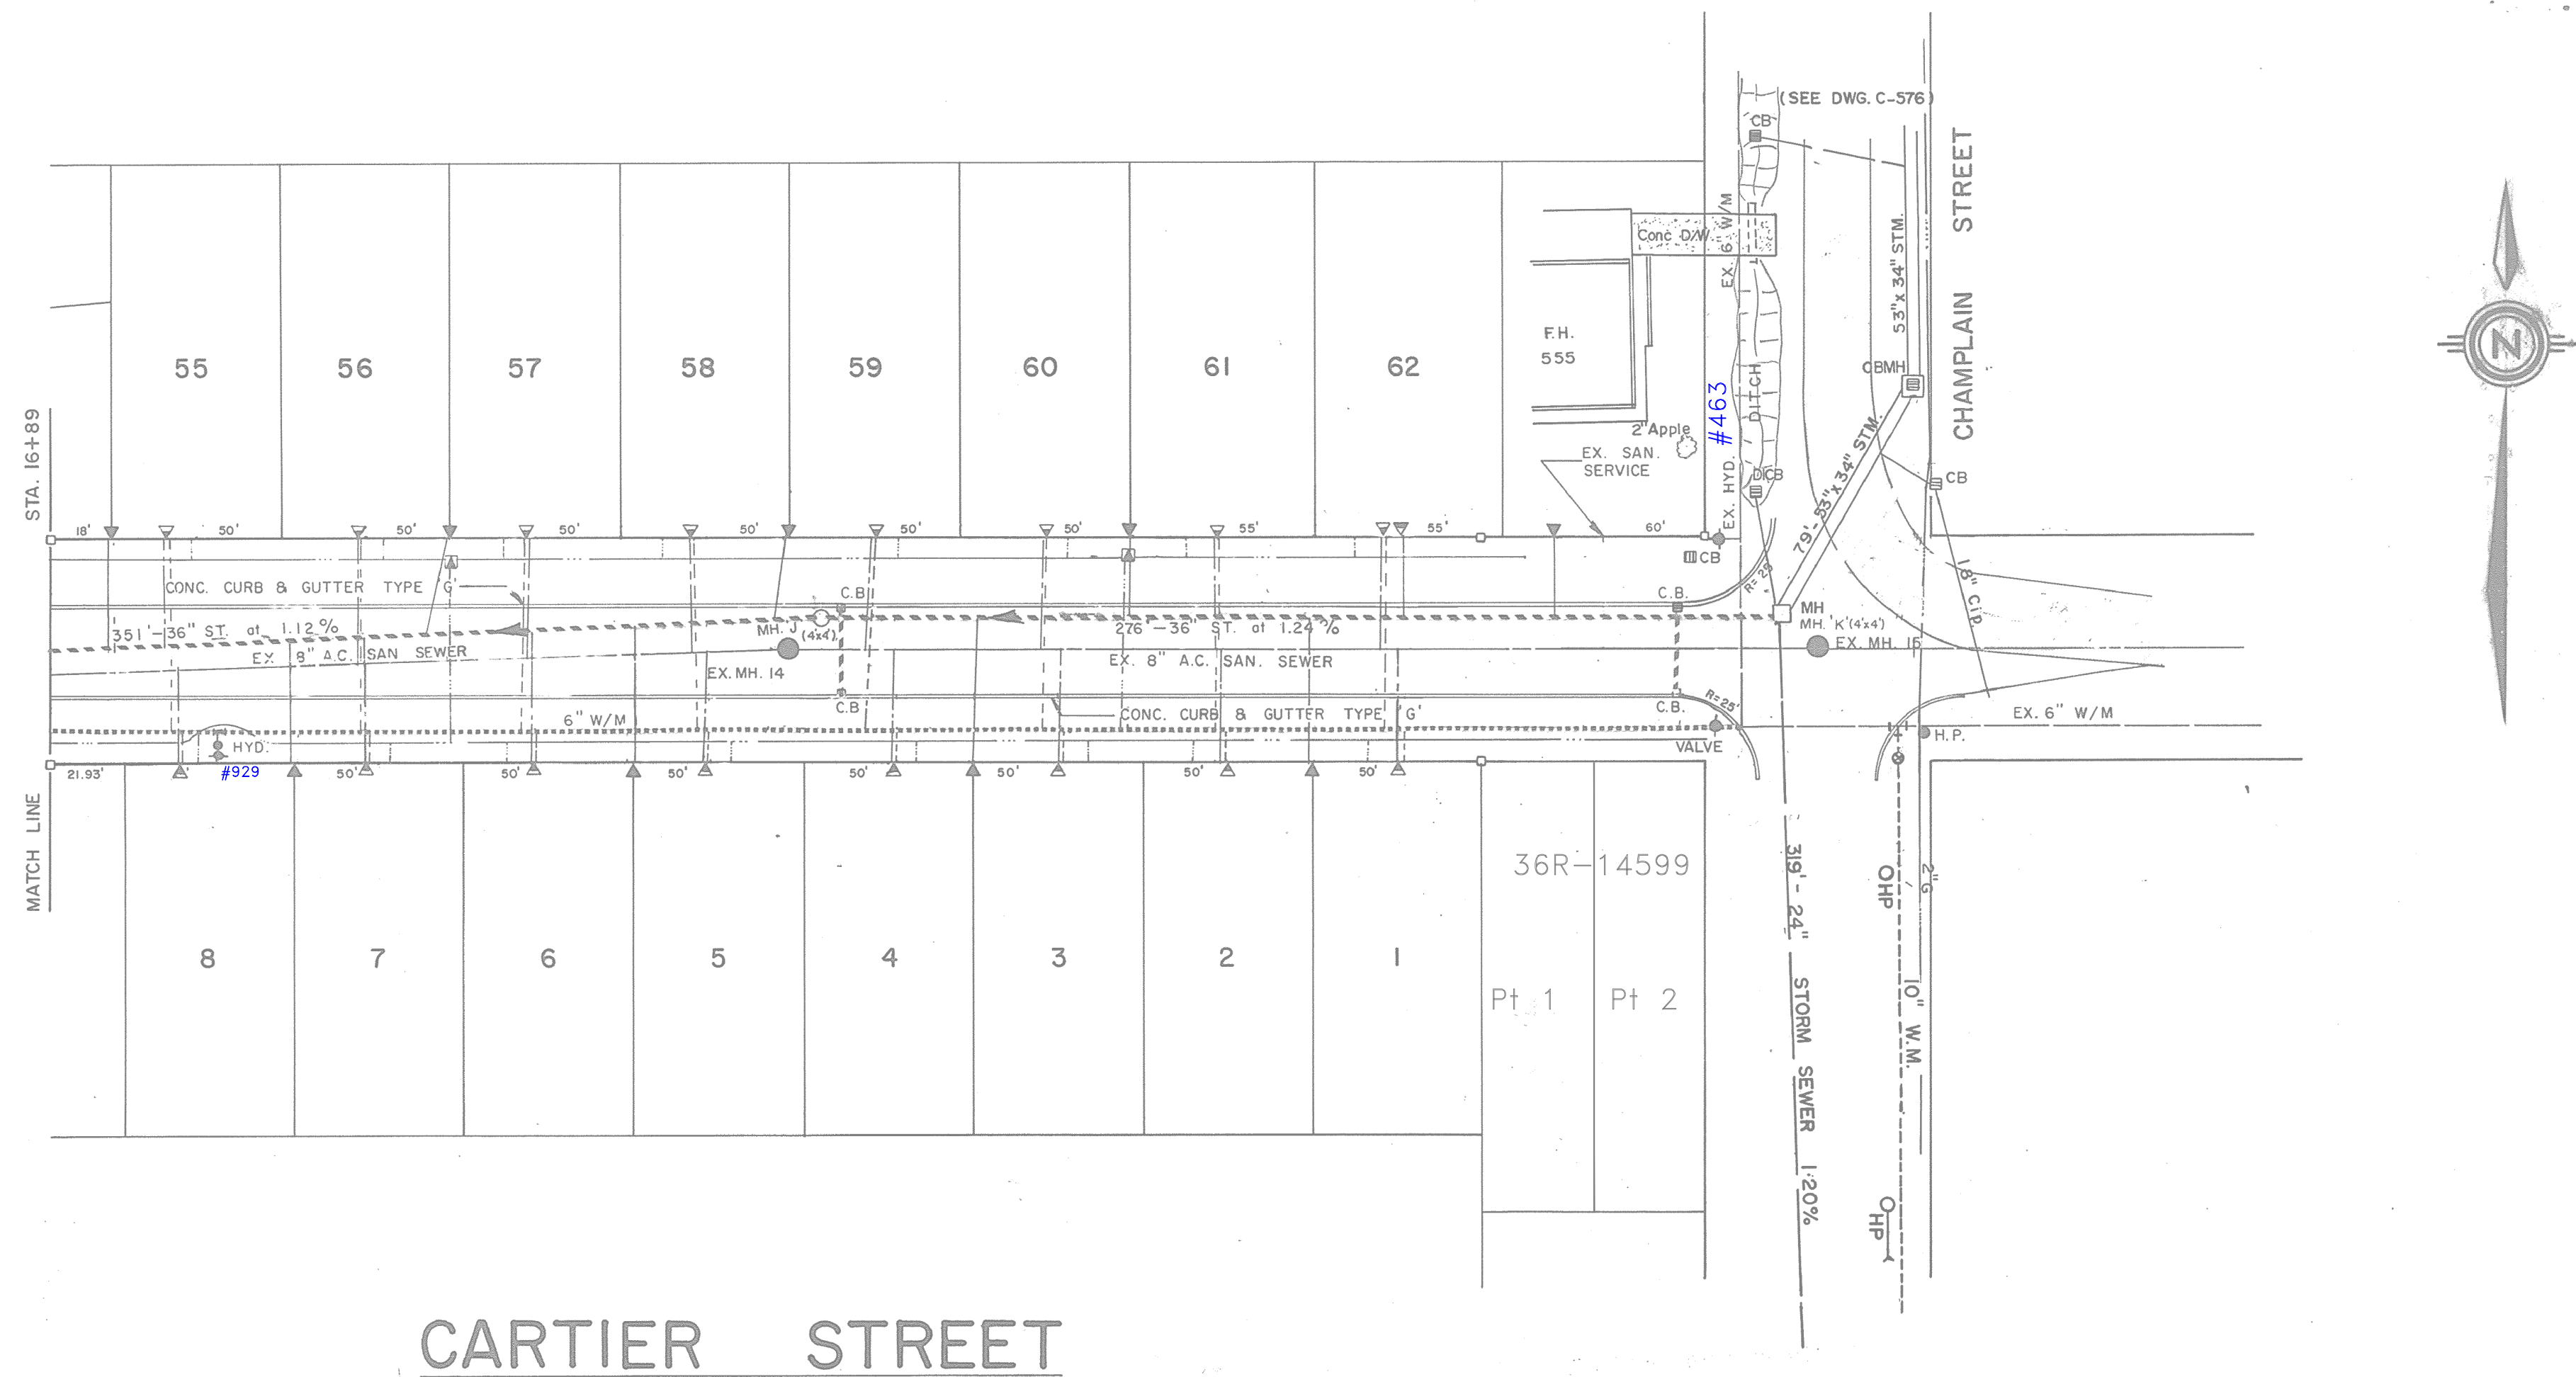

CARTIER STREET

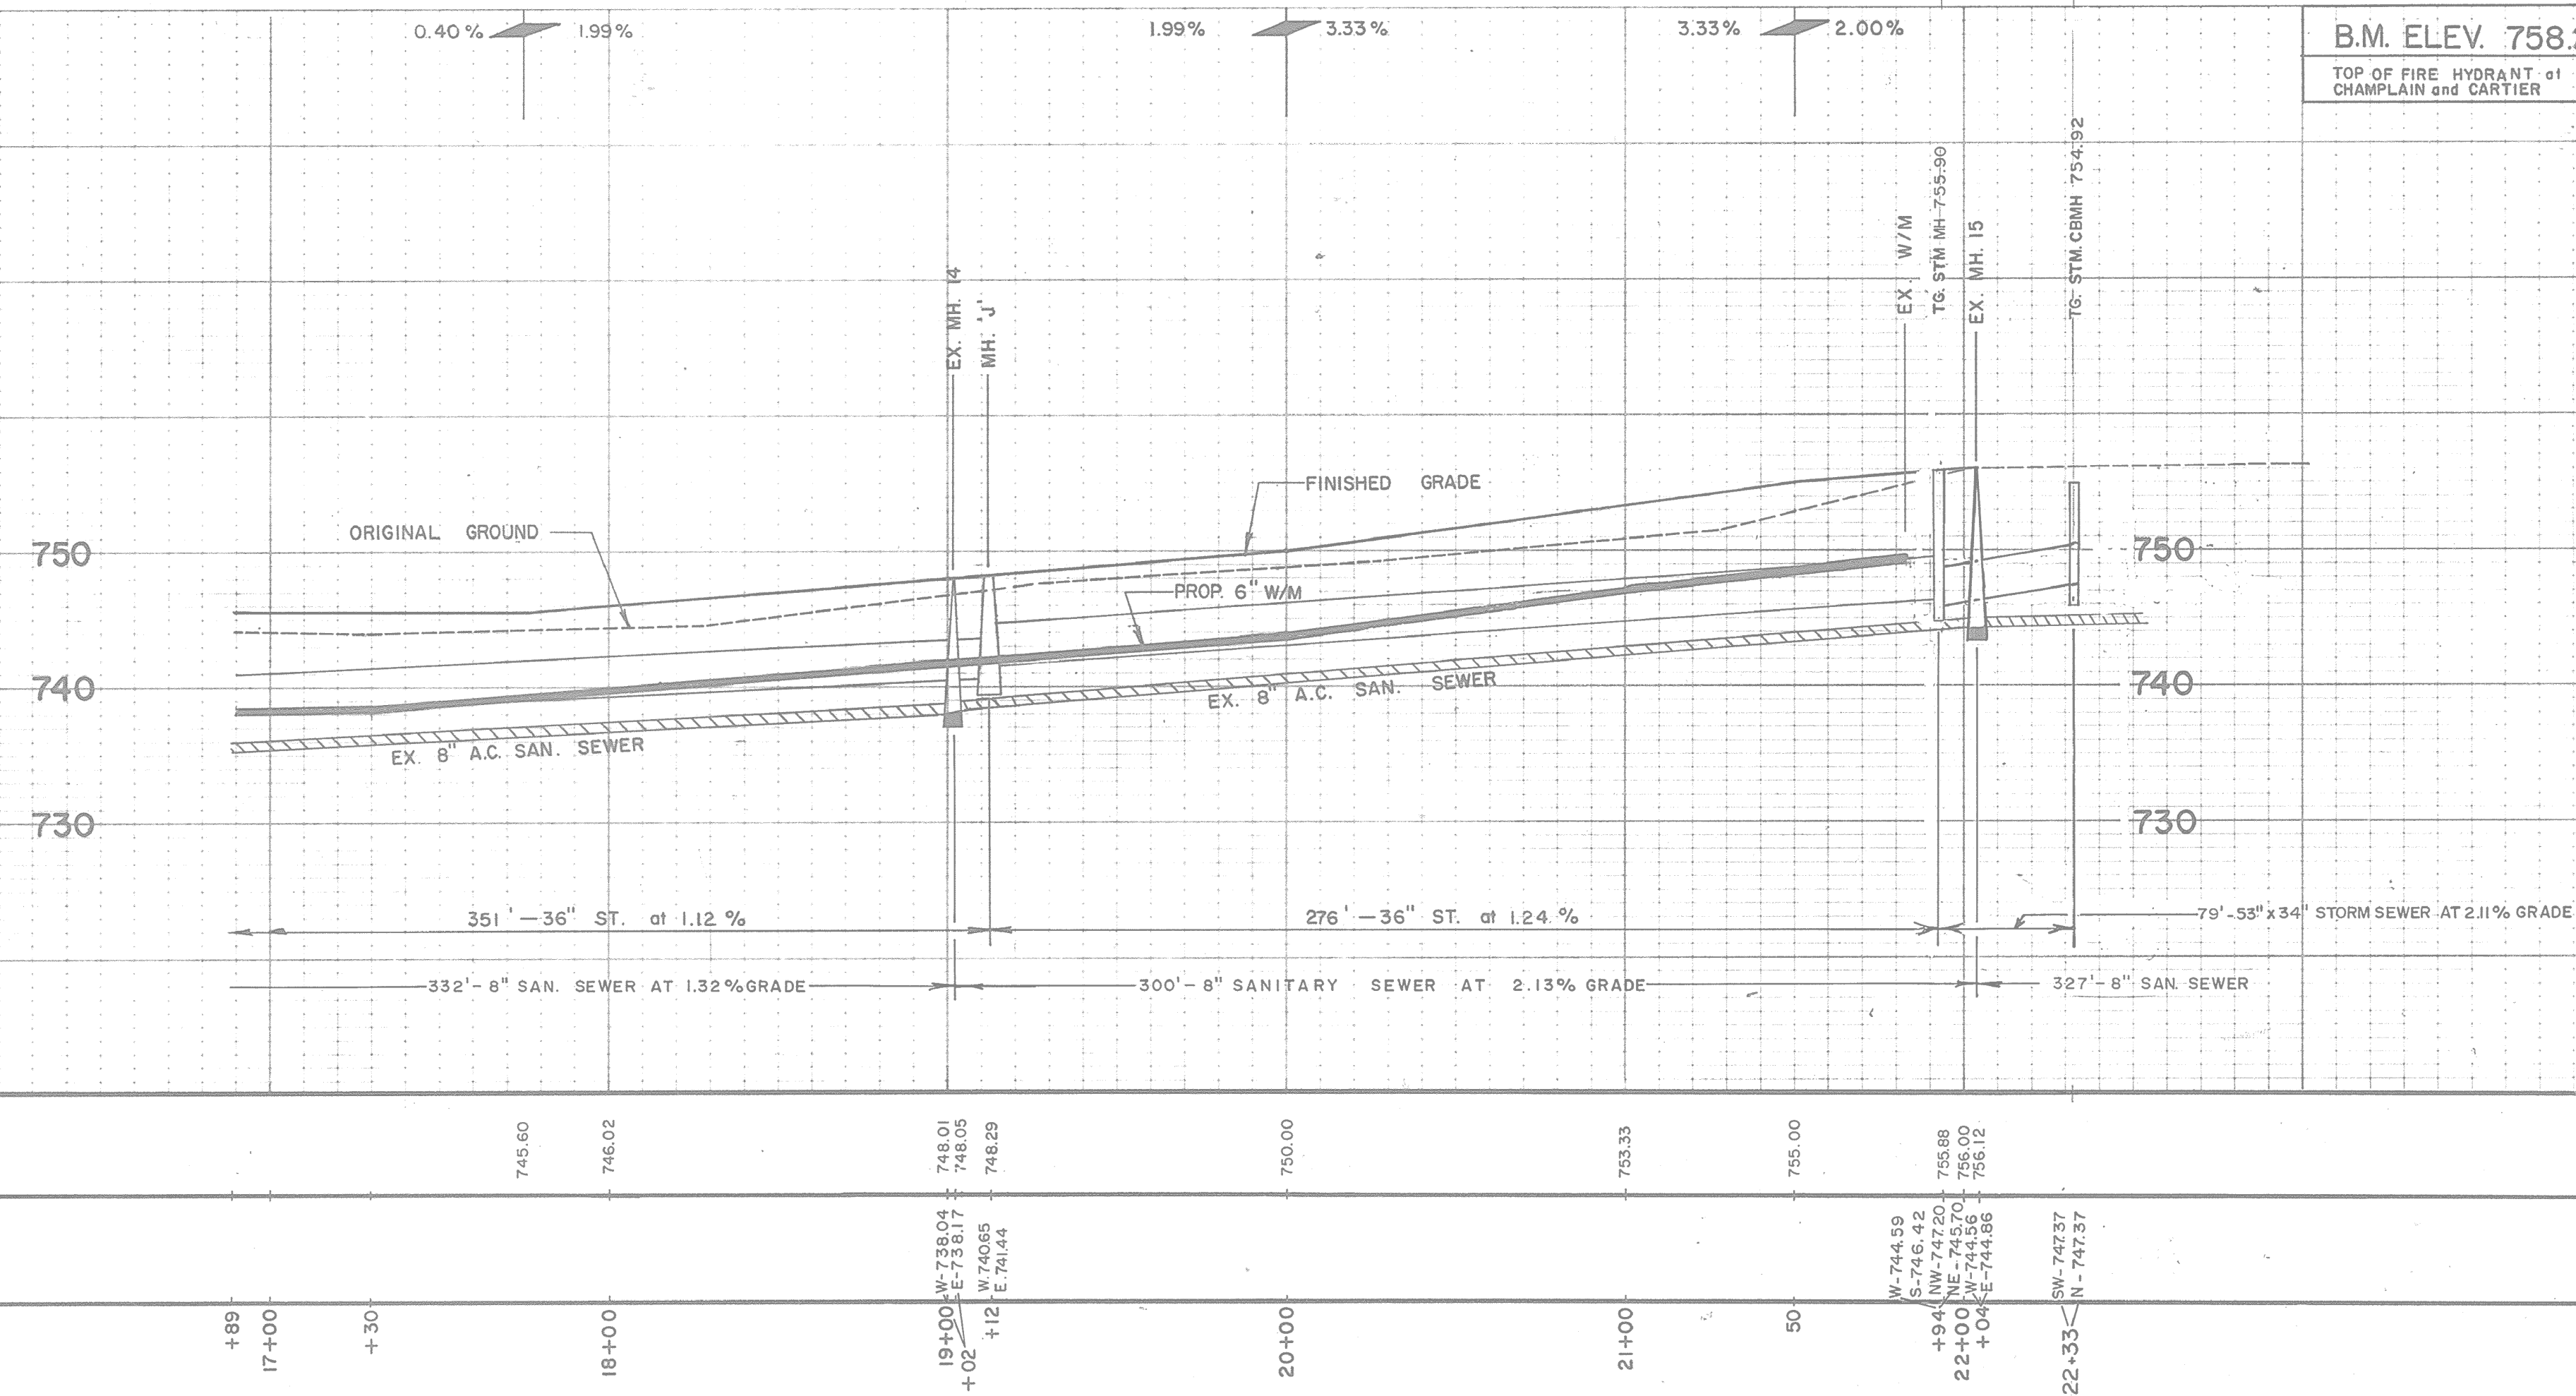

- Notes: 1. CONCRETE PIPE 21" DIA. AND OVER TO BE REINFORCED CLASS '3'
2. CONCRETE PIPE 18" DIA. AND UNDER TO BE NON-REINFORCED EXTRA STRENGTH



DISCLAIMER

The information contained on this drawing may be based upon data provided by others and may not have been verified by either as-constructed drawings or an Ontario Land Surveyor. The City of North Bay cannot accept responsibility for any errors or omissions on any information shown herein. Field verification, land surveys or excavation (with City approvals) may be required to determine actual location of any and all utilities or property lines.

No.	Revision	Date	Initial
2.	AS CONST'D. SAN. SEWER DEC.70 BK. 206	AUG. 81	R.F.B.
1.	AS CONSTRUCTED (Per A.A. underground)	JAN. 74	DM


Approved



CITY OF NORTH BAY

CARTIER STREET

URSULA STREET TO CHAMPLAIN STREET

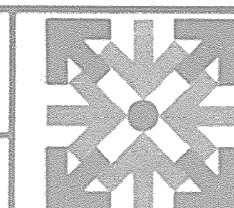

Proctor & Redfern Limited
Consulting Engineers

C-378

Toronto

North Bay

Scale Hor 1"=40'
Vert 1"=10'

Date: DEC/1971

Drawn By G.A.B.
Ckd. By R.S.

Field Book

Drawing No.

B-70324-P3

Rev.