

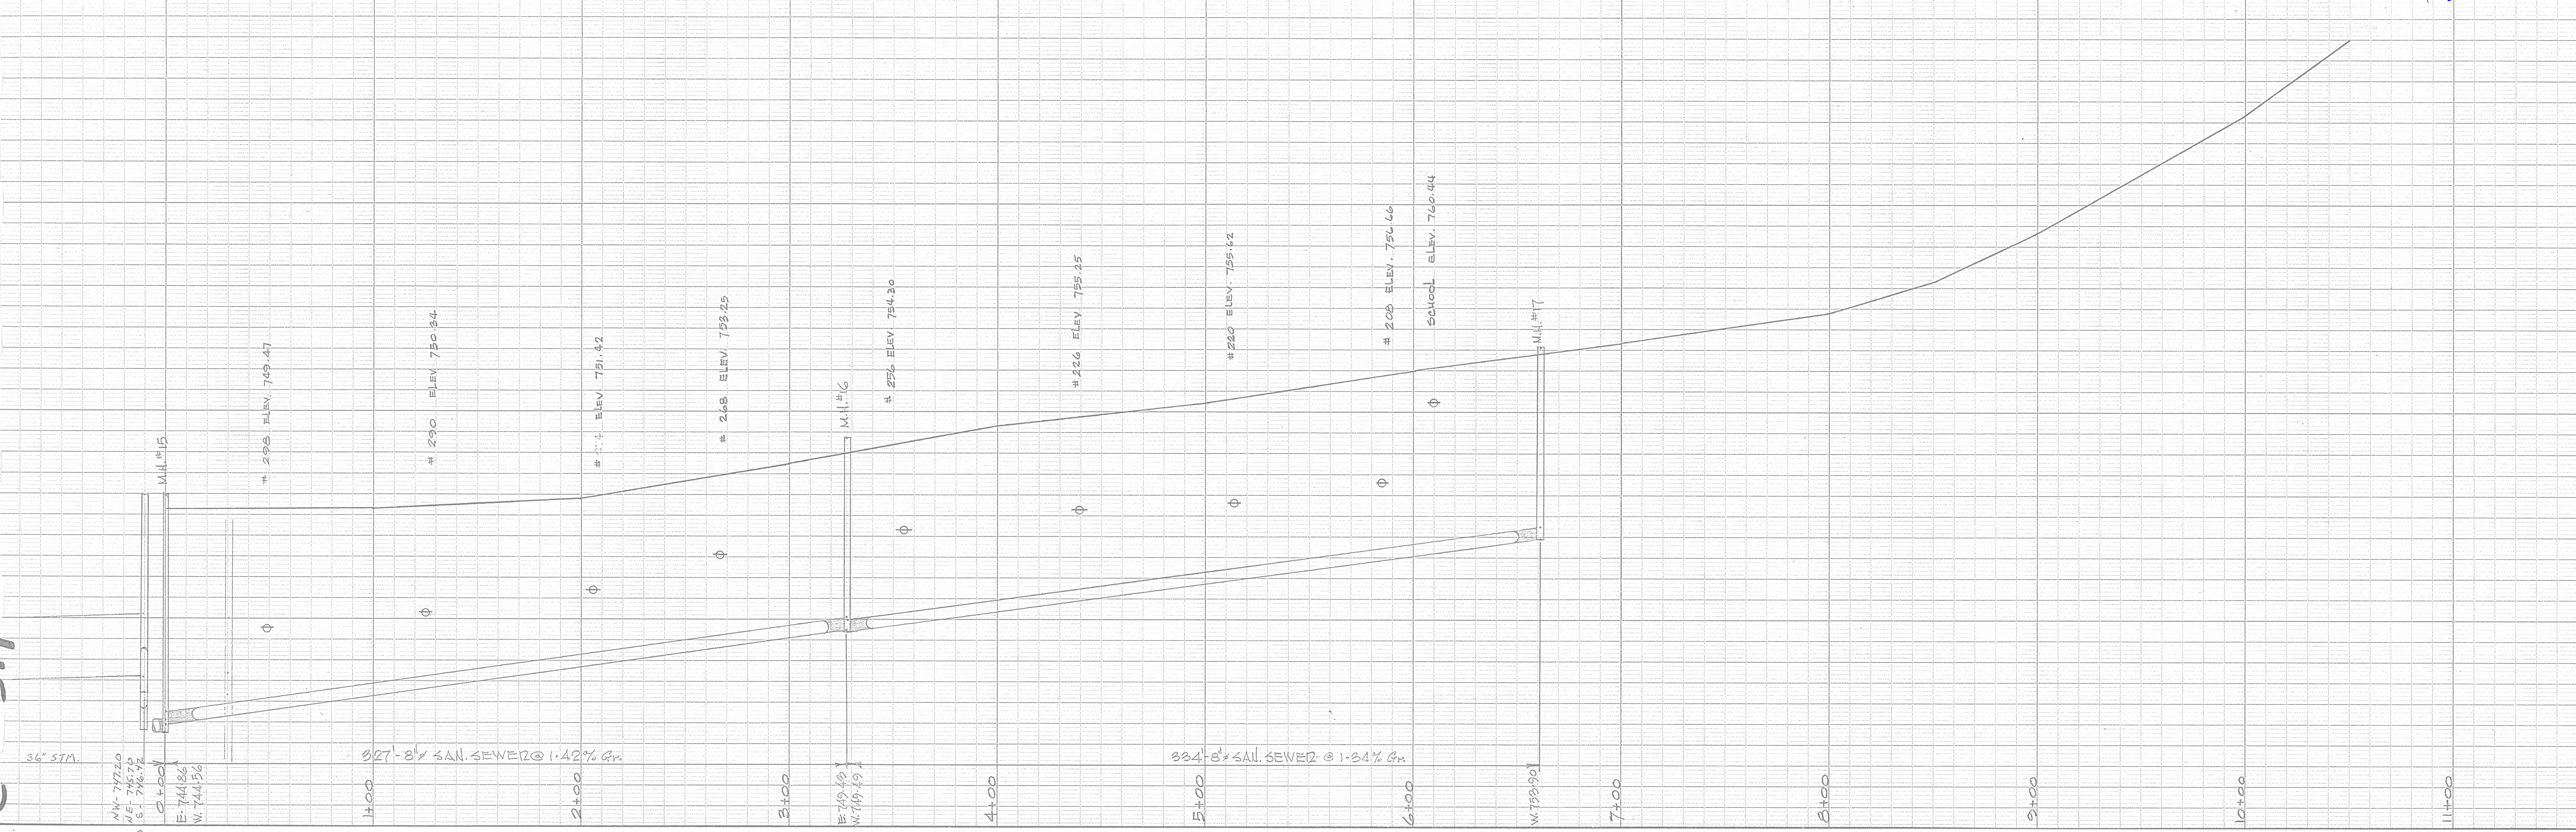
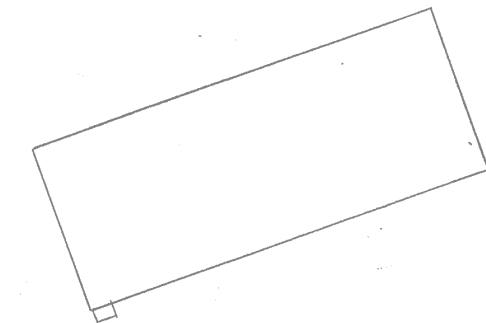
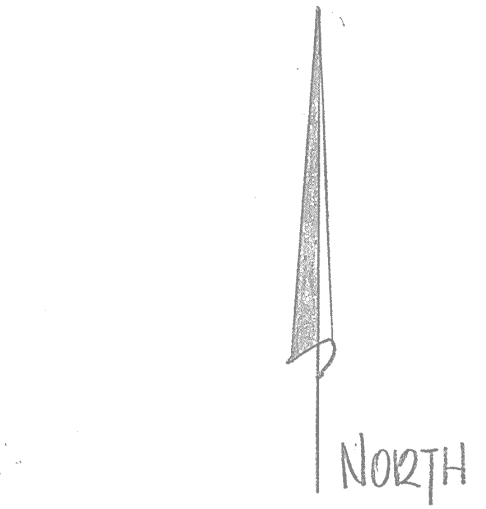


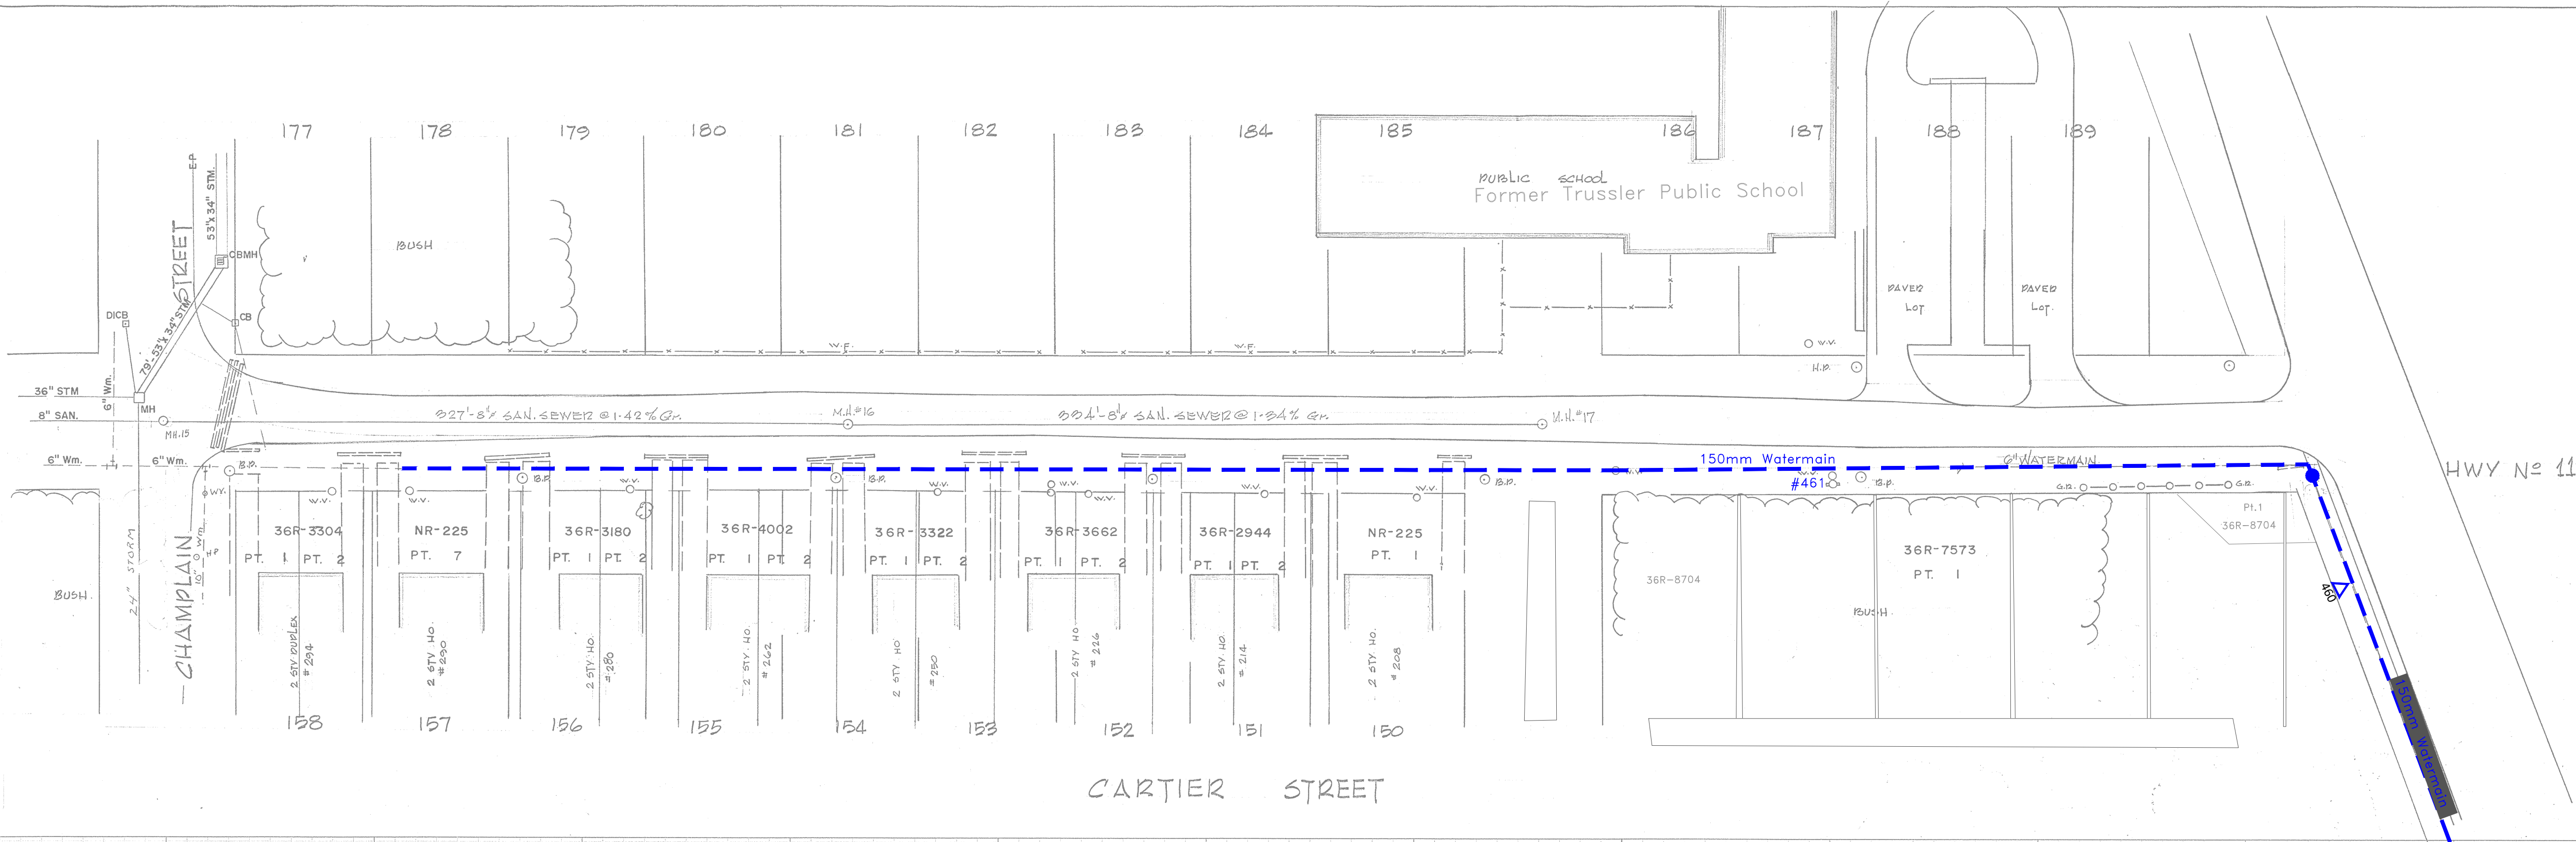

SCALE
VERT - 1" = 4'-0"
HORIZ - 1" = 40'-0"

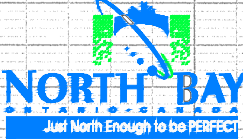

DISCLAIMER
The information contained on this drawing may be based upon data provided by others and may not have been verified by either as-constructed drawings or an Ontario Land Surveyor. The City of North Bay cannot accept responsibility for any errors or omissions on any information shown herein. Field verification, land surveys or excavation (with City approvals) may be required to determine actual location of any and all utilities or property lines.

CORPORATION CITY OF NORTH BAY - ONTARIO			
CARTIER STREET			
CHAMPLAIN STREET TO HWY No 11			
BENCH MARK			
DATE	REVISIONS	BY	CHK'D
JAN 11/10	AS CONST. SAN. SEWER	M.V.K.	
DRAWN BY		CHECKED BY	
D. TUNLOP			
DATE	SCALE	BOOK	DWG NO
JULY 8 1968	AS NOTED		C-379

KEUFFEL & ESSER CO.
NEW YORK

THREE STANDARD MARK
REPL. 1/2" X 2" X 2" OFF
PROFILE, PLATE A, 4 X 20
100% AND 100%
MADE IN U.S.A.

KEUFFEL & ESSER CO.
NEW YORK

THREE STANDARD MARK
REPL. 1/2" X 2" X 2" OFF
PROFILE, PLATE A, 4 X 20
100% AND 100%
MADE IN U.S.A.

KEUFFEL & ESSER CO.
NEW YORK

THREE STANDARD MARK
REPL. 1/2" X 2" X 2" OFF
PROFILE, PLATE A, 4 X 20
100% AND 100%
MADE IN U.S.A.