
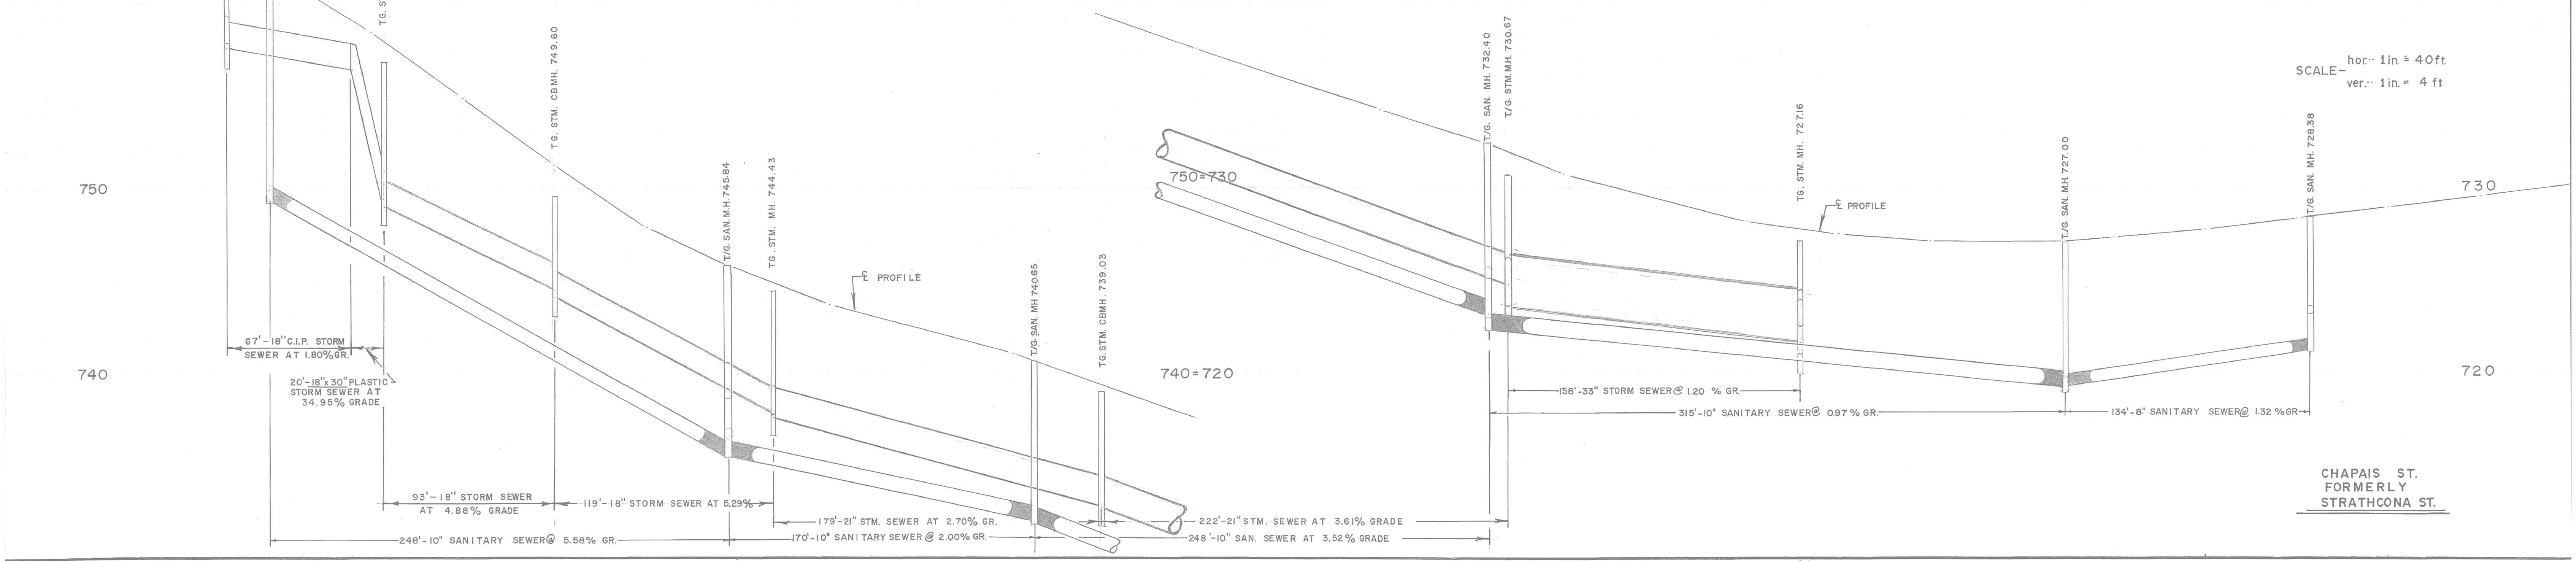


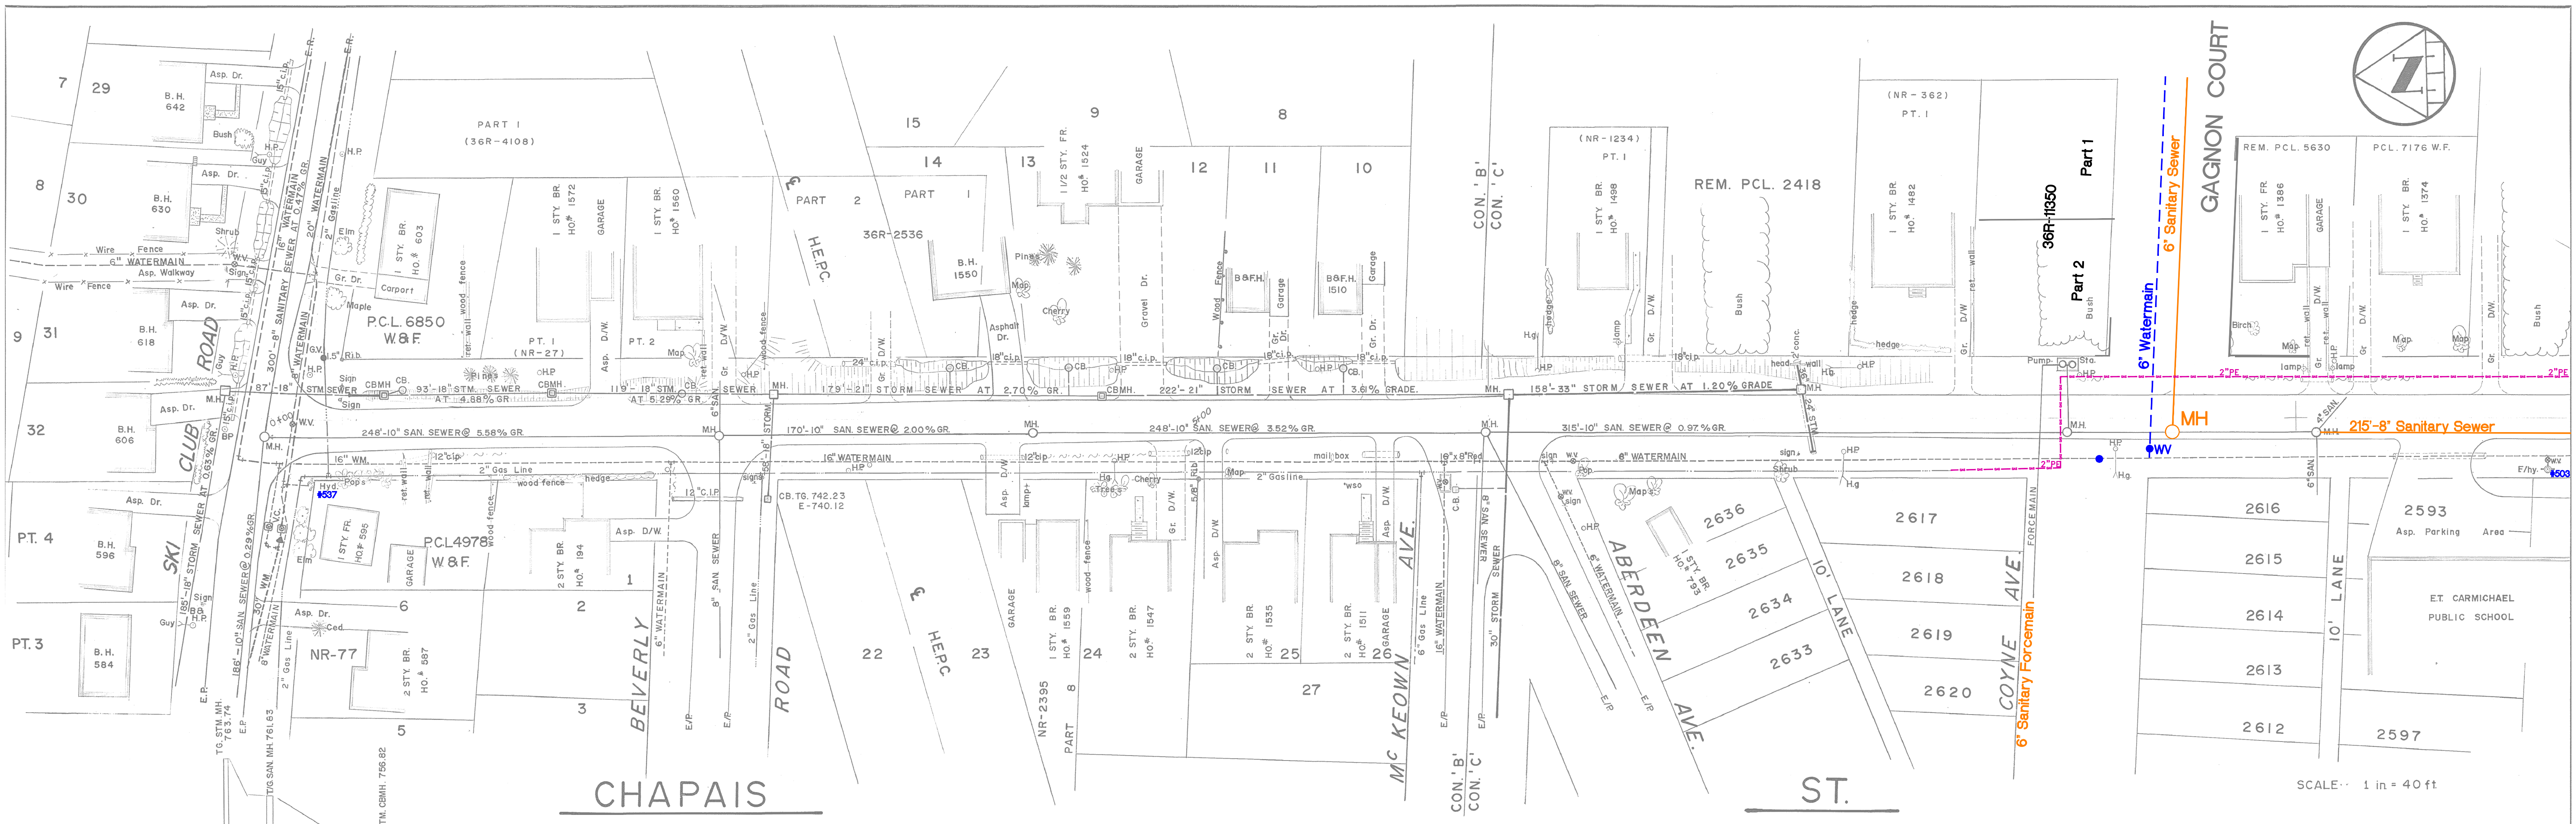

CHAINAGE	GROUND EL	INVERT
0+30	757.95	W-757.95
0+37	758.14	N-758.14
0+40	758.20	E-758.20
0+42	758.26	S-758.26
0+45	758.36	Plugged
0+50	758.43	N-758.43
0+57	758.51	S-758.51
1+00	754.84	
1+50	751.26	N-751.26
2+00	747.90	
2+42	743.74	N-743.74
2+69	743.74	N-743.74
3+00	743.74	
4+00	741.09	N-741.09
4+11	741.09	S-741.09
4+48	737.79	N-737.79
5+00	737.57	
6+00	734.24	
6+59	730.72	N-730.72
6+70	728.15	S-728.15
7+00	727.06	
8+00	727.06	
8+29	727.06	N-727.06
8+50	727.22	S-727.22
9+00	727.22	
9+74	728.33	N-728.33
10+00	728.33	S-728.33
10+50	728.92	
11+00	729.46	N-729.46
11+08	729.46	S-729.46
11+50	729.46	
12+00	729.46	
CHAINAGE	GROUND EL	INVERT

NOTES:

DISCLAIMER

The information contained on this drawing may be based upon data provided by others and may not have been verified by either as-constructed drawings or an Ontario Land Surveyor. The City of North Bay cannot accept responsibility for any errors or omissions on any information shown herein. Field verification, land surveys or excavation (with City approvals) may be required to determine actual location of any and all utilities or property lines.

1.	NEW DRAWING	25/9/73	G.W.R.
2.	REVISED PROPERTY LINES.	JUNE/84.	A.P.
3.	REVISE HOUSE DETAIL- EAST SIDE OF CHAPAIS	FEB. 85	J.S.
4.	REVISE SKI CLUB RD. INTERSECTION (From S-403)	FEB. 85	J.S.
5.	As Const'd. Stm. Sewer SKI CLUB - McKEOWN	AUG. 85	Rick B.
6.	San./Water/R-plans Added	Aug 07	r.j.o.
No.	REVISION	DATE	INITIAL

CHAPAIS STREET	
SKI CLUB RD. TO COYNE AVENUE	
REG.D. PLAN N° M-360, M-531.	
M-177	
NR-177	
NR-27	

CITY OF NORTH BAY	
ENGINEERING DEPARTMENT	
SCALE: AS SHOWN	DATE: SEPT. 1973
DRAWN BY: CK'D. BY:	FIELD BOOK No. 229
DRAWING No. C-401	REV.