



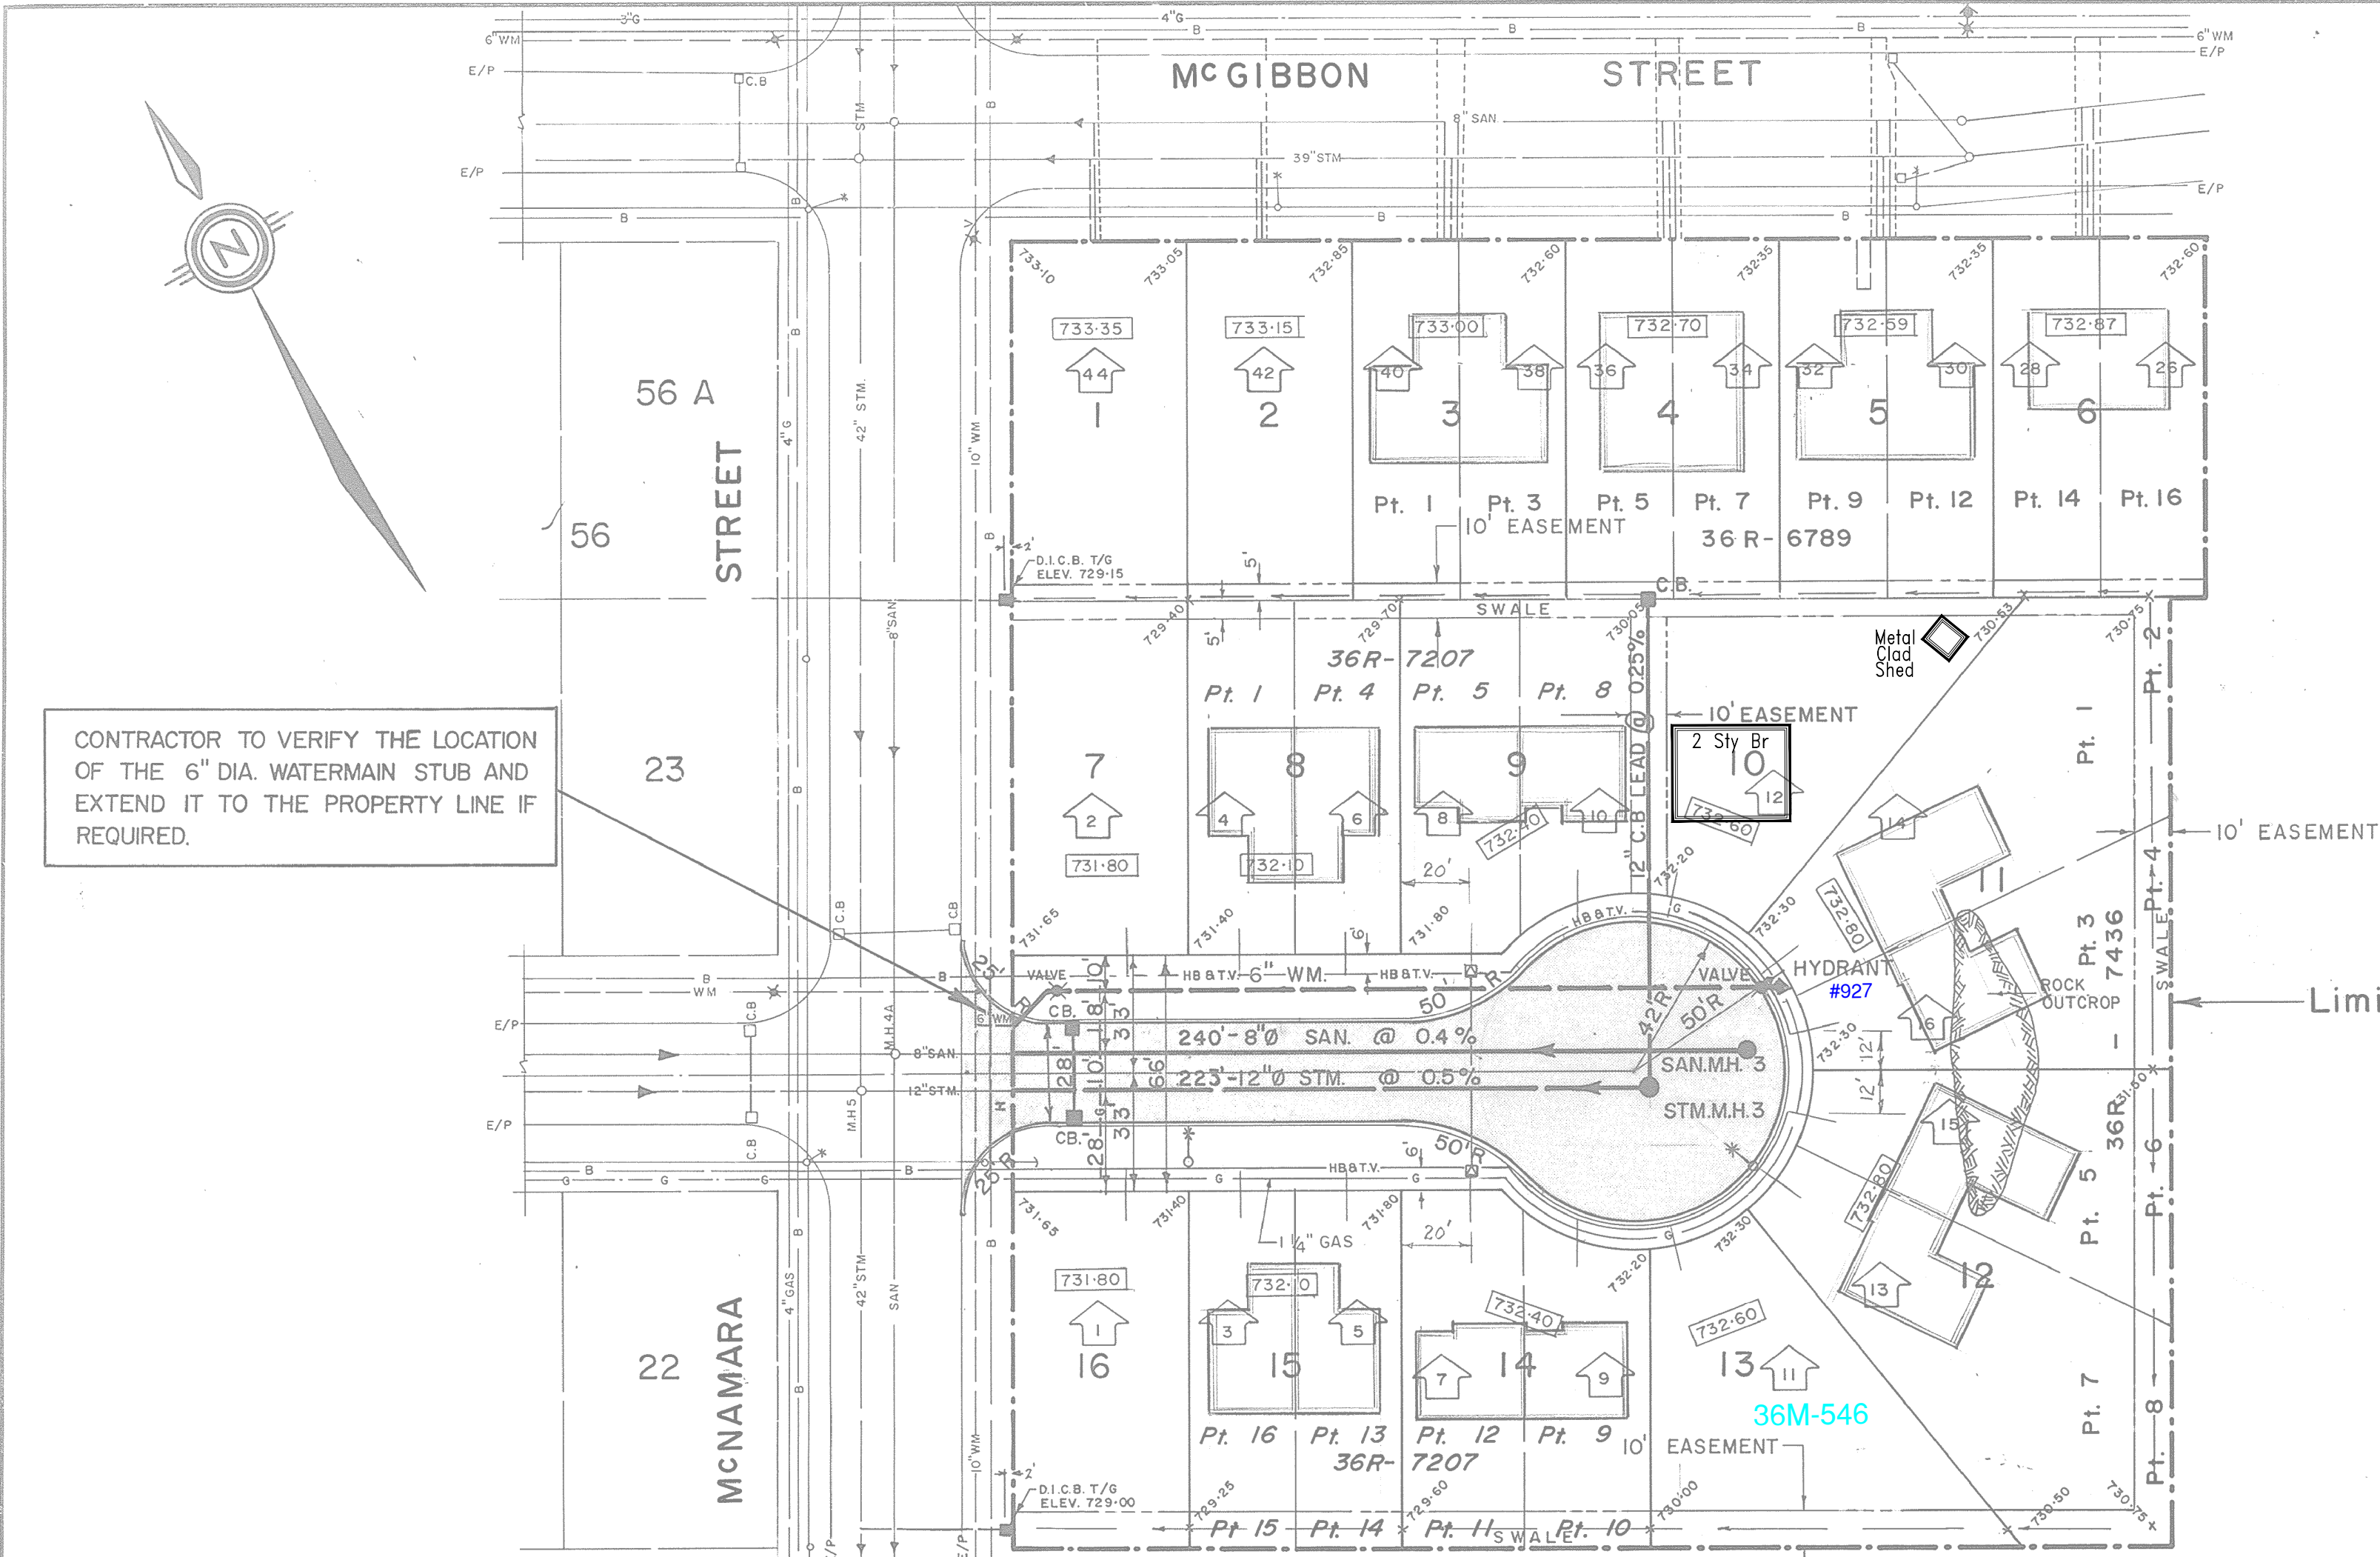

CITY OF NORTH BAY

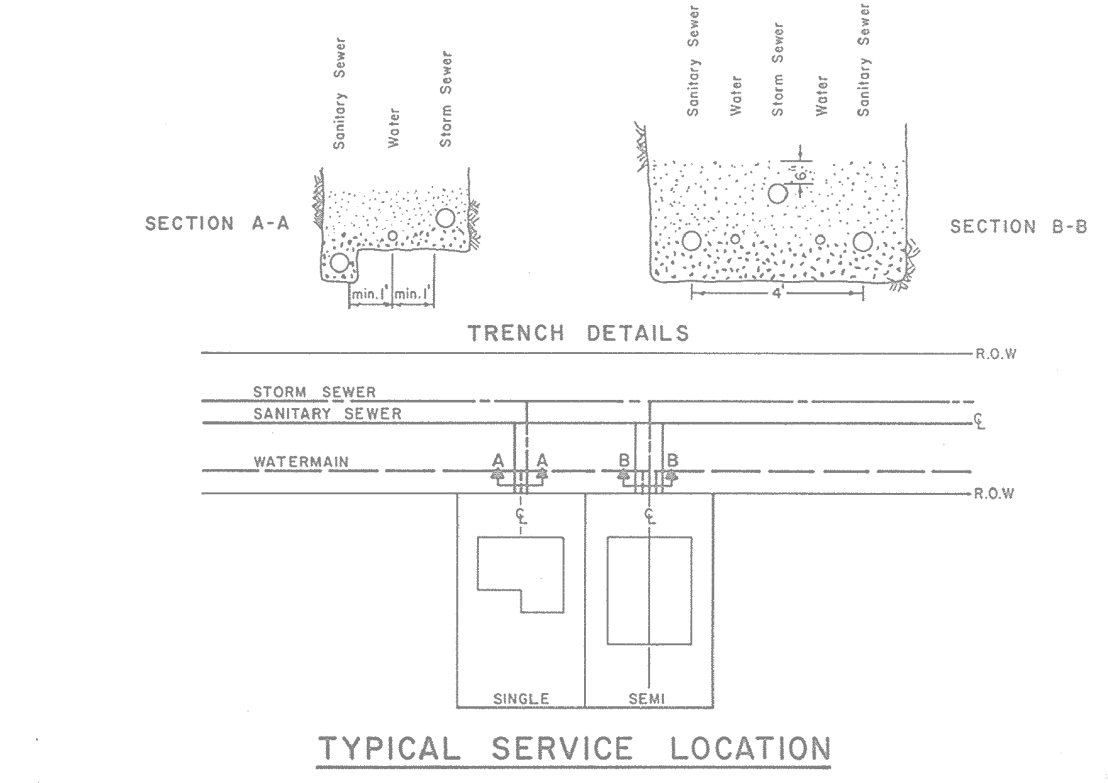

- LEGEND
- H.B.T.V. — HYDRO, BELL & CABLE TELEVISION
 - TRANSFORMER
 - STREET LIGHT - 125 watt M.V.
 - GAS —


CATV PLANT APPROVED <i>[Signature]</i> Date McLean Hunter Cable T.V. Ltd.	GAS PLANT APPROVED <i>[Signature]</i> Date Northern & Central Gas Corp. Ltd.
HYDRO PLANT APPROVED <i>[Signature]</i> Date North Bay Hydro	BELL PLANT APPROVED <i>[Signature]</i> Date Bell Canada Ltd.

Legend

- 732.15 Min. finished ground elevation at house.
- 731.60 Swale or ditch elevation.
- 10 House number

DISCLAIMER

The information contained on this drawing may be based upon data provided by others and may not have been verified by either as-constructed drawings or an Ontario Land Surveyor. The City of North Bay cannot accept responsibility for any errors or omissions on any information shown herein. Field verification, land surveys or excavation (with City approvals) may be required to determine actual location of any and all utilities or property lines.

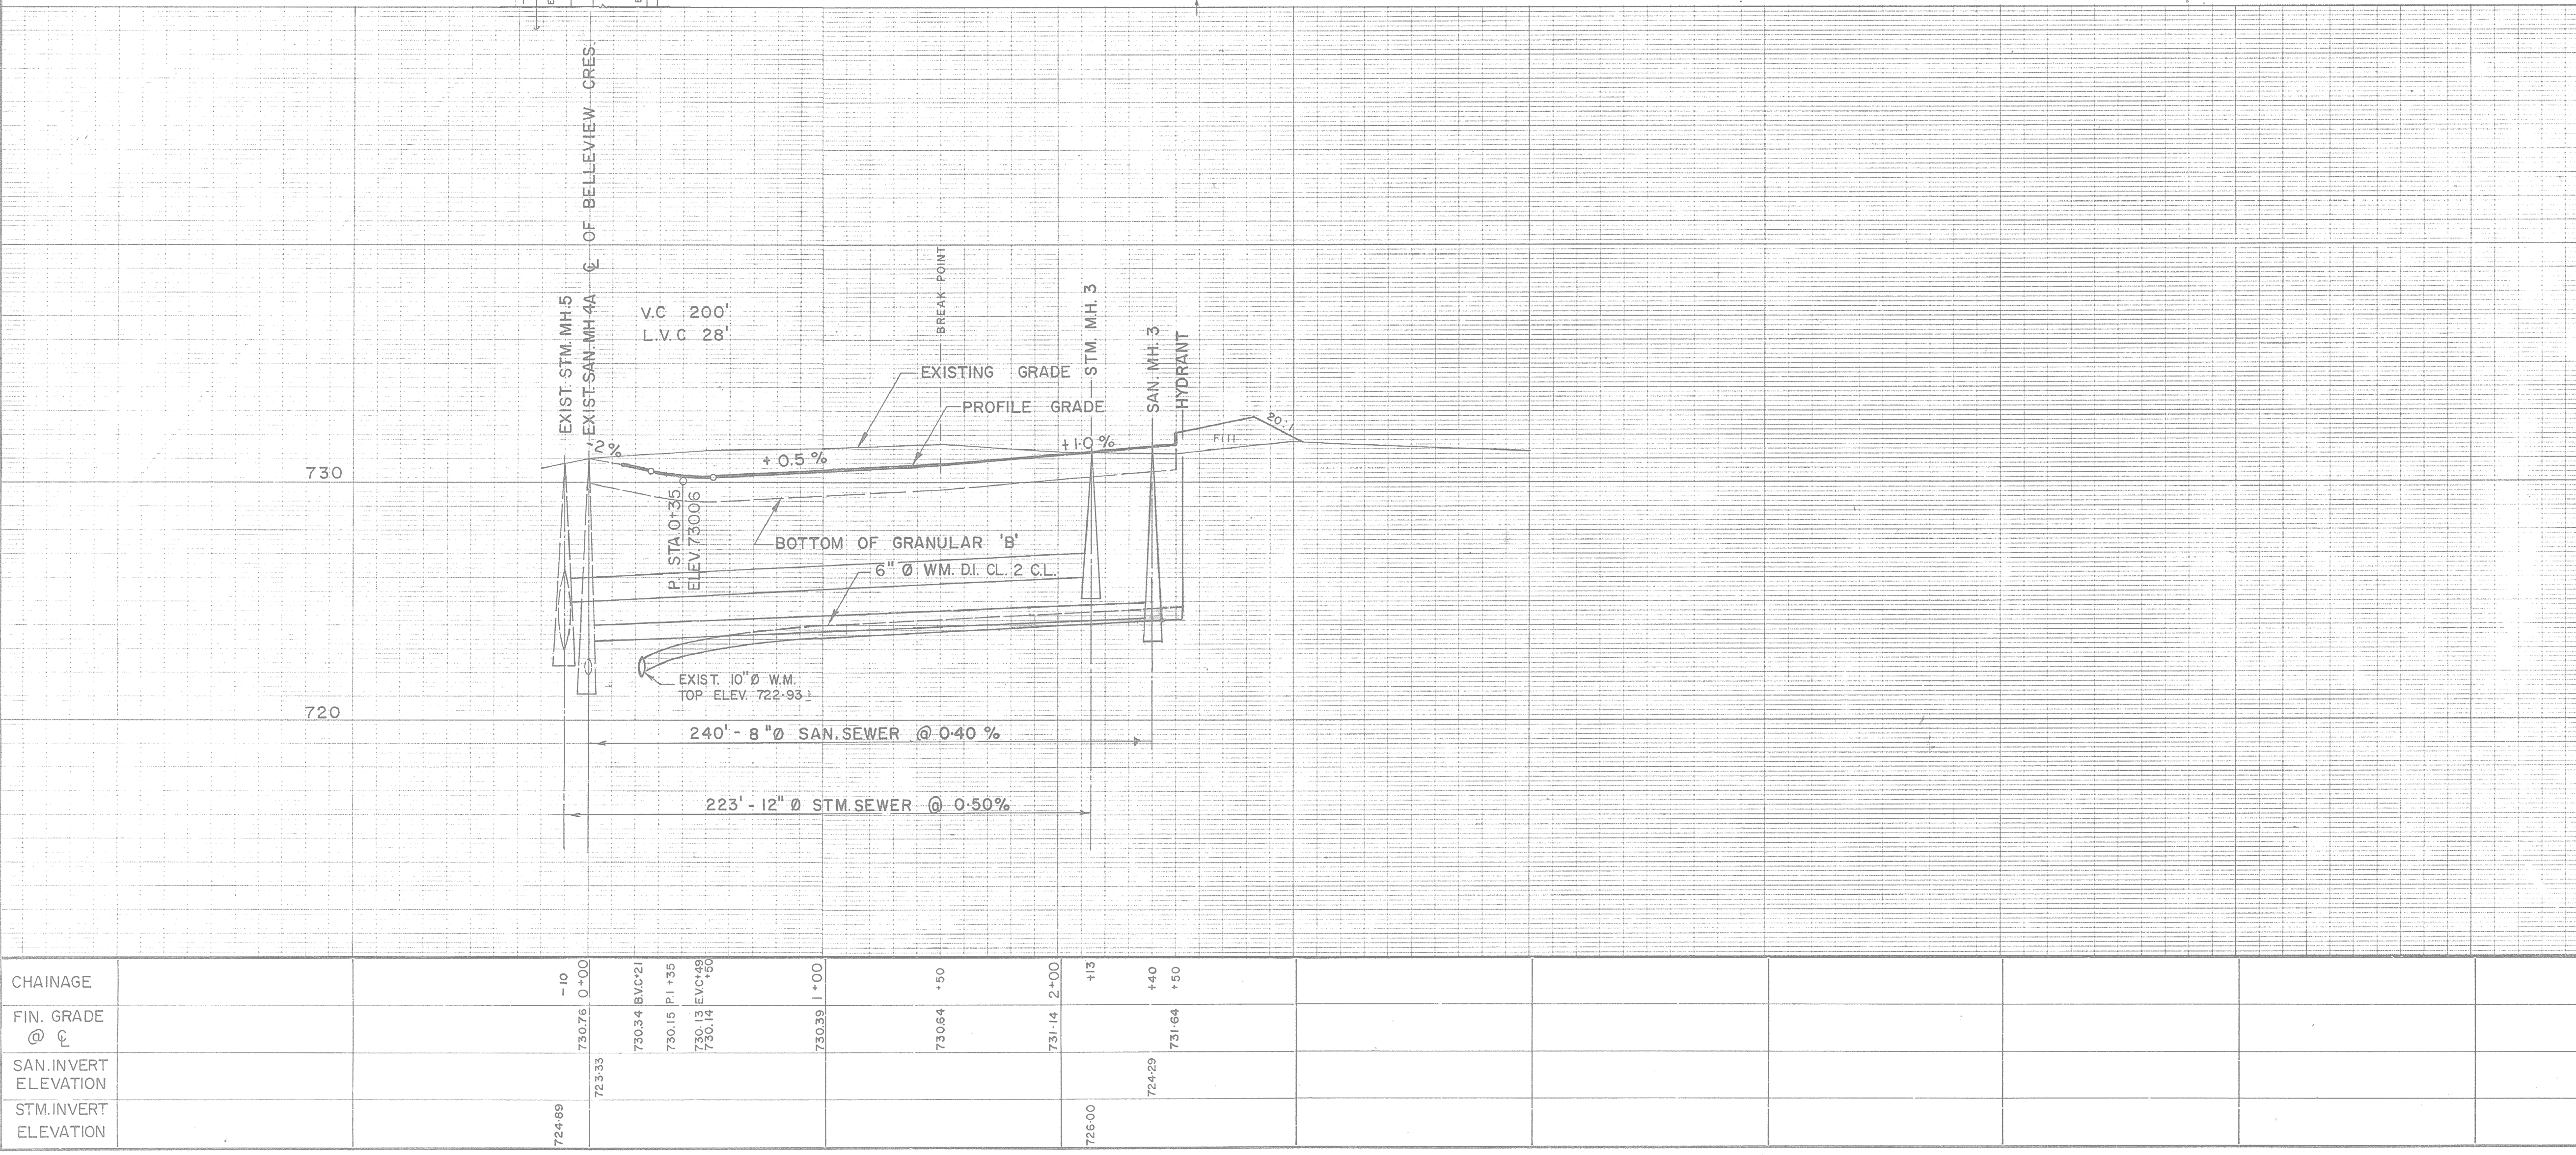

3	S-v-S	ADDED UTILITIES, GAS, BELL, HYDRO & CABLE T.V.	D.A.R.	5 JUNE '80
2	S-v-S	REV. STM. LOCATION, ADDED C.B. LEAD, REV. EX. SAN. STM. Ø	D.A.R.	4 JUNE '80
1	D.P.C.	REV. SAN. LOCATION, GRADE, & LOCATION EXIST. WM.	D.A.R.	11 OCT. '78

MK.	BY	REVISIONS	APP.	DATE

BELLEVUE PARK SUBDIVISION
PHASE III

PLAN AND PROFILE
CYPRESS COURT.

Northland Engineering Ltd.
CONSULTING ENGINEERS AND PLANNERS

NORTH BAY	SUDBURY
DESIGN: D. A. R.	CHECKED: DATE: JUNE, 1978
DRAWN: S. C. P.	APPROVED: FIELD BOOK:
SCALE: HORIZ. 1" = 40'	CONTRACT No.
VERT. 1" = 4'	PROJECT No. 1712
	SHEET No. C-451

NORTH BAY
Just North Enough to be NORTH