


PARCEL 3317 W&F.

BLOCK 'A'

WALLACE ROAD

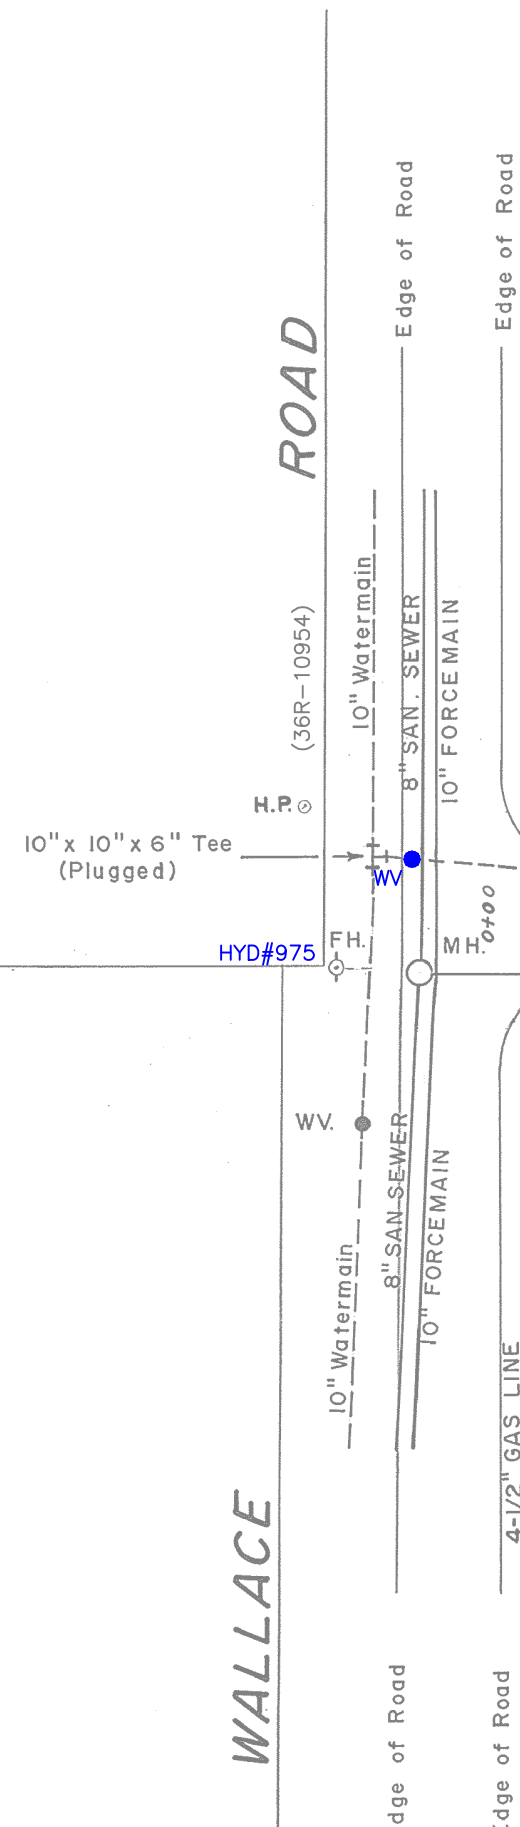

CIRCLE LAKE

ROAD

(SCALE: 1" = 40')


680

670

680

670

(SCALE: hor - 1" = 40'
ver - 1" = 4')

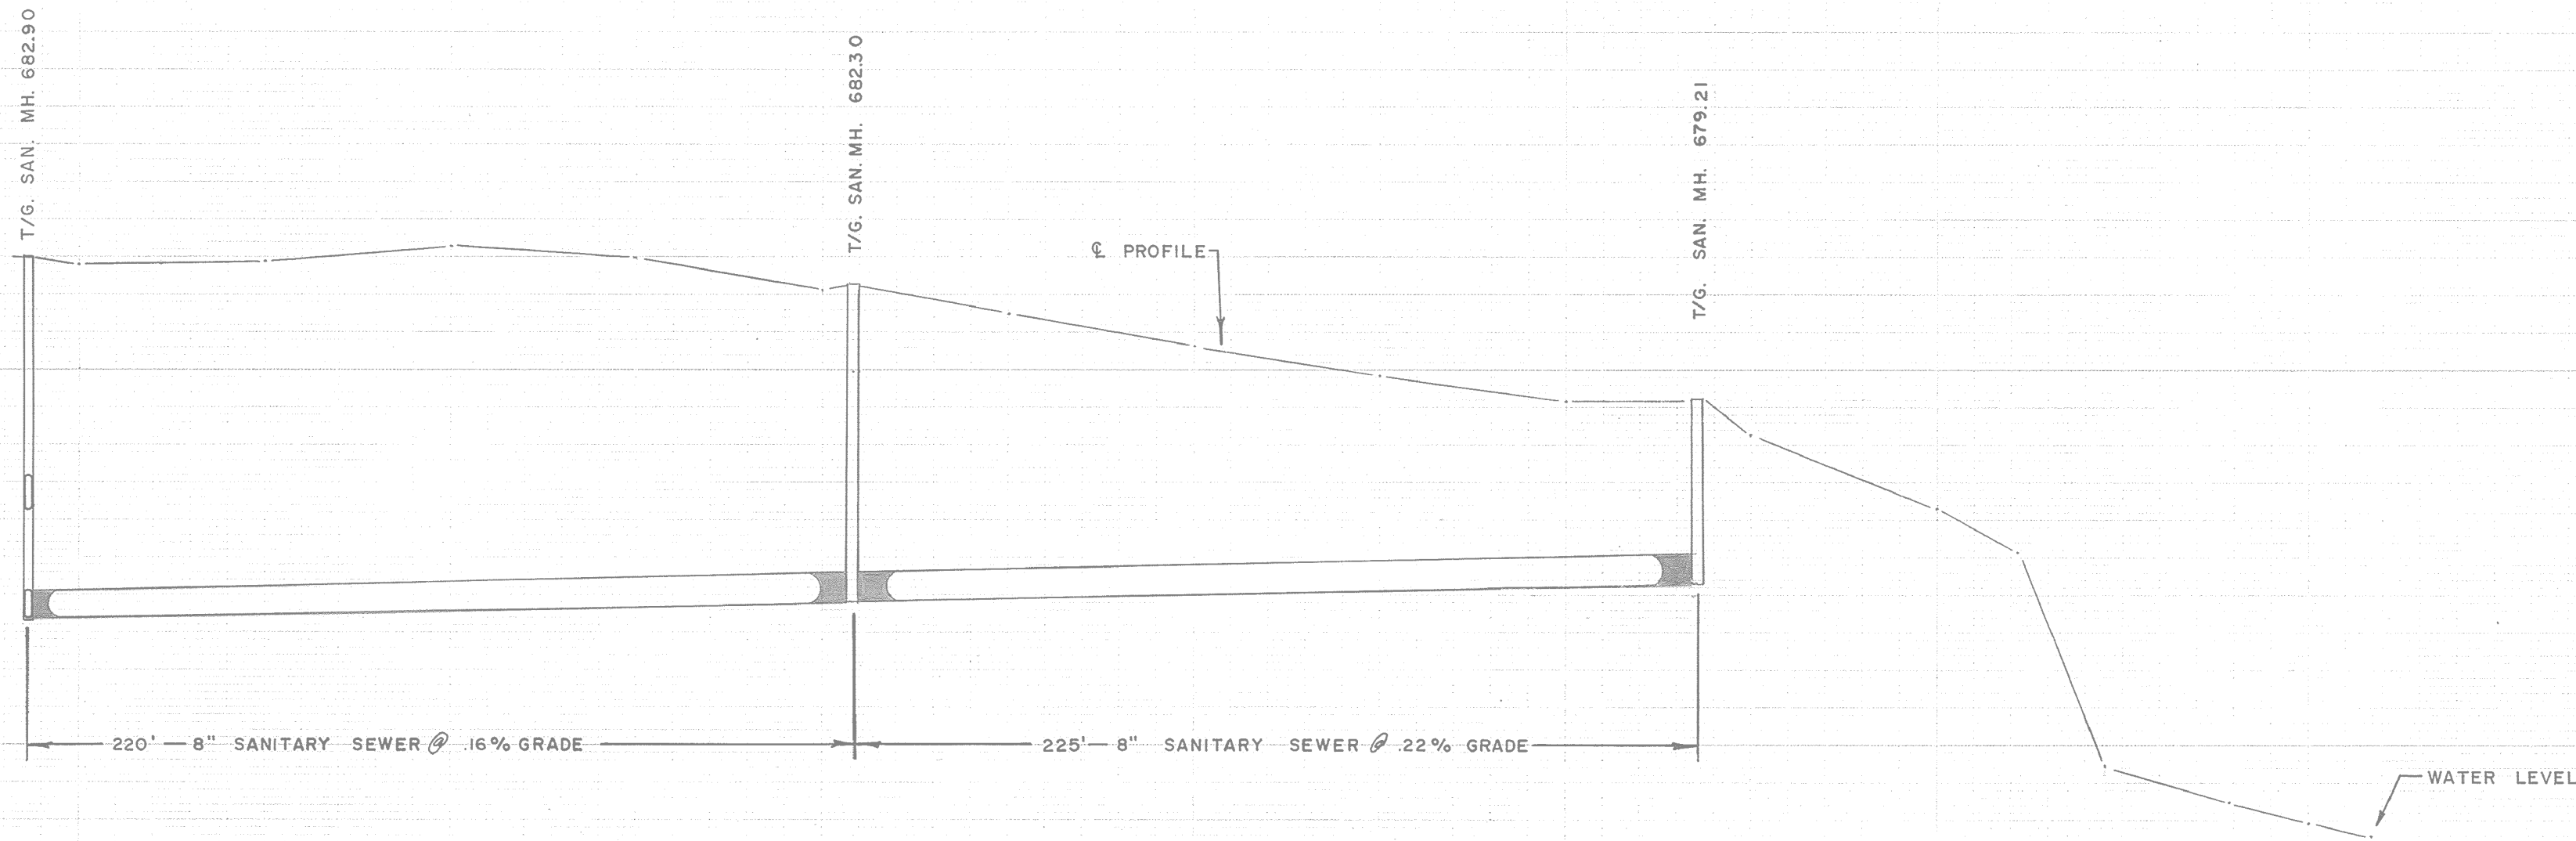

CHAINAGE	GROUND EL.	INVERT
0+12	682.90	N-676.30 E-673.45
0+00	682.78	
0+50	682.90	
1+00	682.29	
1+50	682.99	
2+00	682.09	N-673.79 E-673.79
2+08	682.30	
2+50	681.48	
3+00	680.64	
3+50	679.81	
4+00	679.18	
4+33	679.21	N-674.29 W-674.29
4+50	678.24	
5+00	676.34	
5+21	675.15	
5+45	669.44	
5+78	668.46	
6+00	667.97	
6+16	667.59	
6+50		
7+00		
7+50		
8+00		

NOTES:

DISCLAIMER

The information contained on this drawing may be based upon data provided by others and may not have been verified by either as-constructed drawings or an Ontario Land Surveyor. The City of North Bay cannot accept responsibility for any errors or omissions on any information shown herein. Field verification, land surveys or excavation (with City approvals) may be required to determine actual location of any and all utilities or property lines.



No.	REVISION	DATE	INITIAL
1.	AS CONST'D. SAN. MH'S. & WATERLINE	12/74	A.P.
2.	ADDITION OF HOUSE NUMBERS	OCT. 78	J.d.m.
3.	E. PROFILE 0+00 TO 5+78 BOOK 257 AUG. 80	JULY 81	R.F.B.
4.	ADDITION OF GAS LINE.	NOV. 83	A.P.
5.	Updated Legal Fabric, etc.	Mar 2015	G.W.C.
6.	36R-14094 added	Sept 2017	r.j.o.

APPROVED

CIRCLE LAKE ROAD
WALLACE ROAD to CIRCLE LAKE
REG'D. PLAN N^o. NR-301

CITY OF NORTH BAY
ENGINEERING DEPARTMENT

SCALE: As Shown DATE: Sept. 73.

DRAWN BY: R.F.B.	FIELD BOOK No.	DRAWING No.	REV.
CK'D. BY:	229	C-501	