
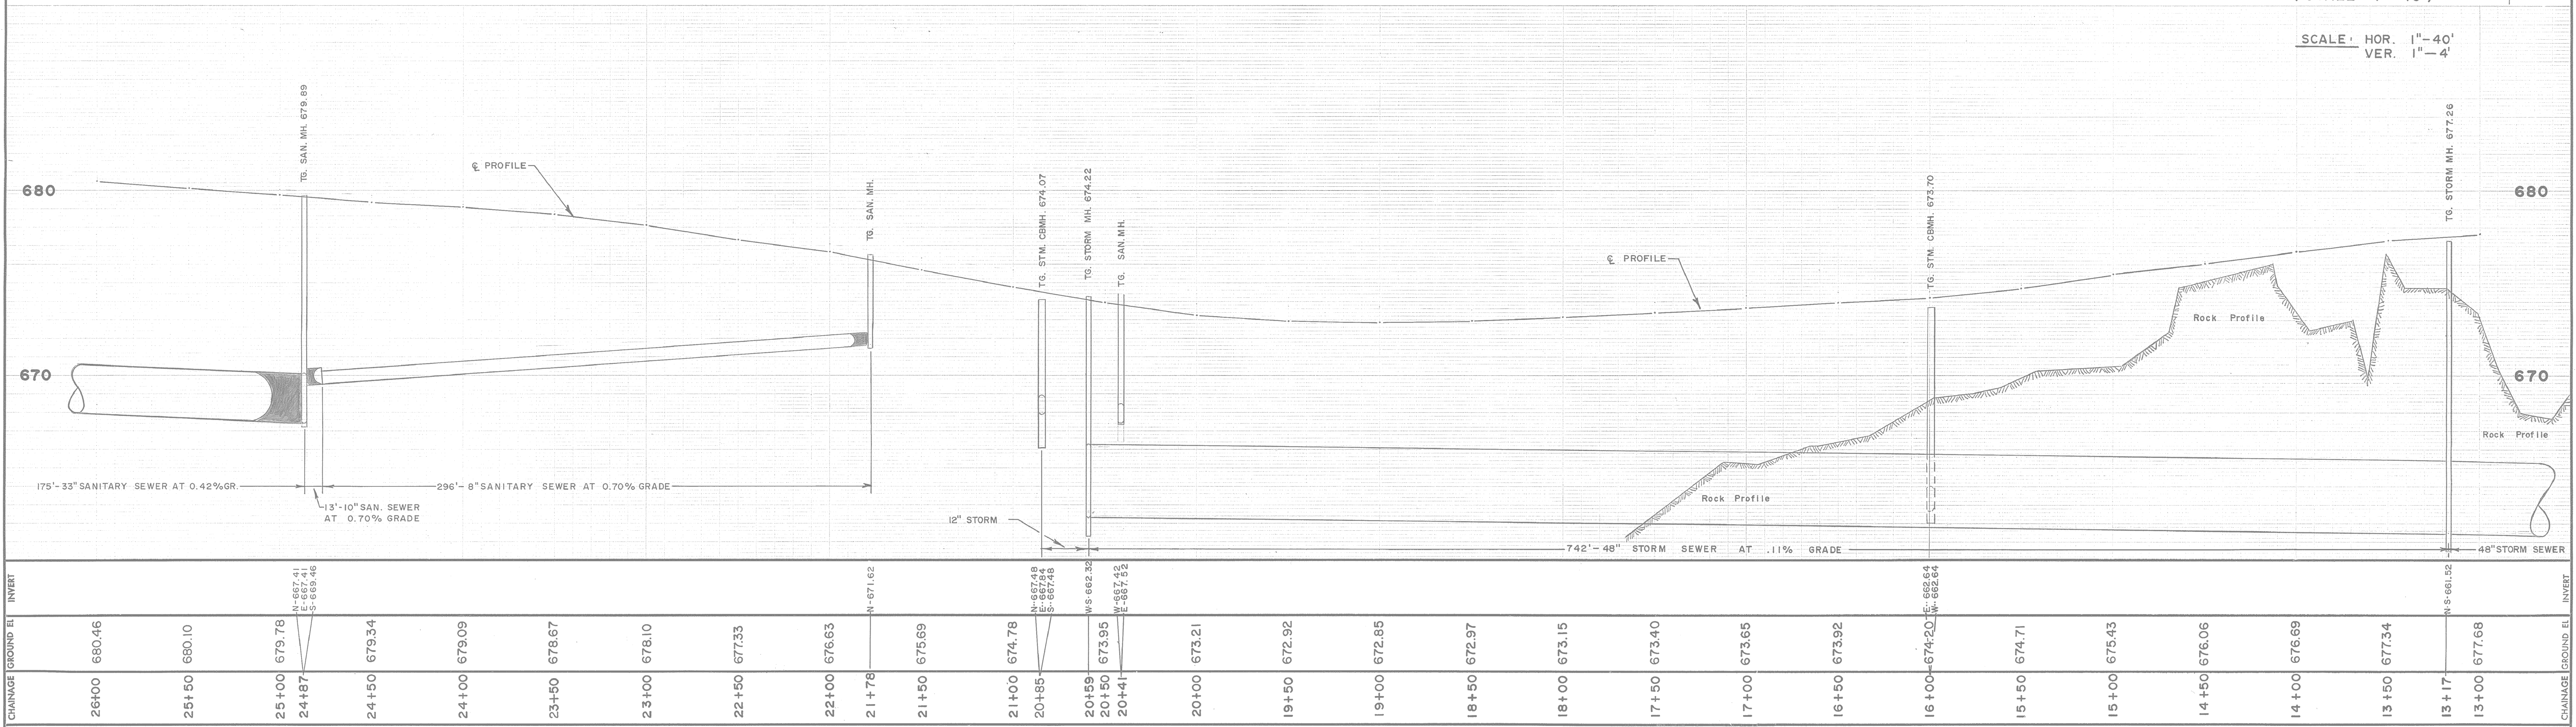


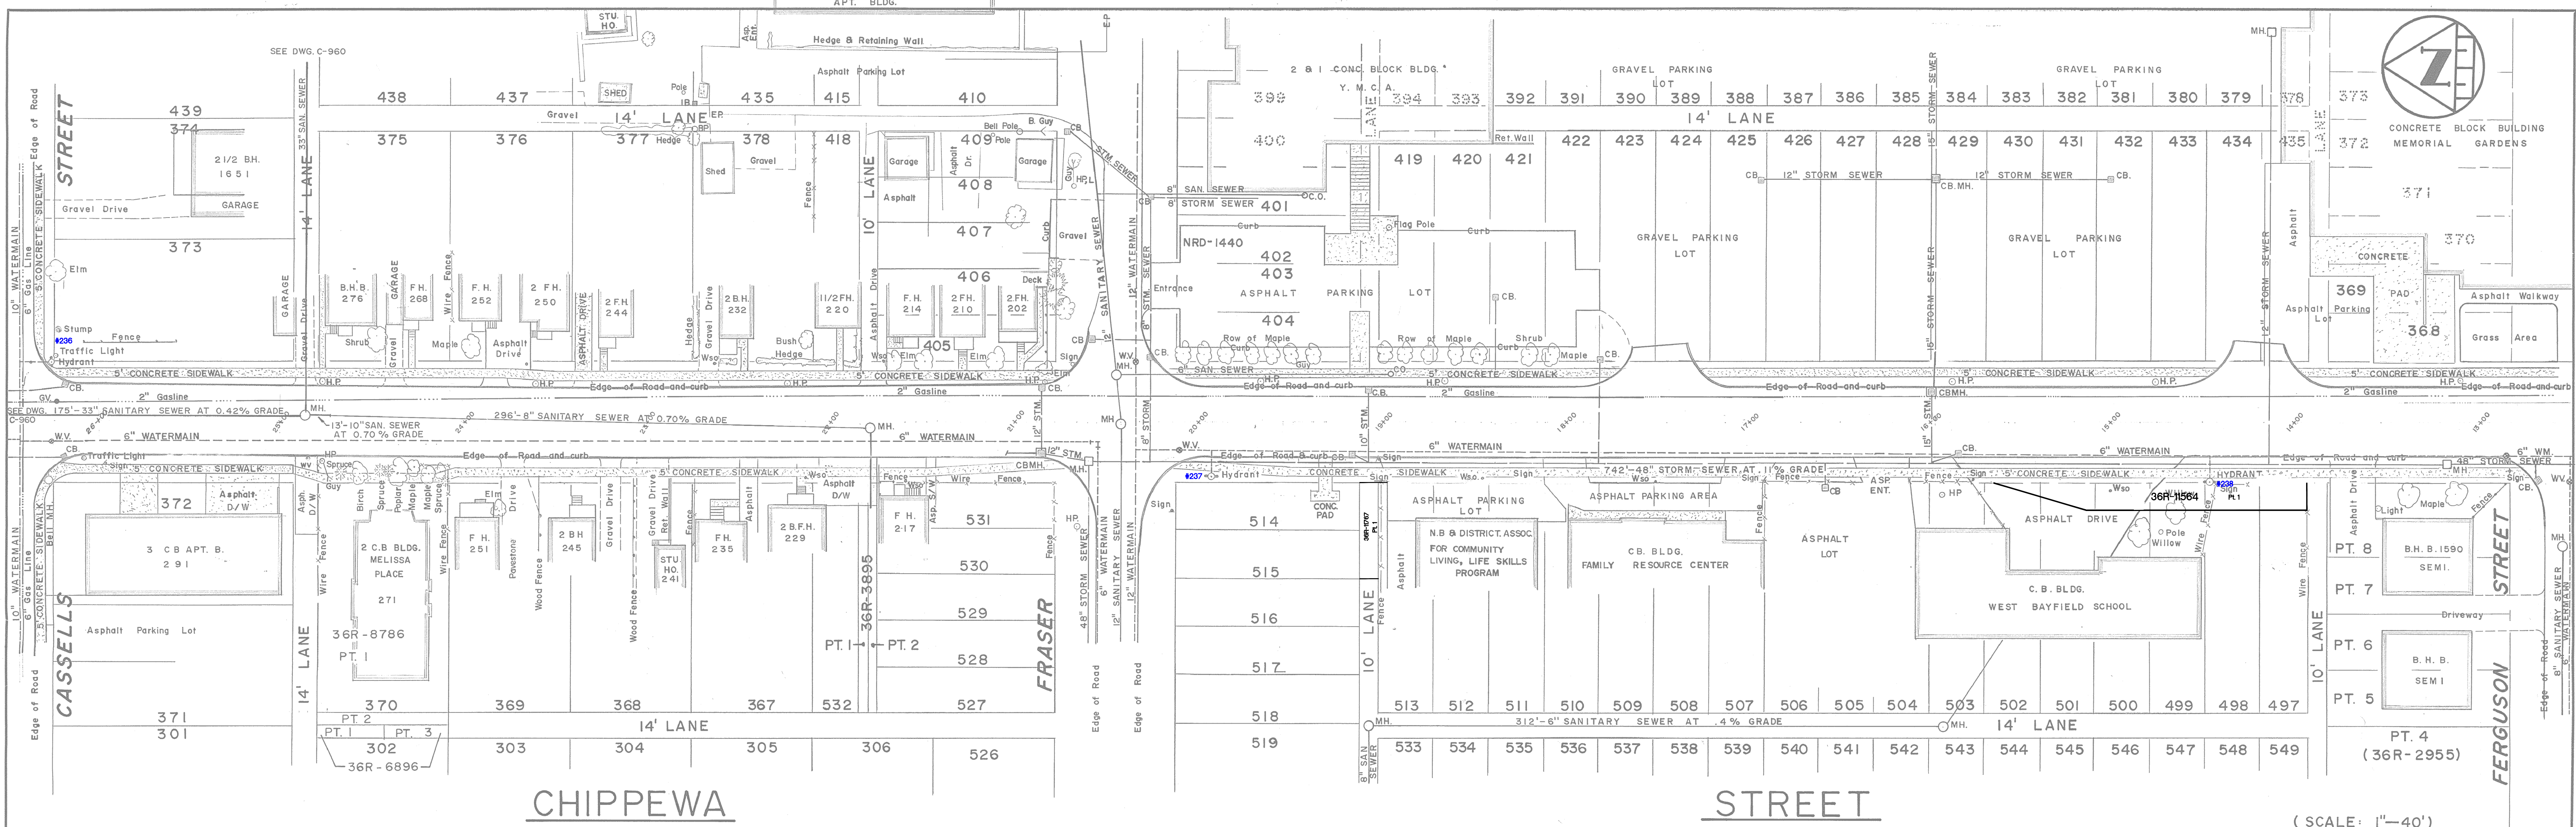

NOTES: DISCLAIMER The information contained on this drawing may be based upon data provided by others and may not have been verified by either as-constructed drawings or an Ontario Land Surveyor. The City of North Bay cannot accept responsibility for any errors or omissions on any information shown herein. Field verification, land surveys or excavation (with City approvals) may be required to determine actual location of any and all utilities or property lines.		7.	Registered Plans Added.	Sept. 07	r.j.o.	1.	NEW DWG., MH. INVS. & ELEV., OLD DWG. SEPT. 59	April 77	R.F.B.	NOTES: 1. ROAD WIDTH 40' (CURB TO CURB)	CHIPPEWA STREET		CITY OF NORTH BAY ENGINEERING DEPARTMENT			
						2.	33" SANITARY SEWER AT CASSELLS ST.	SEPT 78	R.F.B.		FERGUSON STREET TO CASSELLS STREET					
						3.	REVISED LOCATION OF 6" Wm. CASSELLS TO FRASER.	AUG. 79	A.P.		Reg'd. Plan N ^o . 57, 93					
						4.	REVISE ROAD, STM., SDWK., PROFILE BK. 275	NOV. 84	J.S.				SCALE: AS SHOWN		DATE: APRIL 1977	
						5.	REVISED DETAIL	MAY 94	RT.				DRAWN BY: Rick B. CKD. BY:		FIELD BOOK No. 245	
						6.	REVISED DETAIL (FRASER ST.) BEHIND LOTS 376-405	MAY 97	R.T.				DRAWING No.		C - 52	
						No.	REVISION	DATE	INITIAL				REV.			