



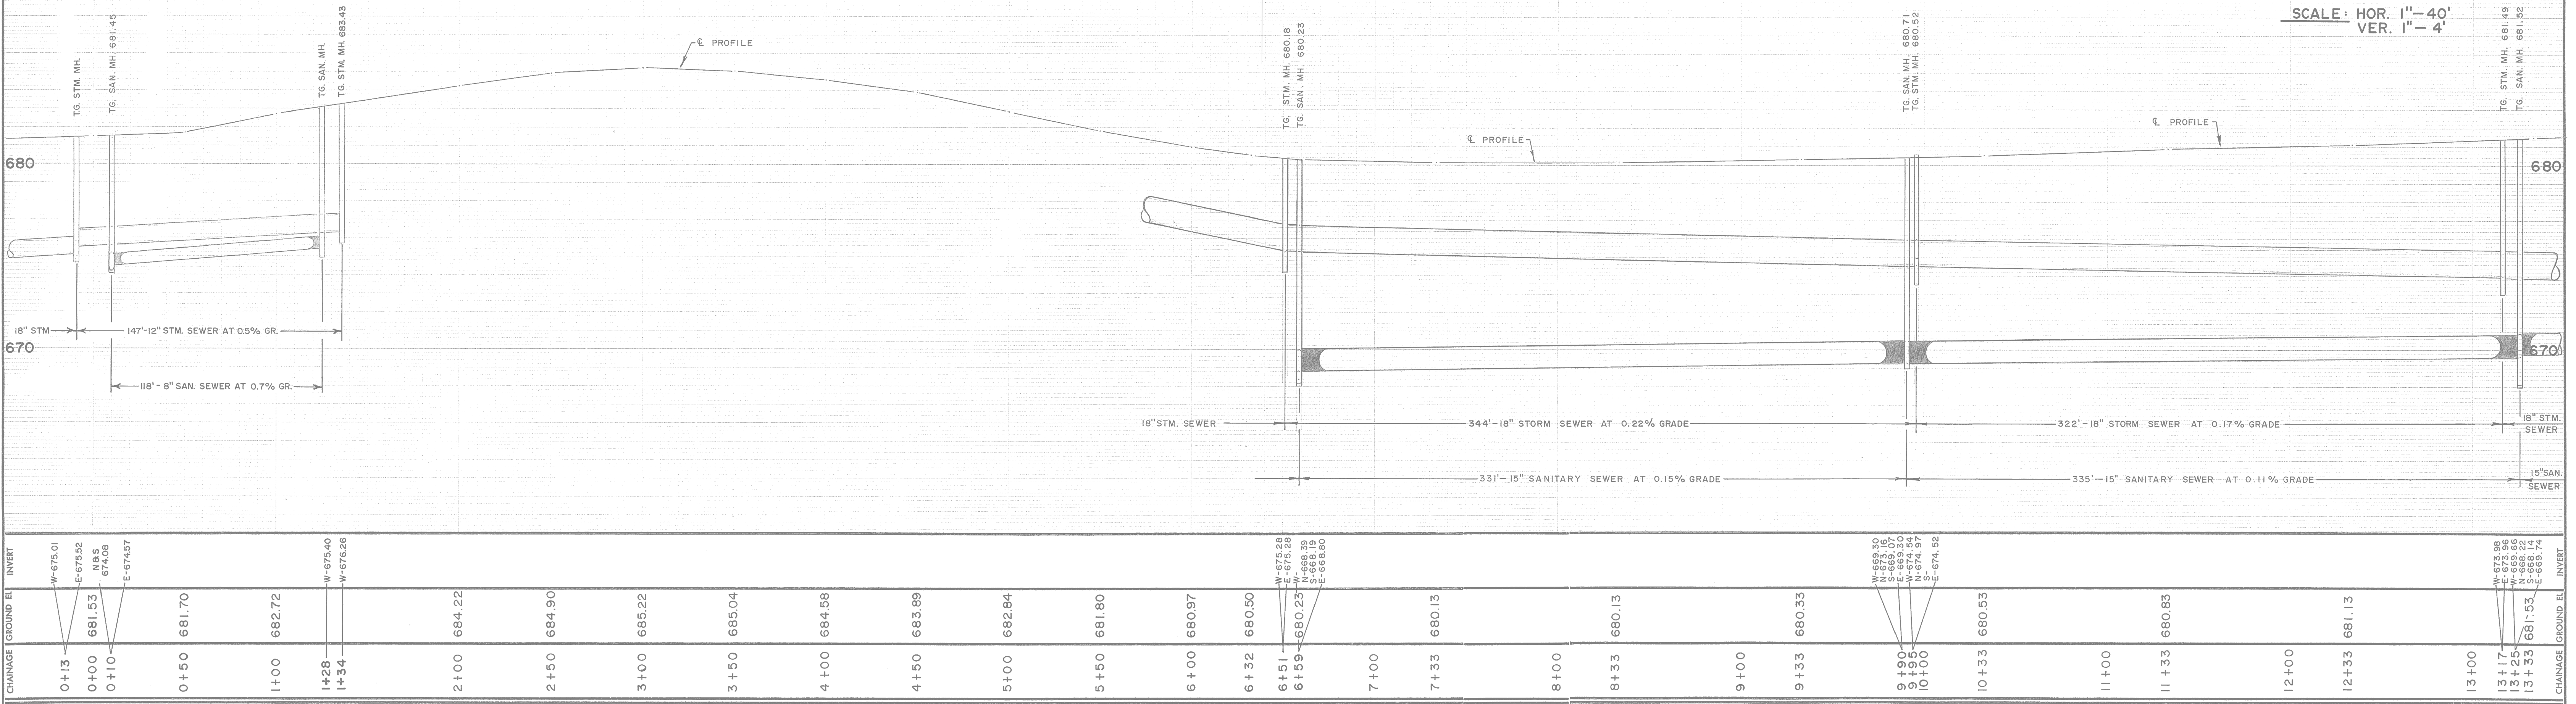

NOTES:		1. STORM SEWER INV. PRINCESS TO CHIPPEWA ST.		2. SAN. & STM. DETAIL AT KING ST.		3. Water Correction, as per PW	
DISCLAIMER		MAY 2001		MAY 2010		G.W.C.	
The information contained on this drawing may be based upon data provided by others and may not have been verified by either as-constructed drawings or an Ontario Land Surveyor. The City of North Bay cannot accept responsibility for any errors or omissions on any information shown herein. Field verification, land surveys or excavation (with City approvals) may be required to determine actual location of any and all utilities or property lines.		REVISION		DATE		INITIAL	
CITY OF NORTH BAY ENGINEERING DEPARTMENT		SCALE: AS SHOWN		DATE: SEPT. 79		DRAWN BY: Rick B. C.K.D. BY:	
FIELD BOOK No. 184, 186, 241.		DRAWING No. C-529		REV.			

DWG 140

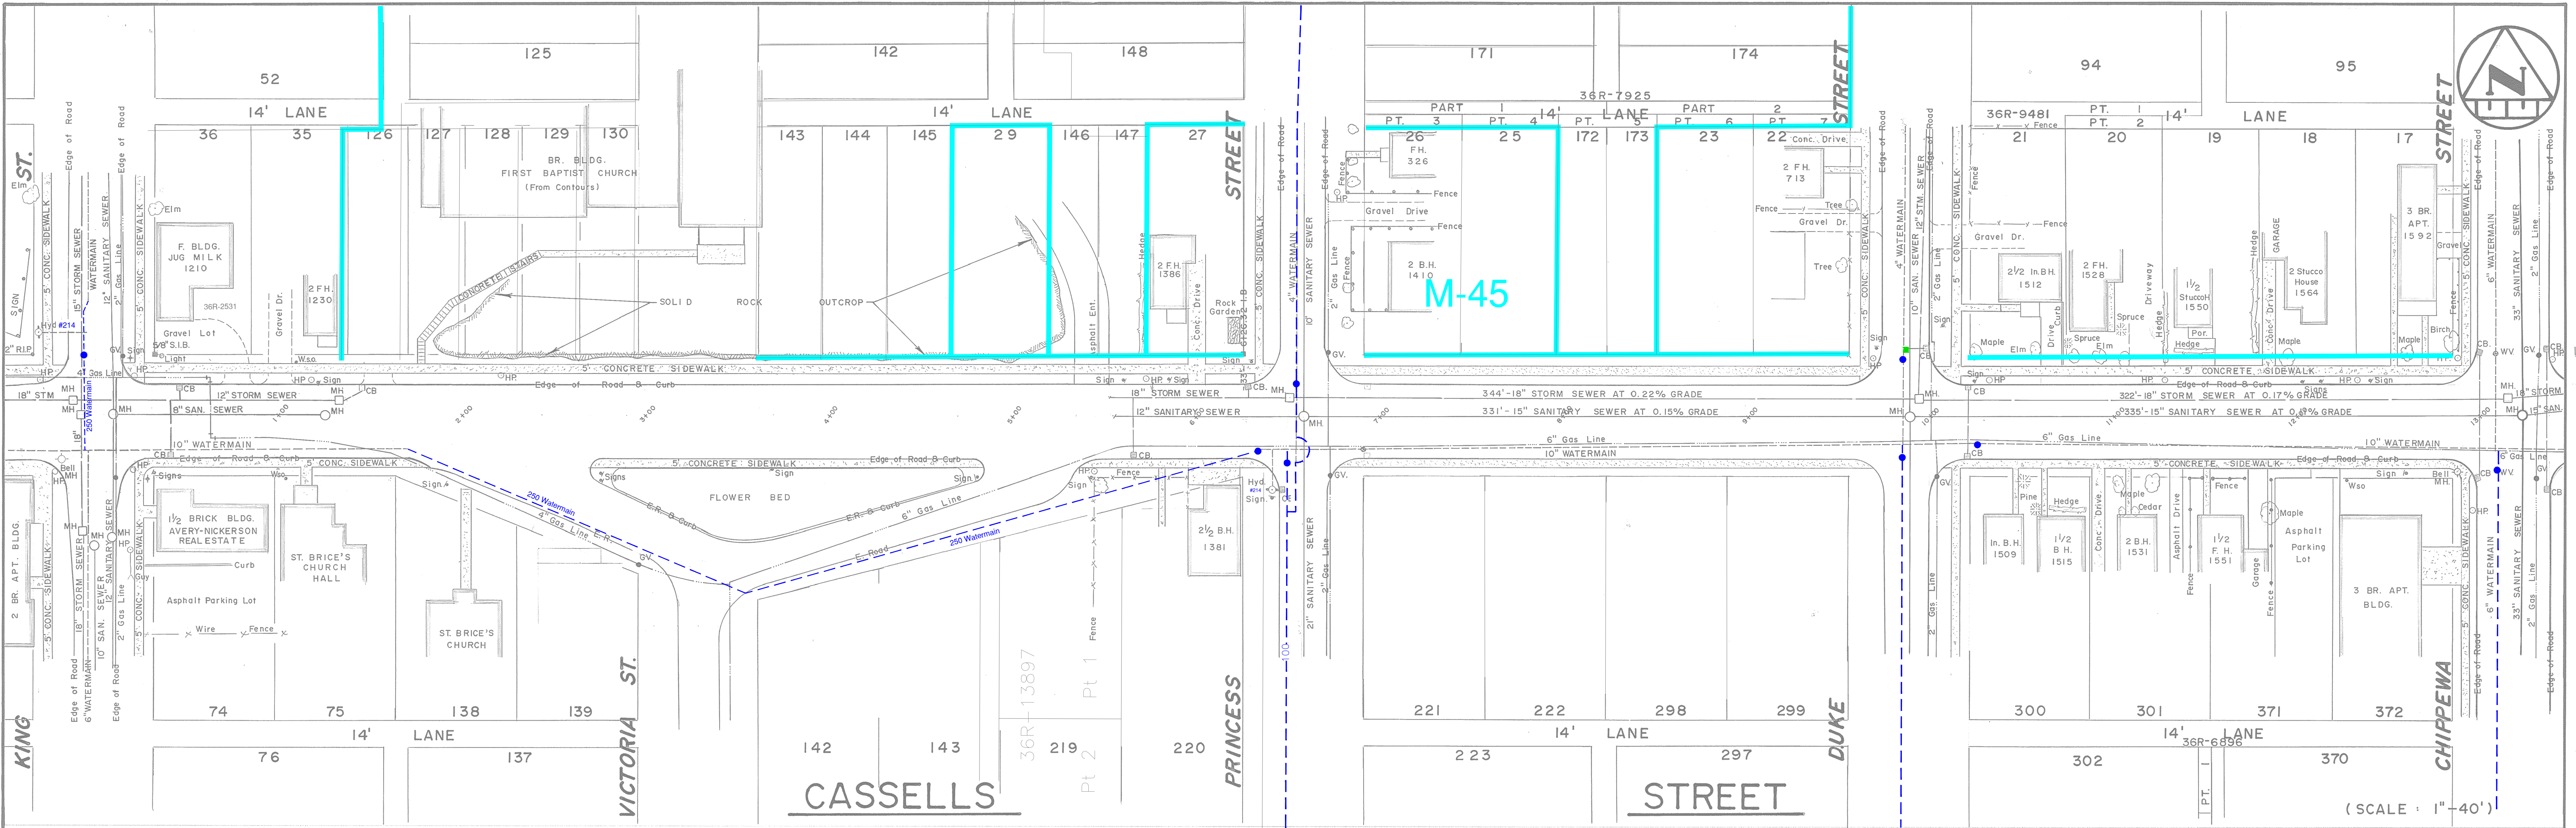