
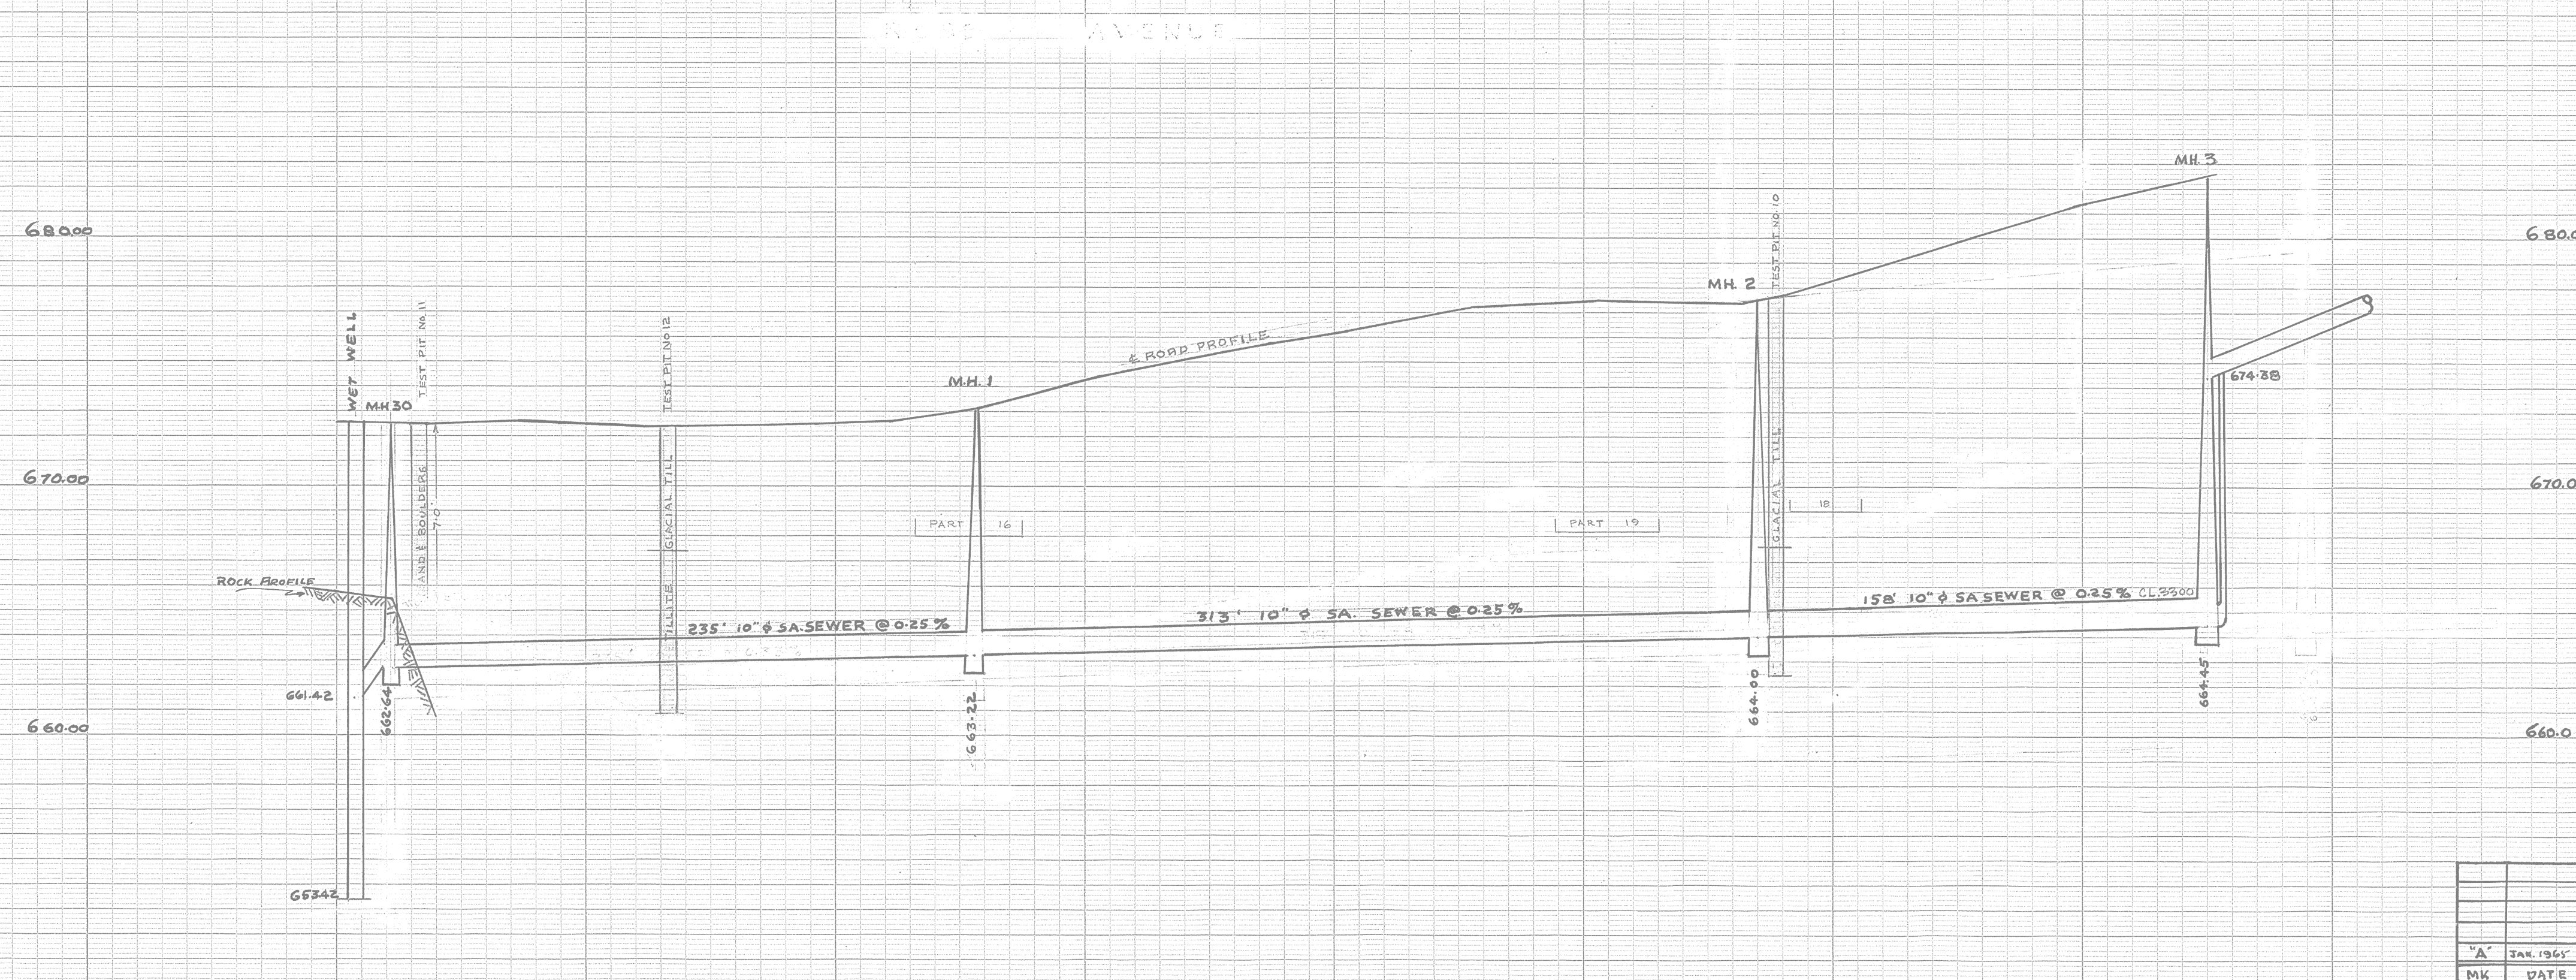
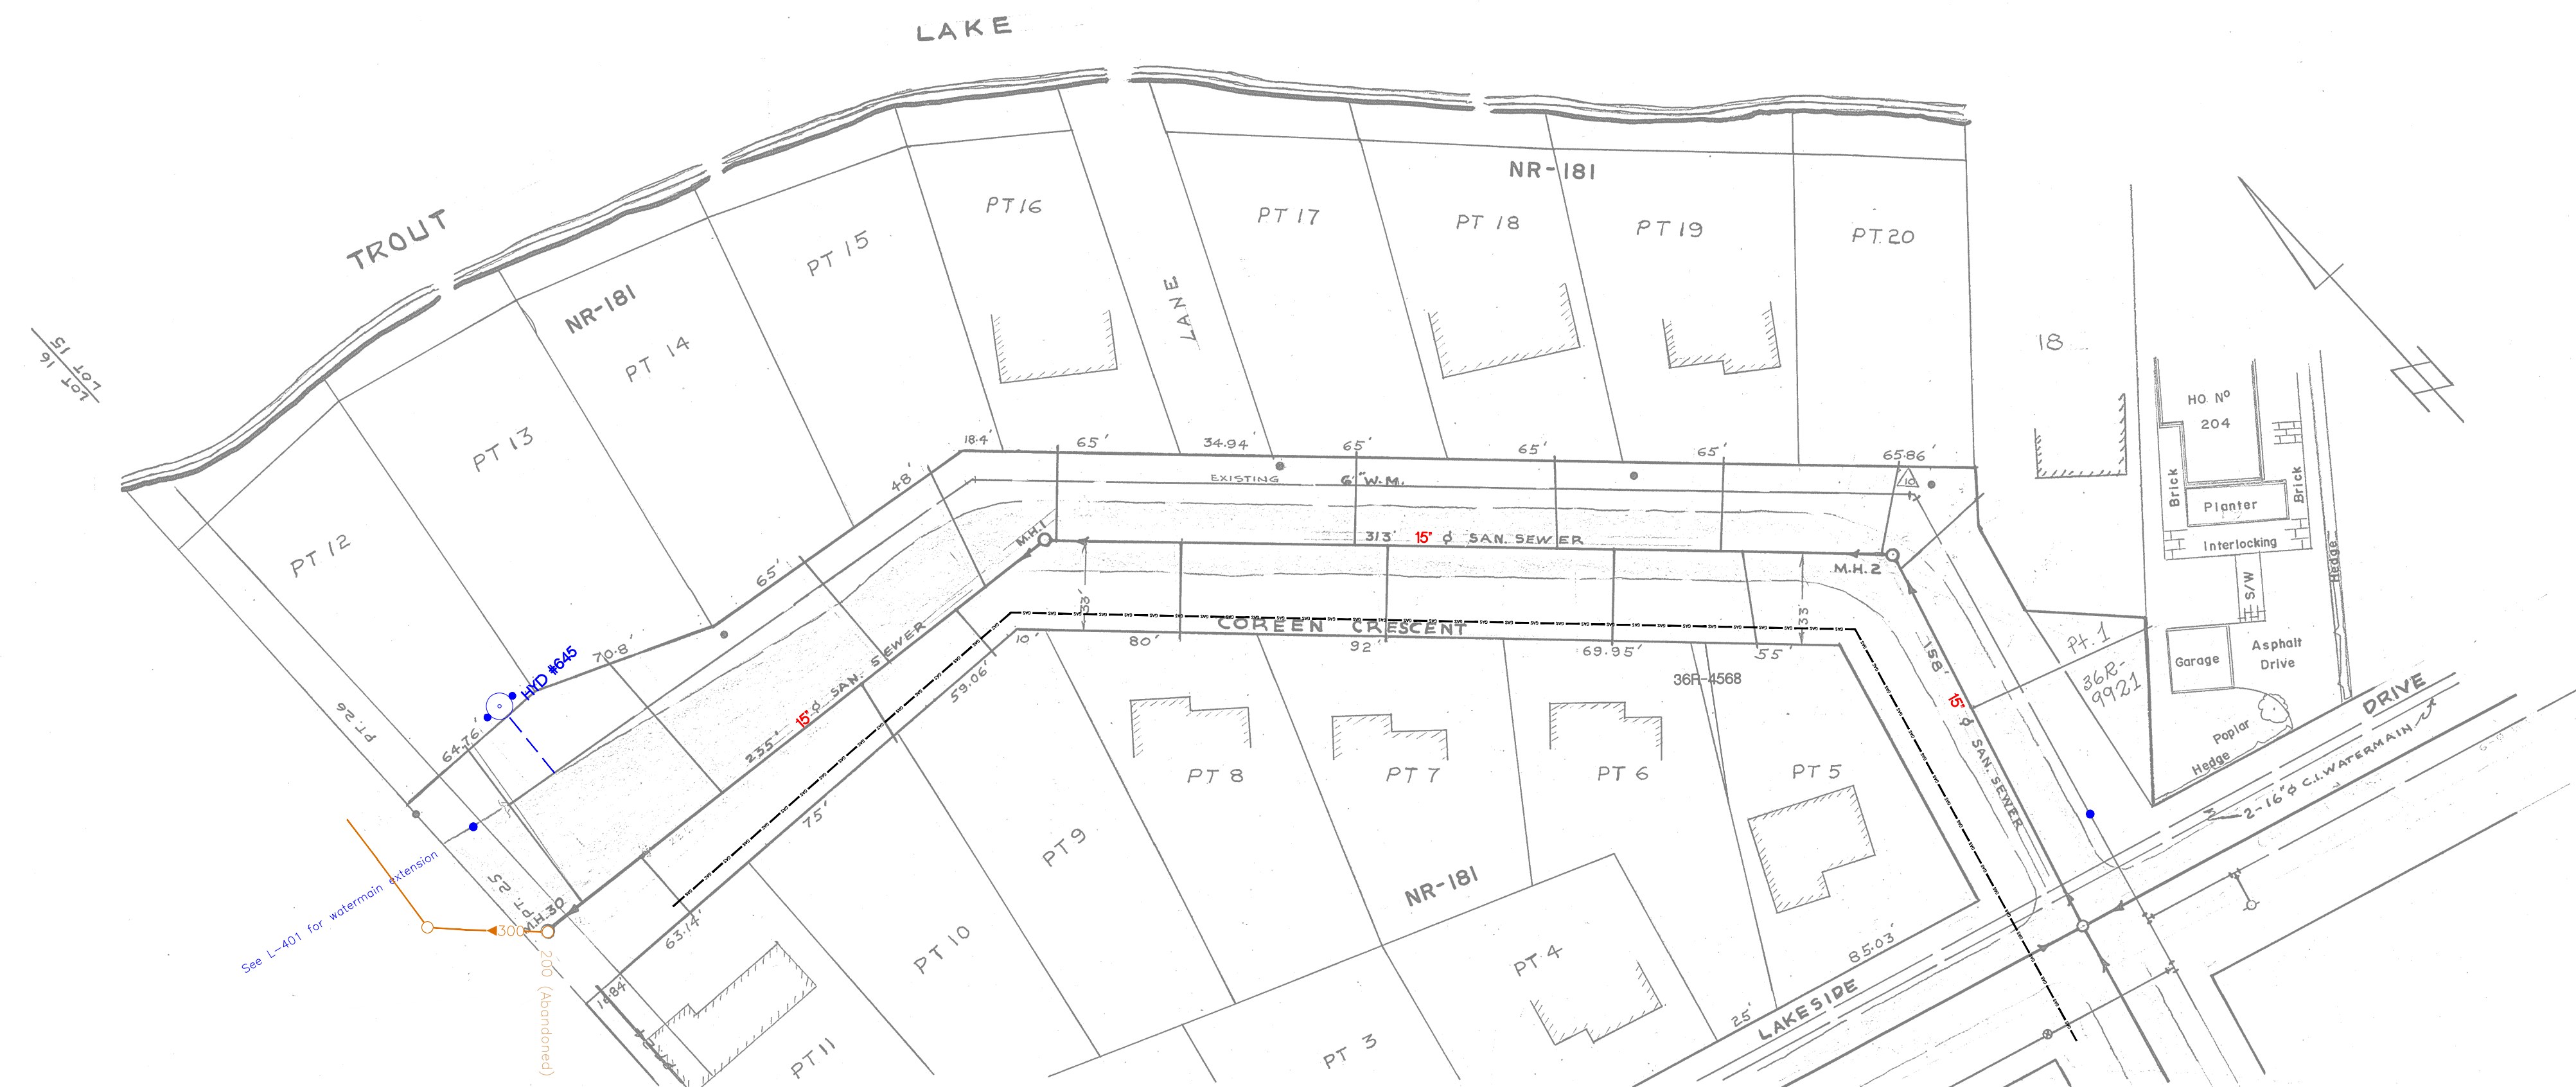


DISCLAIMER
The information contained on this drawing may be based upon data provided by others and may not have been verified by either as-constructed drawings or an Ontario Land Surveyor. The City of North Bay cannot accept responsibility for any errors or omissions on any information shown herein. Field verification, land surveys or excavations (with City approvals) may be required to determine actual location of any and all utilities or property lines.

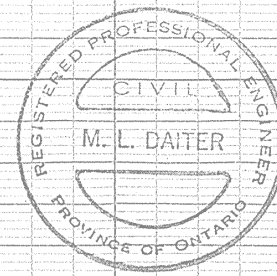

WIDDIFIELD TOWNSHIP	
BOX 717 NORTH BAY ONT.	
BIRCHAVEN SUBDIVISION	
SEWERAGE	
COREEN DRIVE	
FROM LINE BTW. LOT 15 & 16 TO LAKESIDE DR.	
NORTHLAND ENGINEERING	
CONSULTING CIVIL ENGINEERS	
NORTH BAY - ONTARIO	

APPROVALS		W.B. DRAWN BY - W.B.		SCALE - HORIZ. 1"=40 FT. VERT. 1"=4 FT.		DATE - MARCH 2016		DWG. NO. C-626		REV. 1A	
BY		CHECKED BY -		DATE		DATE		DATE		DATE	

KEUFFEL & ESSER CO.
NEW YORK

THIS STANDARD DRAWING
IS A PART OF
PROFILE PLATE A 4 X 20
DOWNSIDE NORTH
BAY, ONT. 2016

KEUFFEL & ESSER CO.
NEW YORK

THIS STANDARD DRAWING
IS A PART OF
PROFILE PLATE A 4 X 20
DOWNSIDE NORTH
BAY, ONT. 2016

KEUFFEL & ESSER CO.
NEW YORK