



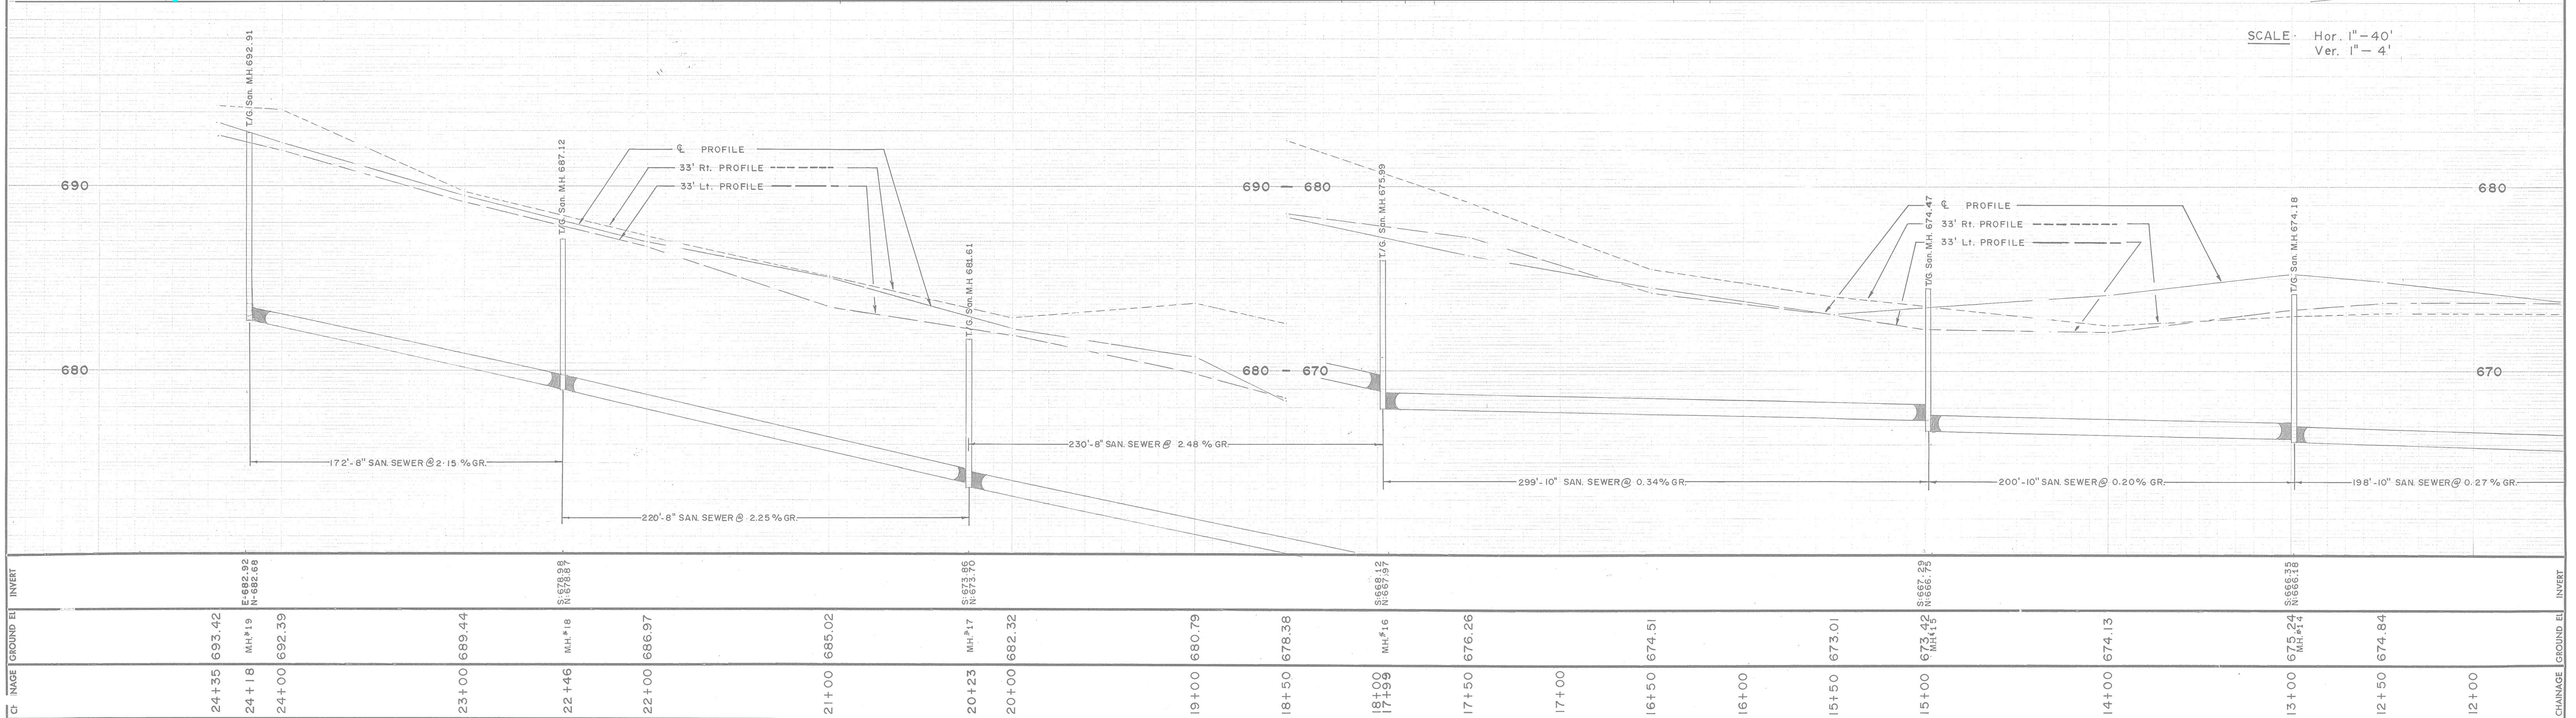

NOTES:

DISCLAIMER

The information contained on this drawing may be based upon data provided by others and may not have been verified by either as-constructed drawings or an Ontario Land Surveyor. The City of North Bay cannot accept responsibility for any errors or omissions on any information shown herein. Field verification, land surveys or excavation (with City approvals) may be required to determine actual location of any and all utilities or property lines.

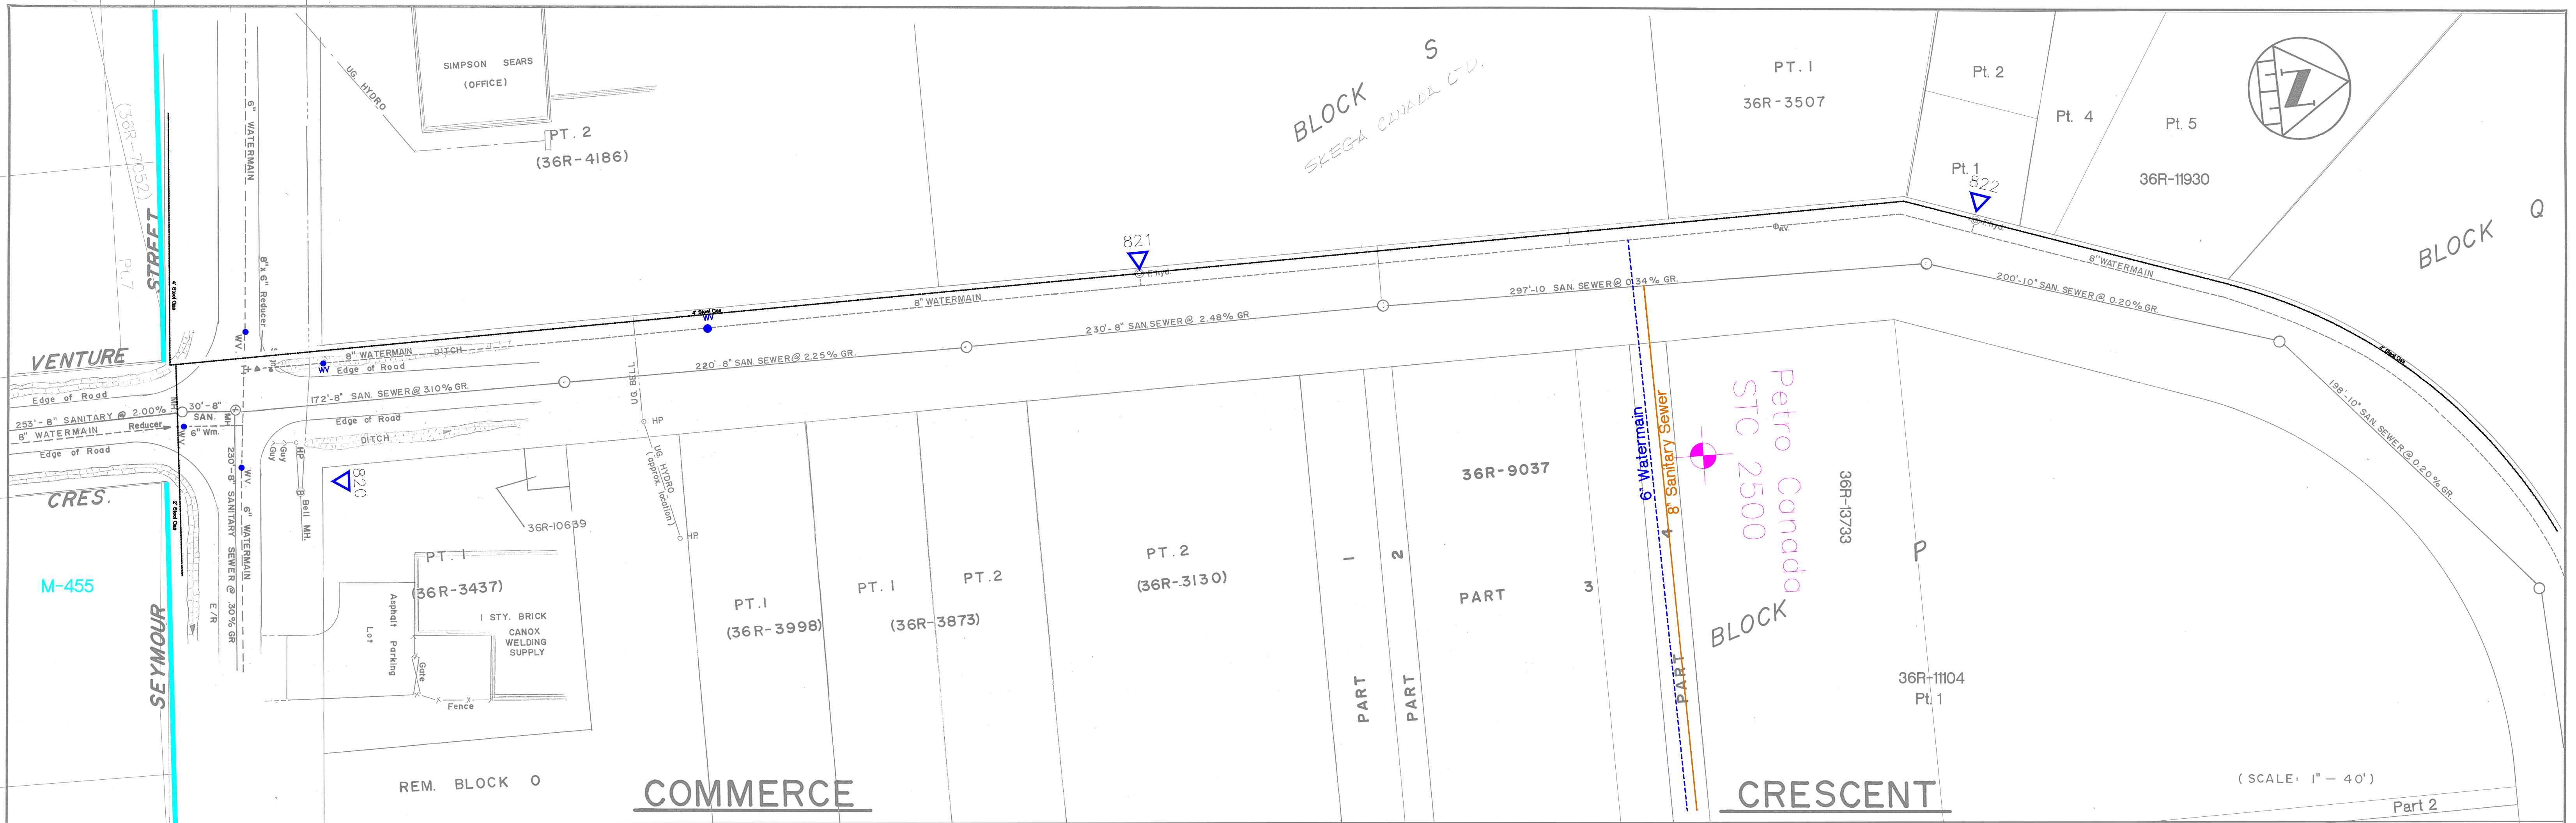

1.	10" 8" SAN. SEWER & 8" WATERMAIN	3 Jan. 1974	CSM
2.	FISHER MACHINE SHOP & UG. HYDRO	JULY 78	J.d.m.
3.	Registered Plans, watermain and sanitary sewer added.	Sept. 07	rjo.
4.	36R-13733 + Seymour Intersection, FH moved	Jan. '15	Q.W.C.
No.	REVISION	DATE	INITIAL

APPROVED

COMMERCE CRES.
STATION 12+00 TO SEYMOUR STREET.
REG'D. PLAN No. M-455

CITY OF NORTH BAY
ENGINEERING DEPARTMENT

SCALE: As Shown. DATE: MAY. 73.

DRAWN BY: R.F.B. CK'D. BY: **226** FIELD BOOK No. **226** DRAWING No. **C-652** REV.