
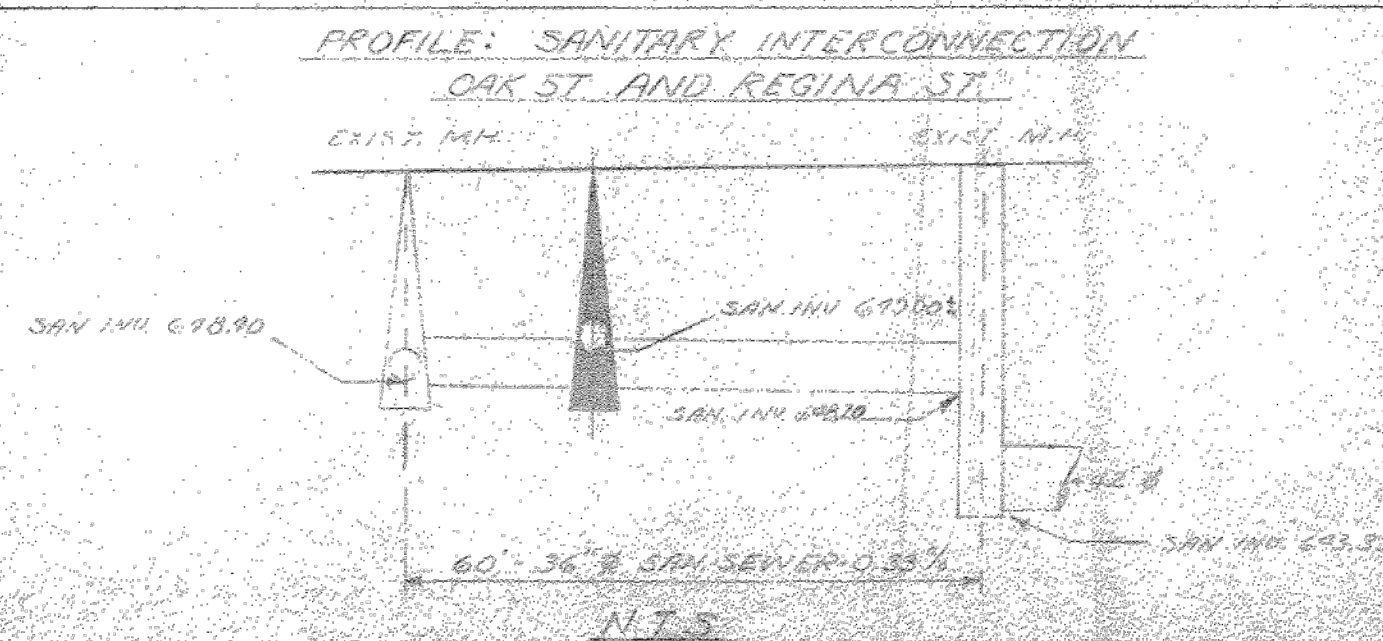
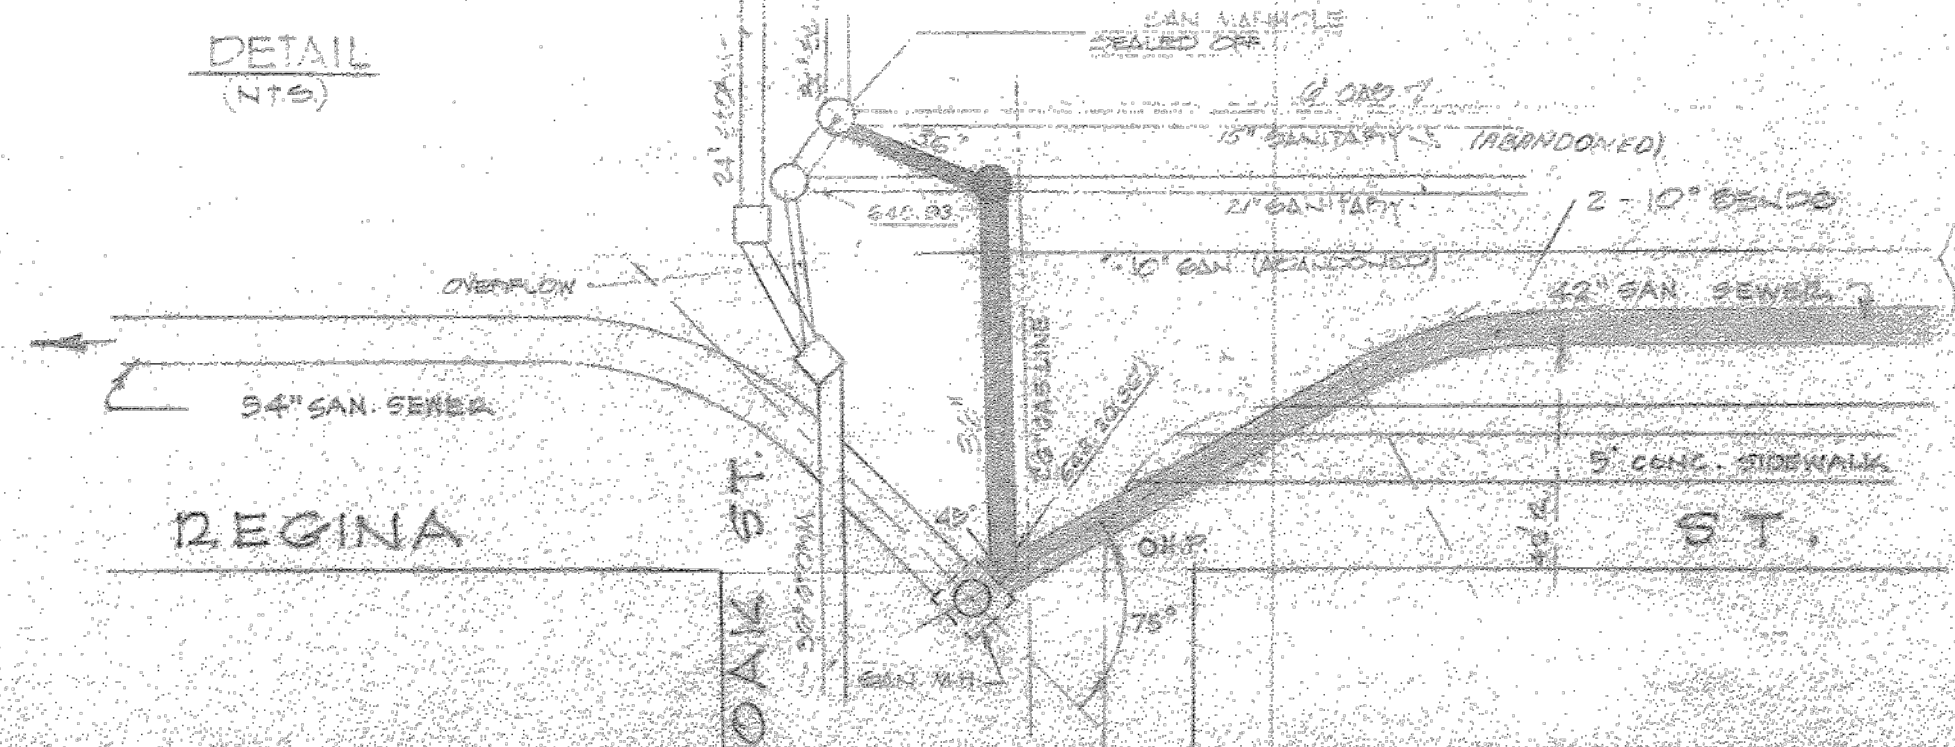
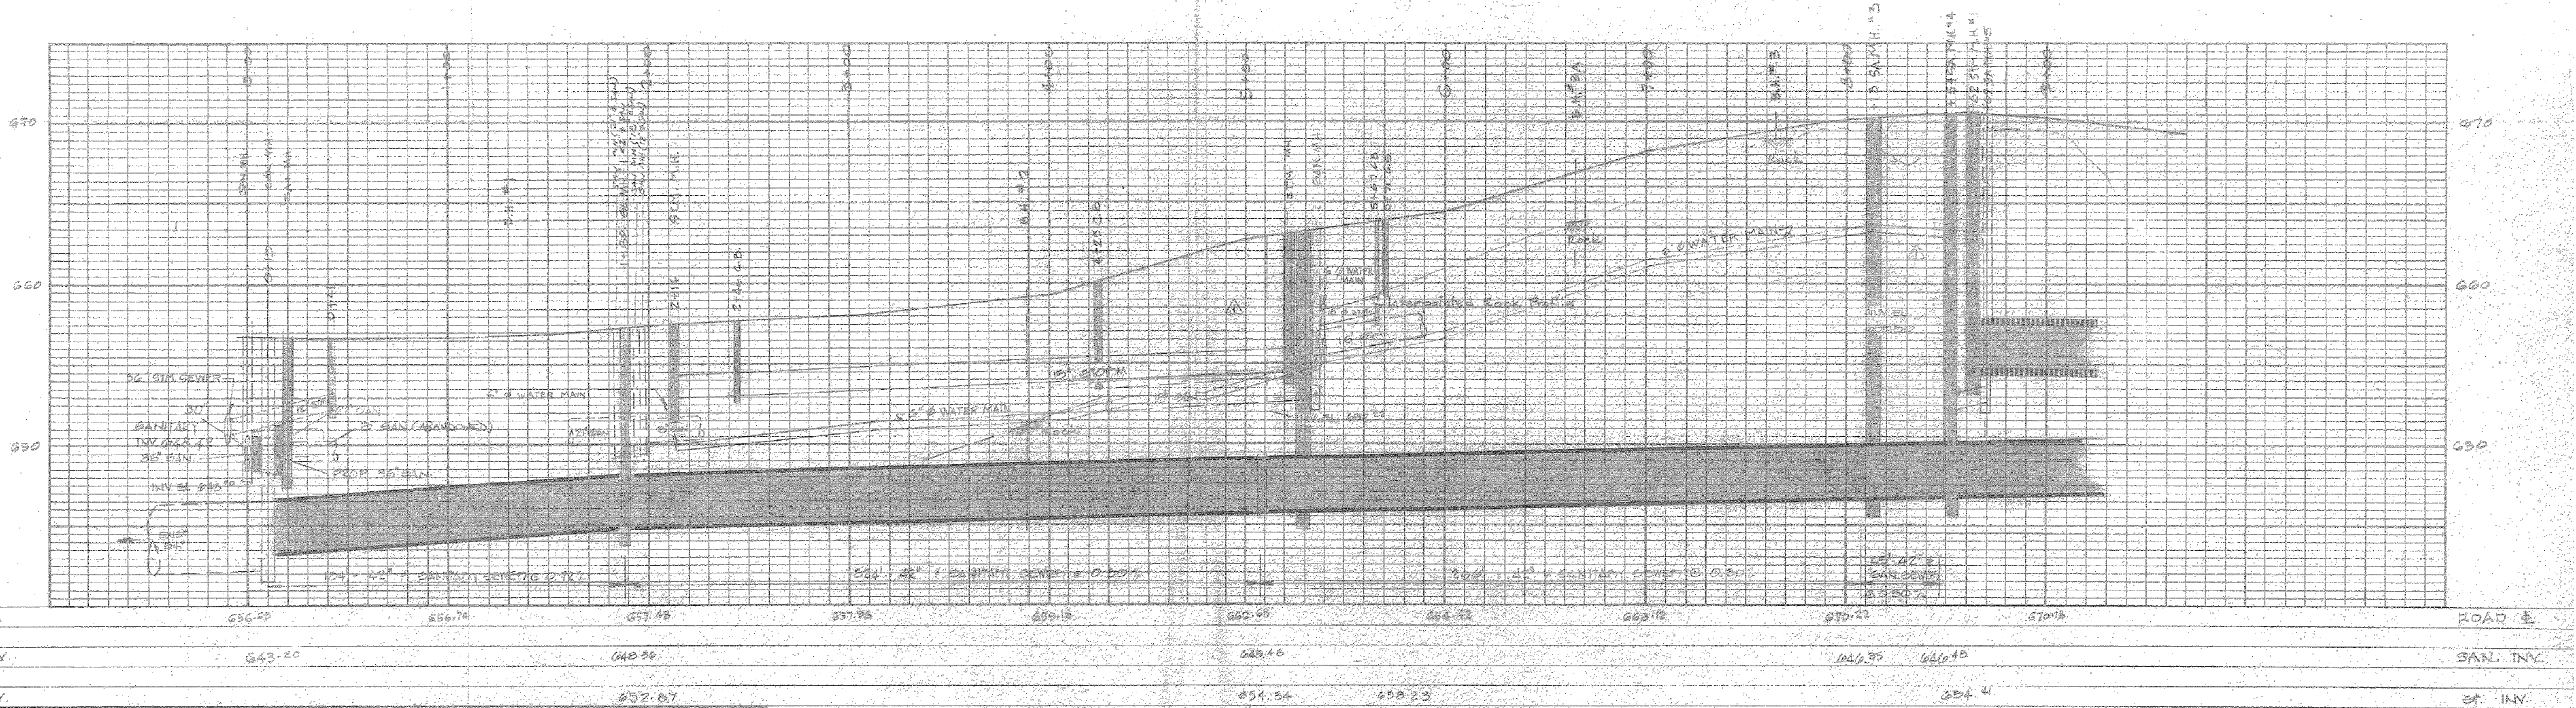


DISCLAIMER

The information contained on this drawing may be based upon data provided by others and may not have been verified by either as-constructed drawings or an Ontario Land Surveyor. The City of North Bay cannot accept responsibility for any errors or omissions on any information shown herein. Field verification, land surveys or excavation (with City approval) may be required to determine actual location of any and all utilities or property lines.

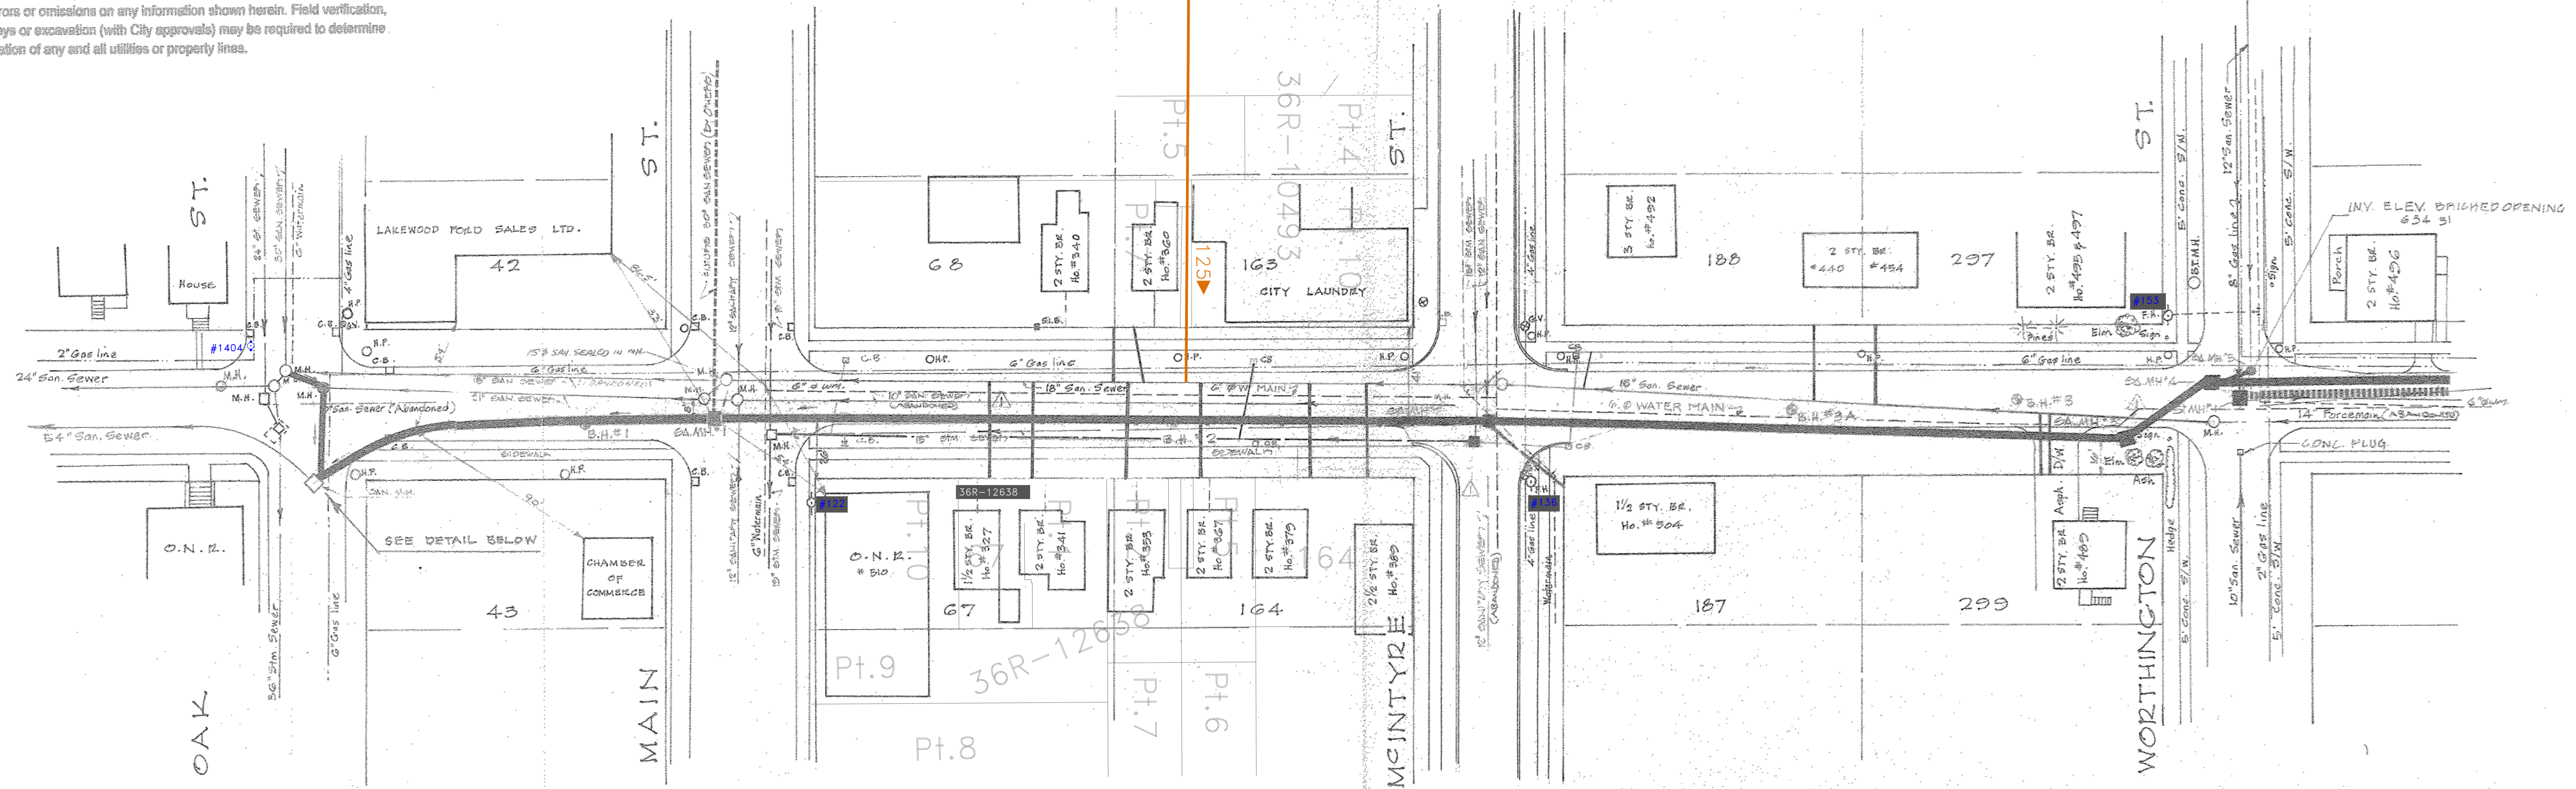

CITY OF NORTH BAY			
CHIPPEWA VALLEY TRUNK SEWER			
REGINA STREET			
OAK ST TO WORTHINGTON ST.			
CONTRACT A			
3 B.W. AS CONSTRUCTED		NOV 27 '74	DWN. BY J.C.F. + Z.W.
3 B.W. SANITARY INTERCONNECTION AT OAK'S REGINA ST.		JULY 8 '74	CHKD. BY J.C.F.
3 B.W. SANITARY SEWER ALIGNMENT		JAN 7 '74	DATE NOVEMBER 1975
REVISIONS		APP.	DATE
3 B.W. AS CONSTRUCTED		NOV 27 '74	DWN. BY J.C.F. + Z.W.
3 B.W. SANITARY INTERCONNECTION AT OAK'S REGINA ST.		JULY 8 '74	CHKD. BY J.C.F.
3 B.W. SANITARY SEWER ALIGNMENT		JAN 7 '74	DATE NOVEMBER 1975
SCALE: 1" = 40'		SCALE: 1" = 40'	

Northland Engineering Ltd.
CONSULTING CIVIL ENGINEERS
NORTH BAY - SUDBURY - TORONTO

No C-951
1121-2