

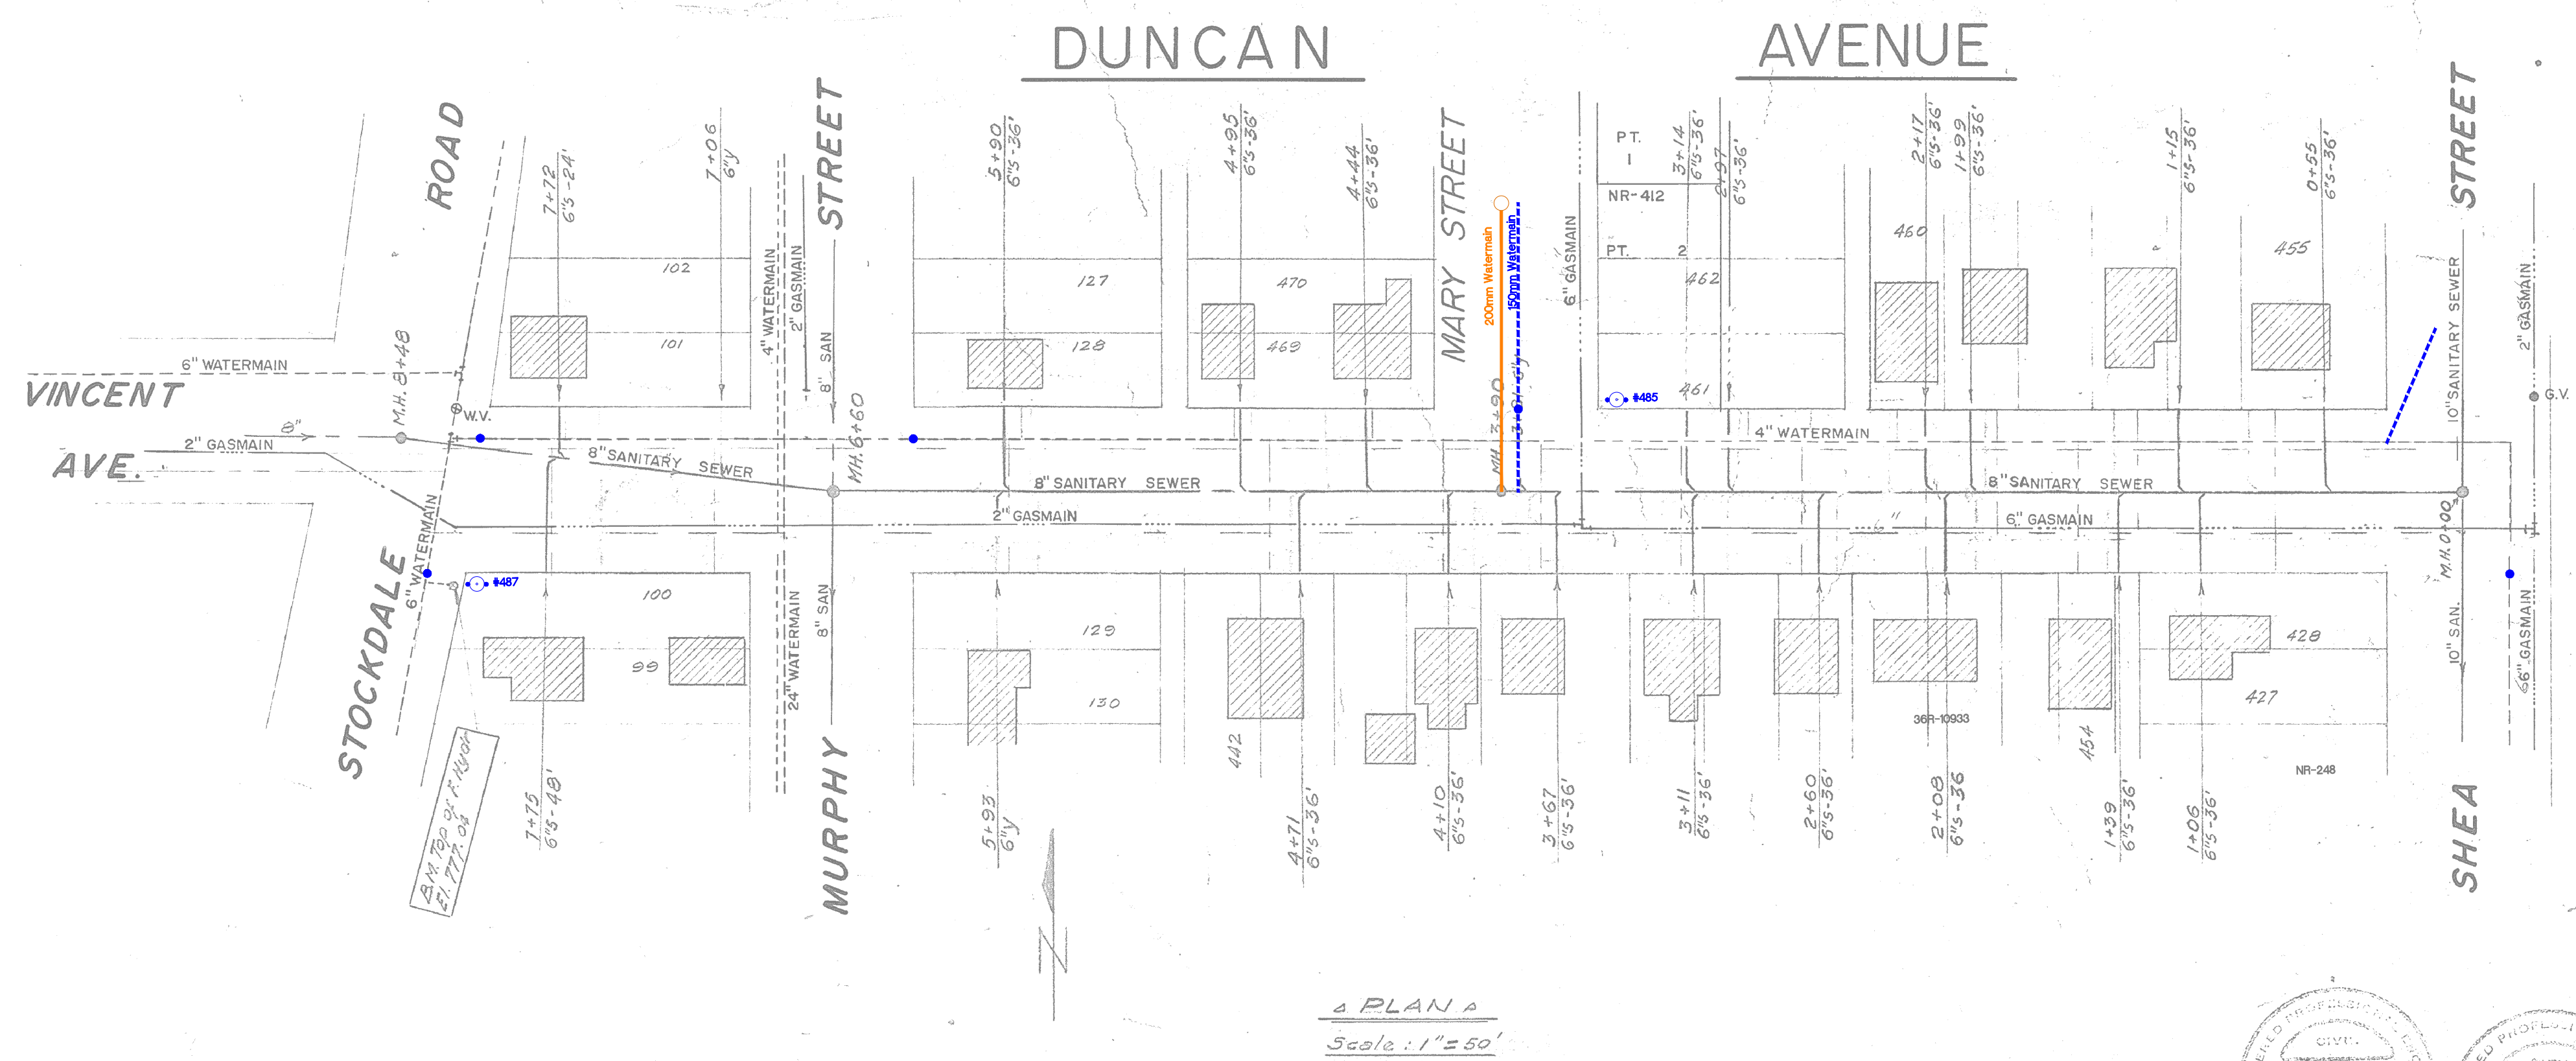


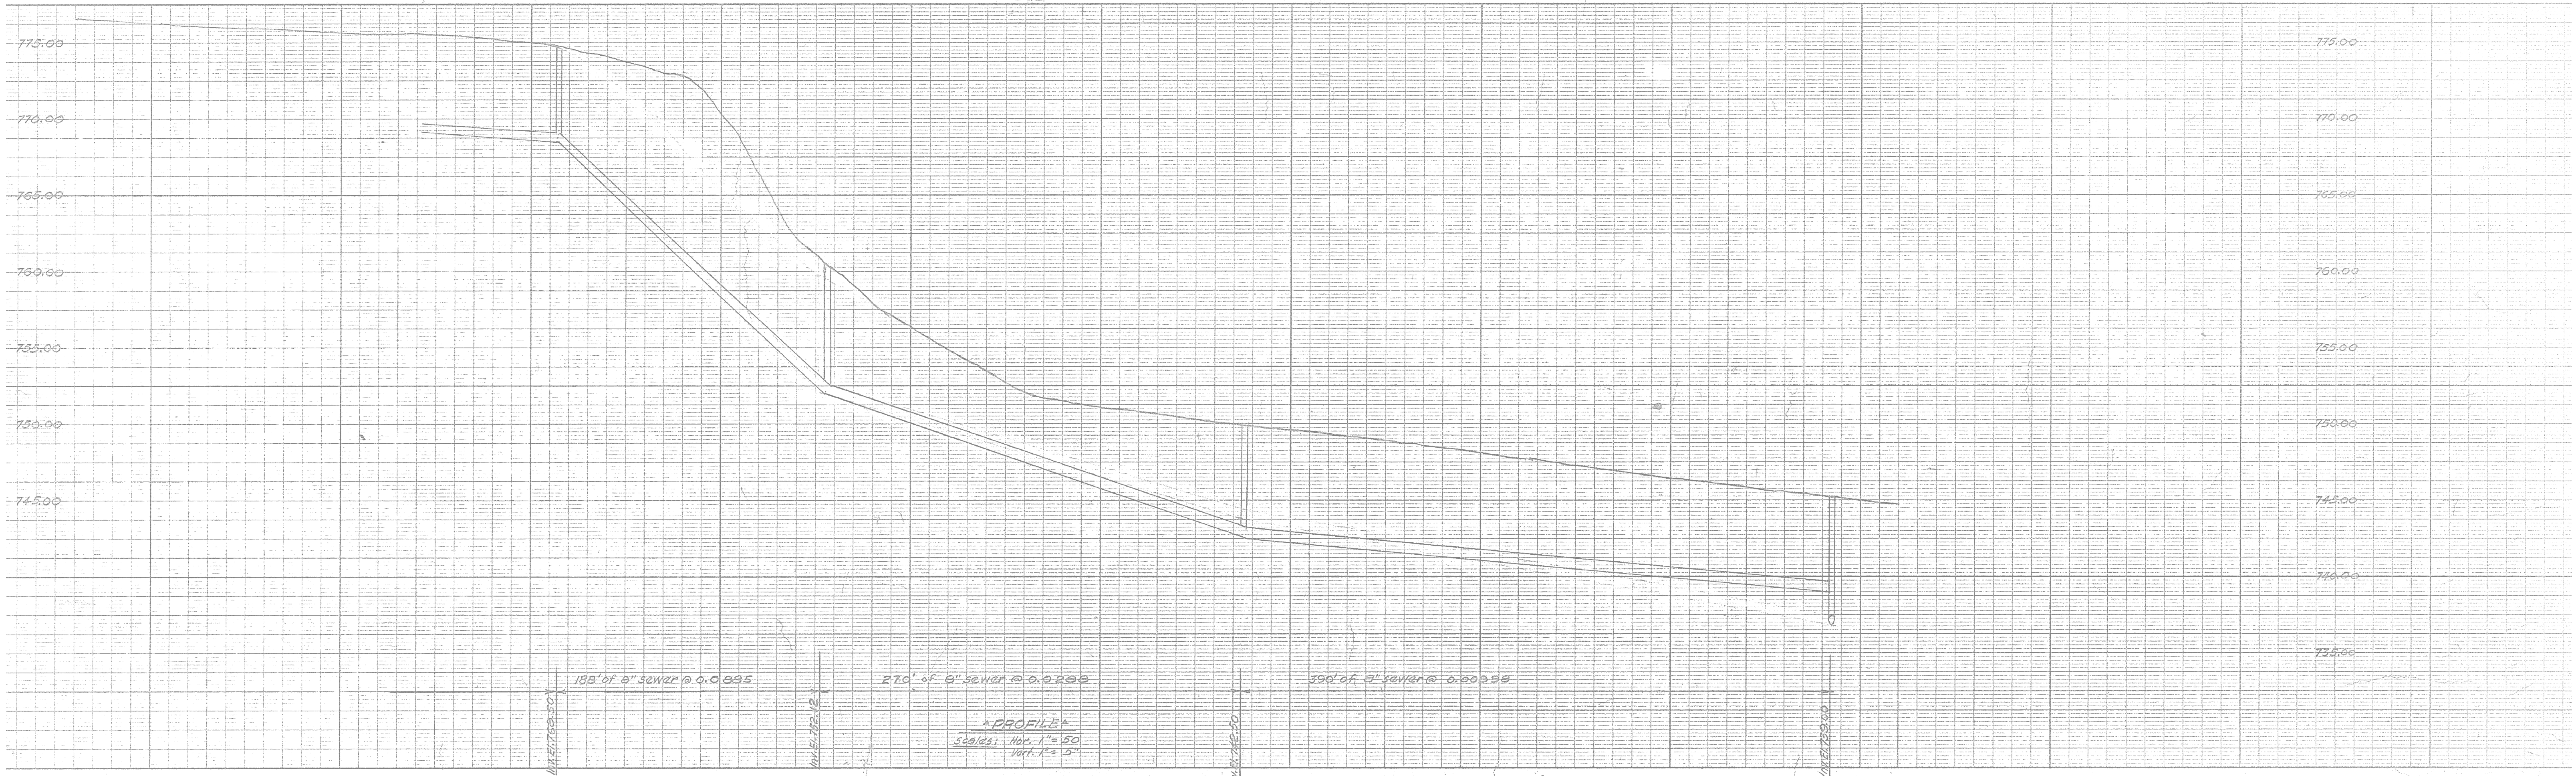

PLAN A
Scale: 1" = 50'

DISCLAIMER
The information contained on this drawing may be based upon data provided by others and may not have been verified by either as-constructed drawings or an Ontario Land Surveyor. The City of North Bay cannot accept responsibility for any errors or omissions on any information shown herein. Field verification, land surveys or excavation (with City approvals) may be required to determine actual location of any and all utilities or property lines.

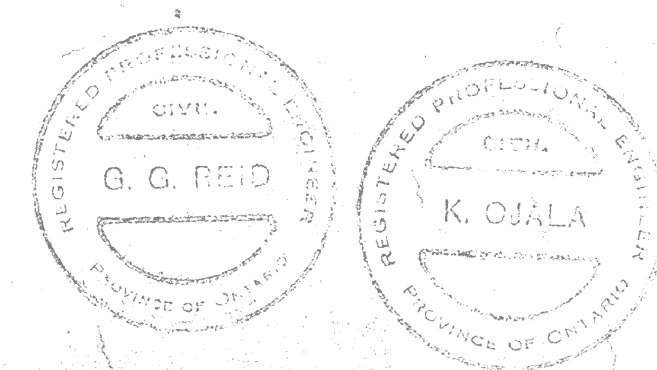

LEGEND & NOTE: See Dwg. N° 156

REVISIONS	
Dec. 28/60	As constructed
April 11	Removed Watermain from Shear North, as per P/W

TWP of WIDDIFIELD	
Mr. A. Carmichael Clark Treasurer North Bay	Graham Reid & Associates Ltd. Consulting Engineers Toronto, Ontario
DUNCAN AVE	
STOCKDALE RD. TO SHEAR STREET	
No. 184	Scale: As Shown
Date: April 25, 60	Signature: [Signature] Signature: [Signature]

D-176