
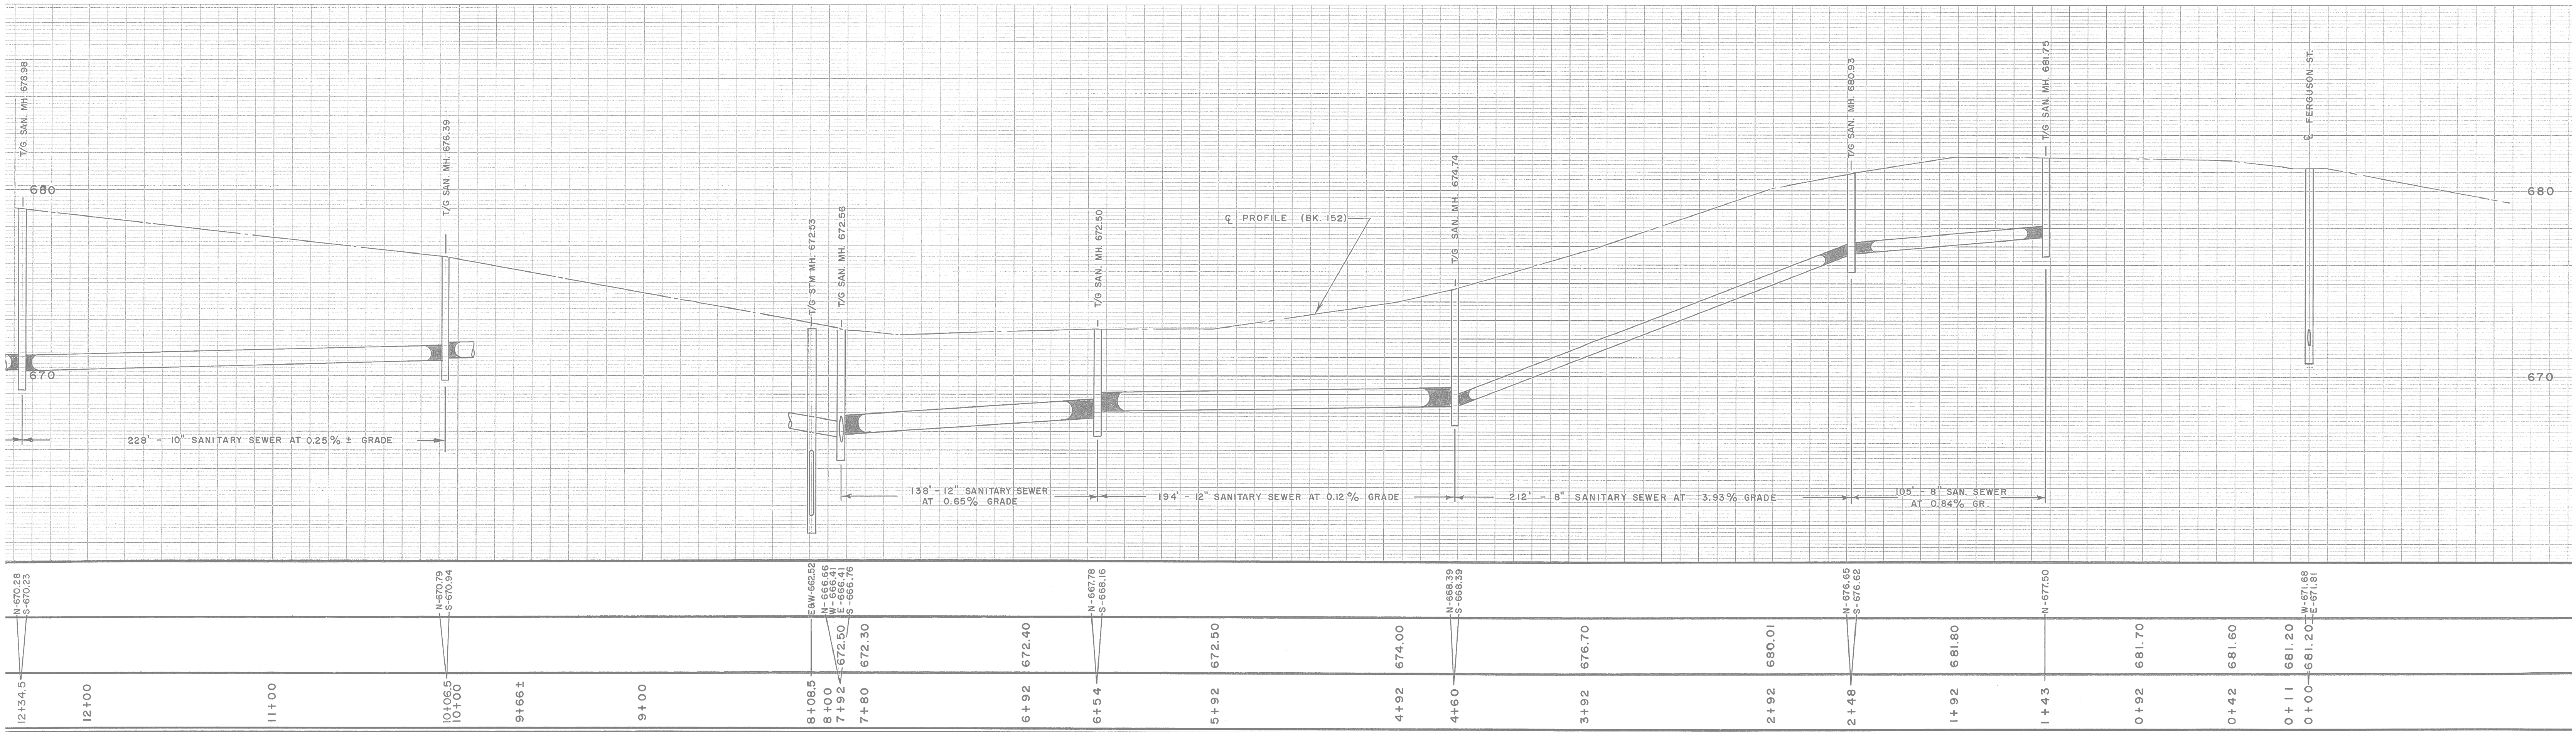


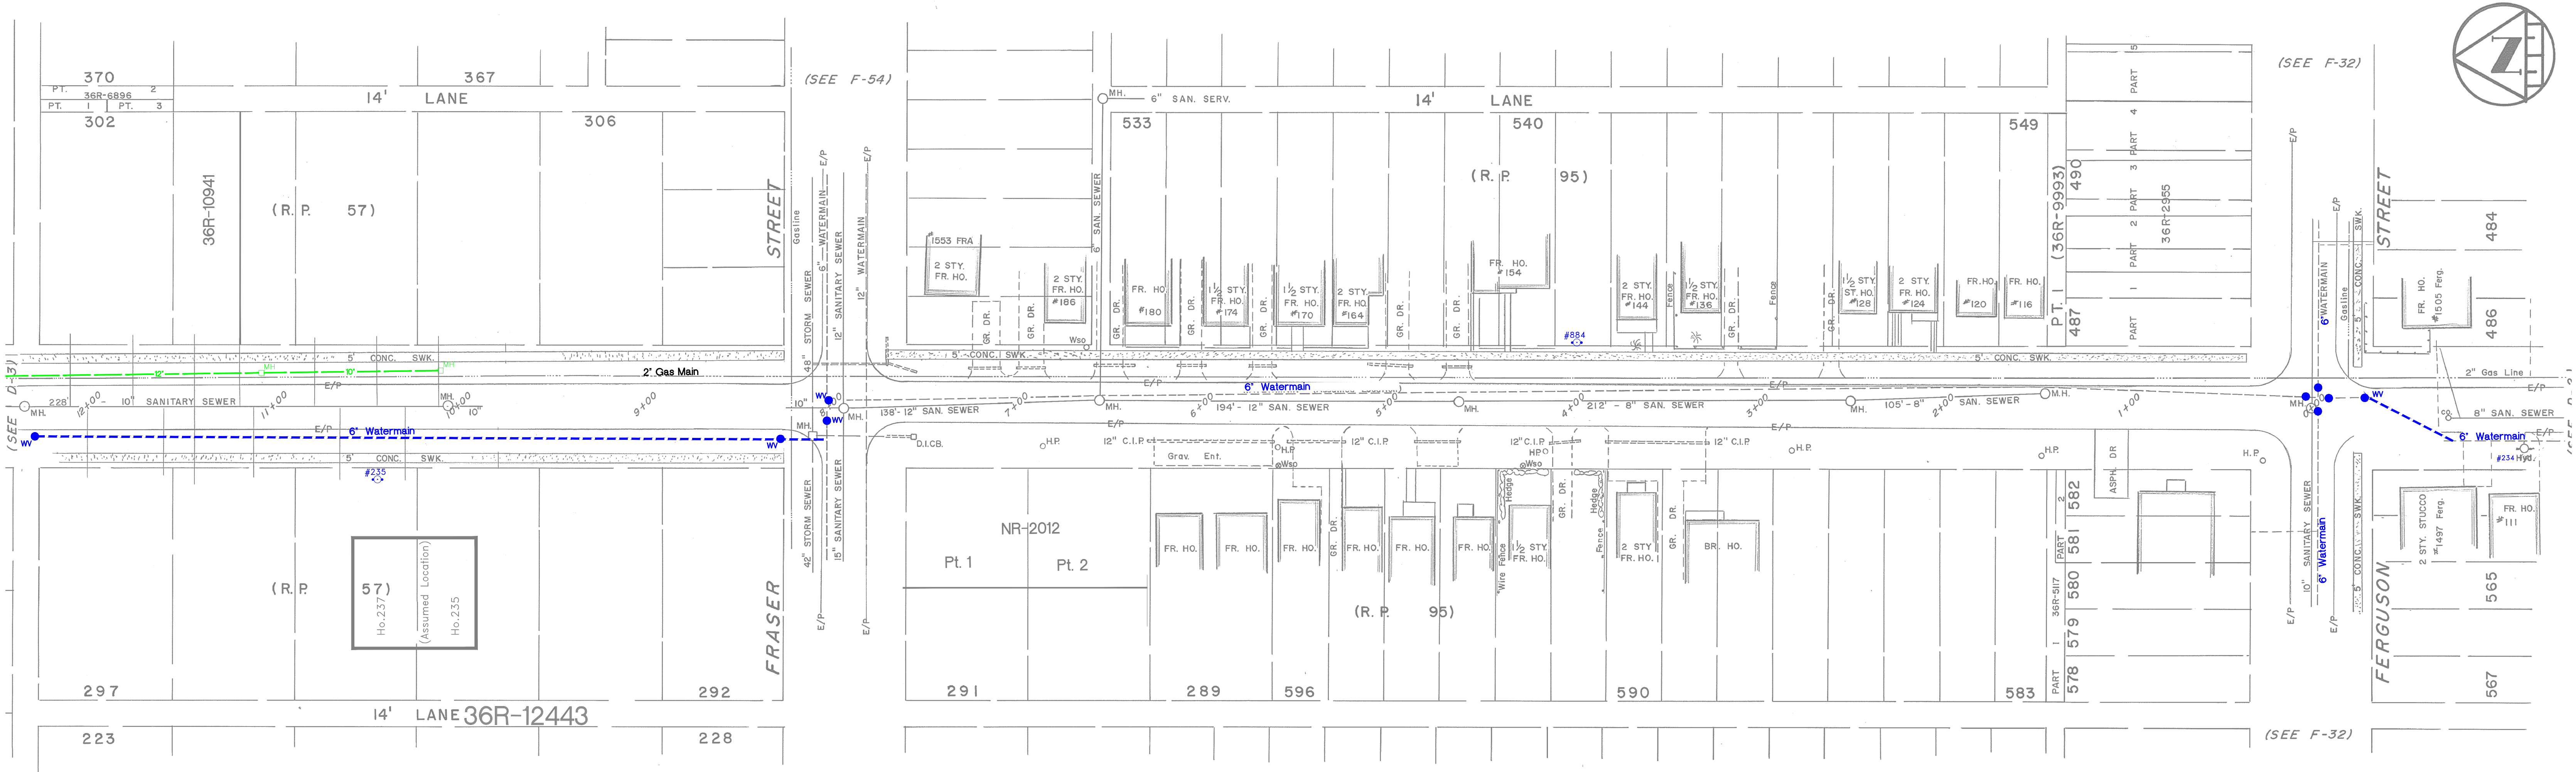

NOTES:		APPROVED		DUKE STREET FERGUSON ST. TO CASSELLS ST. REG. PLAN Nos. 57, 95		CITY OF NORTH BAY ENGINEERING AND WORKS	
DISCLAIMER						SCALE: 1" = 40' HOR. 1" = 4' VERT.	
The information contained on this drawing may be based upon data provided by others and may not have been verified by either as-constructed drawings or an Ontario Land Surveyor. The City of North Bay cannot accept responsibility for any errors or omissions on any information shown herein. Field verification, land surveys or excavation (with City approvals) may be required to determine actual location of any and all utilities or property lines.						DATE: NOV, 1990	
DRAWN BY: P.L.C.		FIELD BOOK No. 213, 215, 245		DRAWING No. D-2		REV	
C.D. BY:		276					