
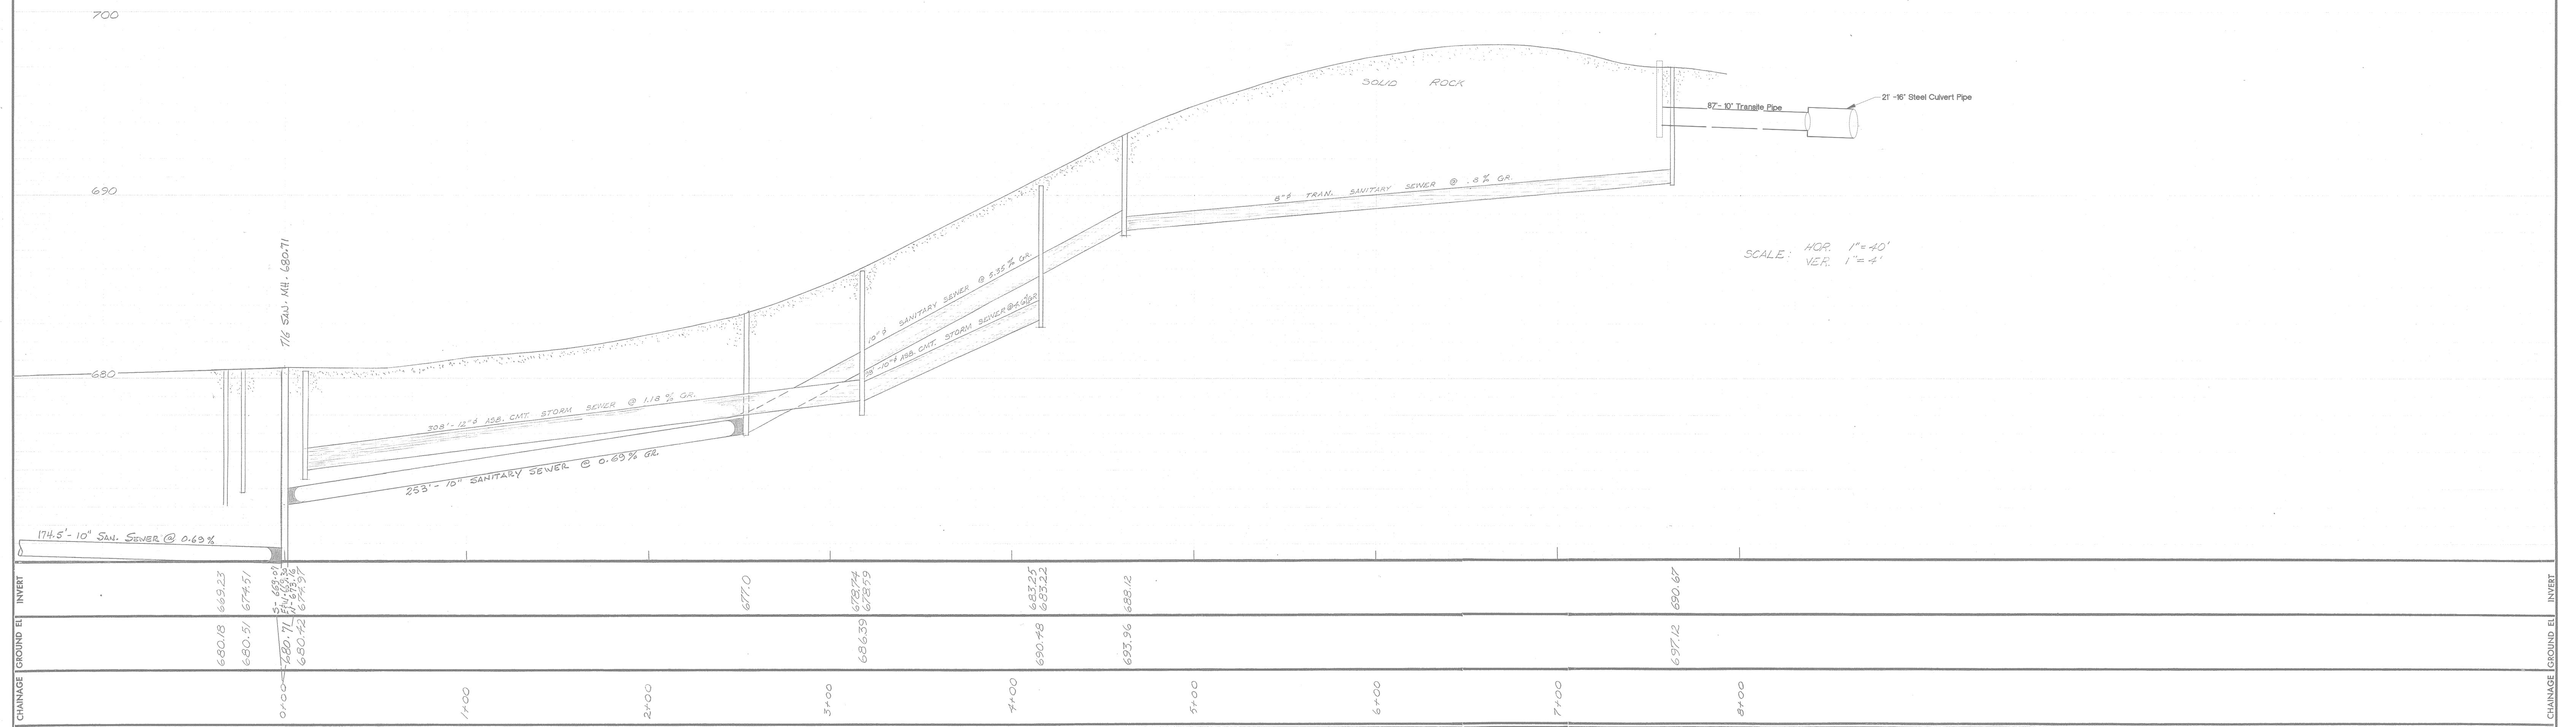


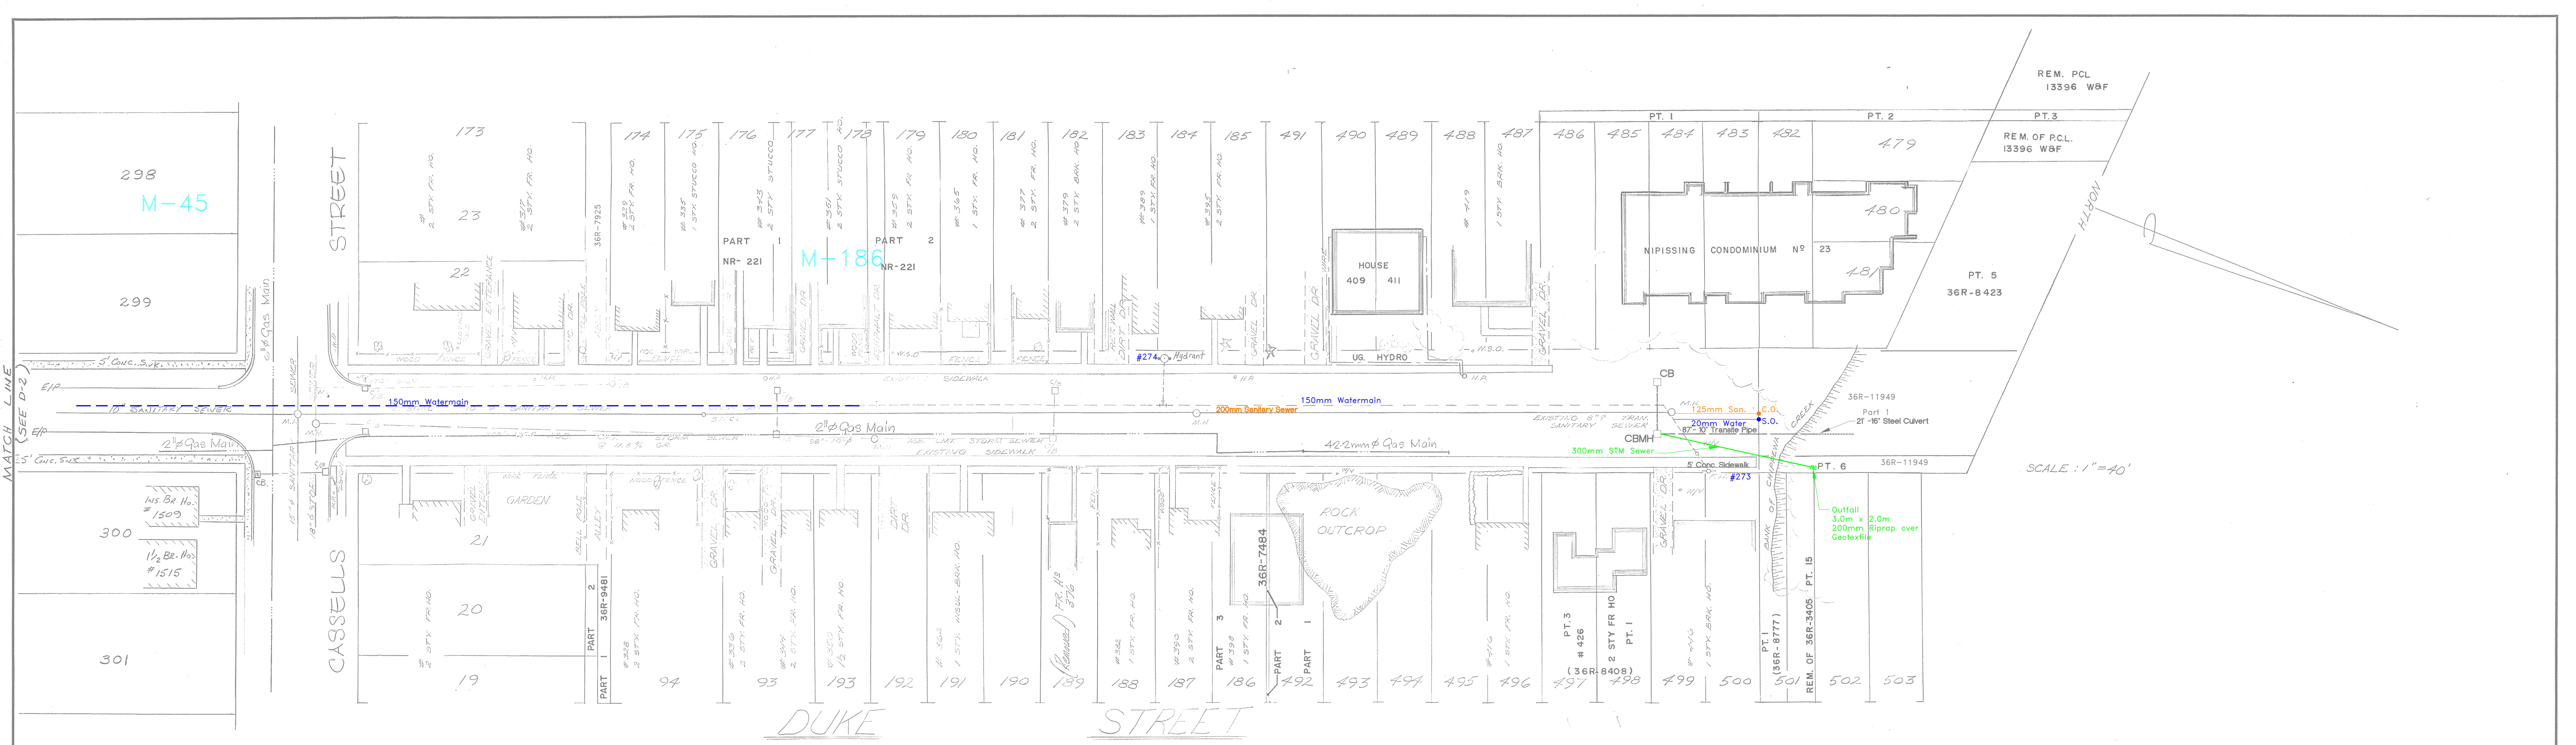

DWG. No.	NOTES:	DISCLAIMER The information contained on this drawing may be based upon data provided by others and may not have been verified by either as-constructed drawings or an Ontario Land Surveyor. The City of North Bay cannot accept responsibility for any errors or omissions on any information shown herein. Field verification, land surveys or excavation (with City approvals) may be required to determine actual location of any and all utilities or property lines. 				1		AS CONSTRUCTED				APPROVED		DUKE STREET 0+00 = @ CASSELLS STREET - CHAINED NORTH		CITY OF NORTH BAY ENGINEERING DEPARTMENT	
	2.					UG. HYDRO TO HOUSE 409-411		JULY 78		J.D.							
	3.					6", 2" : 4x2mm Gas Mains		JAN/82		B.D.							