
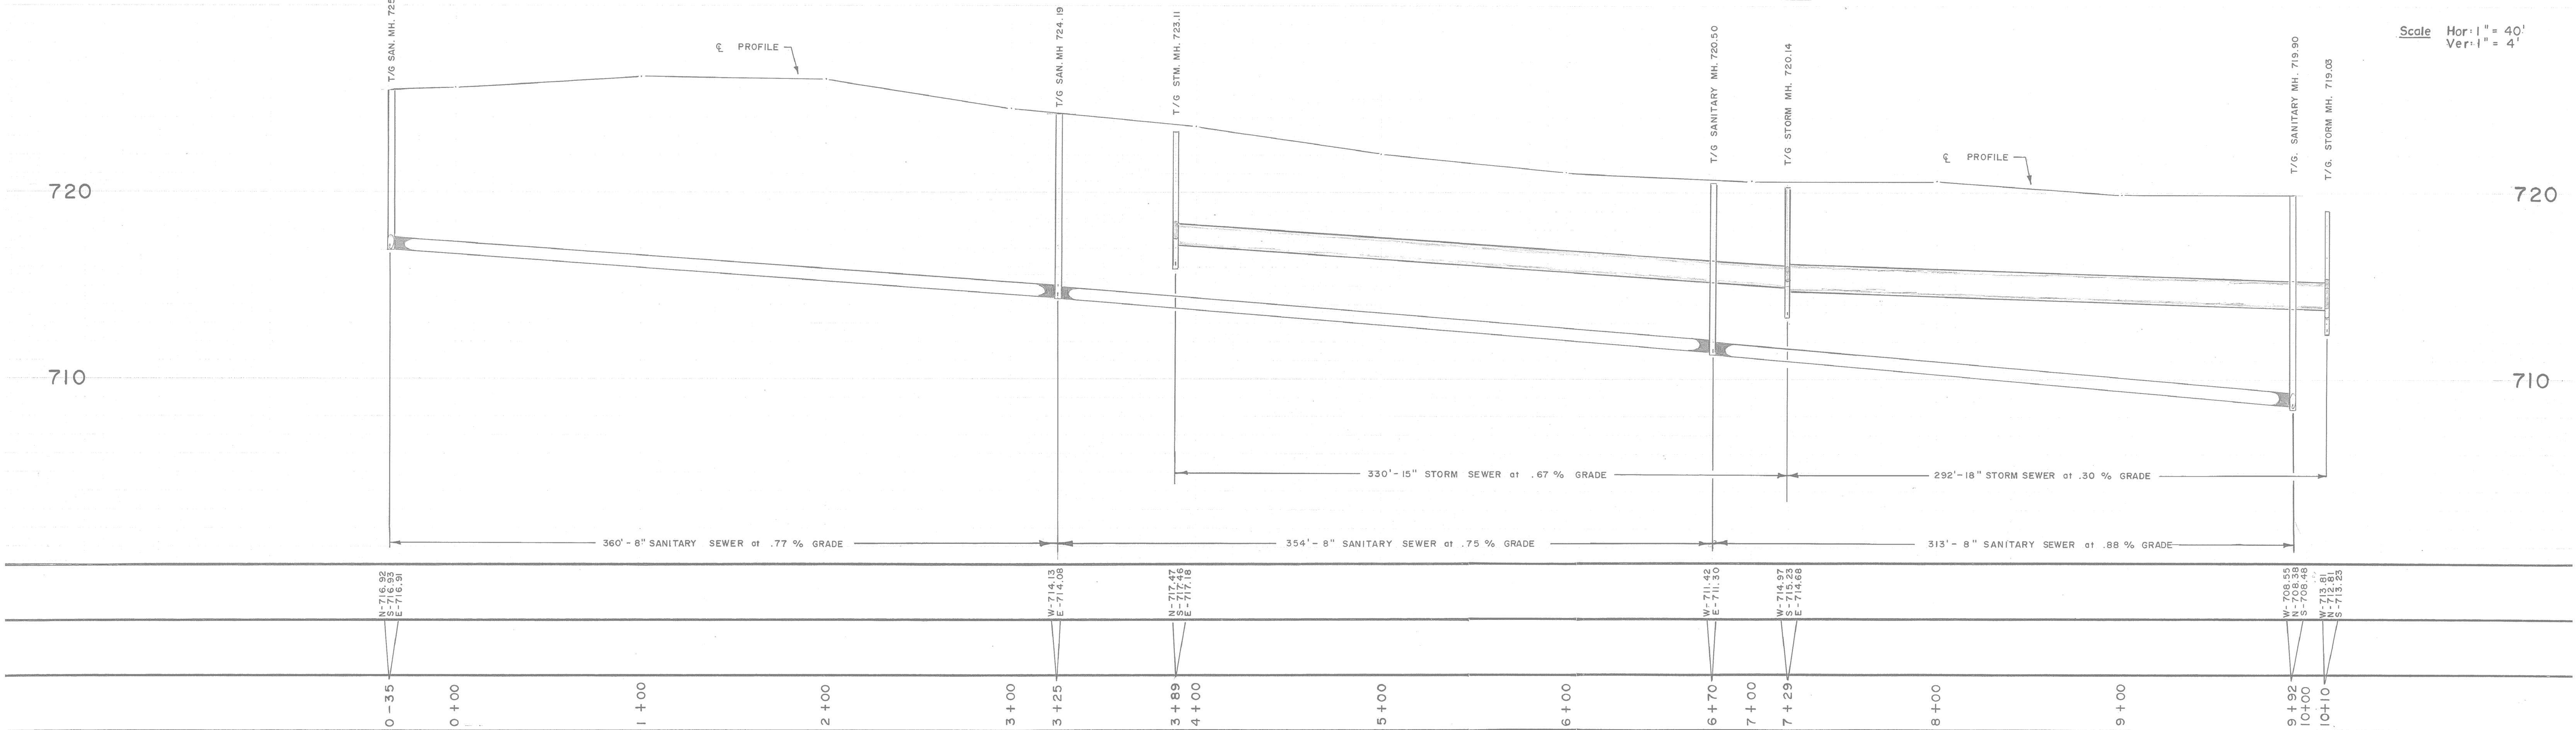


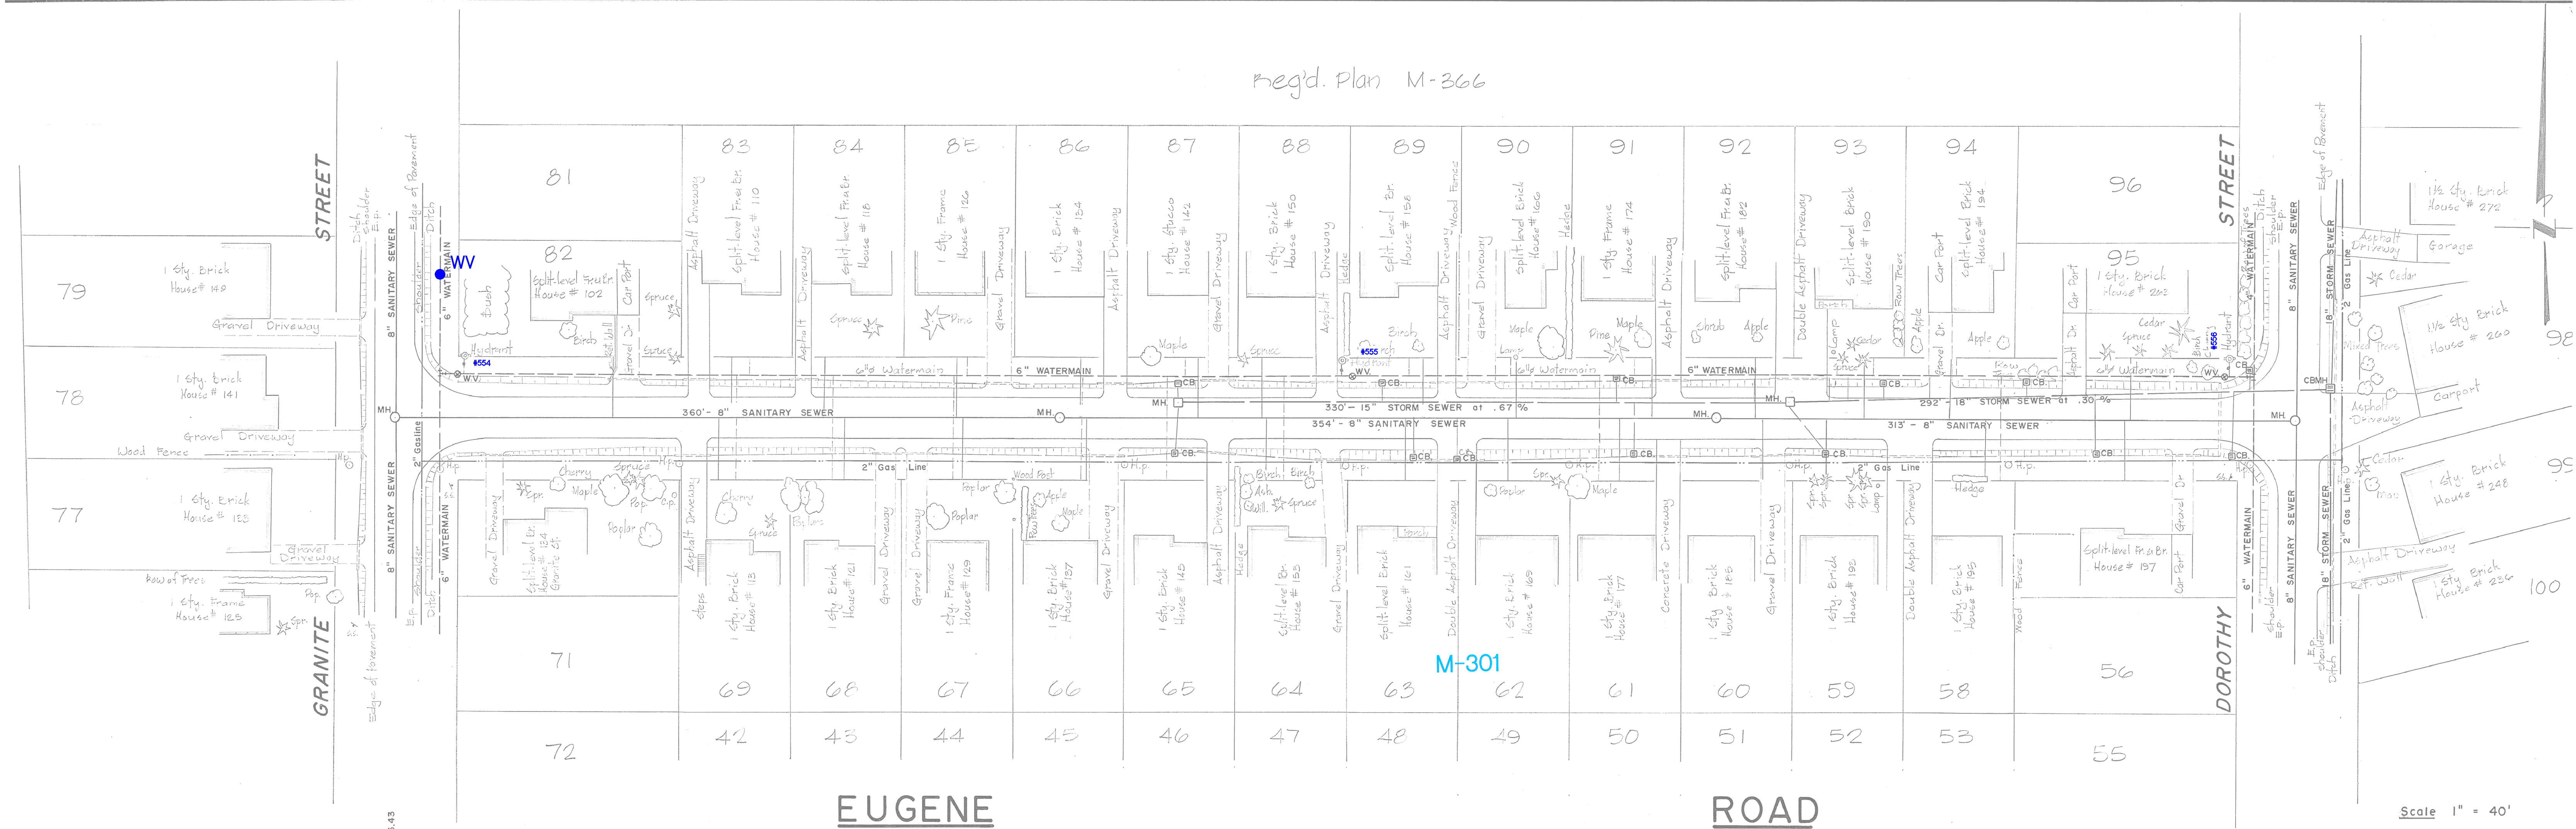

NOTES:

DISCLAIMER

The information contained on this drawing may be based upon data provided by others and may not have been verified by either as-constructed drawings or an Ontario Land Surveyor. The City of North Bay cannot accept responsibility for any errors or omissions on any information shown herein. Field verification, land surveys or excavation (with City approvals) may be required to determine actual location of any and all utilities or property lines.

2.	AS CONSTRUCTED STORM	MAY / 76	j.d.m.
No.	REVISION	DATE	INITIAL

APPROVED

EUGENE ROAD

GRANITE STREET to DOROTHY STREET

REG'D PLAN - M-301

CITY OF NORTH BAY

ENGINEERING DEPARTMENT

SCALE: AS SHOWN

DATE: MARCH 72

DRAWN BY:

FIELD BOOK No. 218

DRAWING No. E-176

REV.