



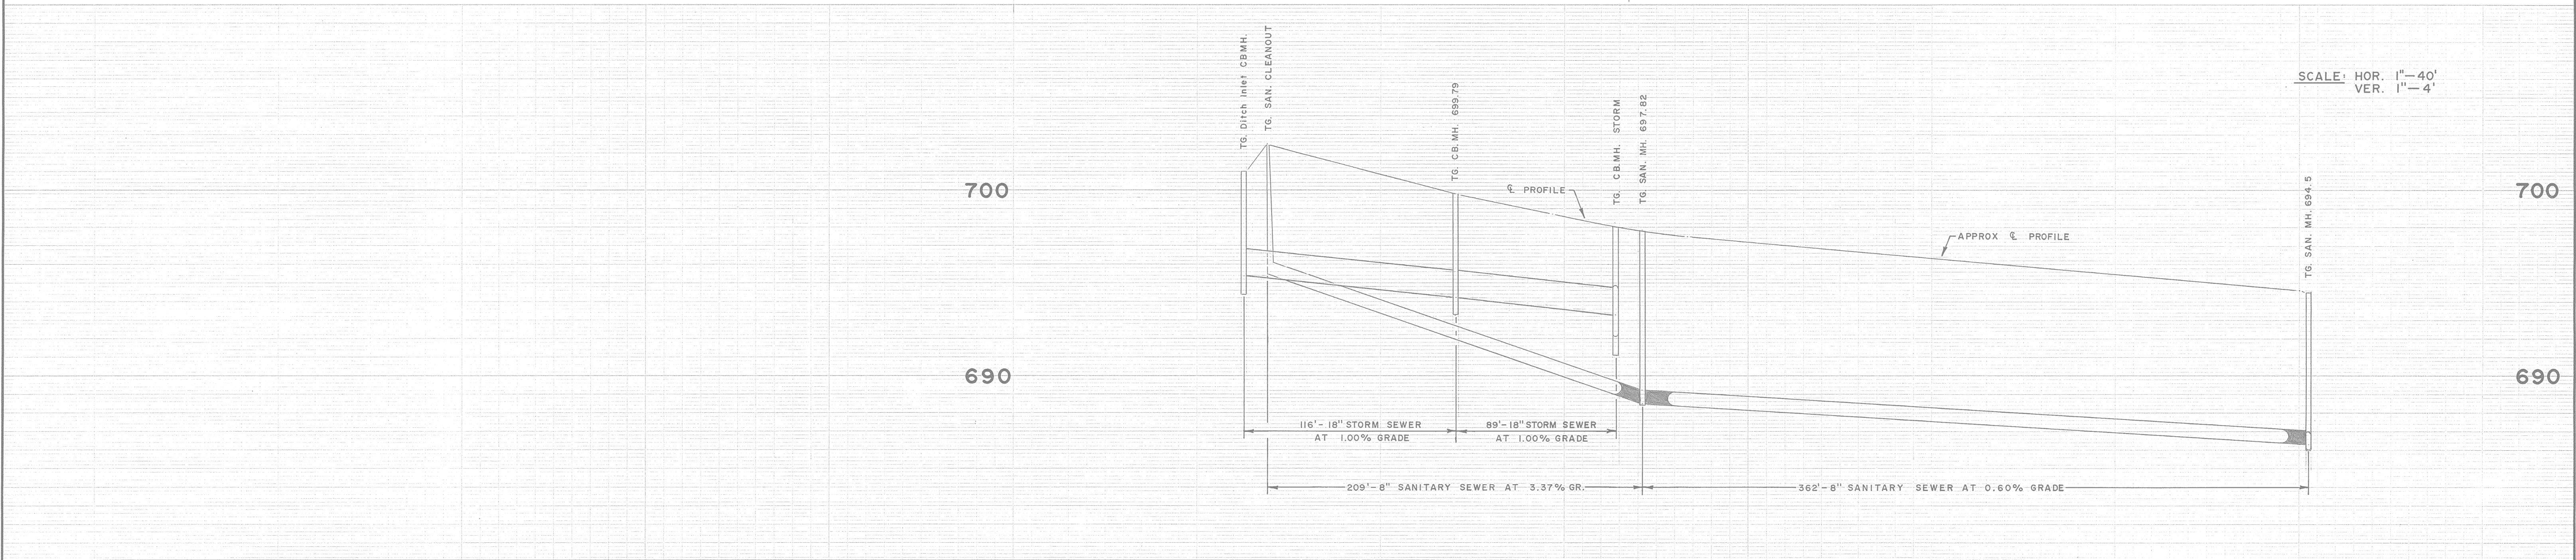

NOTES:

DISCLAIMER

The information contained on this drawing may be based upon data provided by others and may not have been verified by either as-constructed drawings or an Ontario Land Surveyor. The City of North Bay cannot accept responsibility for any errors or omissions on any information shown herein. Field verification, land surveys or excavation (with City approvals) may be required to determine actual location of any and all utilities or property lines.

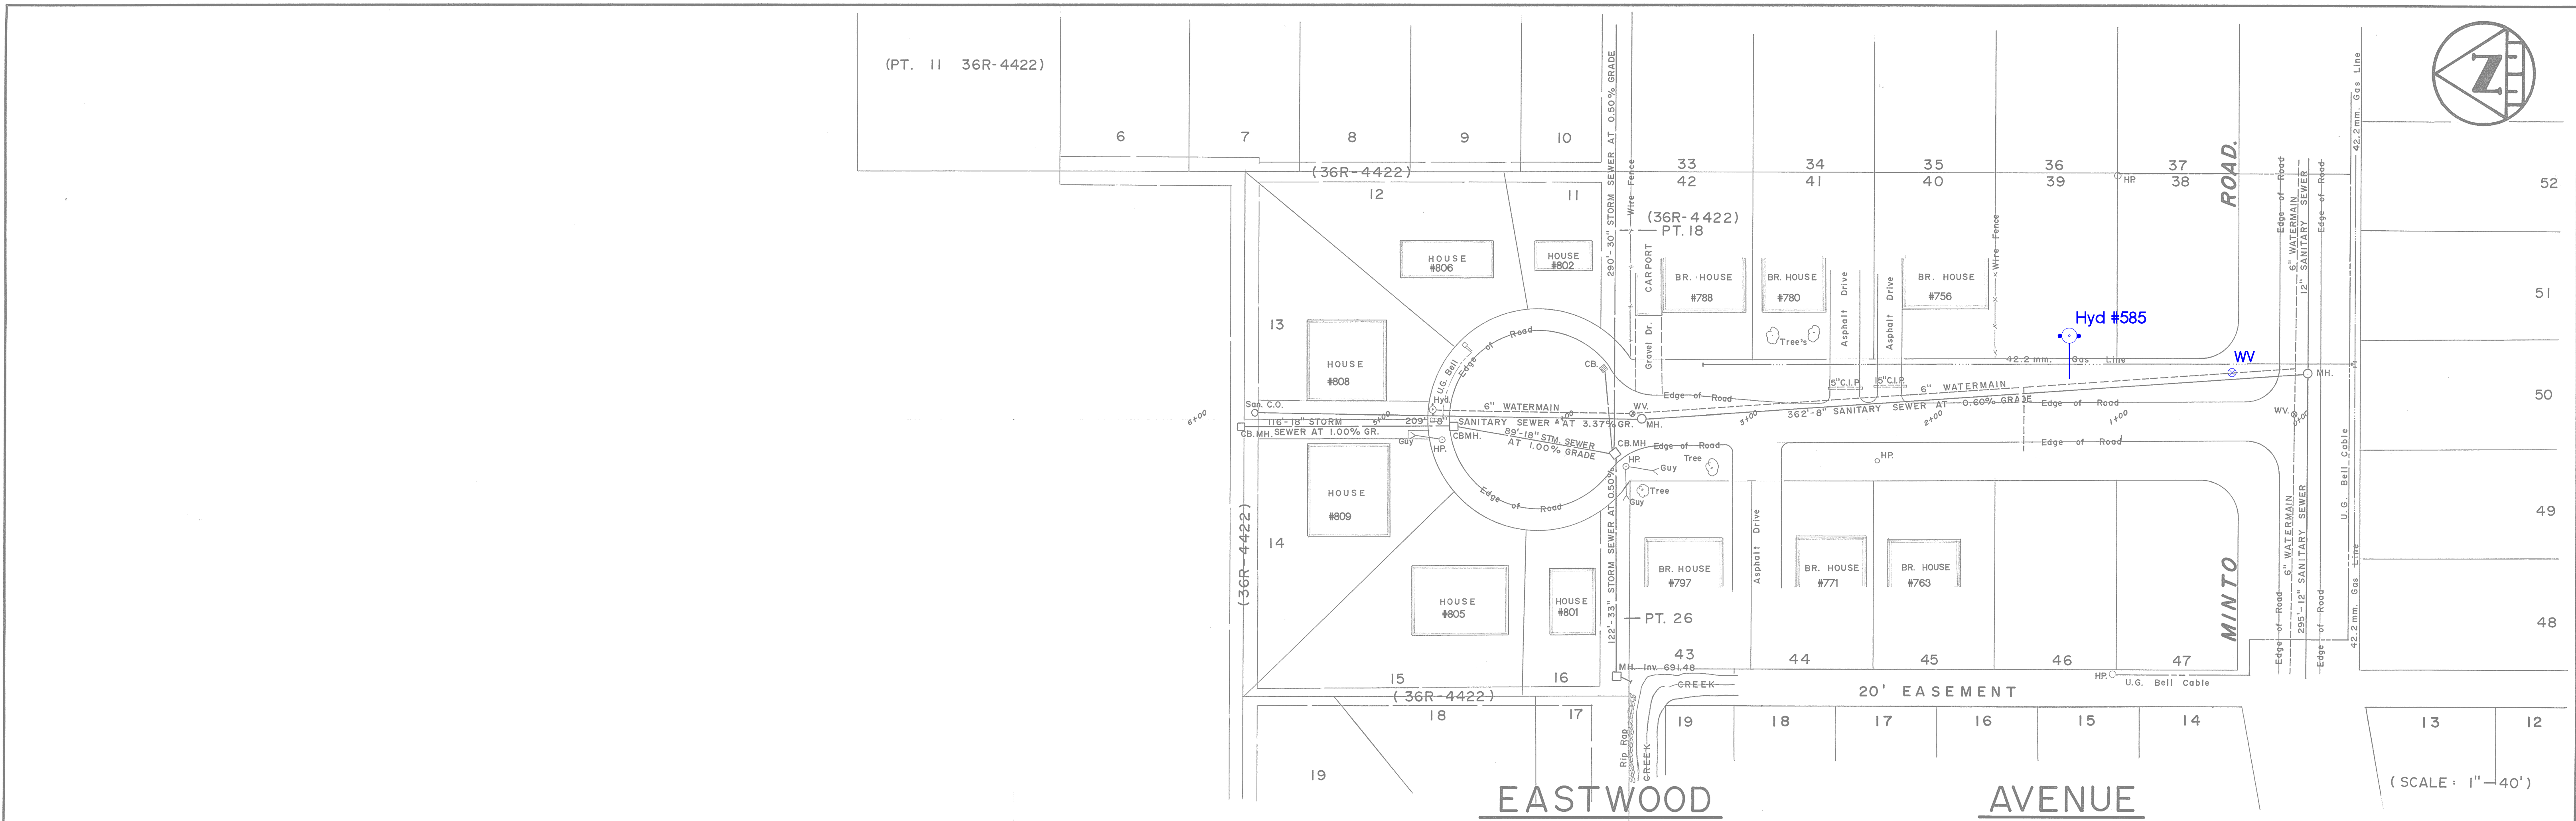

No.	REVISION	DATE	INITIAL
1.	U.G. Bell Cable.	MAY 82	A.P.
2.	Gas Line	JUNE 82	A.P.
3.	Hydrant location change/house nos. added.	Oct. 07	r.j.o.

APPROVED

EASTWOOD AVENUE

MINTO ROAD TO END OF ROAD.

Reg'd. Plan N^o. M-287, M-350, M-500, 36R-4422

CITY OF NORTH BAY

ENGINEERING DEPARTMENT

SCALE: AS SHOWN DATE: JAN. 1978

DRAWN BY: Rick B. CKD. BY:

FIED BOOK No. Hillview Park Sub'd

DRAWING No.

E - 276