


GAS PLANT APPROVED	CATV PLANT APPROVED
<i>R. Anderson</i> 8/29/85	<i>Bruce Lawrence</i> 3/4/85
Northern & Central Gas Corp. Ltd.	McLean-Hunter Cable T.V. Ltd.
HYDRO PLANT APPROVED	BELL PLANT APPROVED
<i>A. Hume</i> 8-25-85	<i>Major Bradley</i> 8/2/85
North Bay Hydro	Bell Canada Ltd.

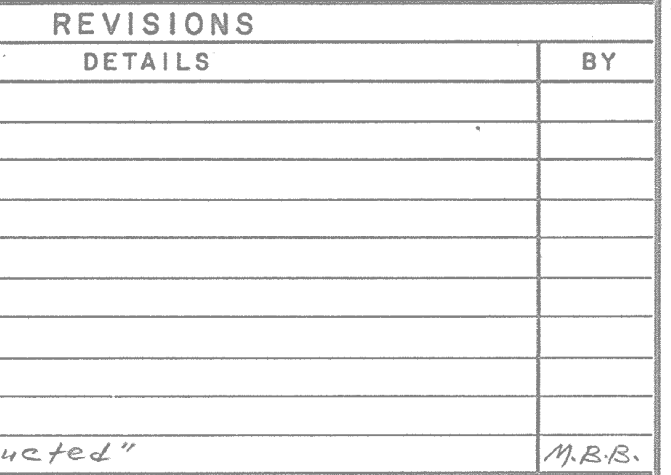

REVISIONS					
DATE		DETAILS			BY
6					
5					
4	June 8/92	"As Constructed"			M.B.B.
3					
2					
1					
		RECOMMENDED BY		APPROVED BY	
LAURENTIAN HEIGHTS LTD.					
ELLENDALE SUBDIVISION STAGE I					
PLAN AND PROFILE STA. 1+000 TO STA. 1+253					
NORTHLAND ENGINEERING LTD. Consulting Engineers and Planners					
NORTH BAY		SUDBURY		TIMMINS	
DRAWN BY:		S. C. P		DATE: AUG , 1985	
CHECKED BY:		M. B. B		FIELD BOOK:	
SCALE:		HORIZ. 1" = 500 VERT. 1" = 50		CONTRACT N°	
OFFICE		PROJECT N°		DRAWING N°	
NORTH BAY		2264		E-302	