
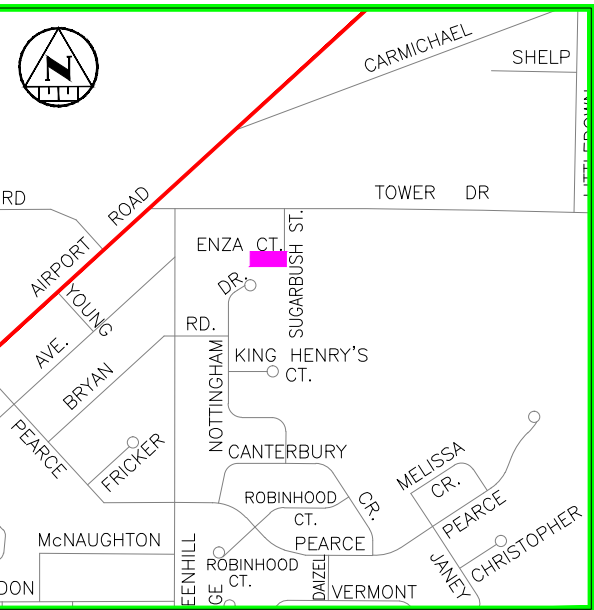


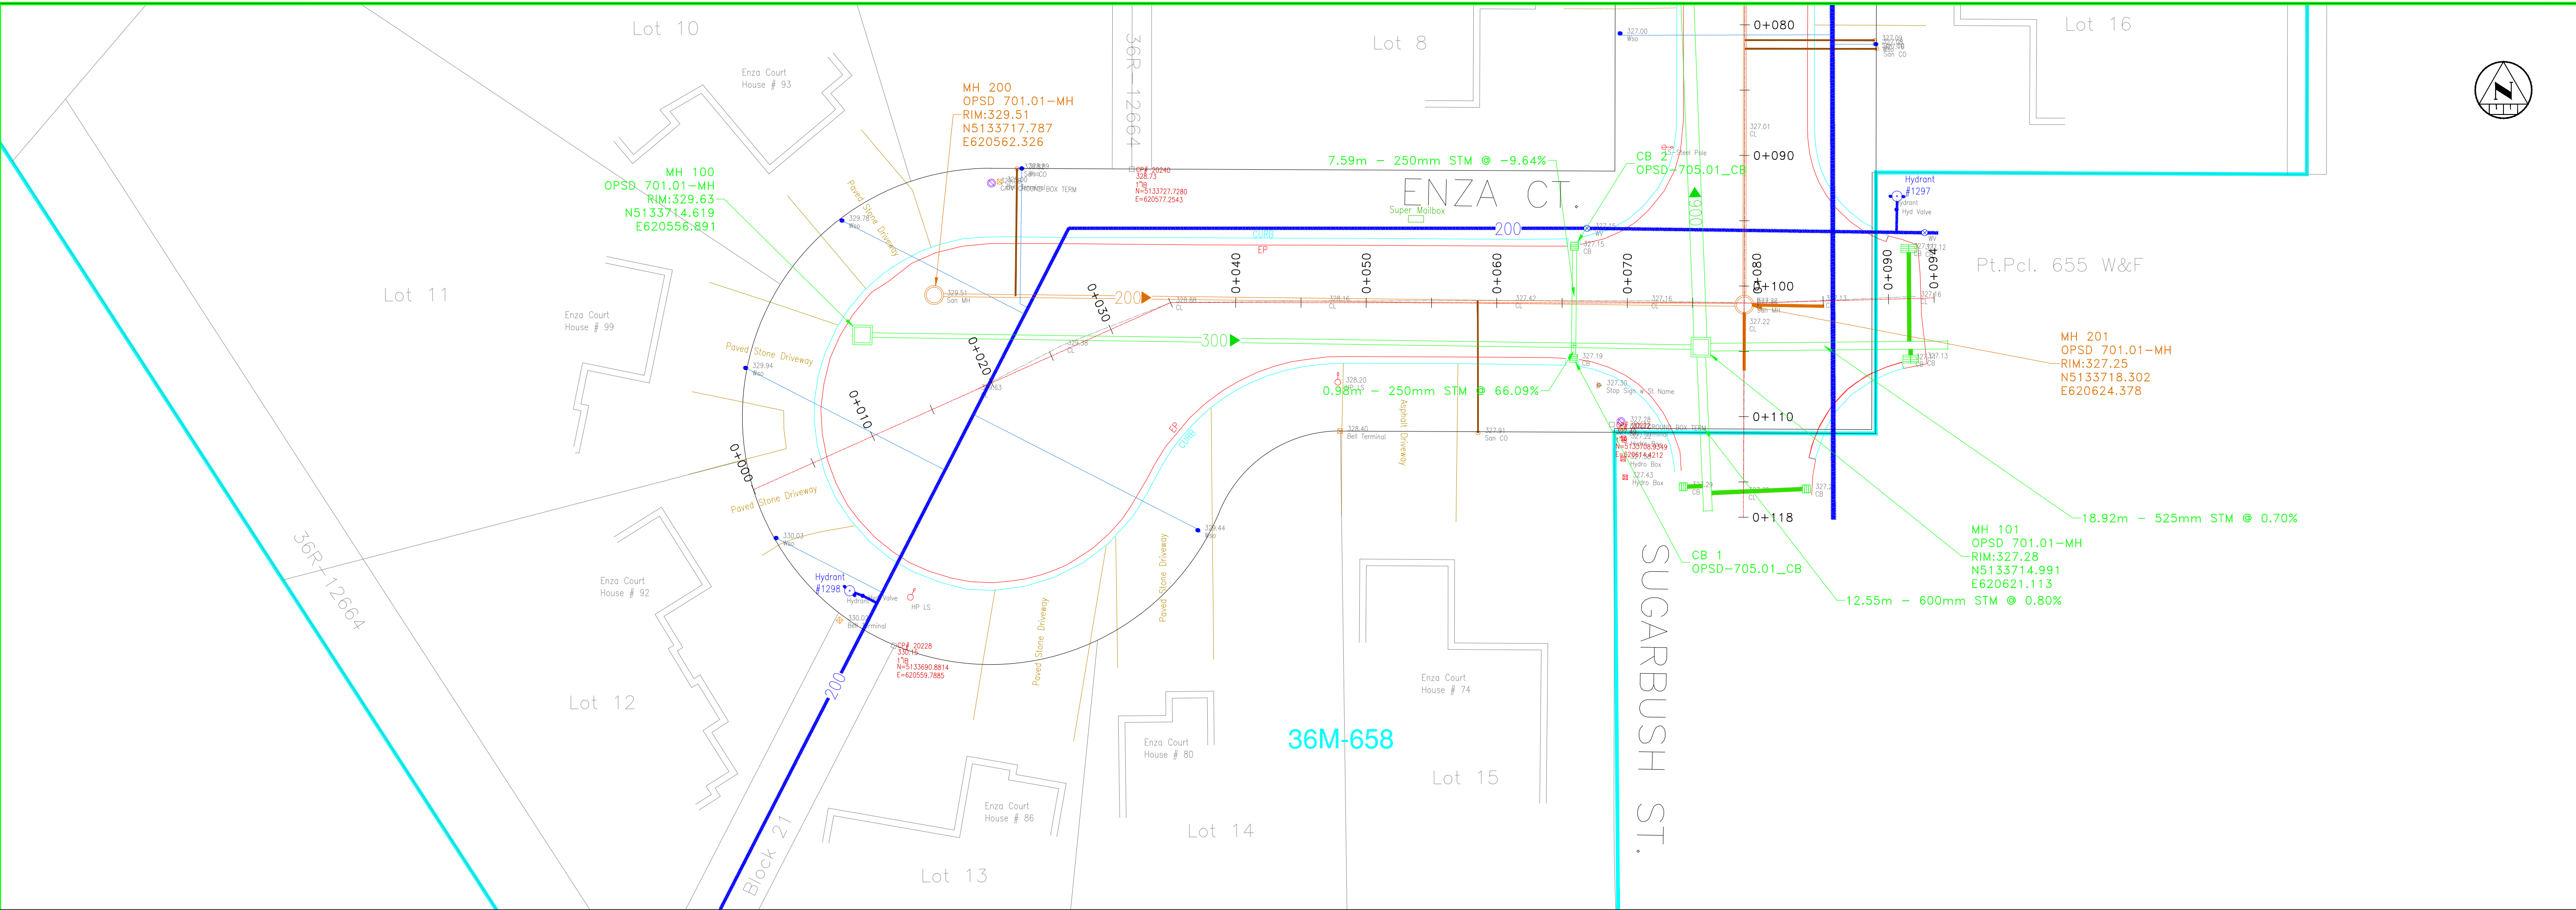

LEGEND

STORMWATER PIPE

SANITARY PIPE

WATERMAIN & VALVES

LOT / CONCESSION LINES

CB3

MH100

CBMH

MH200

EP


HYDRO POLL/LIGHT

END OF STORM PIPE

END OF SANITARY PIPE

REVISIONS

no.	date	by	description
1	Aug 01/13	GWC	As-Built

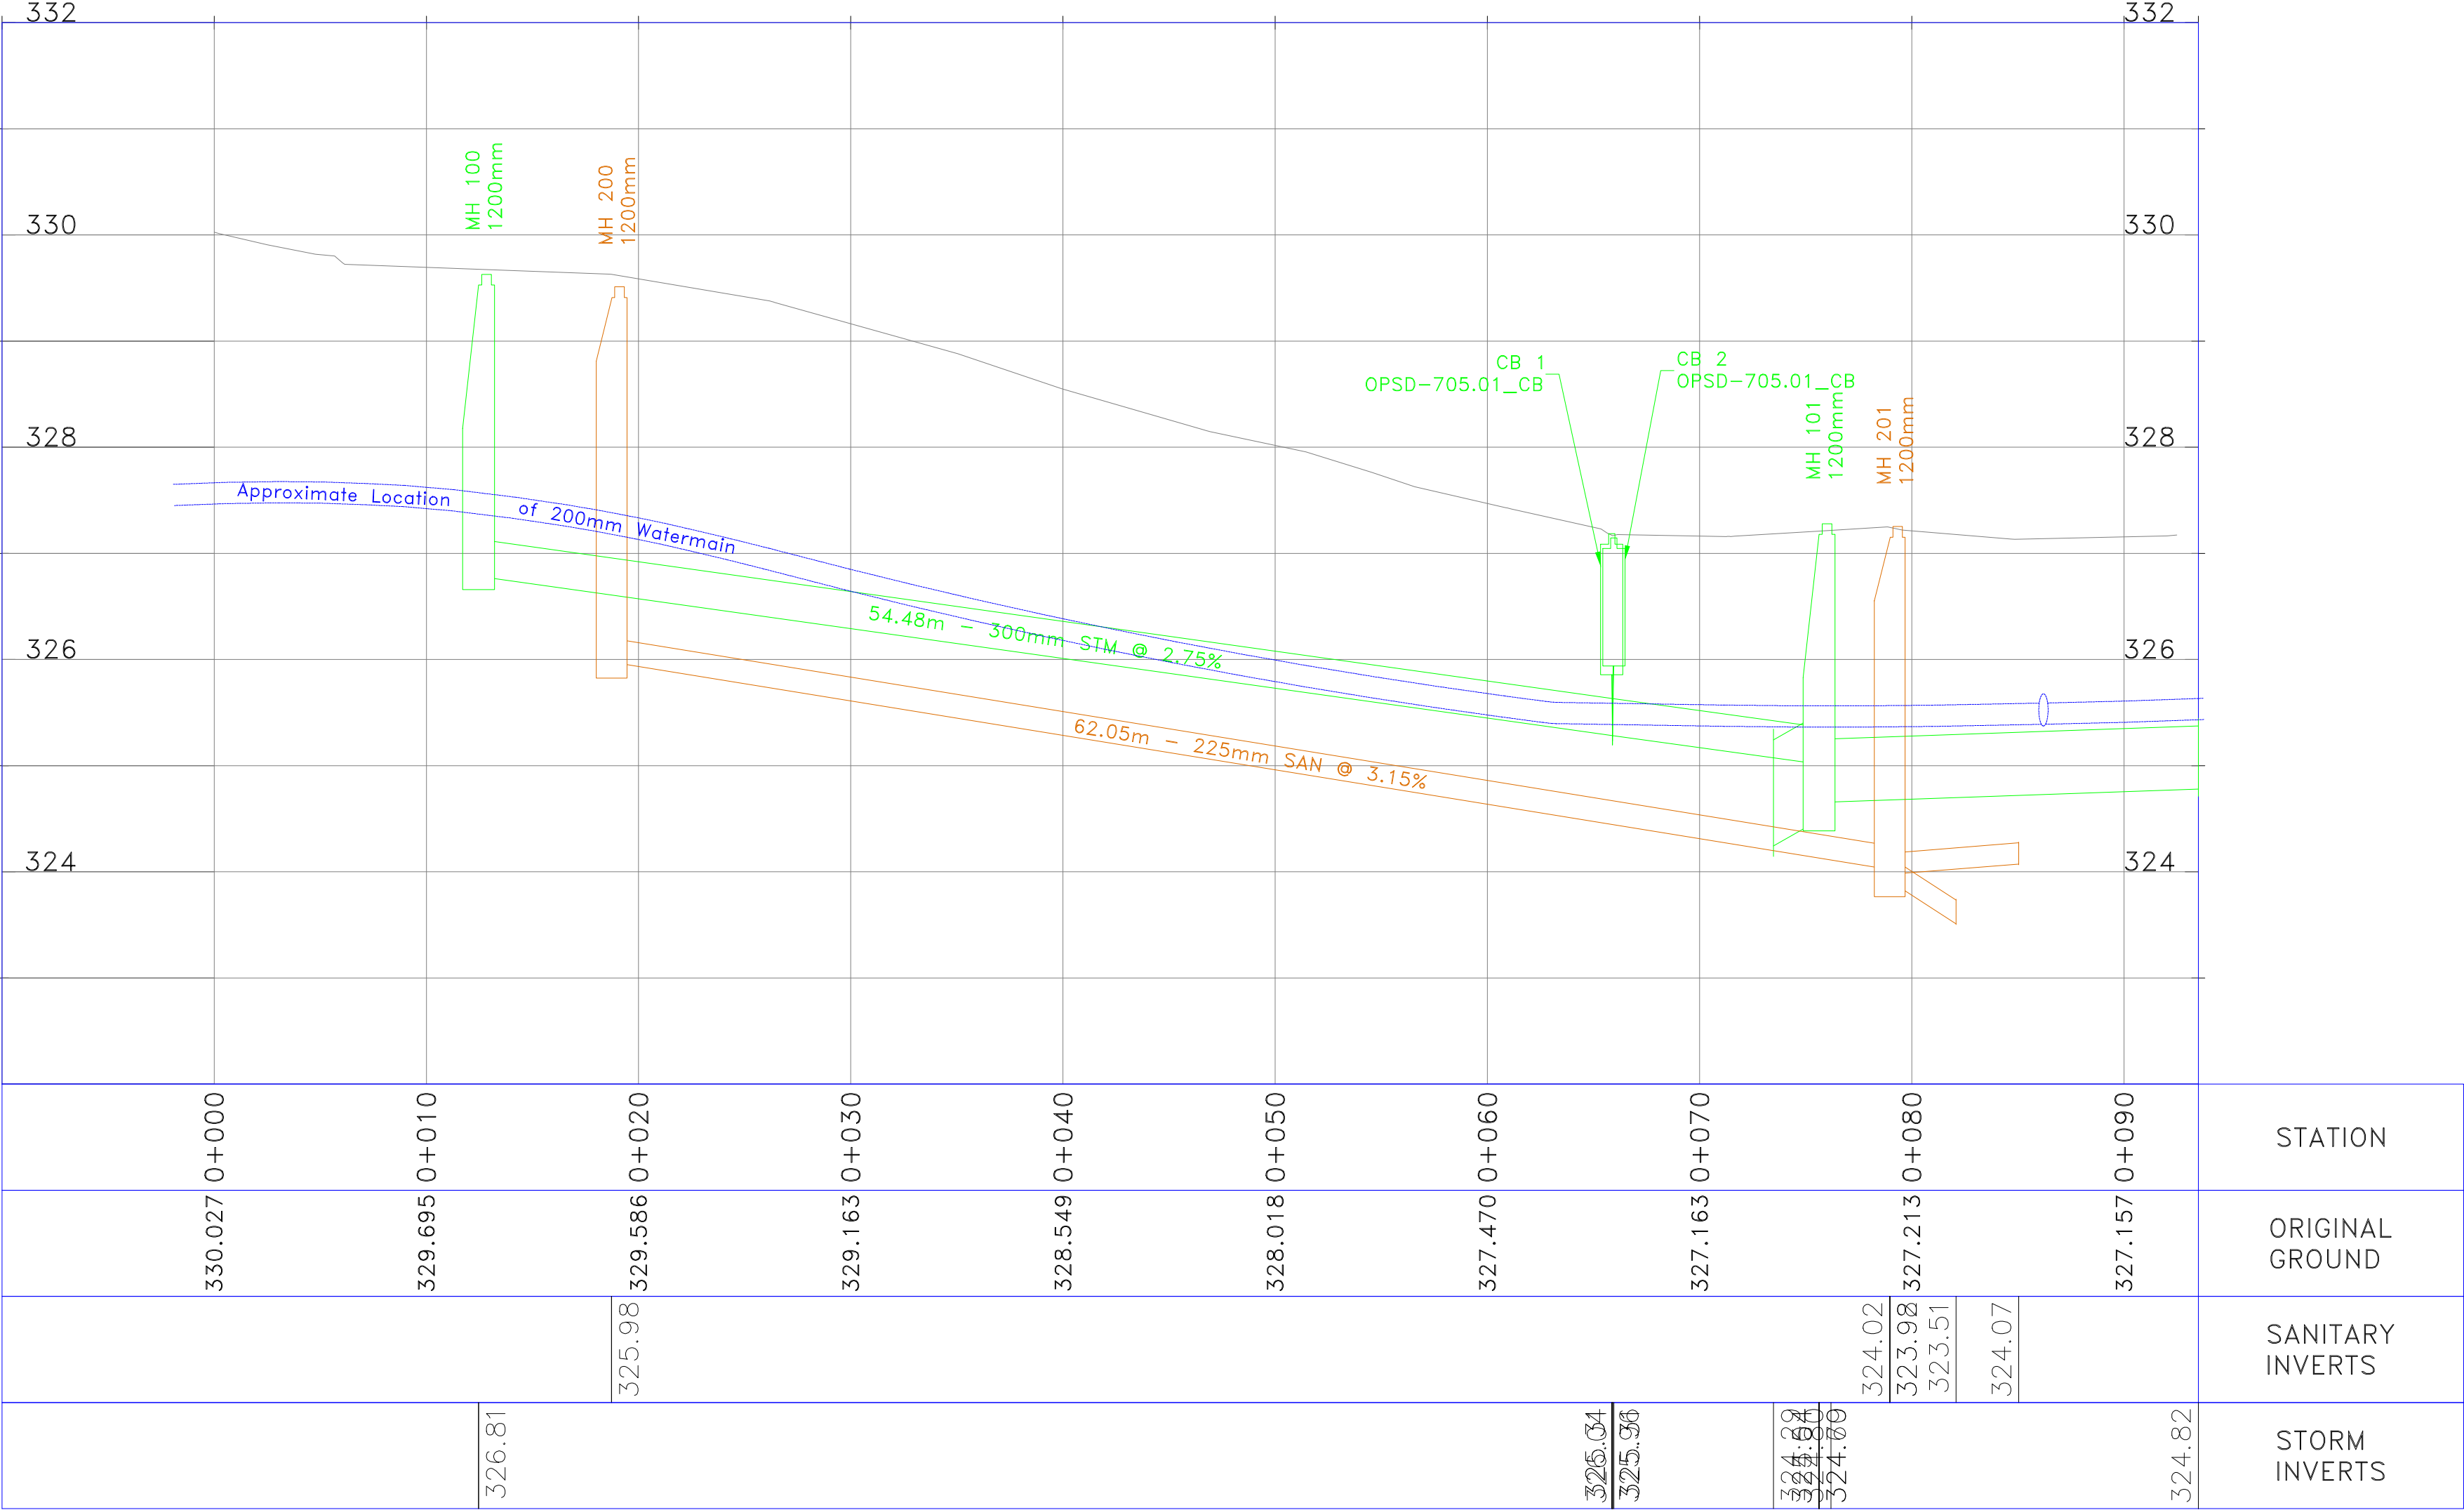

Enza Court

As-Built

PLAN & PROFILE
ENZA COURT

STA. 0+000 to 0+094

designer G.W.C.	drawn by: G.W.C.
checked by:	approved by:

scale
H.1:250
V.1:50

date 01/08/2013	drawing number E-501A
--------------------	--------------------------