



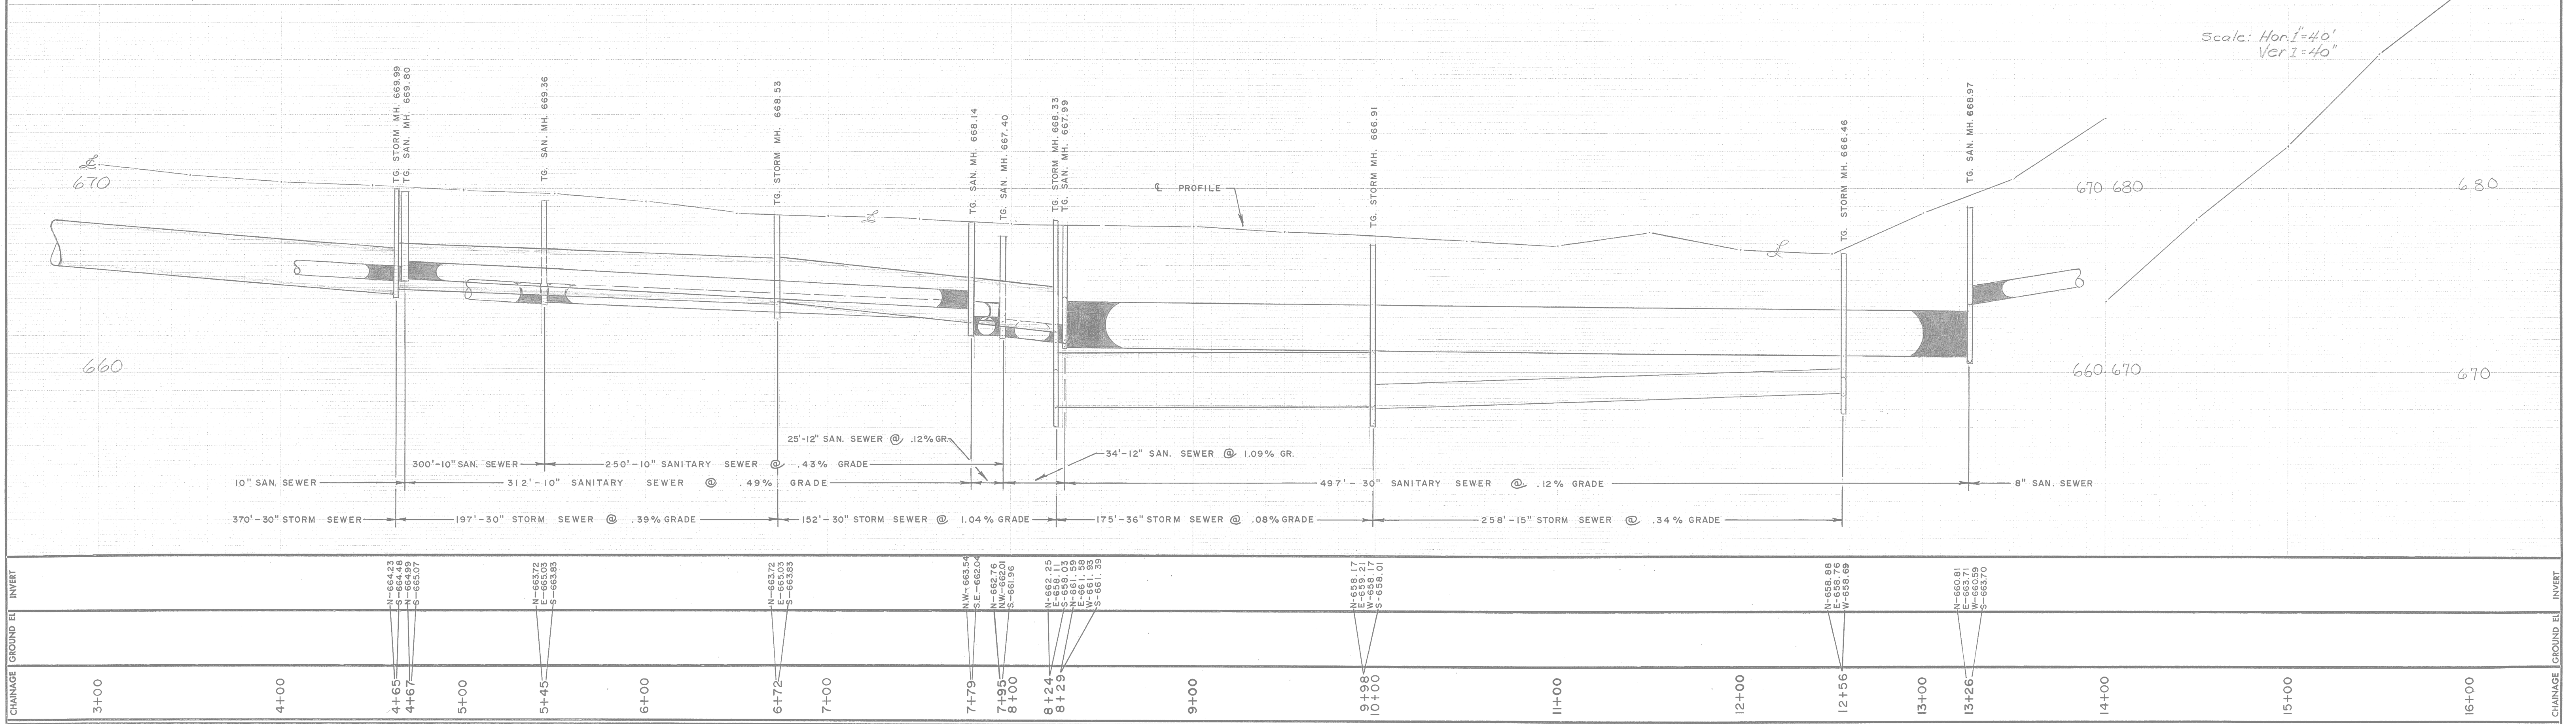

NOTES:

DISCLAIMER

The information contained on this drawing may be based upon data provided by others and may not have been verified by either as constructed drawings or an Ontario Land Surveyor. The City of North Bay cannot accept responsibility for any errors or omissions on any information shown herein. Field verification, land surveys or excavation (with City approvals) may be required to determine actual location of any and all utilities or property lines.

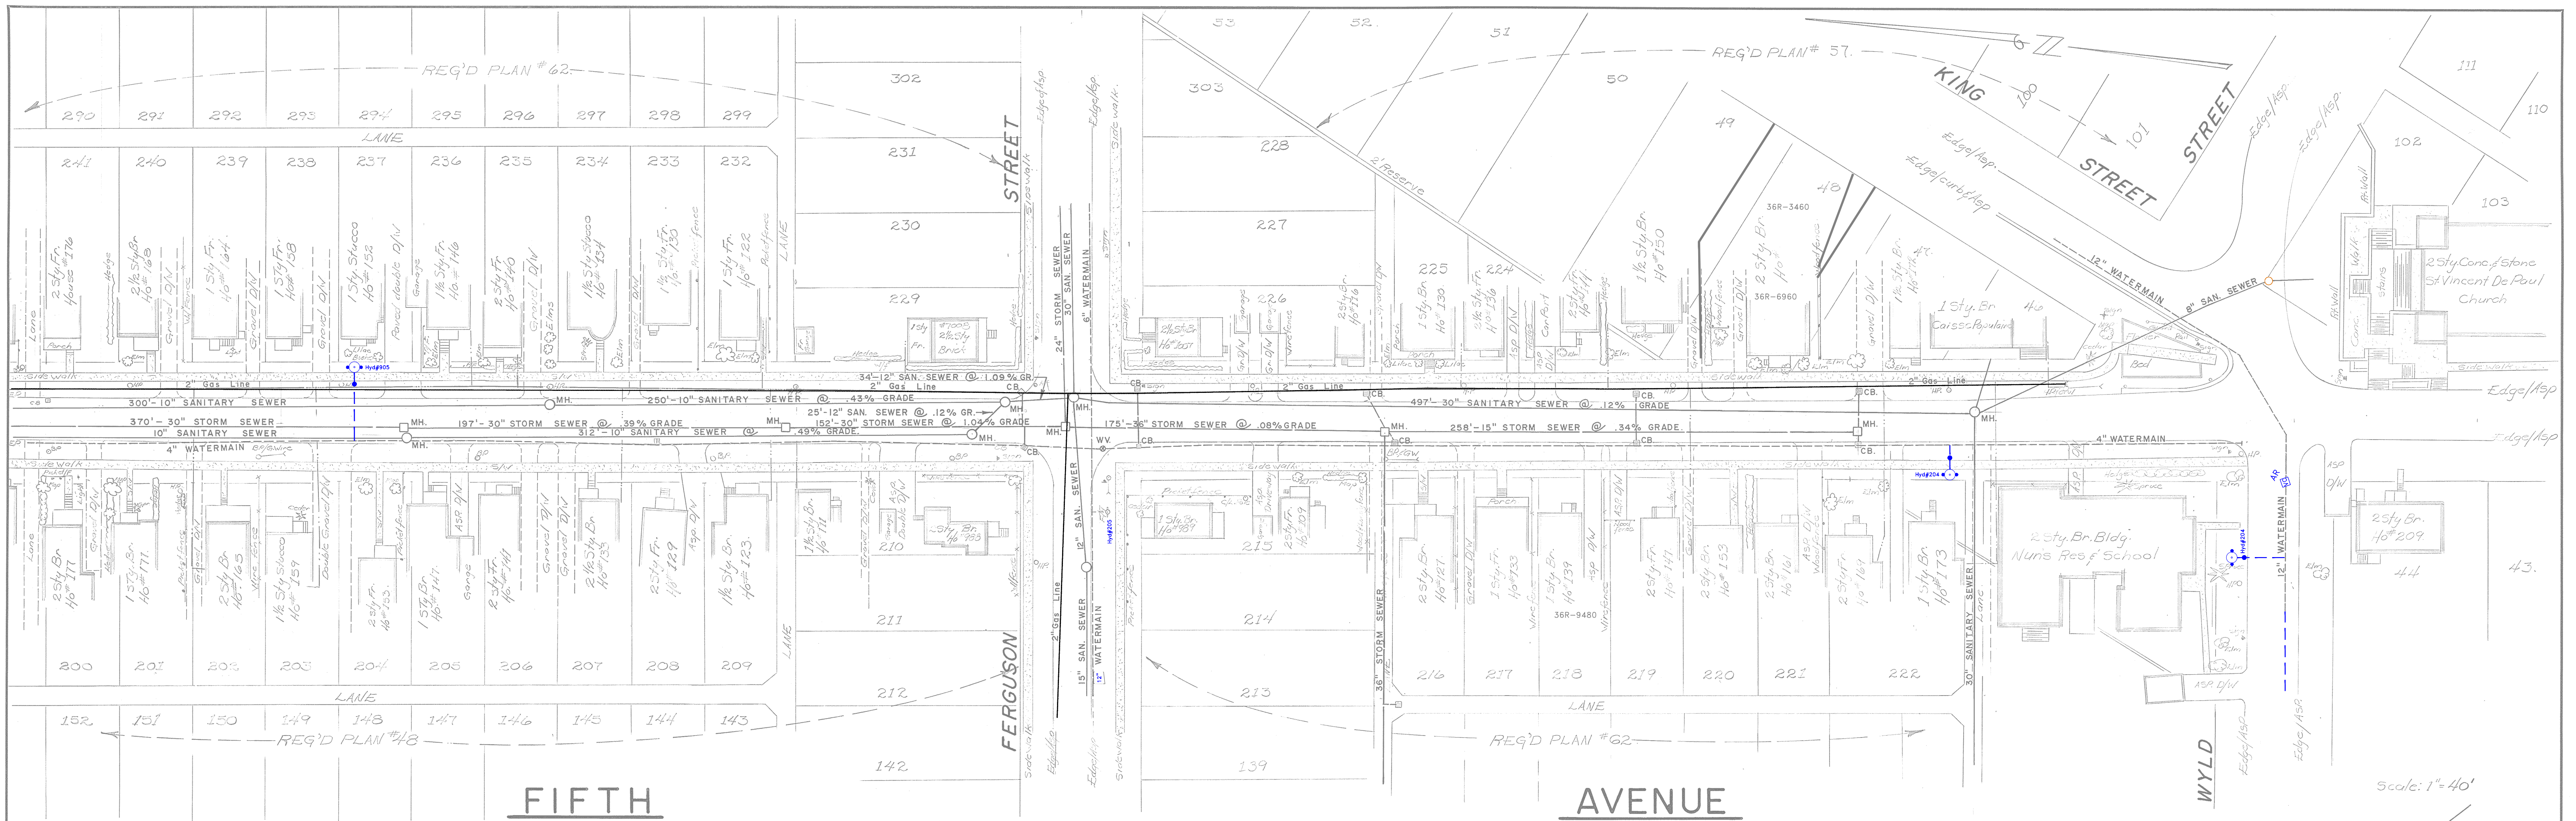

1.	AS CONSTRUCTED STORM & SAN SEWER	MAR. 76	R.F.B.	APPROVED
2.	UNDER GROUND HYDRO CONN. (Caisse Populaire)	JUNE 78	j.d.m.	
No.	REVISION	DATE	INITIAL	

FIFTH AVENUE
FRASER STREET TO WYLD STREET.
REQ'D PLAN N°: 62, 57, 48

CITY OF NORTH BAY
ENGINEERING DEPARTMENT

SCALE: AS SHOWN DATE: FEB 1973

DRAWN BY: C.R. FIELD BOOK No. 225 DRAWING No. F-103 REV.