
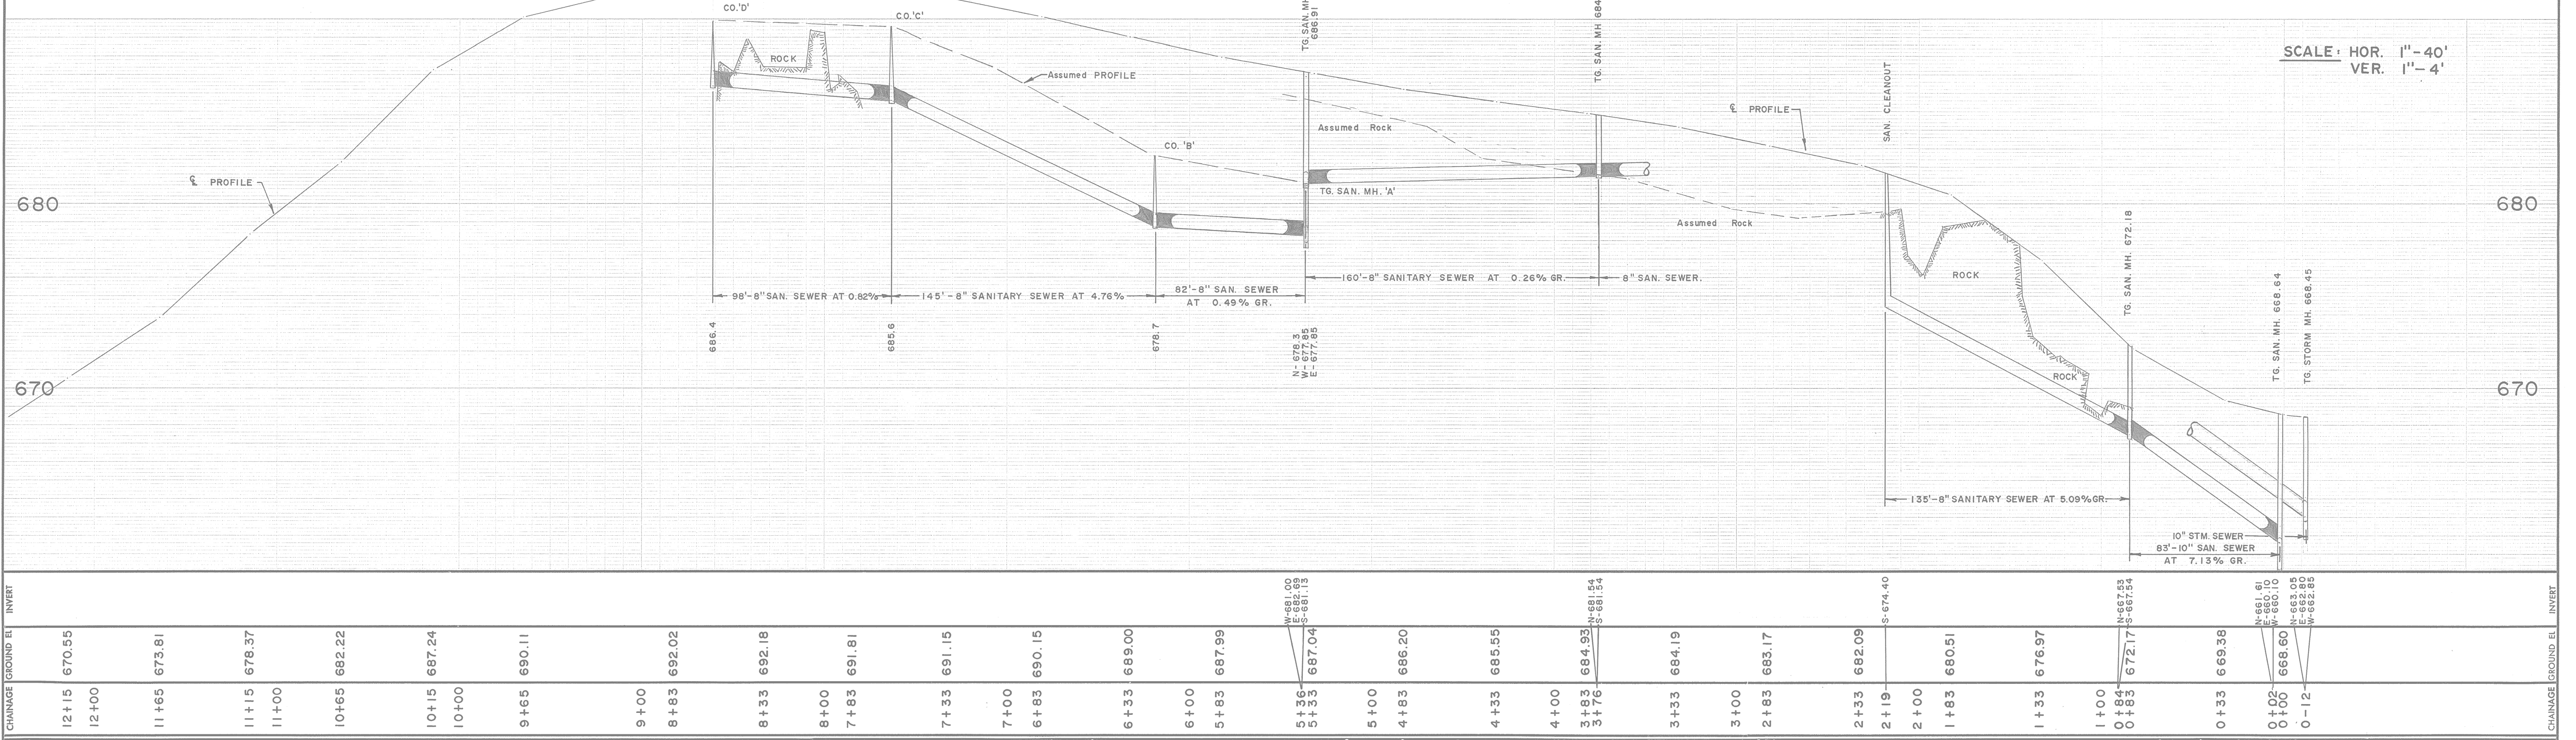


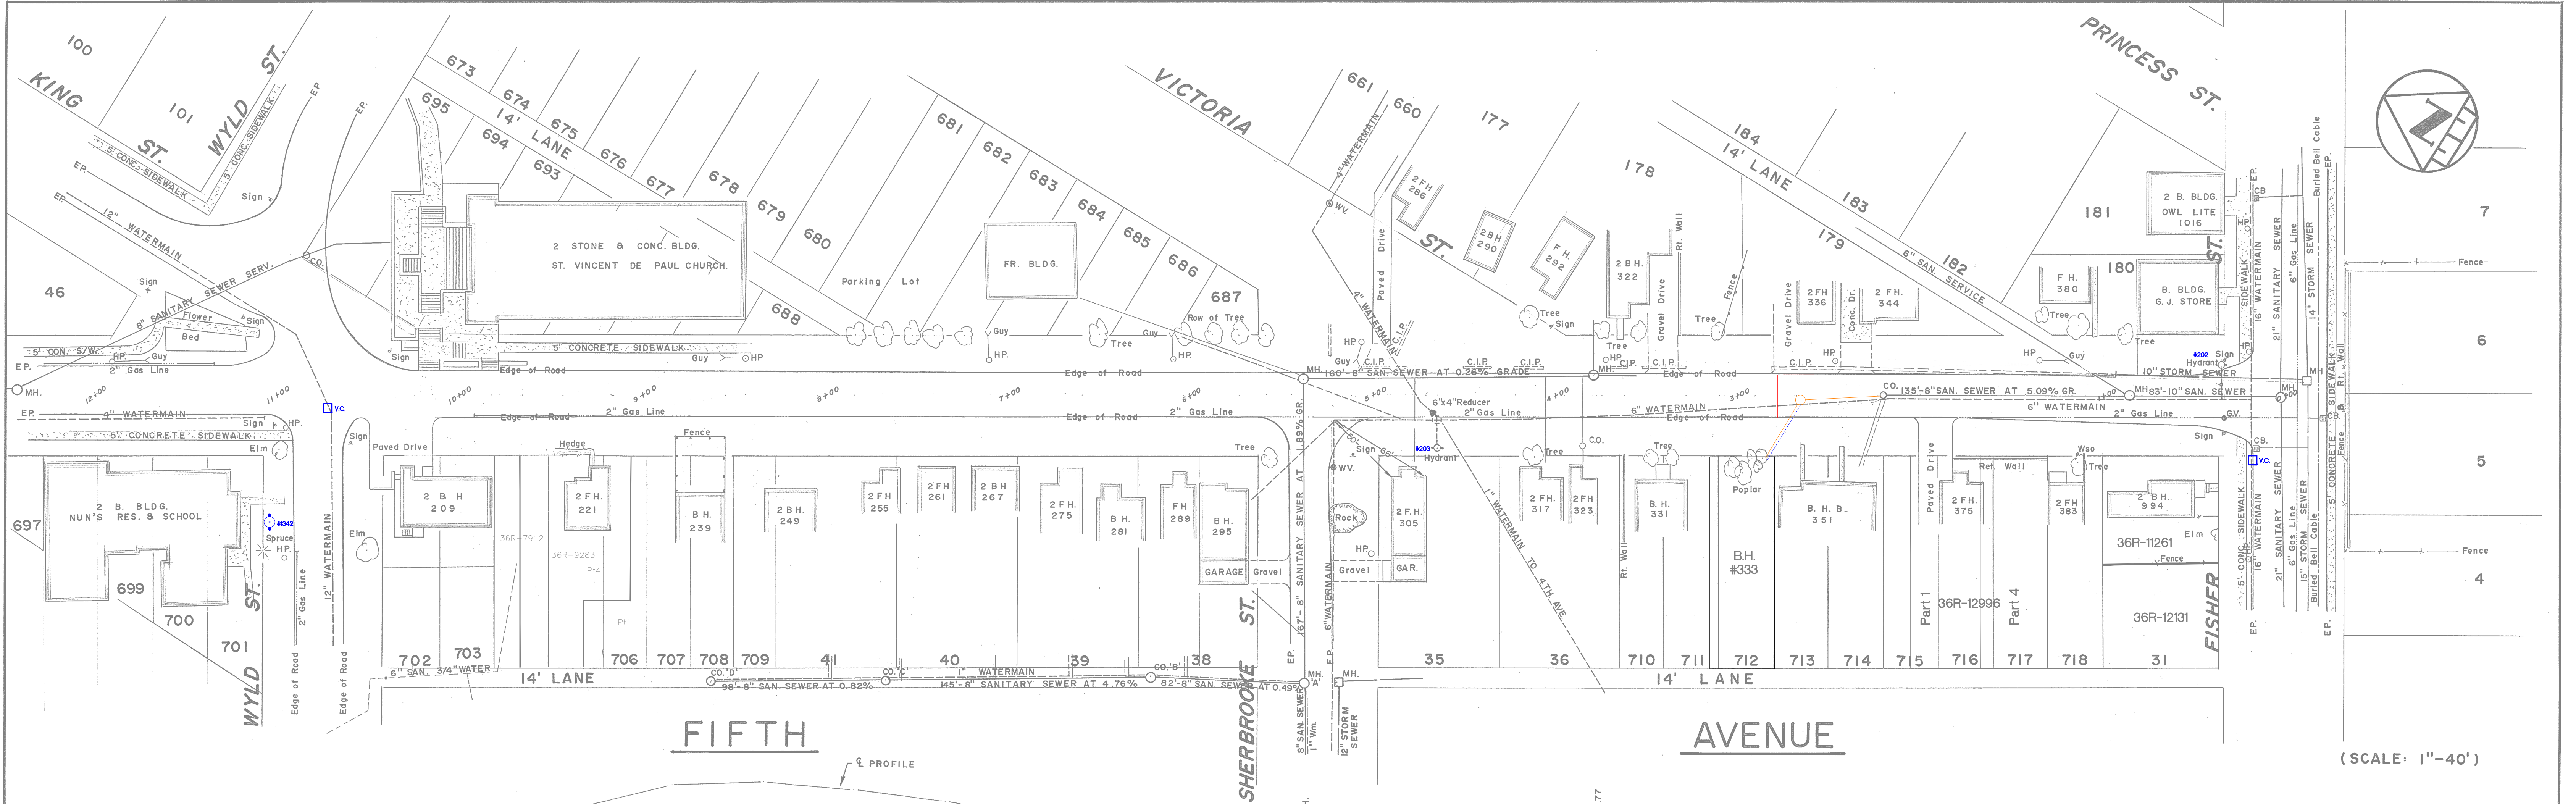

NOTES:

DISCLAIMER

The information contained on this drawing may be based upon data provided by others and may not have been verified by either as-constructed drawings or an Ontario Land Surveyor. The City of North Bay cannot accept responsibility for any errors or omissions on any information shown herein. Field verification, land surveys or excavation (with City approvals) may be required to determine actual location of any and all utilities or property lines.

1. NEW DRAWING FIELD NOTES MAY 1968 OCT. 77 R.F.B.

2. No Notes - Located in Field AS-CONST. 6" WATERMAIN 2419 to 5120 NOV. 77 FEB. 78 R.F.B.

3. Registered Plan Added Oct. 07 r.j.o.

4. 36R-12996 Added Feb '11 G.W.C.

No. REVISION DATE INITIAL

APPROVED

FIFTH AVENUE

FISHER STREET TO WYLD STREET

REG'D. PLAN N^o. 57 & 93

CITY OF NORTH BAY

ENGINEERING DEPARTMENT

SCALE: AS SHOWN

DATE: OCT. 1977.

DRAWN BY: Rick B.
CK'D. BY:

FIELD BOOK No.
175

DRAWING No.
F-104

REV.