
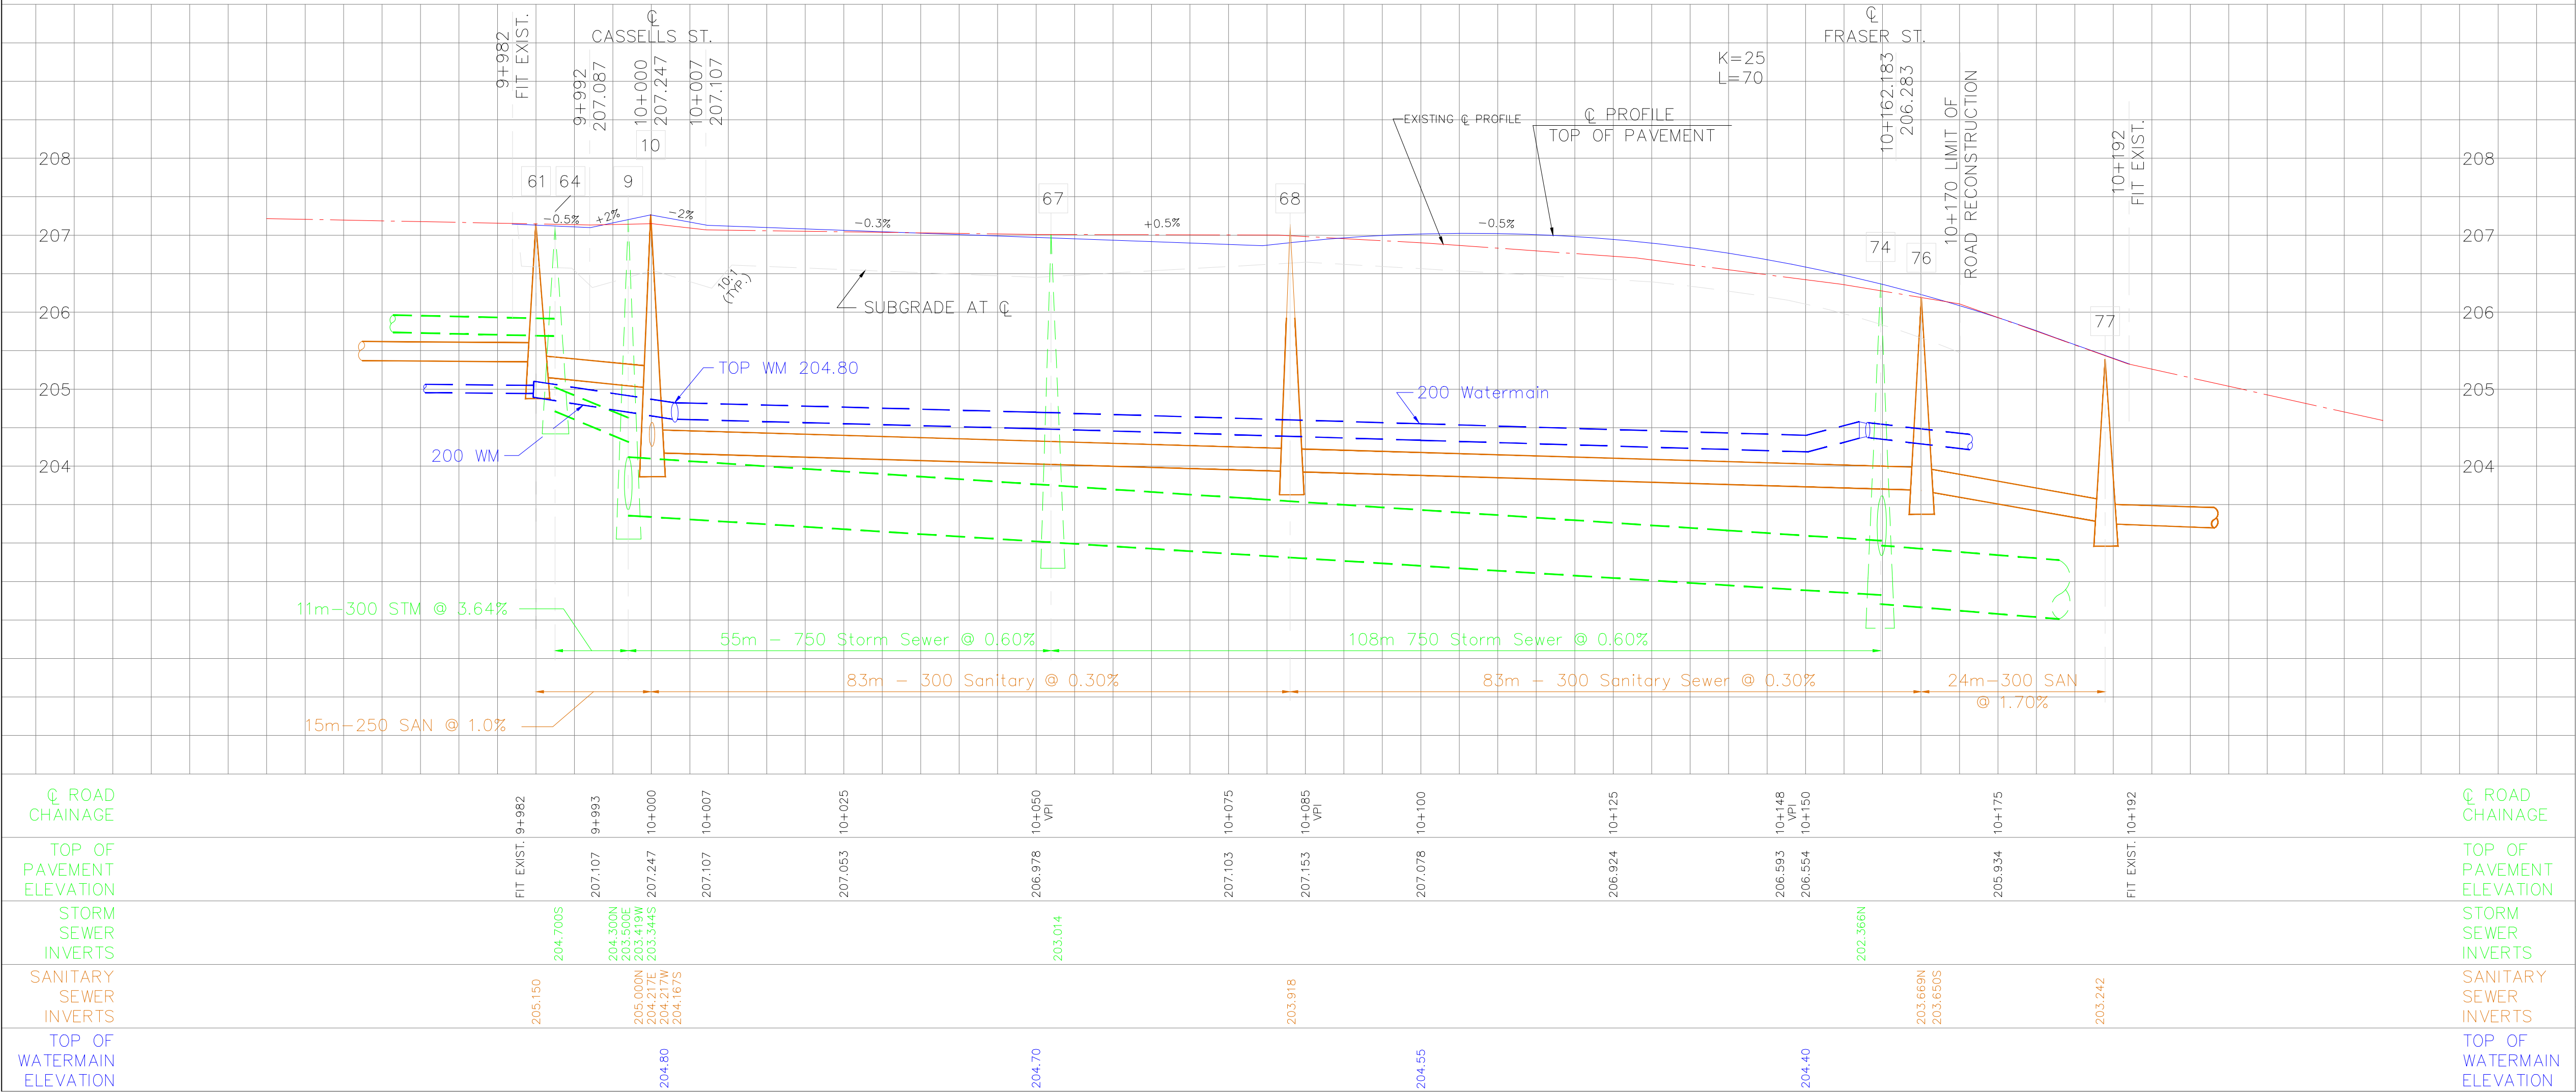


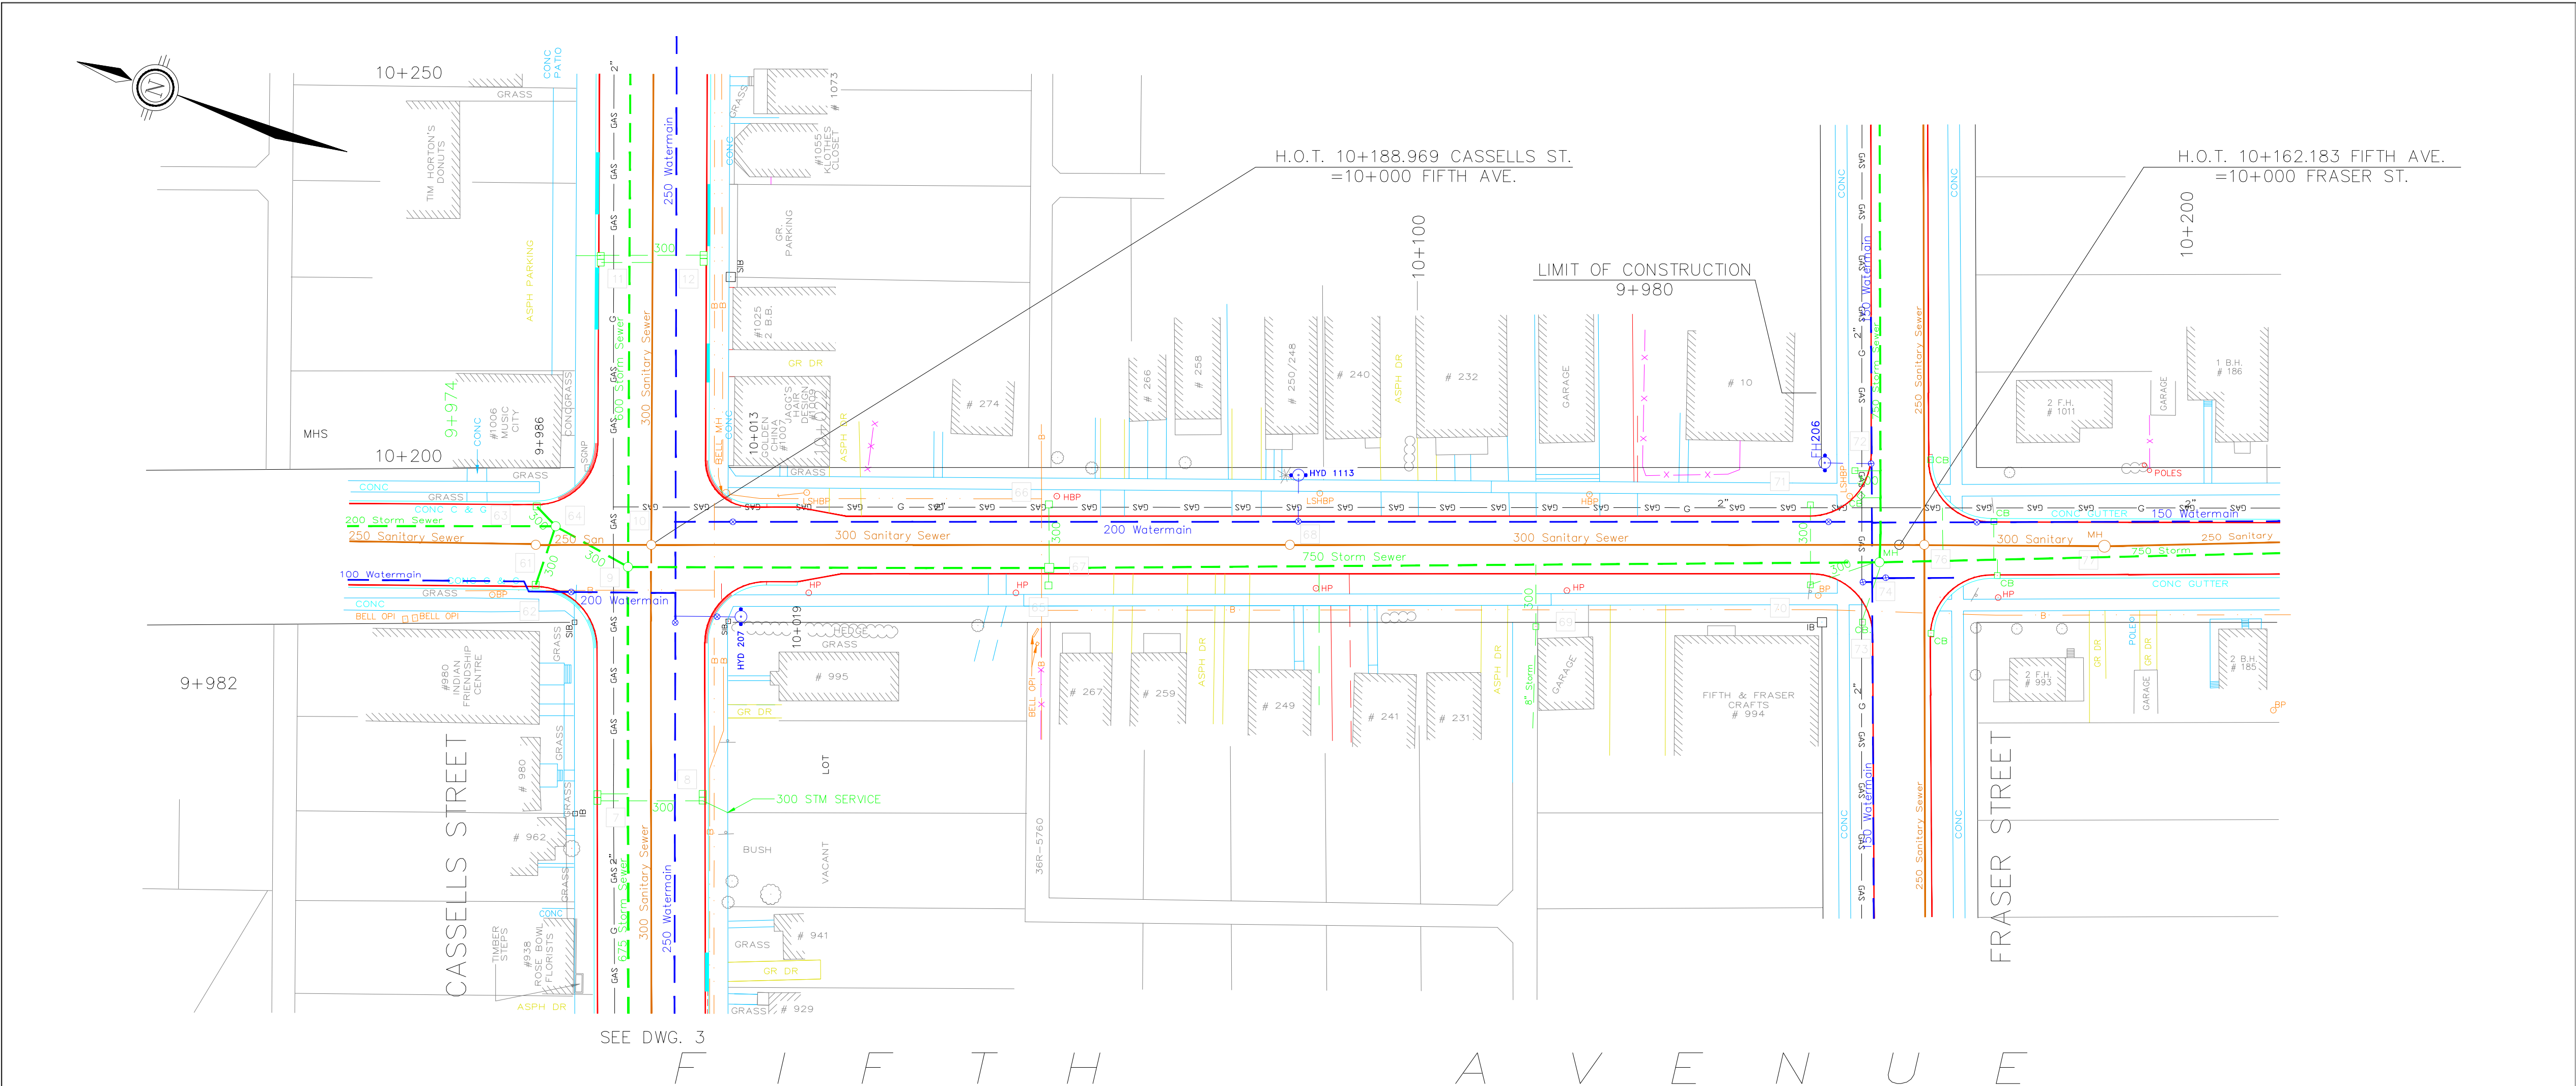

REFERENCE	
DWG No	DESCRIPTION

NOTES
1. REPLACE SANITARY AND WATER SERVICES TO PROPERTY LINE.

Disclaimer
The information contained on this drawing may be based upon data provided by others and may not have been verified by either as-constructed drawings or an Ontario Land Surveyor. The City of North Bay cannot accept responsibility for any errors or omissions on any information shown herein. Field verification, land surveys or excavation (with City approvals) may be required to determine actual location of any and all utilities or property lines.

APP'D BY	DETAILS REVISIONS	DATE	No

RECOMMENDED BY	APPROVED BY

CORPORATION OF THE
CITY OF NORTH BAY

CASSELLS STREET RECONSTRUCTION
THIRD AVENUE TO KING STREET
AS-BUILT

FIFTH AVENUE
CASSELLS ST. TO 30m SOUTH OF FRASER ST.

northland engineering (1987) limited Consulting Engineers and Planners		NORTH BAY SUDBURY TIMMINS	
DRAWN BY:	T.H.P.	DATE:	MAY 1991
CHECKED BY:	R.E.A./S.K.P.	SCALE:	HORIZ. 1 : 500 VERT. 1 : 50
FIELD BOOK			
OFFICE NORTH BAY	PROJECT No 3581	DRAWING No F-105	REV.