
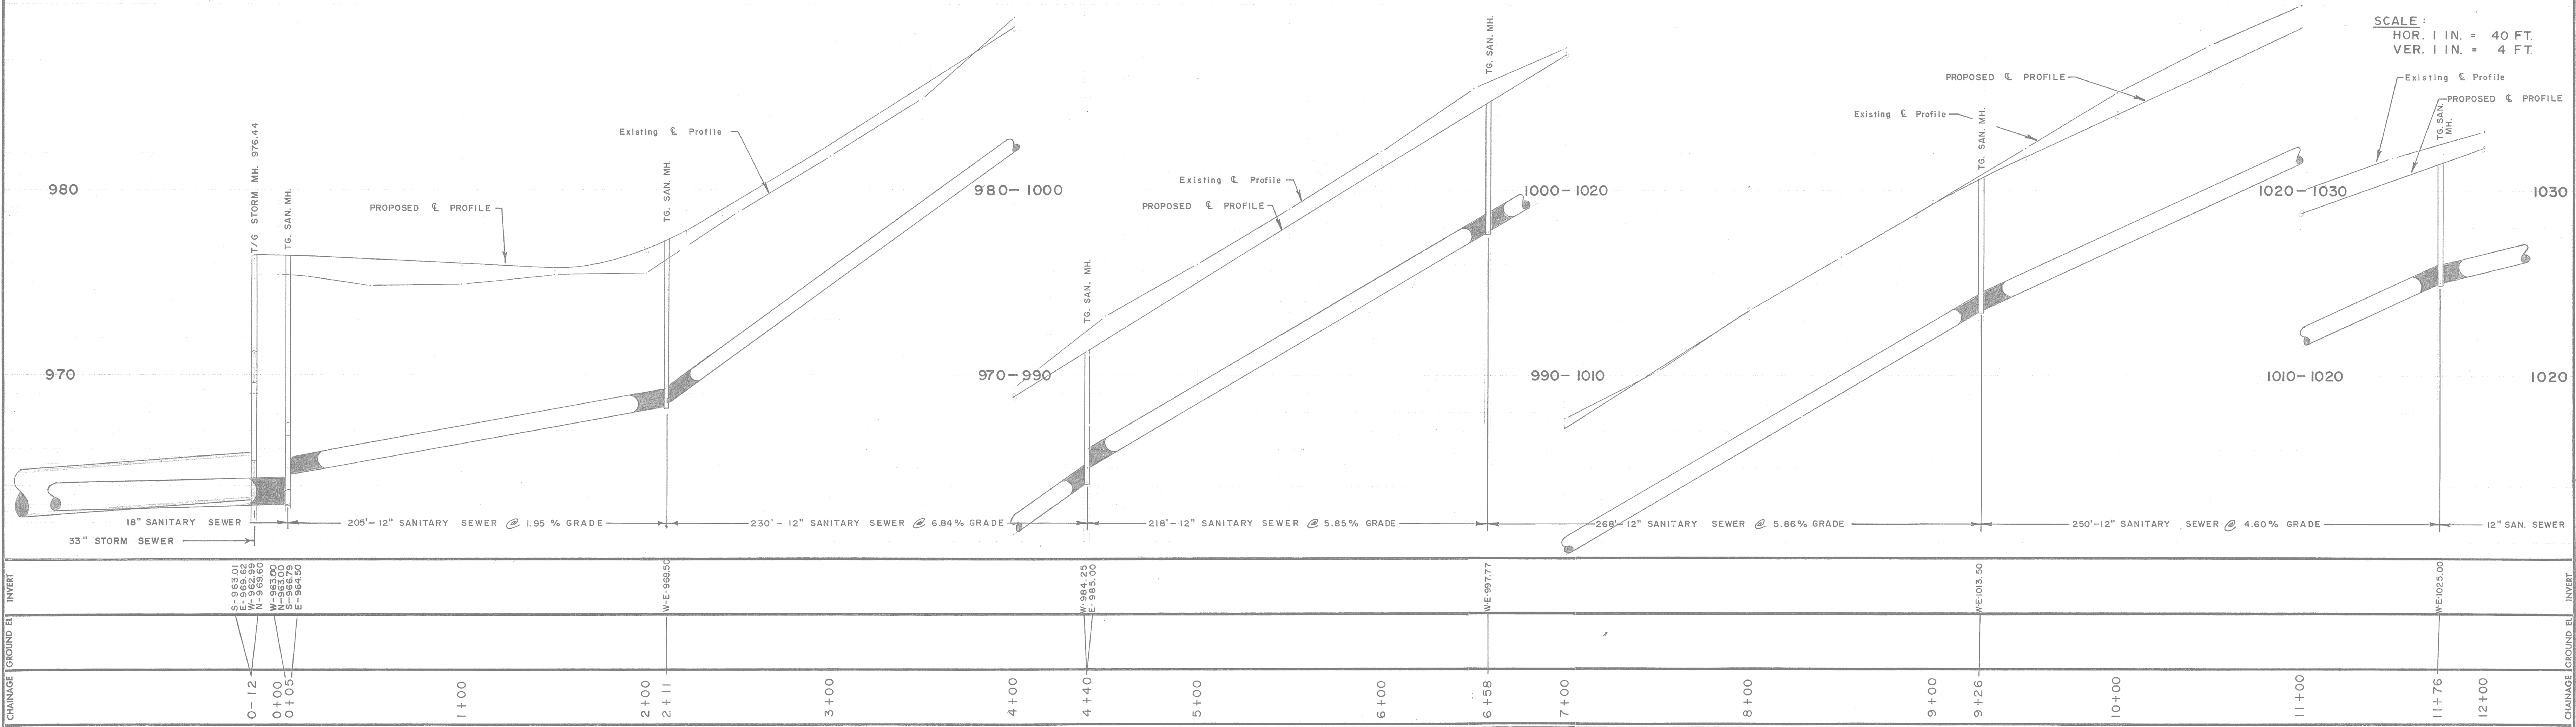


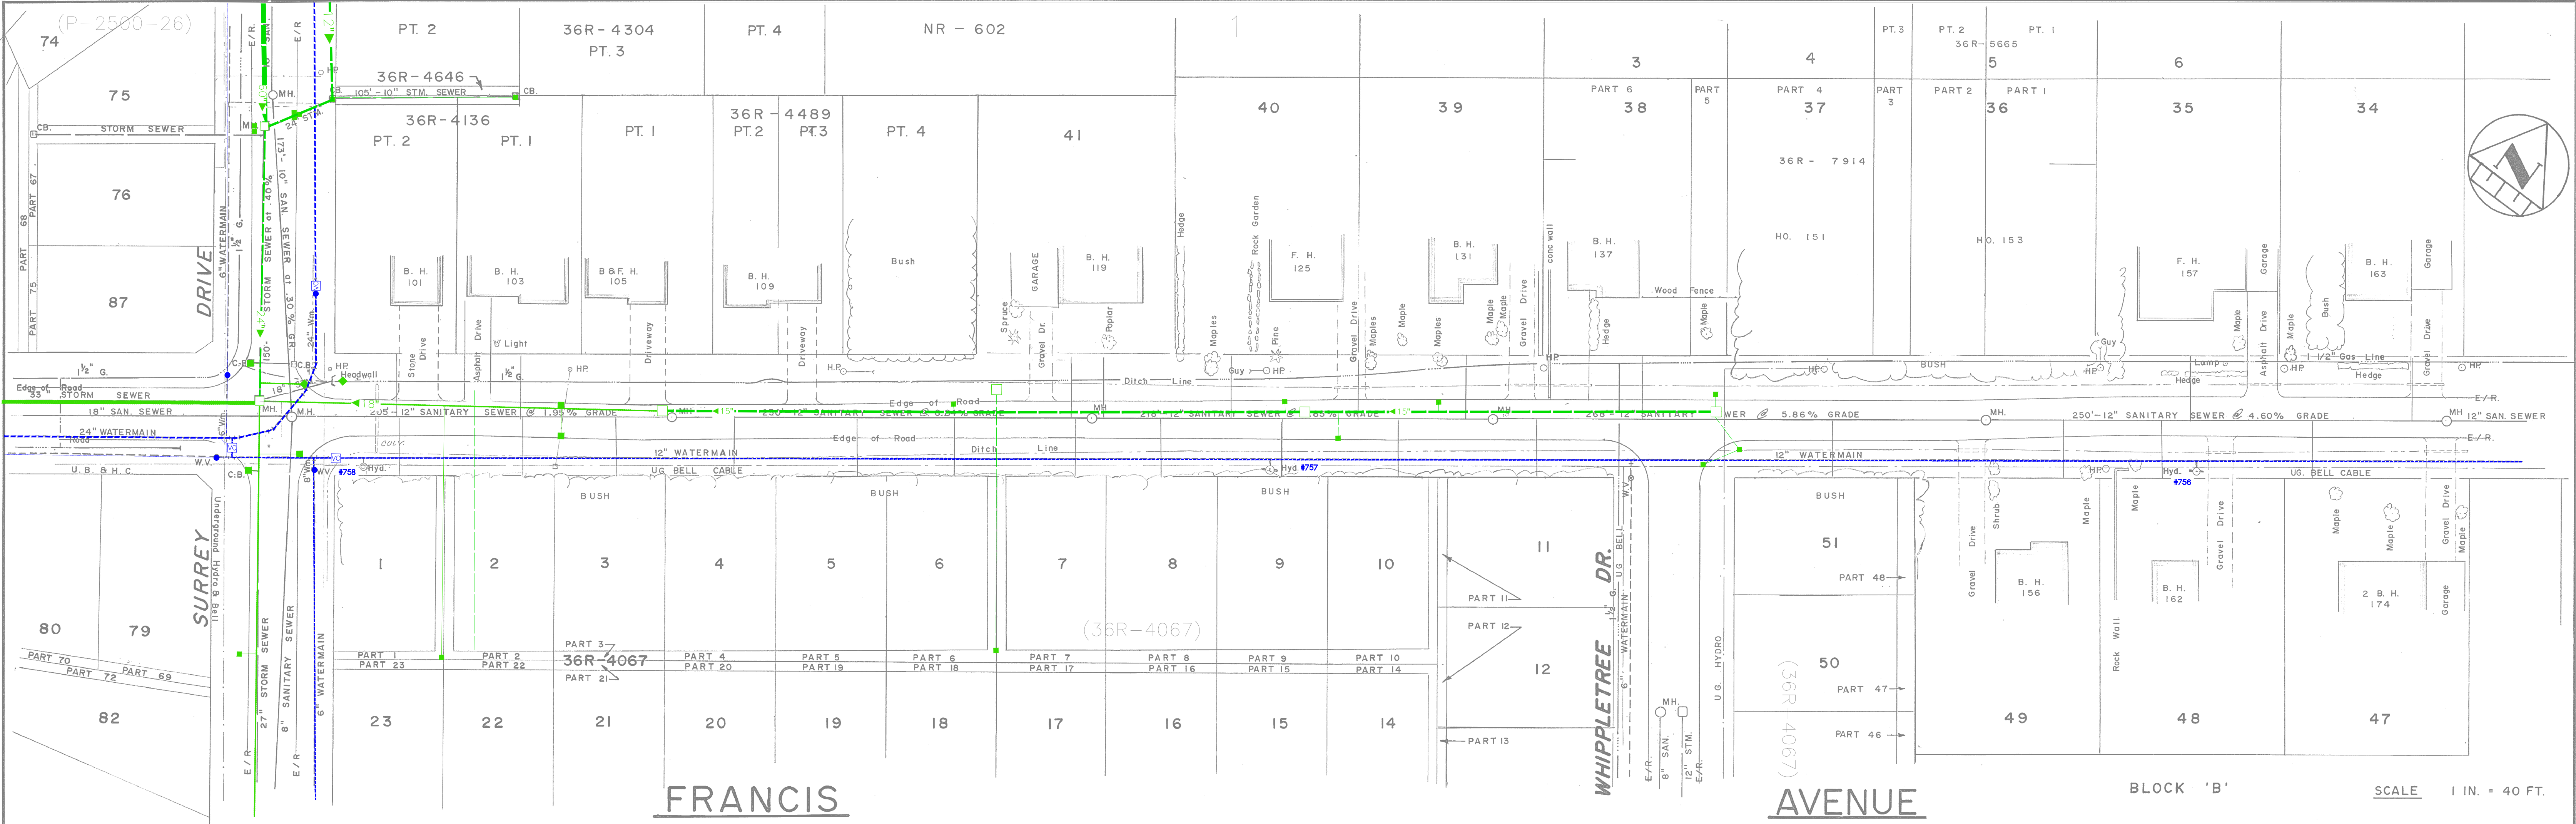

NOTES:

DISCLAIMER

The information contained on this drawing may be based upon data provided by others and may not have been verified by either as-constructed drawings or an Ontario Land Surveyor. The City of North Bay cannot accept responsibility for any errors or omissions on any information shown herein. Field verification, land surveys or excavation (with City approvals) may be required to determine actual location of any and all utilities or property lines.

1.	SANITARY SEWER & WATERMAIN	JUNE 75	R. F. B.
2.	UP-DATE DETAIL of SURREY DRIVE	APR. 76	j.d.m.
3.	UP-DATE STORM DETAIL & PROPERTY PLANS	JUNE 77	j.d.m.
4.	UG. BELL CABLE	AUG. 78	j.d.m.
5.	UP DATE DETAIL of INT. of SURREY	MAR. 79	j.d.m.
6.	SANITARY SERVICES & STM. INVERTS at SURREY SEPT 79	j.d.m.	
No.	REVISION	DATE	INITIAL

APPROVED



FRANCIS AVENUE
SURREY DRIVE to PEARCE STREET
REG'D PLAN : M-270 M-485

CITY OF NORTH BAY
ENGINEERING DEPARTMENT

SCALE: AS SHOWN DATE: DEC. 1969

DRAWN BY: <i>ep</i>	FIELD BOOK No. 190	DRAWING No. F-151	REV.
---------------------	--------------------	-------------------	------