



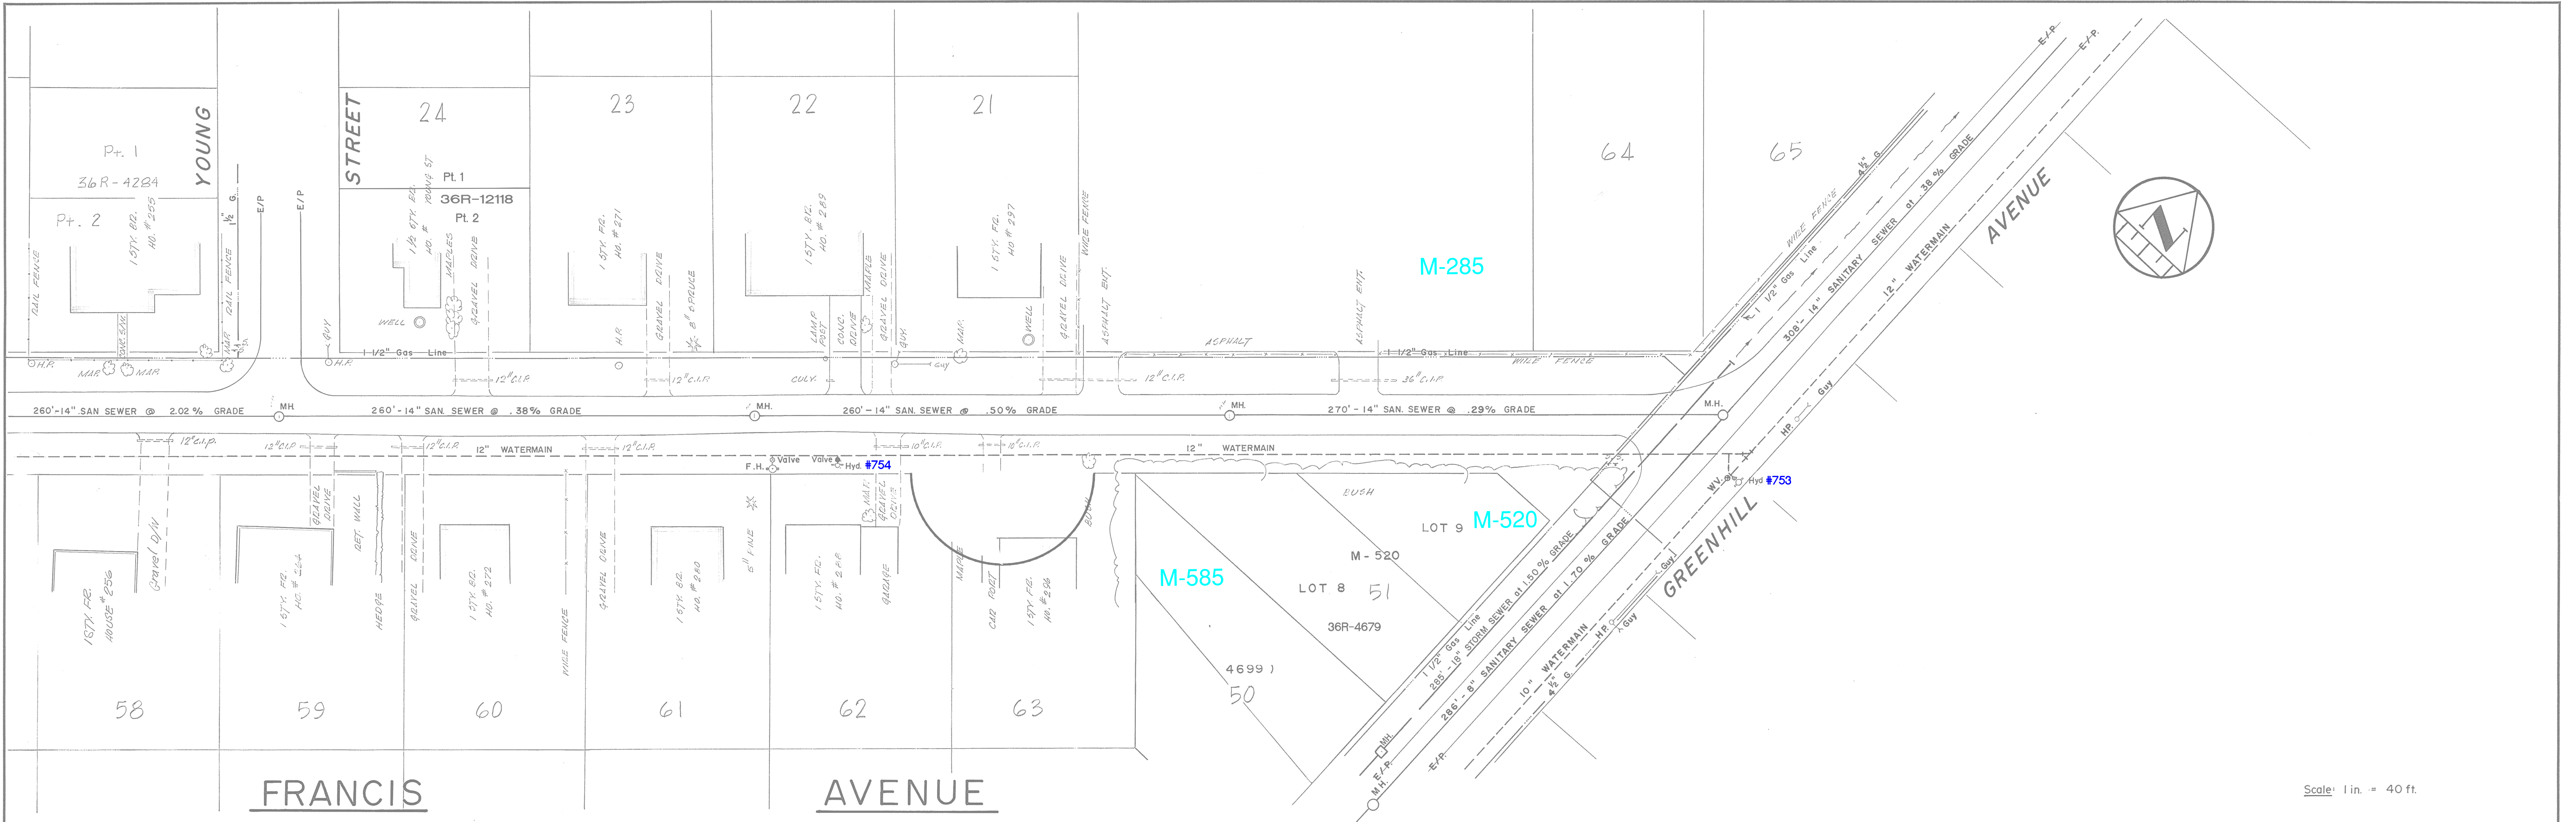

Scale: 1 in. = 40 ft.

Scale: Hor. 1 in. = 40 ft.
Ver. 1 in. = 4 ft.

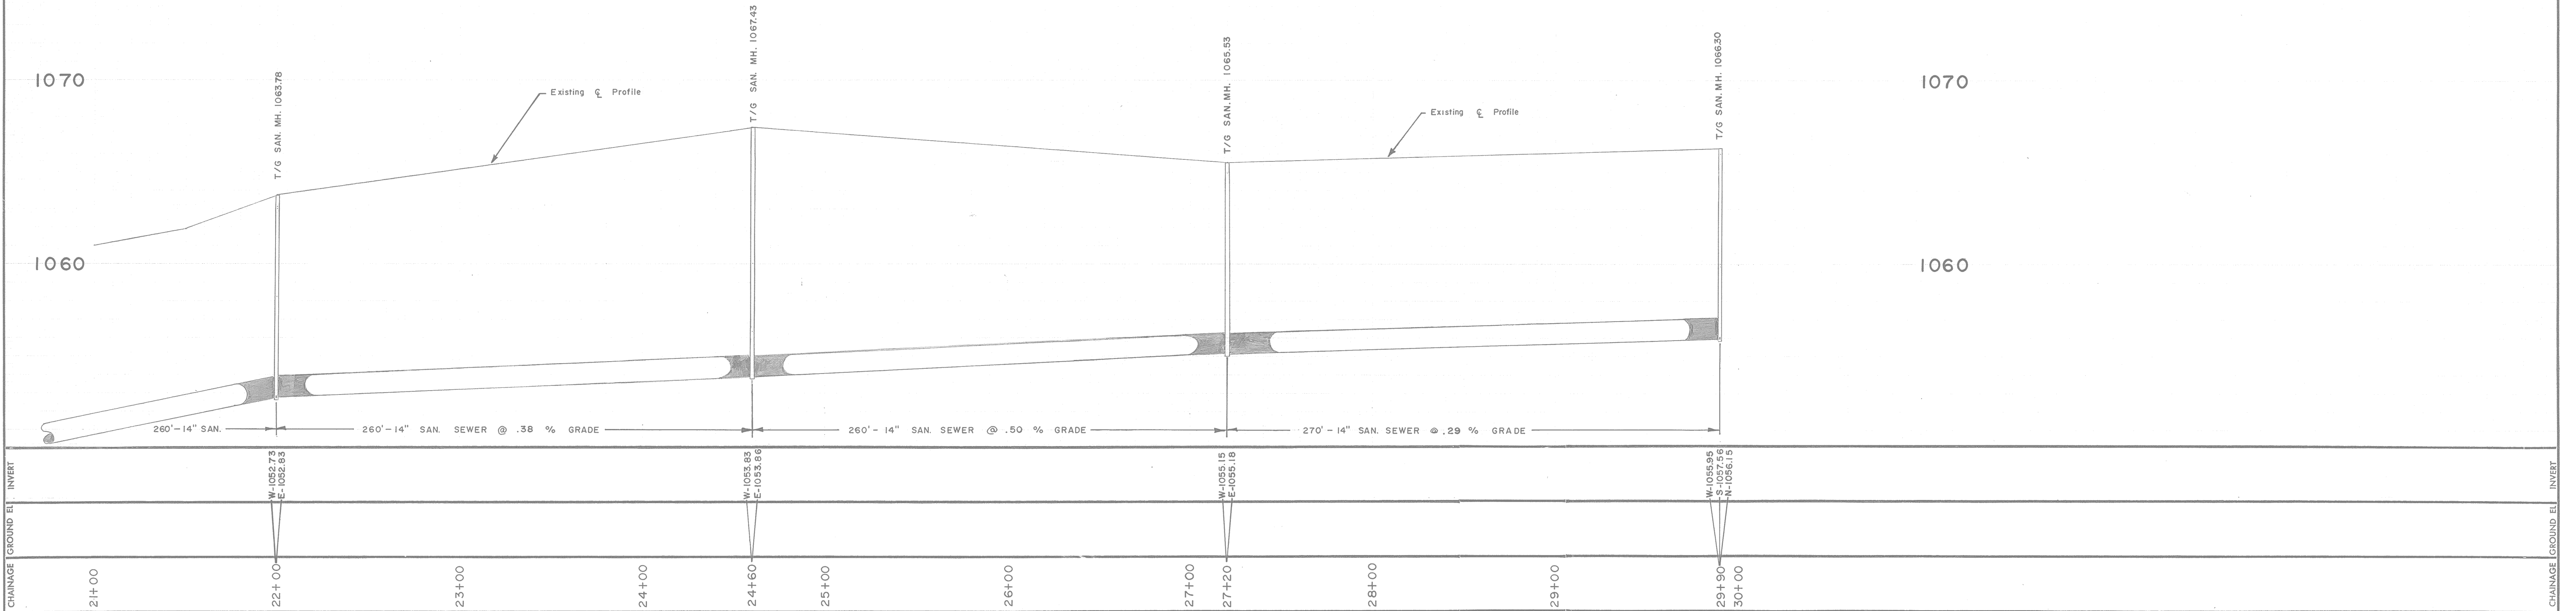

DWG. No.	NOTES:	1. SANITARY SEWER & WATERMAIN JUNE 75 J.M. 2. AS CONST. SAN. & WM. ON GREENHILL APR. 77 J.d.m. 3. ADDITION OF GAS LINE. JUNE/83 A.P. 4. PROPOSED STM. SEWER ON GREENHILL AVE. OCT./87 P.L.C. 5. REVISED SAN. INVERTS, GREENHILL TO YOUNG ST. B.K.289 JUNE 90 RT 6. Registered plans added. OCT. 07 f.j.o.				APPROVED	REGISTERED PROFESSIONAL ENGINEER CIVIL M. L. DAITER PROVINCE OF ONTARIO		FRANCIS AVENUE YOUNG STREET to GREENHILL AVENUE		CITY OF NORTH BAY ENGINEERING DEPARTMENT		SCALE: AS SHOWN DATE: DEC. 1969	
	DISCLAIMER				Reg'd Plan: M - 270, LOT 18, CON. B									
	The information contained on this drawing may be based upon data provided by others and may not have been verified by either as-constructed drawings or an Ontario Land Surveyor. The City of North Bay cannot accept responsibility for any errors or omissions on any information shown herein. Field verification, land surveys or excavation (with City approvals) may be required to determine actual location of any and all utilities or property lines.													