



F-251

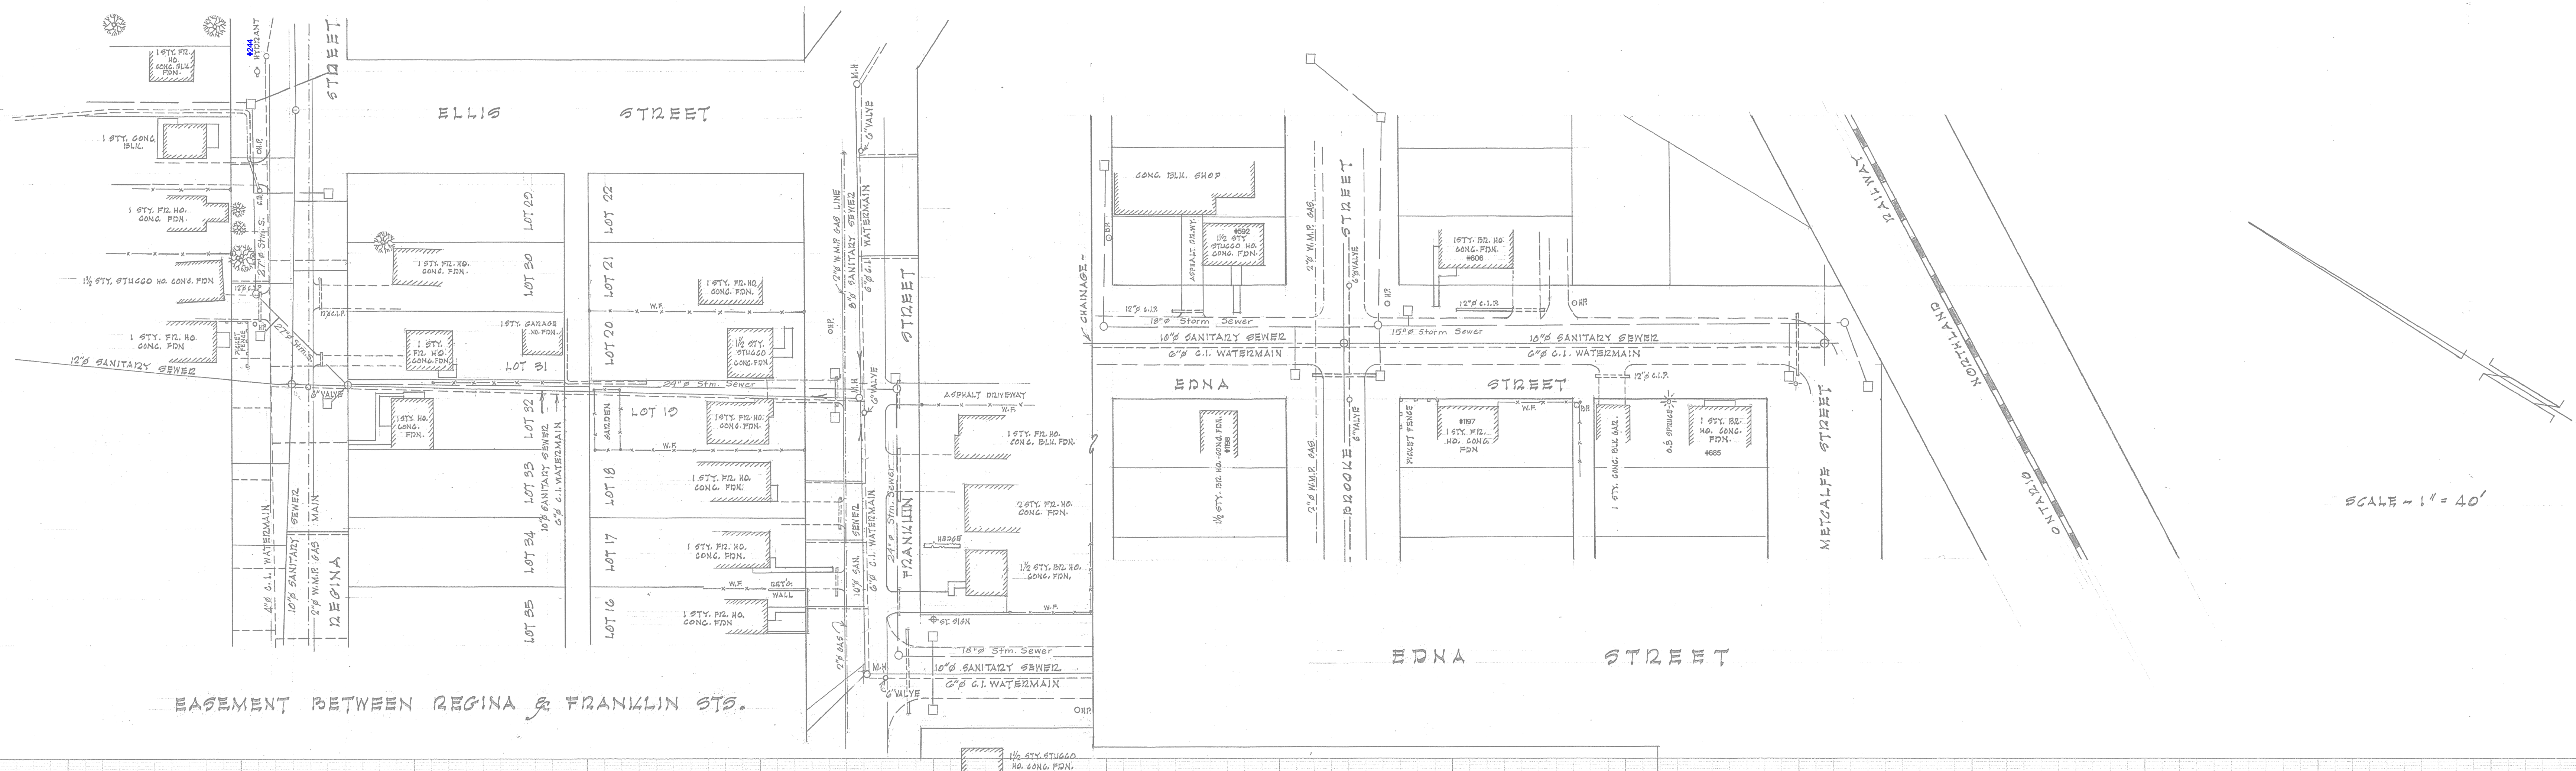

SCALE - 1" = 40'

SEE DRAWING NO.

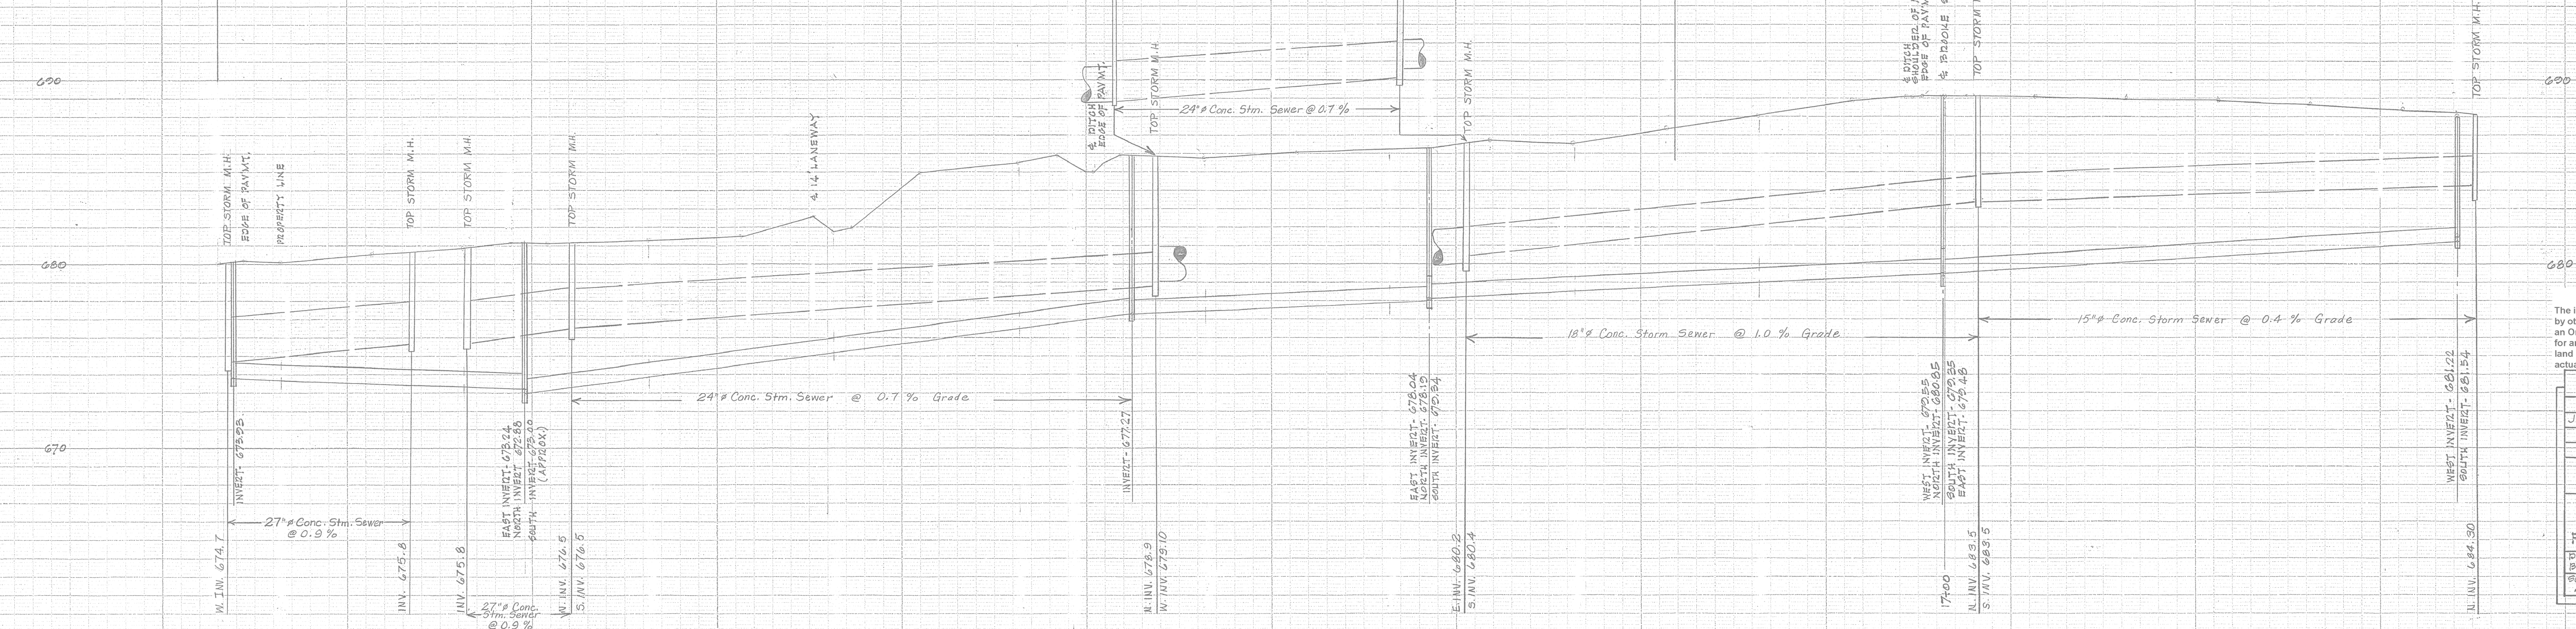

Scale - Hor - 1 inch = 40 feet
Ver - 1 inch = 4 feet

DISCLAIMER

The information contained on this drawing may be based upon data provided by others and may not have been verified by either as-constructed drawings or an Ontario Land Surveyor. The City of North Bay cannot accept responsibility for any errors or omissions on any information shown herein. Field verification, land surveys or excavation (with City approvals) may be required to determine actual location of any and all utilities or property lines.

BENCH MARK		
DATE	REVISIONS	DRAWN BY
July 1968	Storm Sewer - As constructed	J.M.F. R.D.

CORPORATION OF THE CITY OF NORTH BAY - ONTARIO

PLAN AND PROFILE

REGINA ST. THROUGH EASEMENT TO FRANKLIN - ALONG EDNA TO METCALFE

DRAWN BY	CHECKED BY	DATE	FIELD BOOK NO.
B. BAUNDER	J.M.F.	07-15-1968	

APPROVED BY: CITY ENGINEER

DWG. NO. F-251