
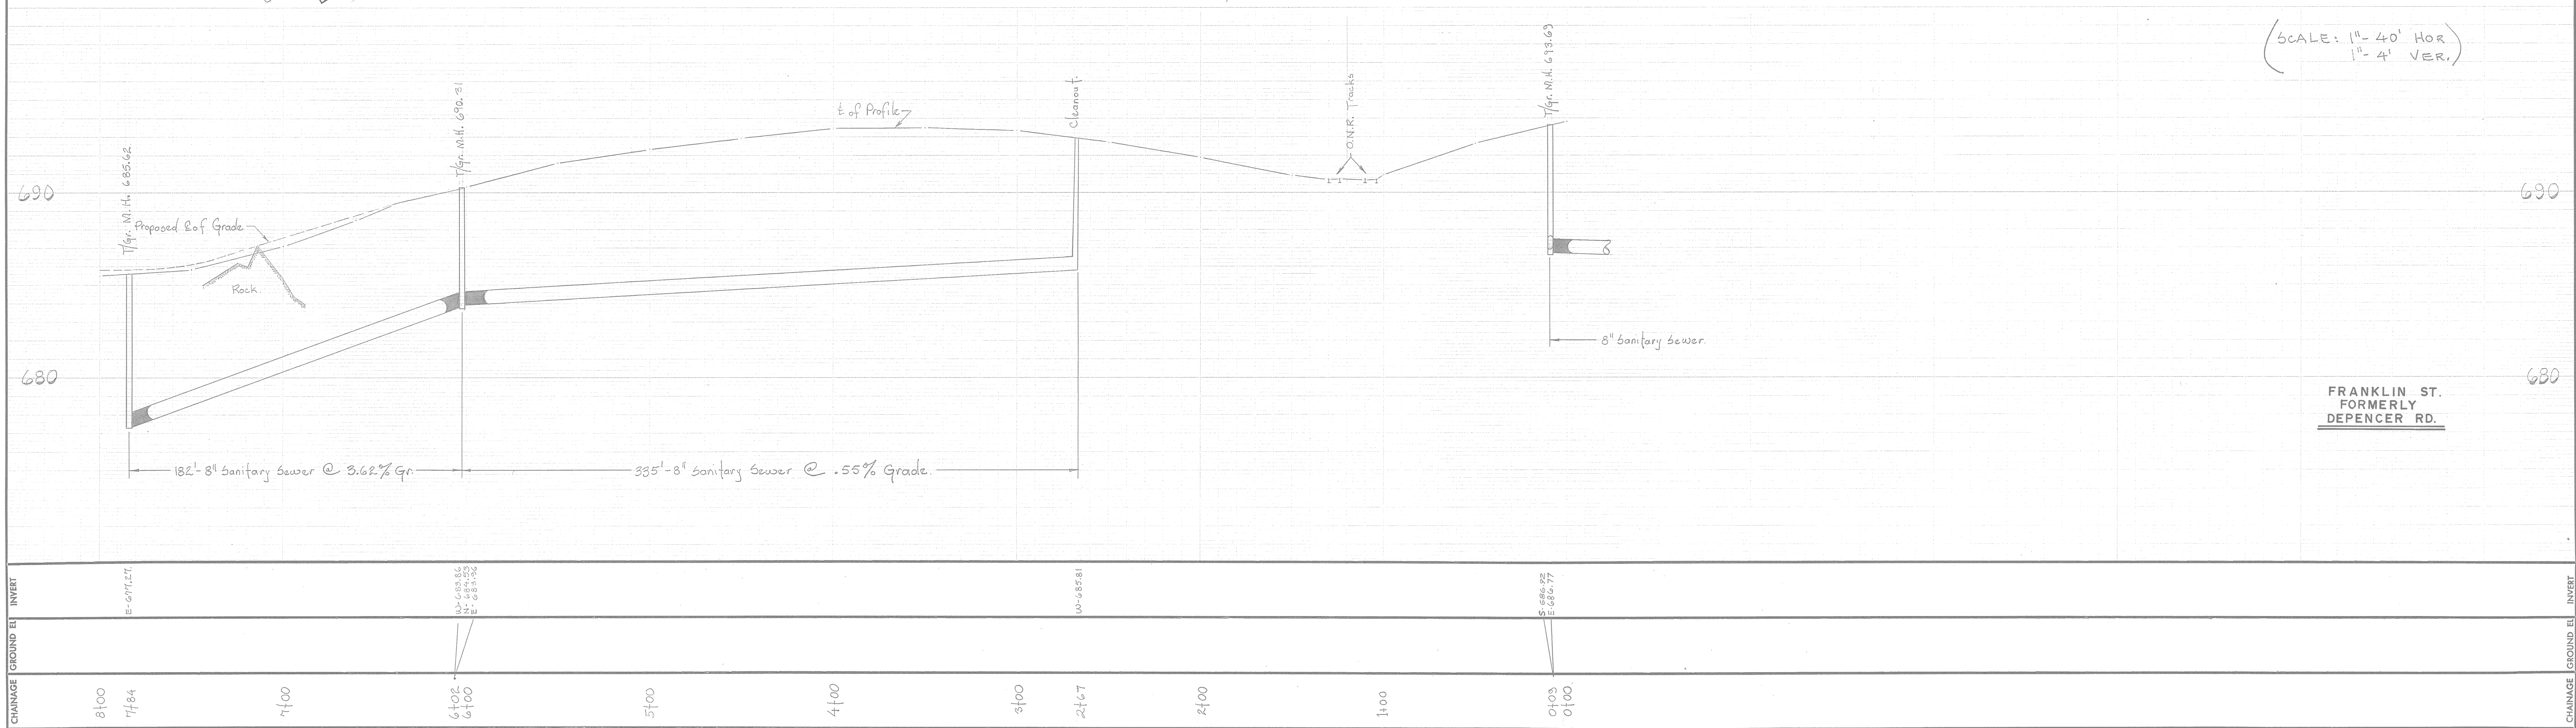


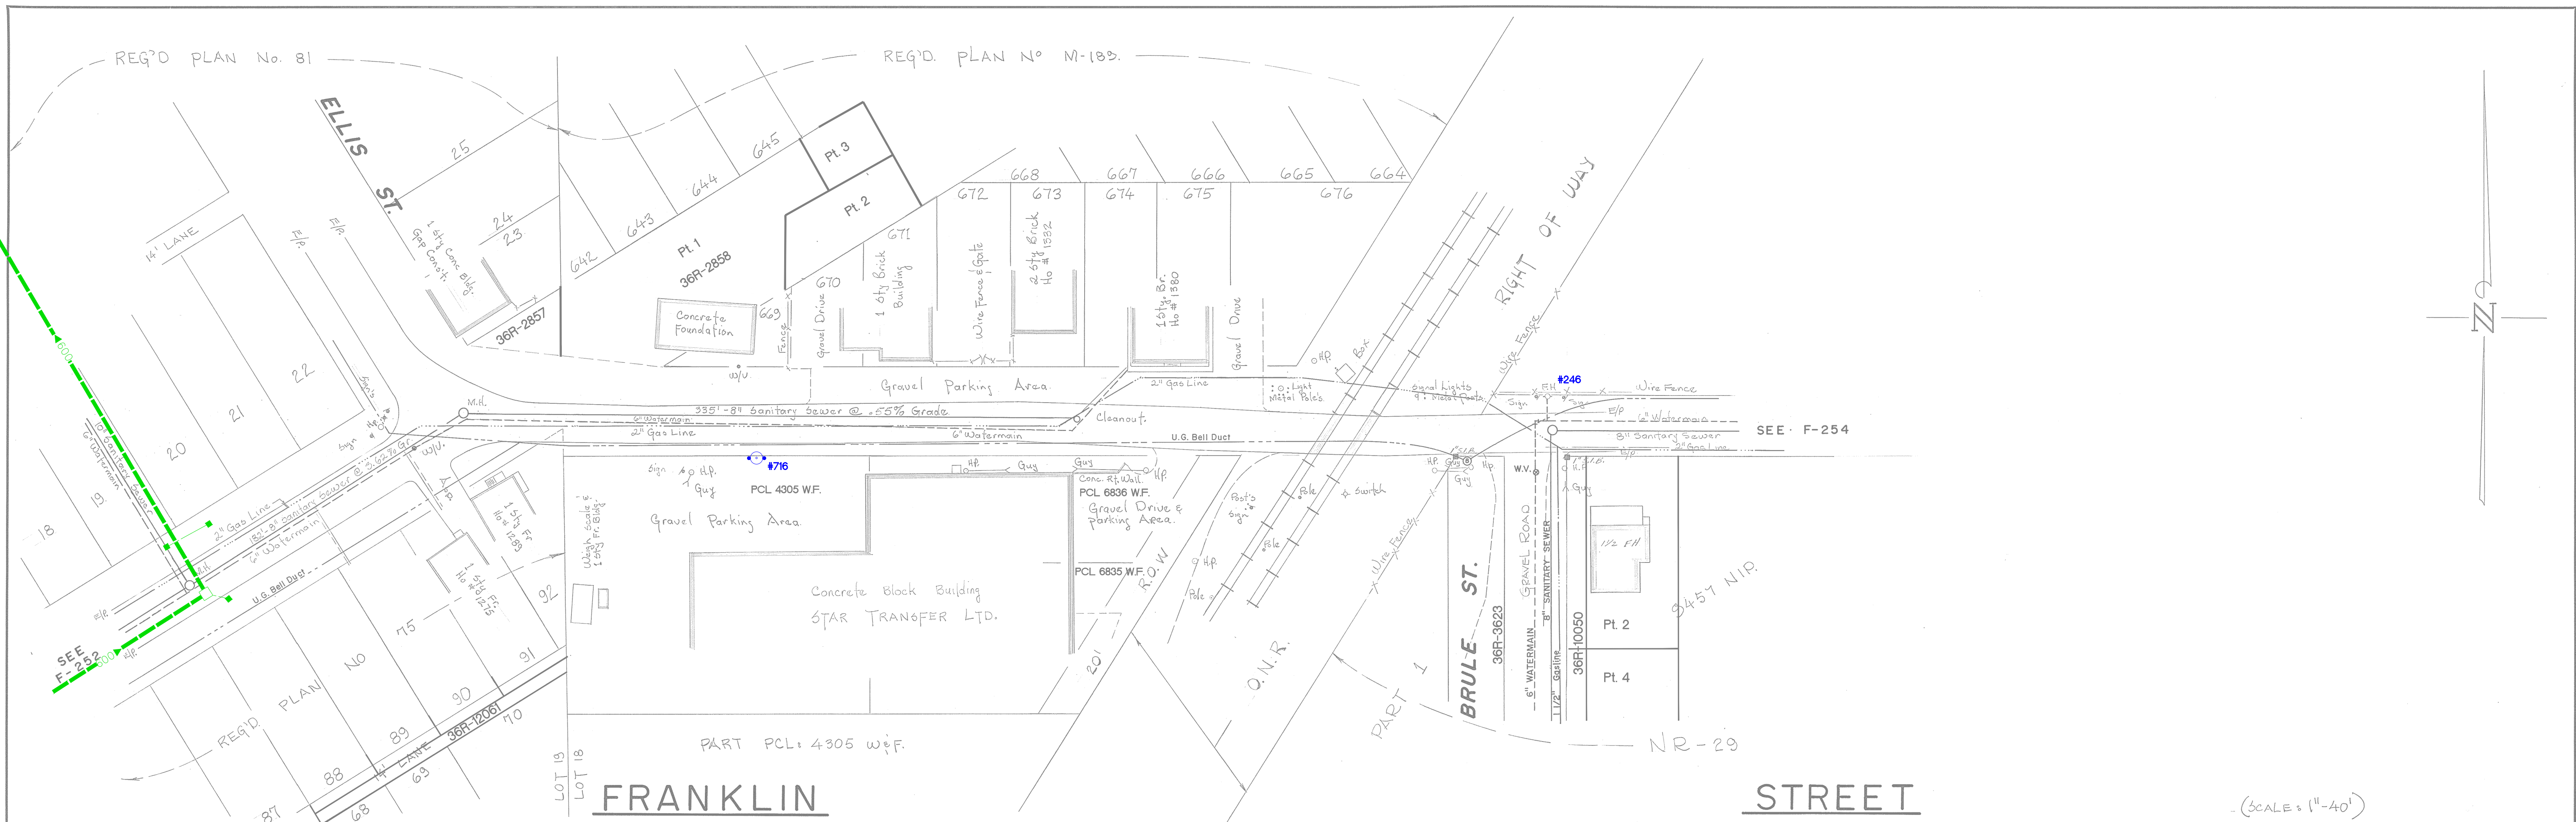

NOTES:	1. NEW DRAWING (Aug 1960)			Nov 1972	RJB	APPROVED
	2. REVISE DETAIL AT BRULE ST.			JUNE 83	J.S.	
	3. ADD 6" WATERMAIN AT BRULE			OCT. 85	J.S.	
	4. Registered plans added.			OCT. 07	rjo	
DISCLAIMER	No.			REVISION	DATE	INITIAL
FRANKLIN STREET	ELLIS STREET TO BRULE STREET			REQ'D PLAN Nos: M-183, 81 & 75		
CITY OF NORTH BAY	ENGINEERING DEPARTMENT			SCALE: AS SHOWN		
				DATE: NOV 1972		
	DRAWN BY: RJB			FIELD BOOK No. # 222		
	CK'D. BY:			DRAWING No. F-253		